

O.D.O.T. DISTRICT 2 SURVEY OFFICE (USE ONLY)

PERSONNEL

REFERENCE NO. 70

SHEET 11 OF 21

NOTES HUSS  
 H.C. CORDES  
 R.C. CORY

DATE 4/15/09  
 WEATHER CLOUDY  
 TEMP. 47°

ROUTE SR 108  
 COUNTY HENRY  
 TOWNSHIP FREEDOM  
 SECTION 35  
 T 6 N R 6 E

DWG BY NIESE PID 101211

TYPE MONUMENT MONBOX W/1" IPIN

ON SURFACE - ~~BELOW~~ ON

OFFSET  $\varnothing$  PAVEMENT 11.5' LT : ~~RT~~

ON TO LT EDGE PAVEMENT


STATION: 989+64.99

HORZ. DATUM: NAD83(2011)

GEOID: 2012A


GRID: NORTHING: 645927.071

EASTING: 1520351.515

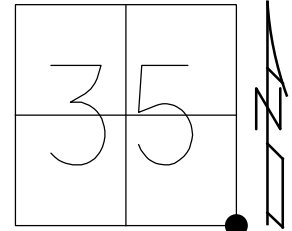

RECORD:  
 1966 PLAN  
 STA. 989+66.2  
 FD MONBOX  
 2/6/08  
 FD MONBOX  
 REF 70  
 4/4/18, JLL  
 FD MONBOX  
 9/17/19, JLL


RECORD:  
 FD R.R. SPIKE  
 @ SURFACE

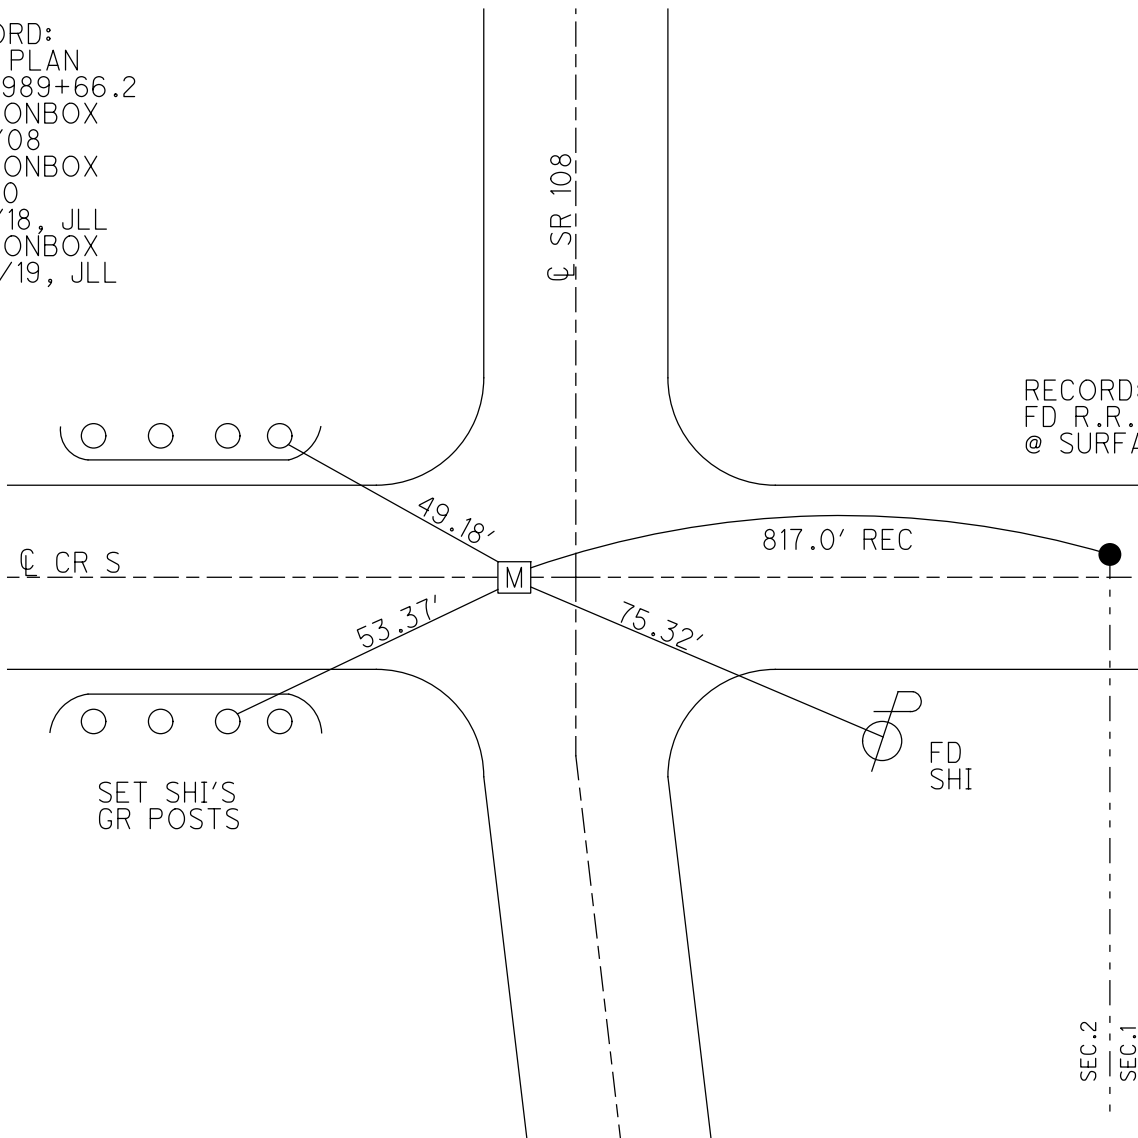

O.D.O.T. DISTRICT 2 SURVEY OFFICE (USE ONLY)


PERSONNEL	REFERENCE NO. <u>70</u>	SHEET <u>11</u> OF <u>21</u>
NOTES <u>HUSS</u>	DATE <u>4/15/09</u>	ROUTE <u>SR 108</u>
H.C. <u>CORDES</u>	WEATHER <u>CLDY-BREEZY</u>	COUNTY <u>HENRY</u>
R.C. <u>CORY</u>	TEMP. <u>47°</u>	TOWNSHIP <u>FREEDOM</u>
		SECTION <u>35</u>
		T <u>6</u> N R <u>6</u> E

TYPE MONUMENT MON.BOX  
 ON SURFACE - ~~BELOW~~ ON \_\_\_\_\_  
 LEFT - Q PAV'T - ~~RIGHT~~ 11.5'  
 ON TO LT EDGE PAVEMENT  
 S.L.M. 989+64.99

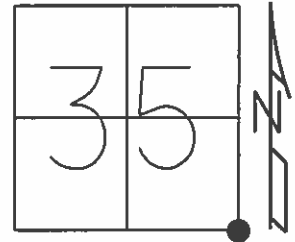

Grid: Northing: 645927.045 Easting: 1520351.523

RECORD:  
 1966 PLAN= 989+66.2  
 FD MON.BOX  
 2/6/08

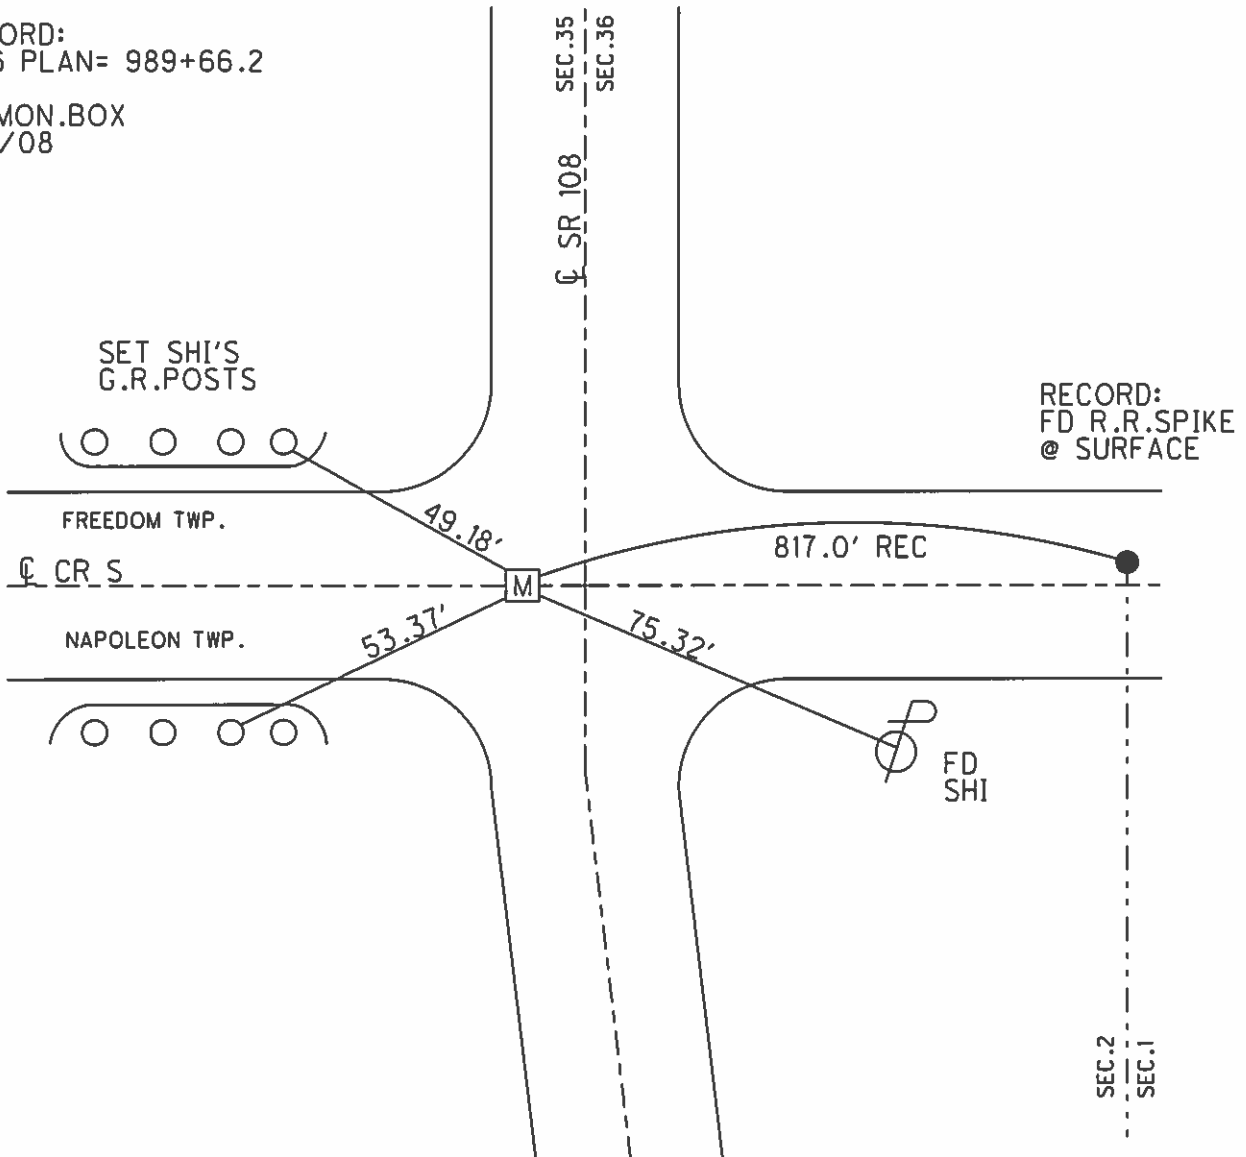

RECORD:  
 FD R.R. SPIKE  
 @ SURFACE

FD  
 SHI

# O.D.O.T. DISTRICT 2 SURVEY OFFICE

PERSONNEL

REFERENCE NO. 70

SHEET 20 OF 21

NOTES MOSE

H.C. CANTERBURY

R.C. MOSE

DATE 8-2-01

WEATHER OVERCAST

TEMP. +90°

ROUTE 108

COUNTY HENRY

TOWNSHIP FREEDOM

SECTION 35

T6 N R6 E


TYPE MONUMENT Mon Box

ON SURFACE - ~~BELOW~~ SURFACE


LEFT - ~~Q~~ PAV'T. - ~~RIGHT~~ 11.5' LT

ON ~~TO~~ LT EDGE PAVEMENT ON ~~Q~~ PAVT

S.L.M. 988 + 98 CO. RD. "S" EAST.

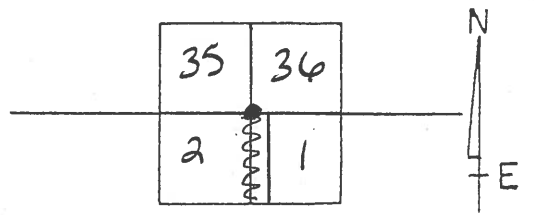

RECORD:  
 ALG PLAN = 989 to 6.2

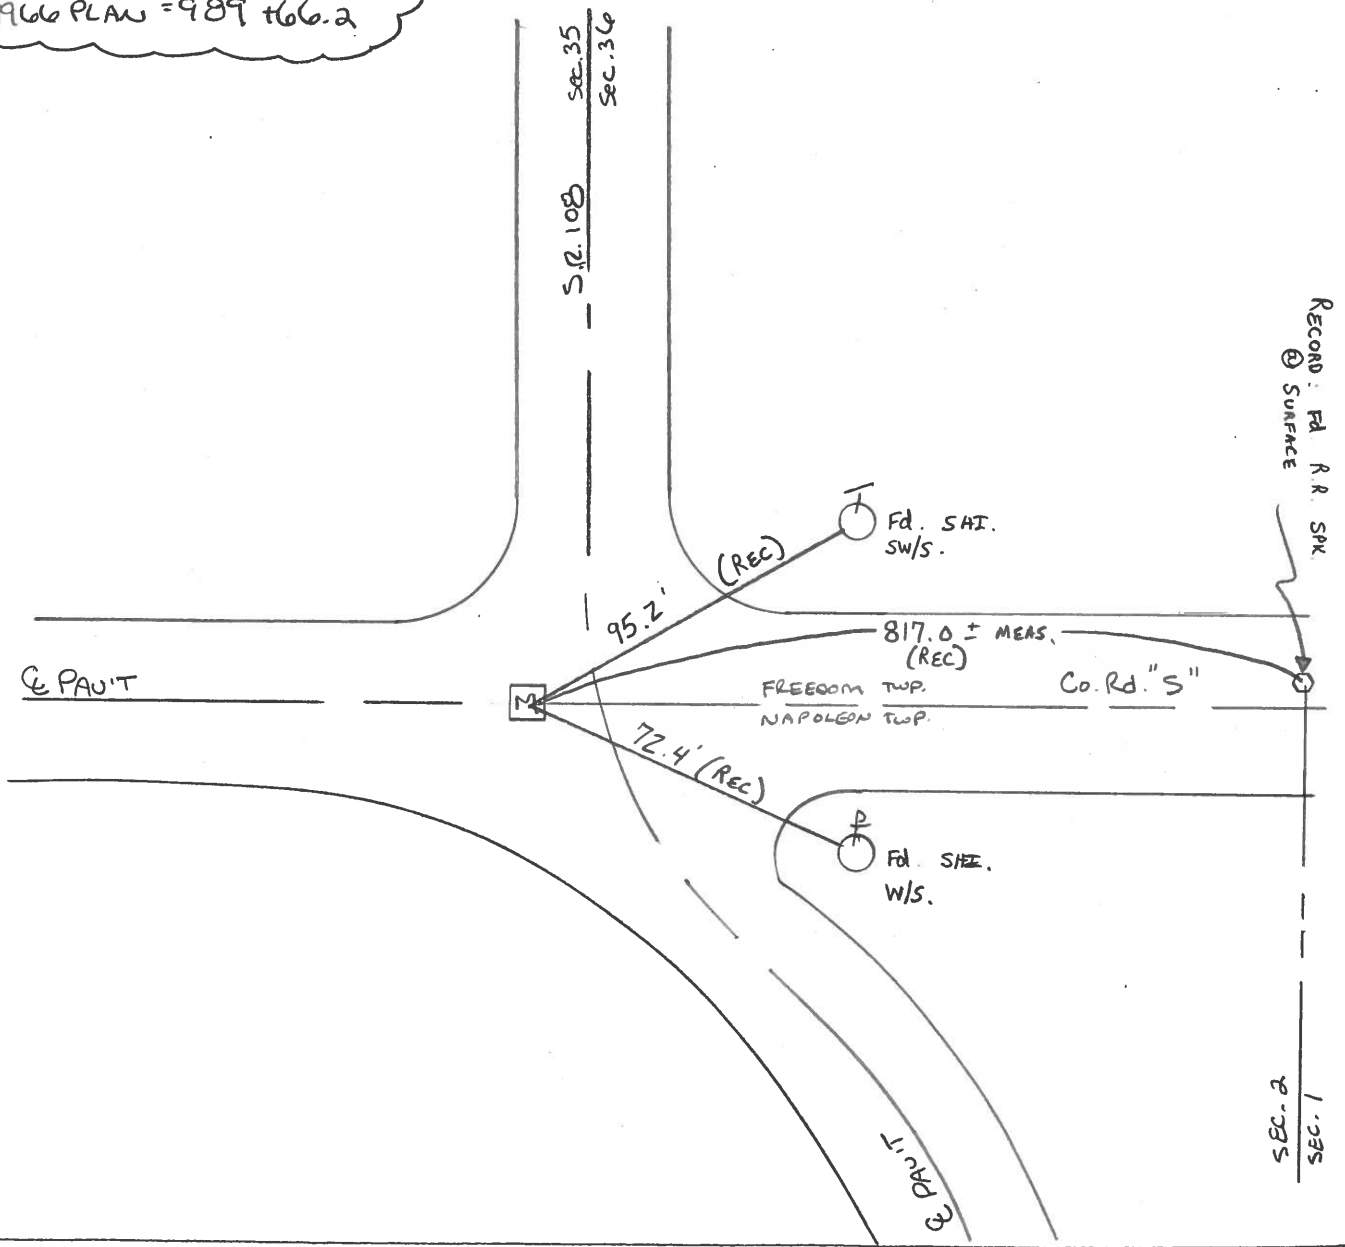

# O.D.O.T. DISTRICT 2 SURVEY OFFICE

PERSONNEL \_\_\_\_\_

REFERENCE NO. \_\_\_\_\_

SHEET 32 OF 33

NOTES HOFFMAN

H.C. BARNHISEL

R.C. LOGARKS

REED

DATE 4-18-88

WEATHER P. CLEAR

TEMP. 44°

ROUTE SR 108

COUNTY HEARLY

TOWNSHIP FREEDOM

SECTION 35

T6 N R 6 E


TYPE MONUMENT Monument Box

ON SURFACE - BELOW YES

LEFT- & PAW'T. - RIGHT 11.5'

on TO LT EDGE PAVEMENT on & Pawt  
Co. Rd. "5" EAST

S.L.M. 988+98

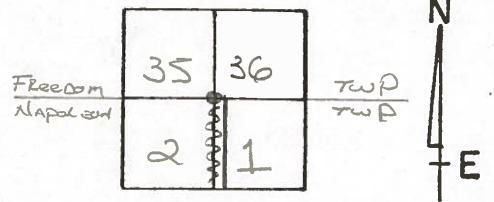


1966 PLAN = 989+66.2

DID NOT OPEN LID

70

SR 108  
SEC 35  
SEC 36

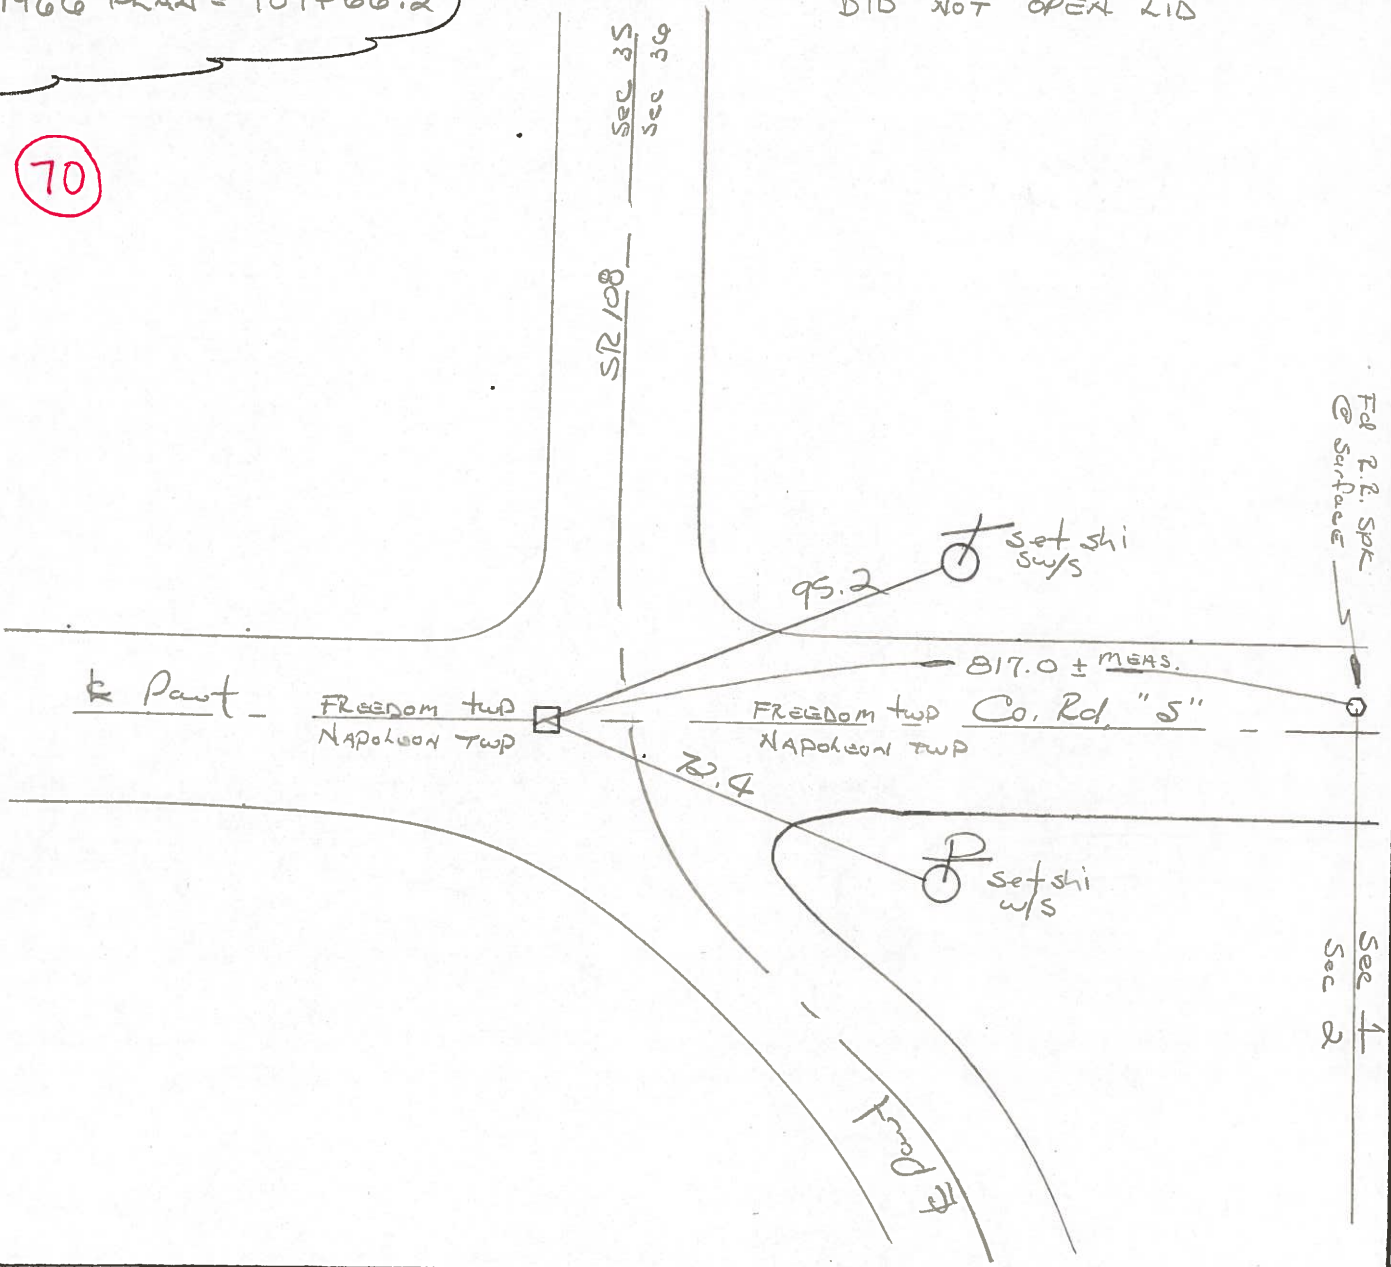

PERSONNEL TITLE PERSONNEL TITLE

Red Beach  
Newcomb  
Knappe  
Wise

COUNTY HENRY

DATE Aug 1971

S. R. Freedom Twp.

WEATHER

SEC. 36

TEMP.

ALIGNMENT & CONTROLS

DESCRIPTION

LEFT

CENTER LINE

RIGHT

JOB NO.

