

O.D.O.T. DISTRICT 2 SURVEY OFFICE (USE ONLY)

PERSONNEL

REFERENCE NO. 77 A

SHEET 21 OF 21

NOTES AUBLE DATE 4/2/18

H.C. LEU WEATHER CLEAR

R.C. AUBLE TEMP. 34°F

ROUTE SR 108

COUNTY HENRY

TOWNSHIP FREEDOM

SECTION 14

DWG BY NIESE PID 101211

T 6 N R 6 E

TYPE MONUMENT P.K./WASHER

ON SURFACE - ~~BELOW~~ ON

OFFSET Q PAVEMENT 4.7' LT : ~~RT~~

7.5' TO LT EDGE PAVEMENT



STATION: 1200+98.24

HORZ.DATUM: NAD83(2011)

GEOID: 012A

GRID: NORTHING: 667055.983

EASTING: 1520771.846

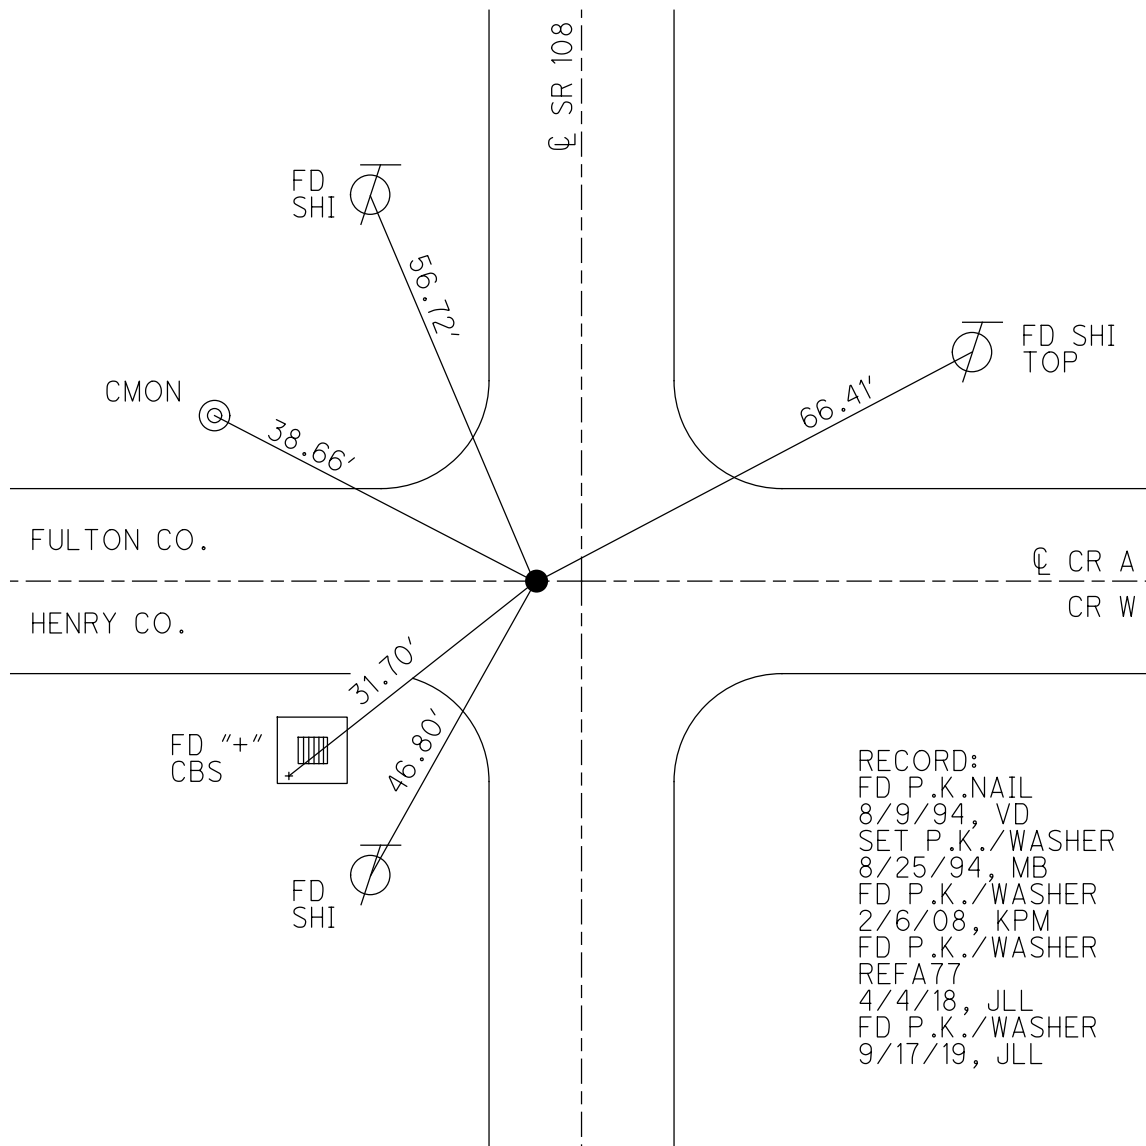
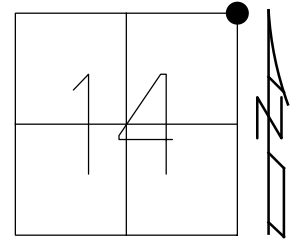


RECORD:
 FD P.K.NAIL
 8/9/94, VD
 SET P.K./WASHER
 8/25/94, MB
 FD P.K./WASHER
 2/6/08, KPM
 FD P.K./WASHER
 REFA77
 4/4/18, JLL
 FD P.K./WASHER
 9/17/19, JLL

O.D.O.T. DISTRICT 2 SURVEY OFFICE (USE ONLY)

PERSONNEL	REFERENCE NO. <u>77 A</u>	SHEET <u>21</u> OF <u>21</u>
NOTES <u>HUSS</u>	DATE <u>4/16/09</u>	ROUTE <u>SR 108</u>
H.C. <u>CORDES</u>	WEATHER <u>CLEAR</u>	COUNTY <u>HENRY</u>
R.C. <u>CORY</u>	TEMP. <u>52°</u>	TOWNSHIP <u>FREEDOM</u>
		SECTION <u>14</u>
		T <u>6</u> N R <u>6</u> E


TYPE MONUMENT P.K.NAIL
 ON SURFACE - ~~BELOW~~ ON _____
 LEFT - CL PAV'T - ~~RIGHT~~ 4.7'
7.5' TO LT EDGE PAVEMENT
 S.L.M. 1200+98.24
 Grid: Northing: 667055.929 Easting: 1520771.830

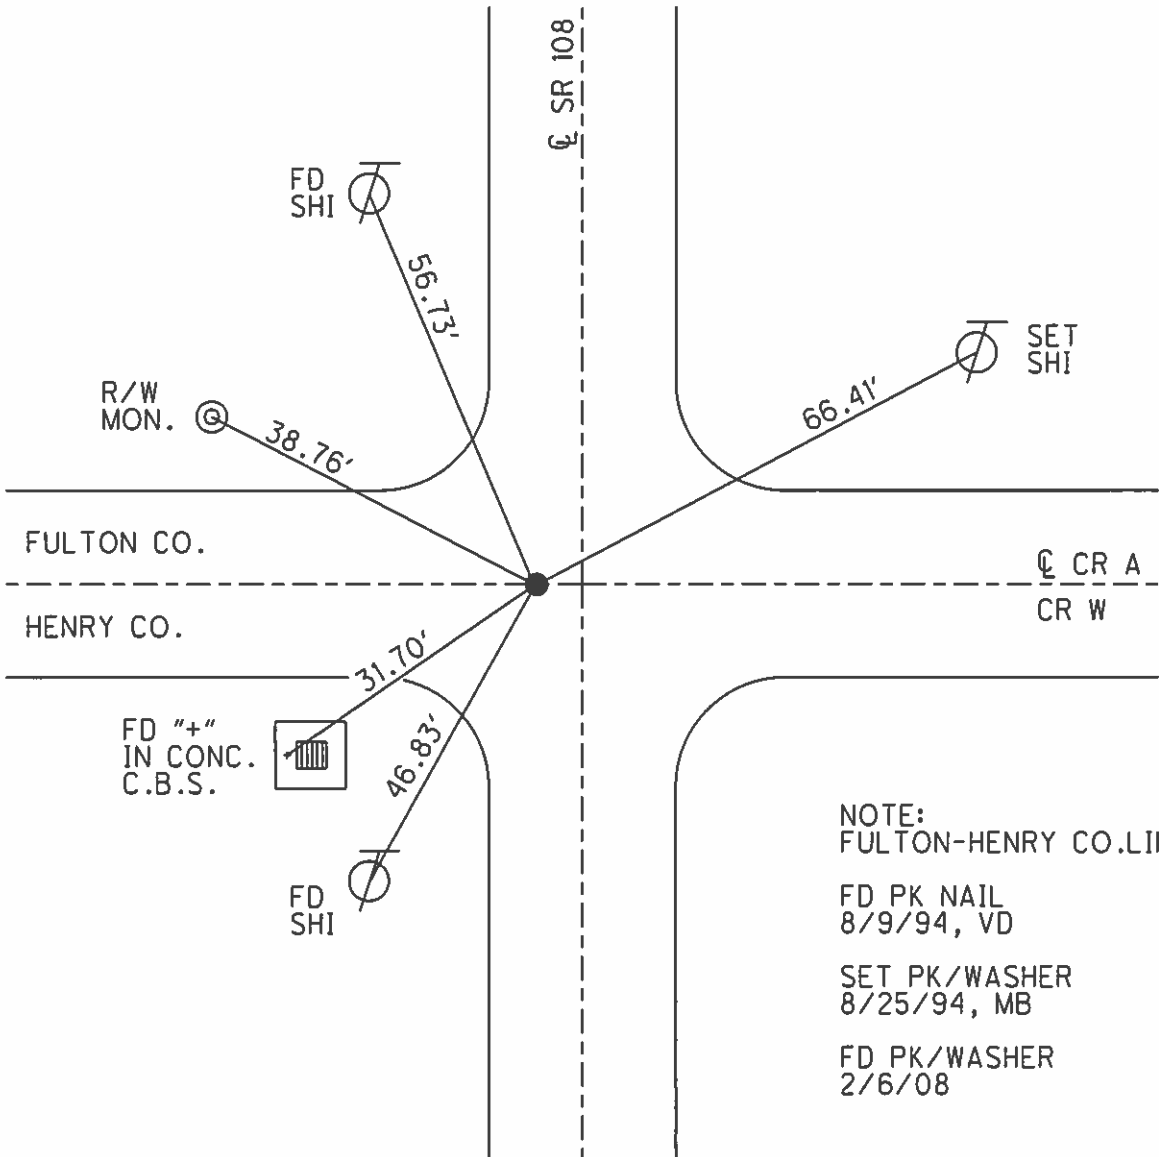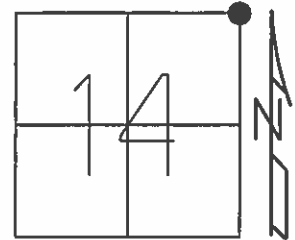

NOTE:
 FULTON-HENRY CO. LINE
 FD PK NAIL
 8/9/94, VD
 SET PK/WASHER
 8/25/94, MB
 FD PK/WASHER
 2/6/08

PERSONNEL TITLE PERSONNEL TITLE COUNTY HENRY DATE Aug. 1971
Red Beach _____
Newcomb _____
Knape _____
Wise _____
 S. R. FREEDOM TWP. WEATHER _____
 SEC. 13 TEMP. _____

DESCRIPTION ALIGNMENT & CONTROLS JOB NO. _____
 LEFT CENTER LINE RIGHT

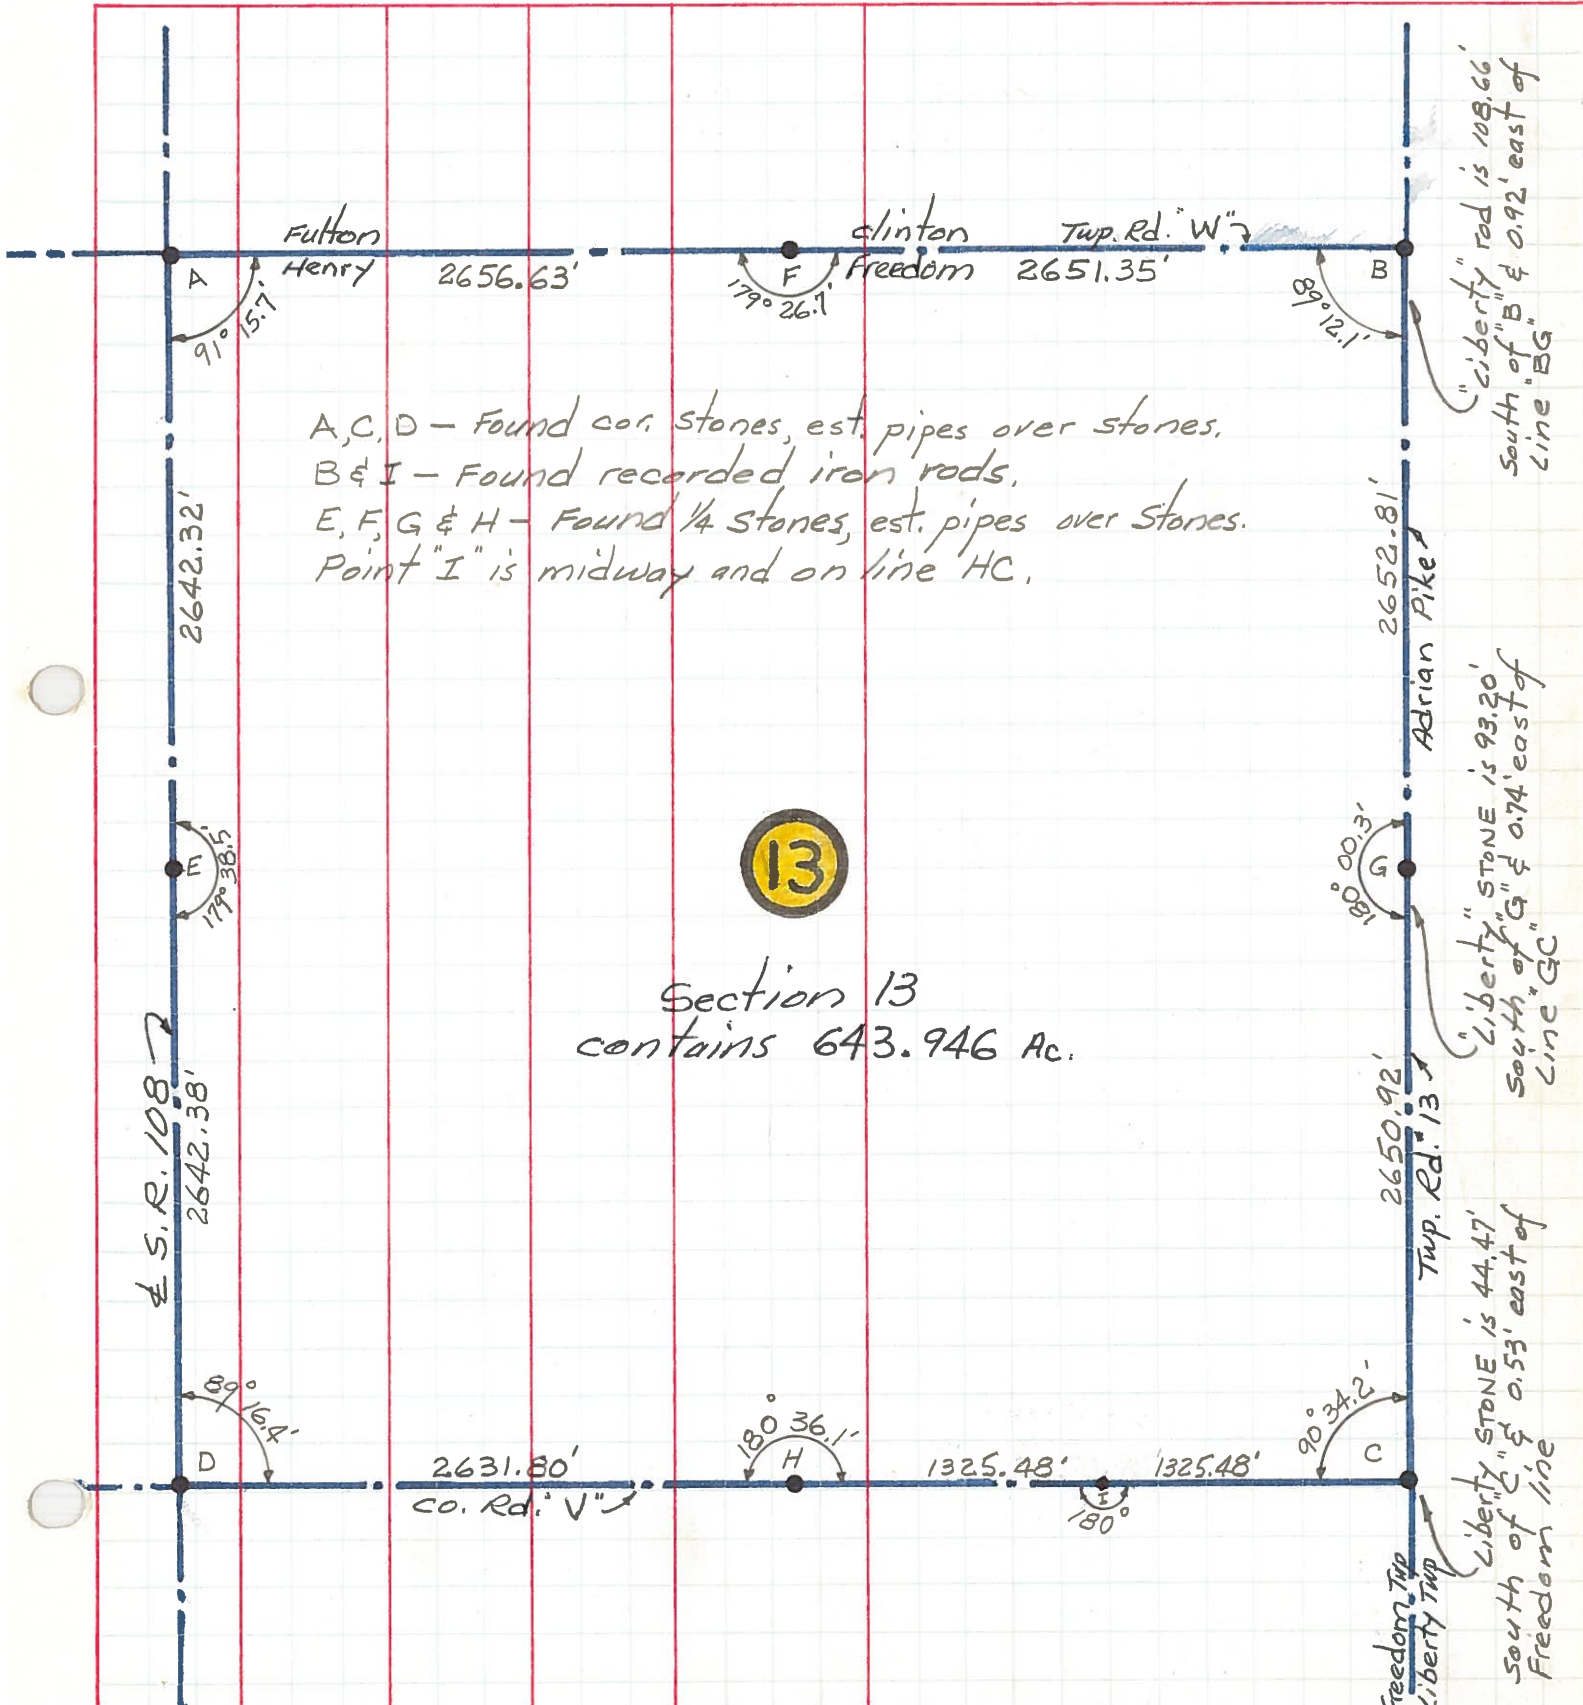

A, C, D - Found cor. stones, est. pipes over stones.
 B & I - Found recorded iron rods.
 E, F, G & H - Found 1/4 stones, est. pipes over stones.
 Point "I" is midway and on line "HC".

13

Section 13
 contains 643.946 Ac.


"Liberty" rod is 108.66' south of "B" & 0.92' east of line "BG"

"Liberty" stone is 93.30' south of "G" & 0.74' east of line "GC"

Liberty stone is 44.47' south of "C" & 0.53' east of Freedom line




PERSONNEL	TITLE	PERSONNEL	TITLE	COUNTY	DATE
Red Beach				HENRY	July 1971
Newcomb				S. R. 108	WEATHER
Knape				SEC. FREEDOM TWP.	TEMP.
Wise					

DESCRIPTION **ALIGNMENT & CONTROLS** JOB NO.

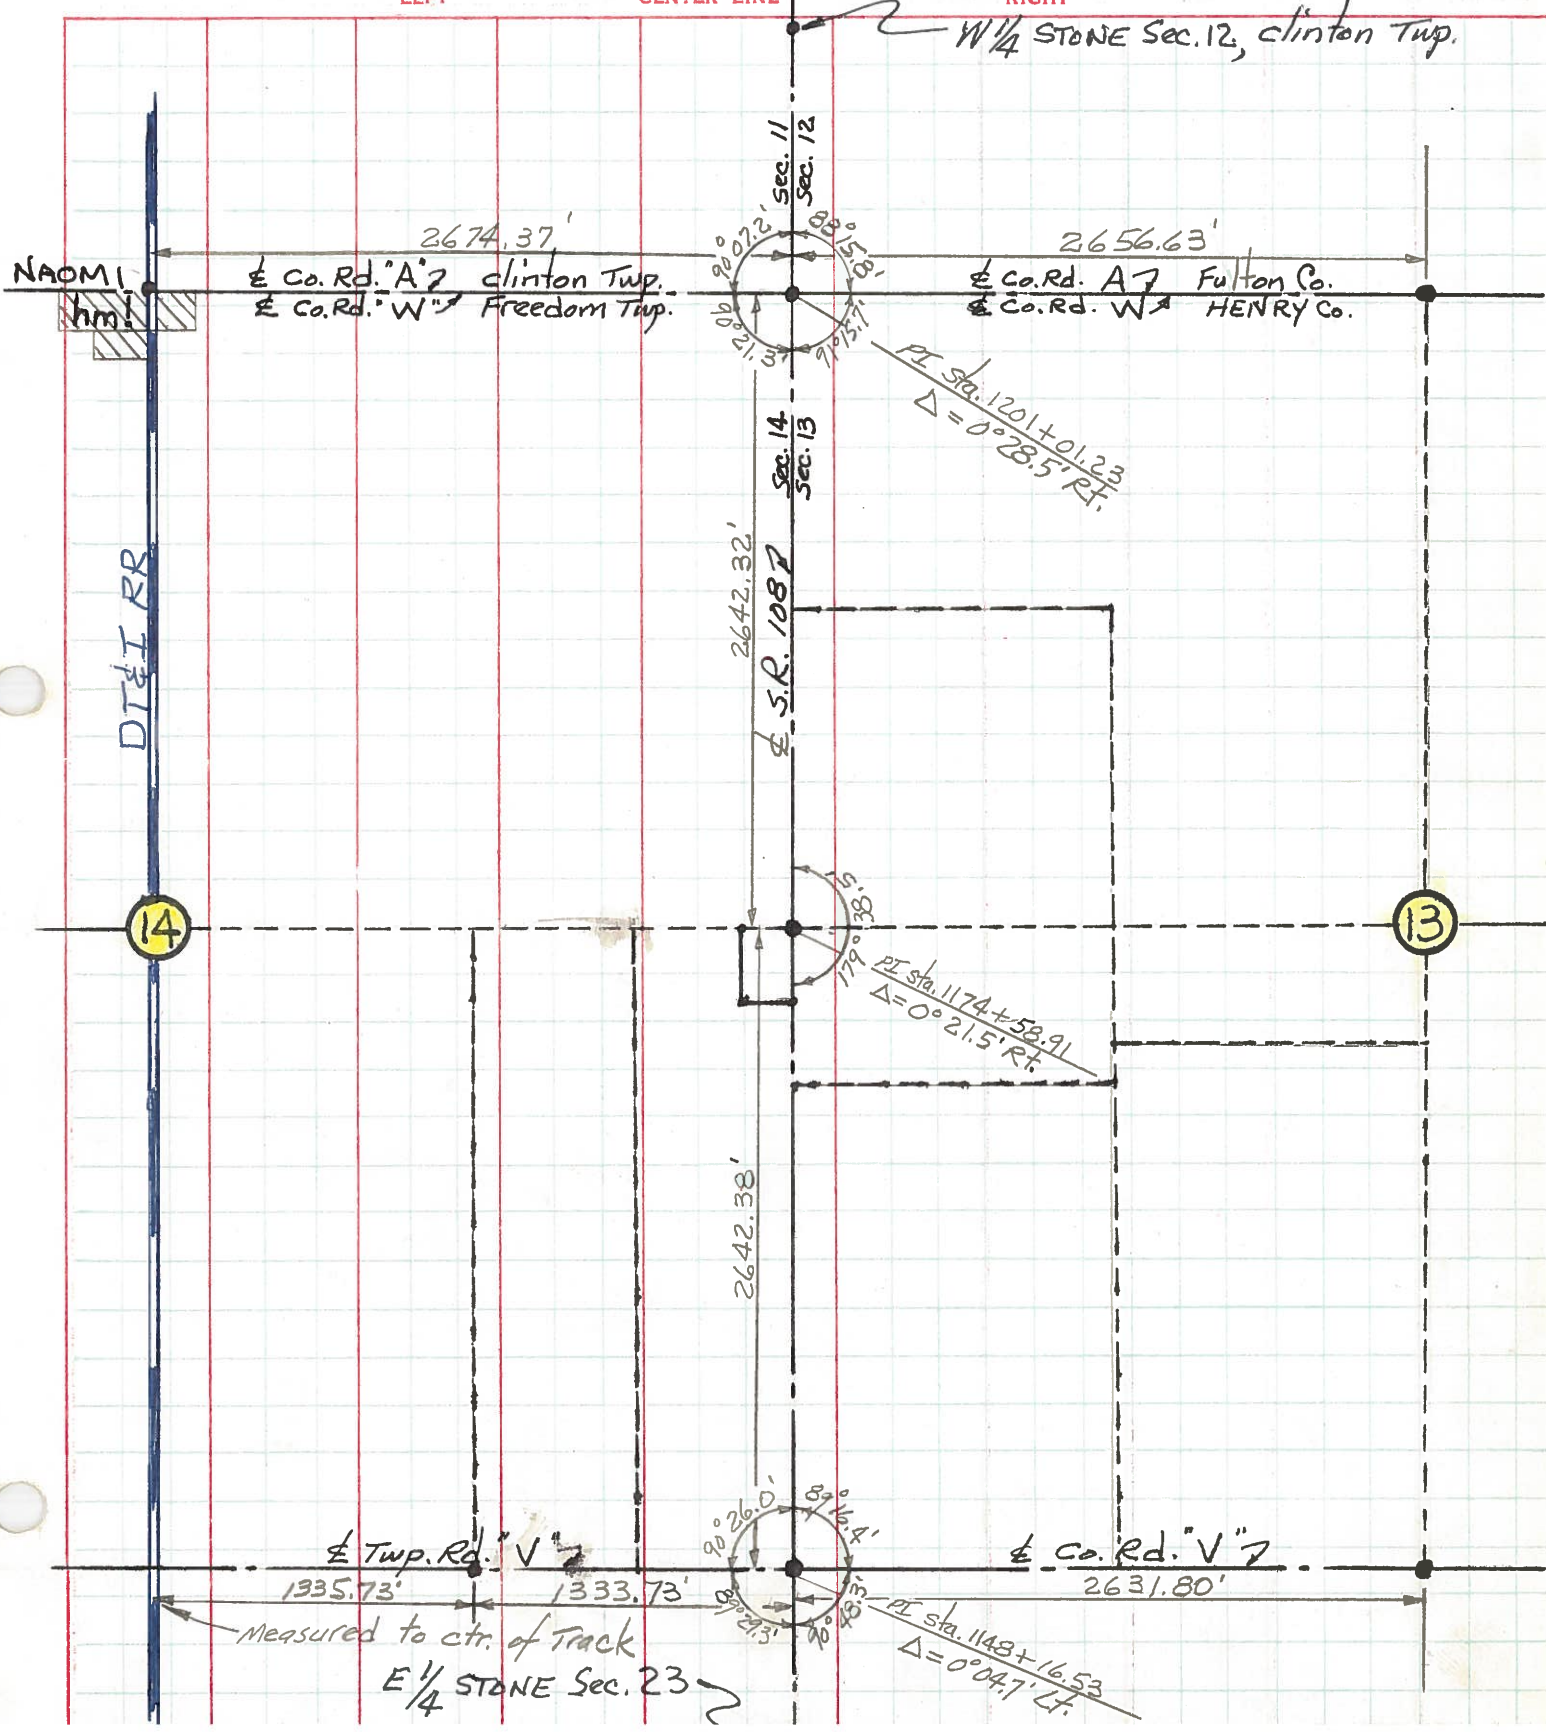


PERSONNEL TITLE PERSONNEL TITLE COUNTY HENRY DATE July '71
Red Beach _____
Newcomb _____
Knape _____
Wise _____
 S. R. 108 WEATHER _____
 SEC. Freedom Twp TEMP. _____

DESCRIPTION CONTROL POINTS JOB NO. _____

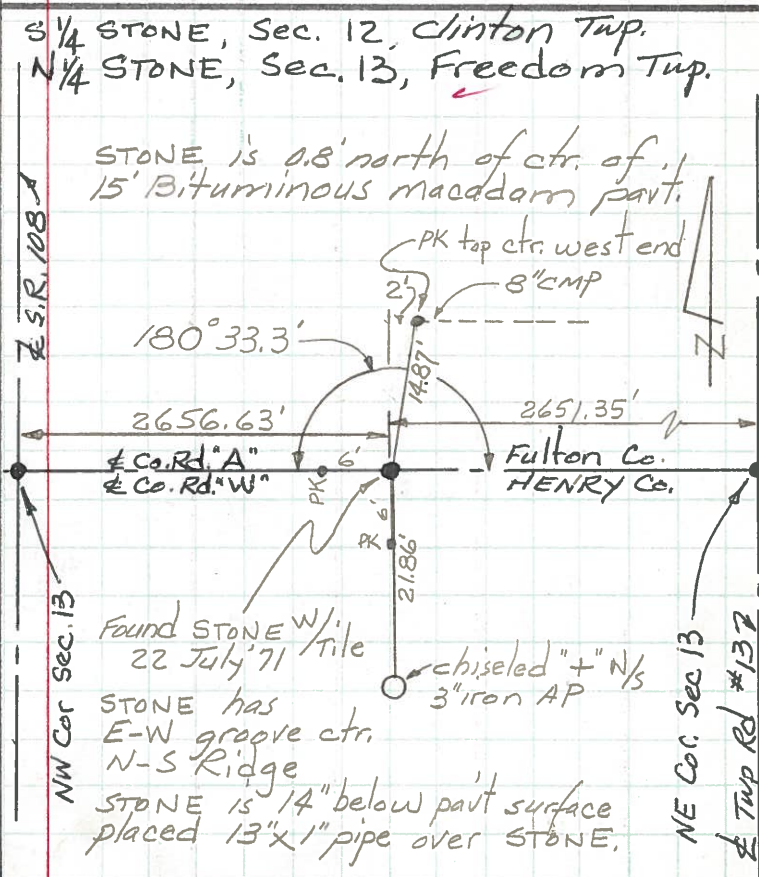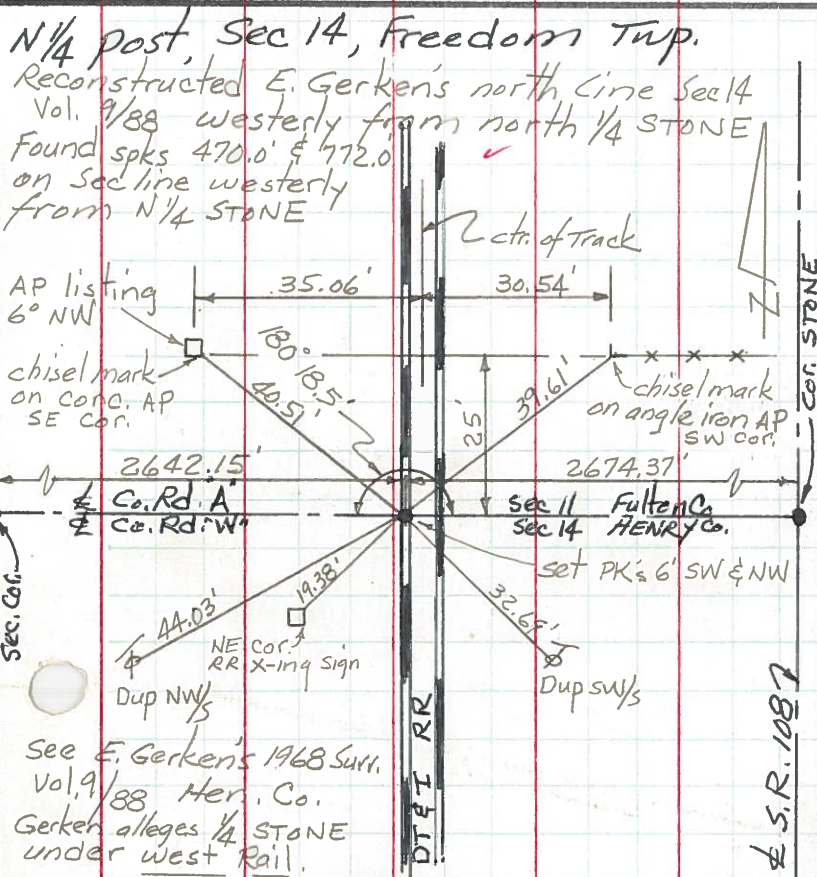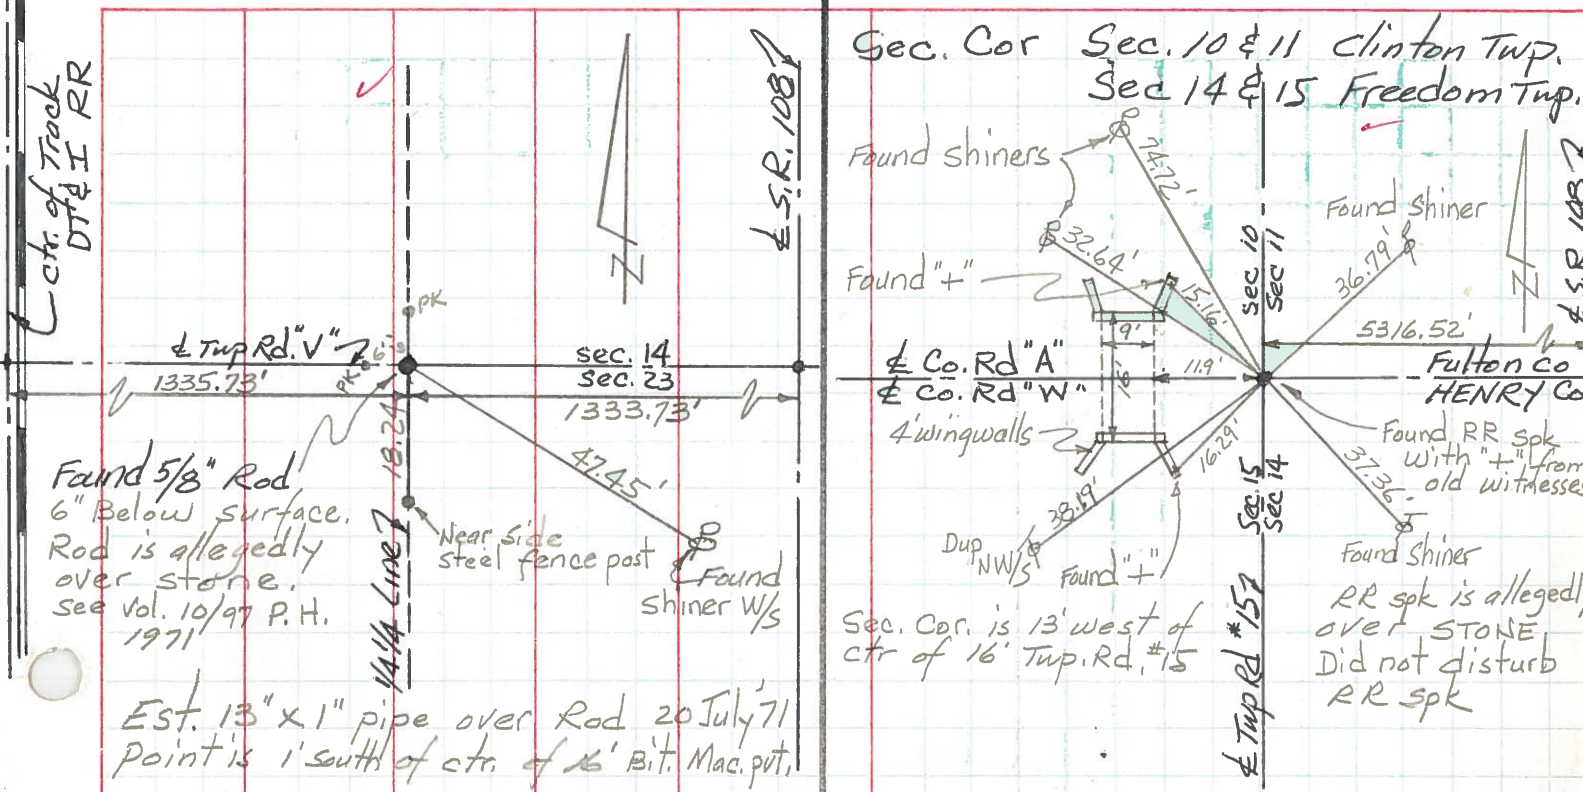

PERSONNEL	TITLE	PERSONNEL	TITLE	COUNTY	DATE
Red Beach				Henry	July 1971
Newcomb				S. R. 108	WEATHER
Knape				SEC. Freedom Twp.	TEMP.
Wise					

DESCRIPTION CONTROL POINTS JOB NO. _____

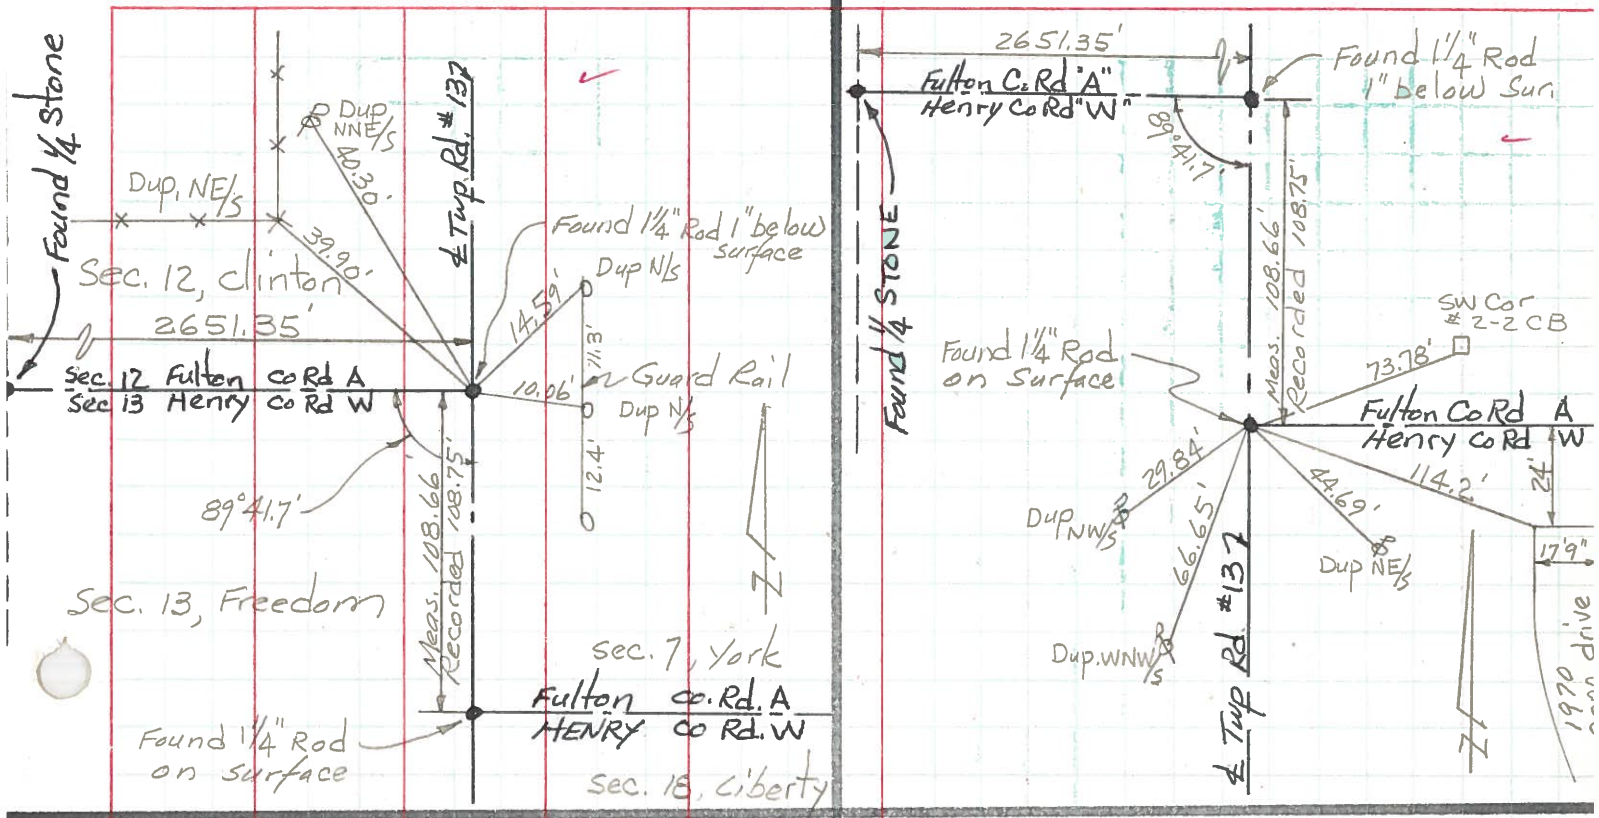

PERSONNEL TITLE PERSONNEL TITLE COUNTY HENRY DATE June 1971
 Red Beach Newcomb S. R. 108 WEATHER
 Knape SEC. Freedom Twp TEMP.
 Wise

DESCRIPTION CONTROL POINTS JOB NO.

