
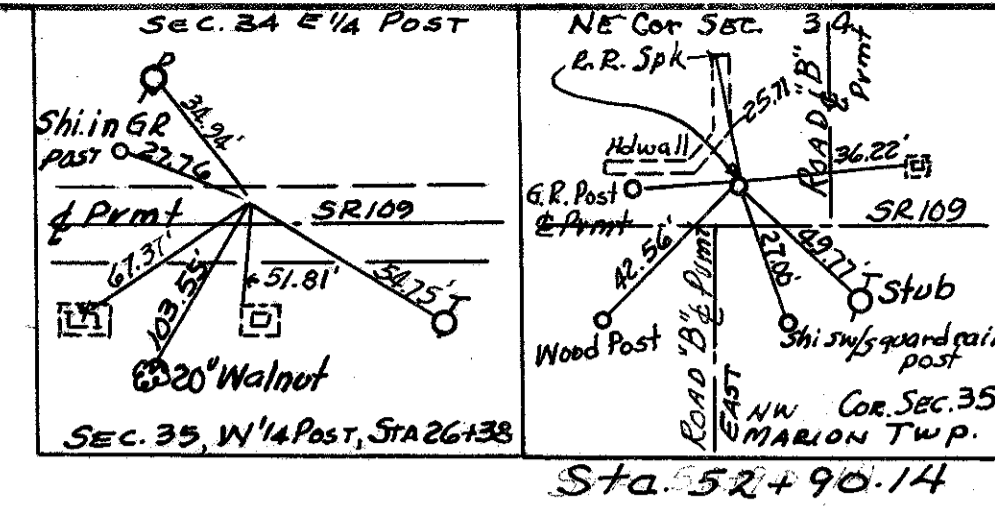


S.E. COR SEC 34 STAD 100
 PUTNAM COUNTY LIBERTY TWP SEC. 3
 17.7 PL & 8' PUM + 3.6 F50 & FAV + 52.109
 28.08 SEC. 2
 HENRY COUNTY MARION TWP SEC. 34 SR 109
 23.823
 31.85' DUNN SE SIDE
 28.08 SEC. 35
 28.08 SEC. 2

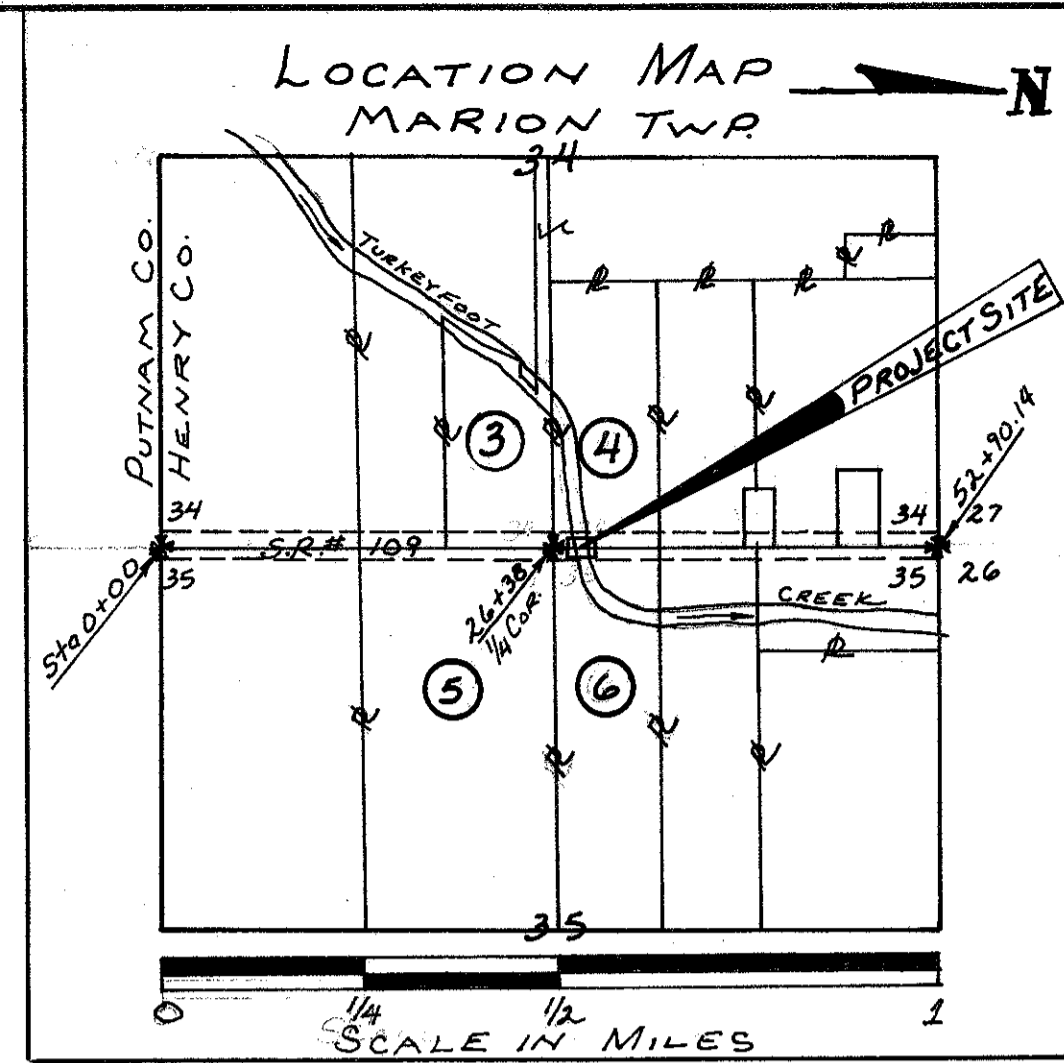

FHWA REGION	STATE	PROJECT	25 26
5	OHIO		
HEN - 109 - (0.49)(2.76)			1 1
JOB NO. 02800(0)			
PART I (0.49)			

③ ROBERT W & MYRA A. MUNTZ
 40 AC.



④ WILLIAM F & CAROLYN J. POWELL
 29.27 AC

③ CONT 0.096 AC.
 PRO 0.064 AC.
 NET 0.032 AC.

④ CONT 0.117 AC.
 PRO 0.063 AC.
 NET 0.054 AC.

GRASS YARD

CULT.

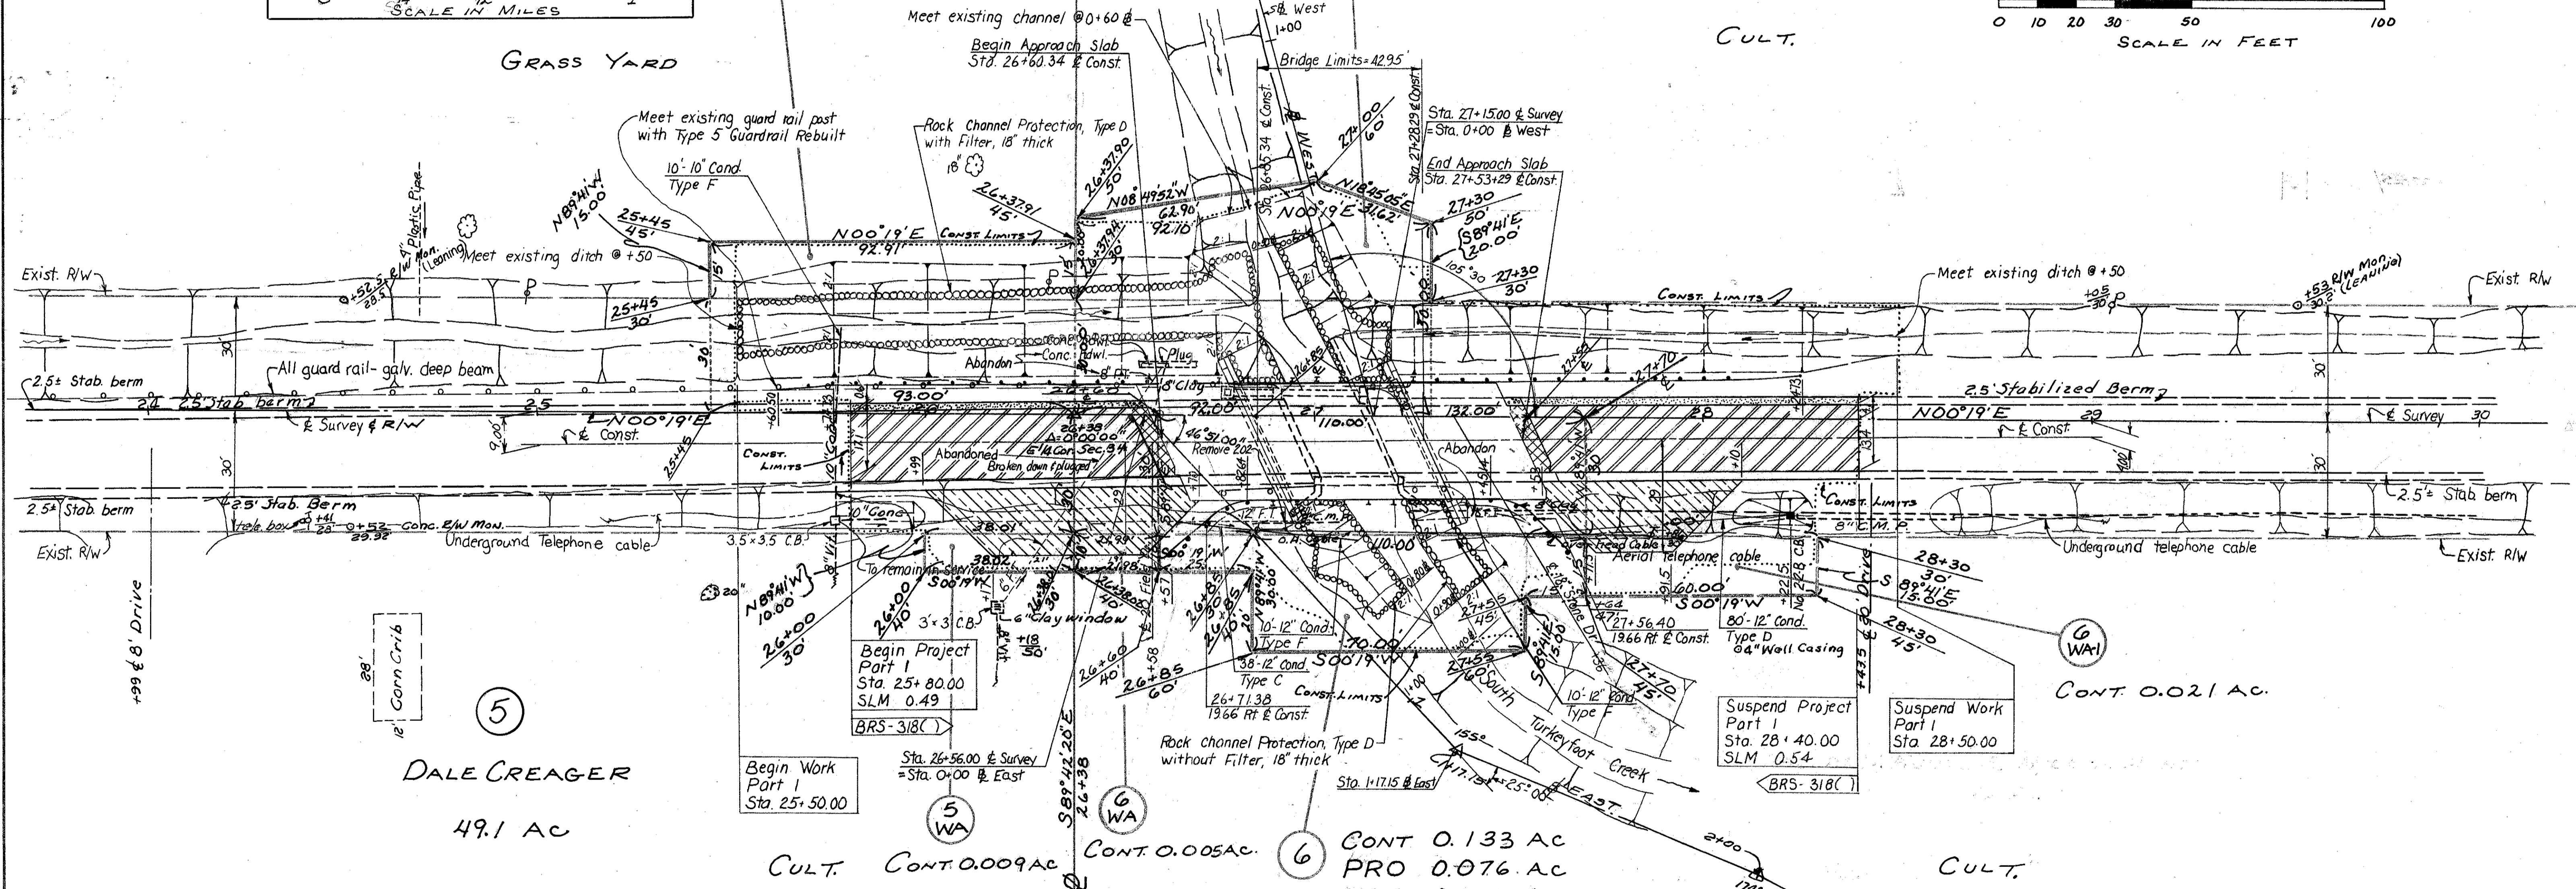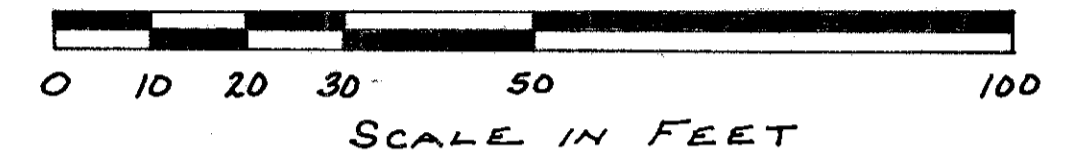

⑤ DALE CREAGER
 49.1 AC

CULT. CONT 0.009 AC

⑤ WA CONT 0.005 AC

⑥ CONT 0.133 AC
 PRO 0.076 AC
 NET 0.057 AC

CULT.



RIGHT OF WAY SUMMARY

PAR NO.	OWNER	DEED RECORD		DEED AREA ACRES	TOTAL PRO ACRES	TOTAL TAKE ACRES	PRO IN TAKE ACRES	NET TAKE ACRES	RESIDUE ACRES	REMARKS	AS ACQUIRED	
		VOL.	PAGE								VOL.	PAGE
3	ROBERT W & MYRA A. MUNTZ	222	436	40	0.430	0.096	0.064	0.032	39.904		226	352
4	WILLIAM F & CAROLYN J. POWELL	224	723	29.27	0.468	0.117	0.063	0.054	29.153		226	355
5WA	DALE CREAGER	224	770	49.10	0.913	—	—	0.009		CONSTRUCT DRIVE APPROACH		
6	ORVIL & IZOA CREAGER	201	813	20.0	0.377	0.133	0.076	0.057	19.867		226	358
6WA	"	201	813	20.0	—	—	—	0.005		CONSTRUCT DRIVE APPROACH		
6WA-1	"	201	813	20.0	—	—	—	0.021		CONSTRUCT DRIVE APPROACH		

⑥ ORVIL & IZOA CREAGER
 20 AC.

PARCEL NO.	DATE	REMARKS
6	11/27/04	Revise Parcel G


RZ109 #1 B-63

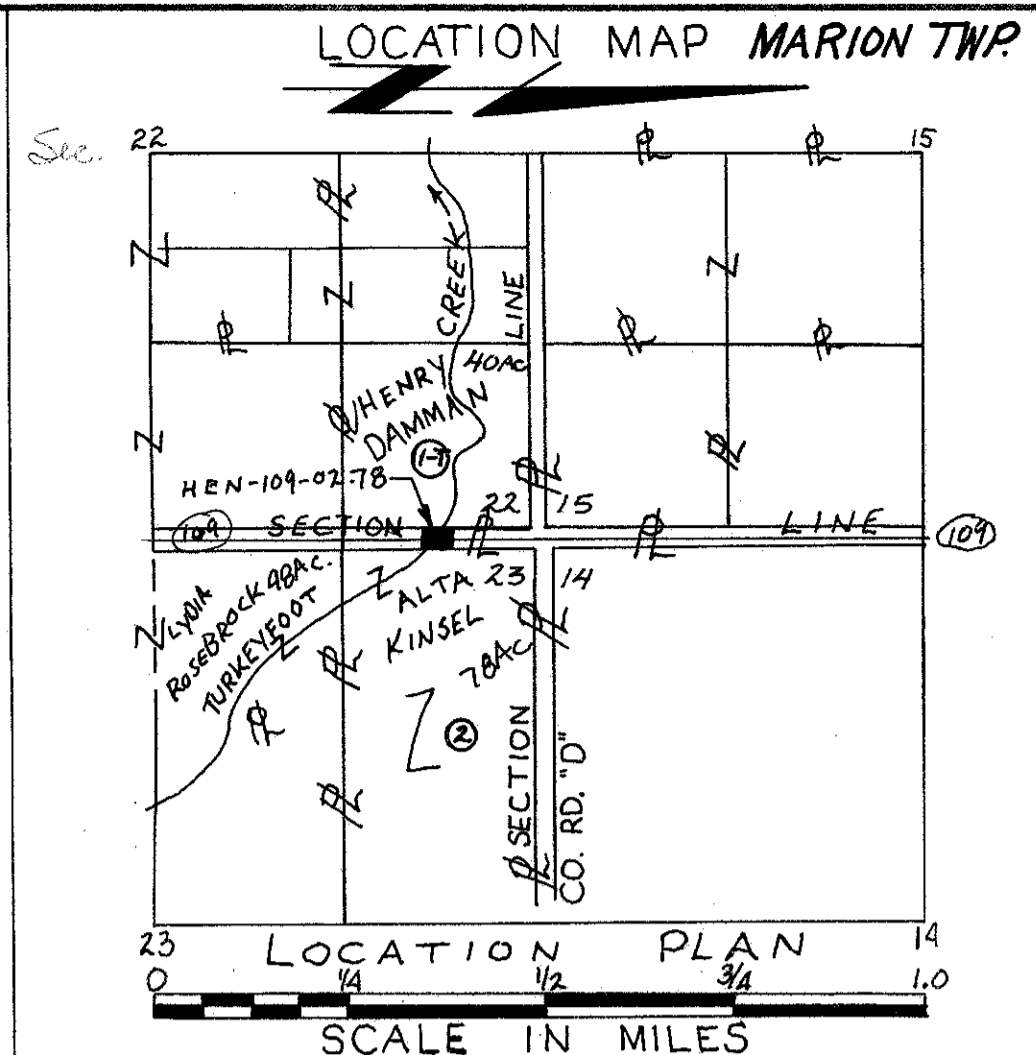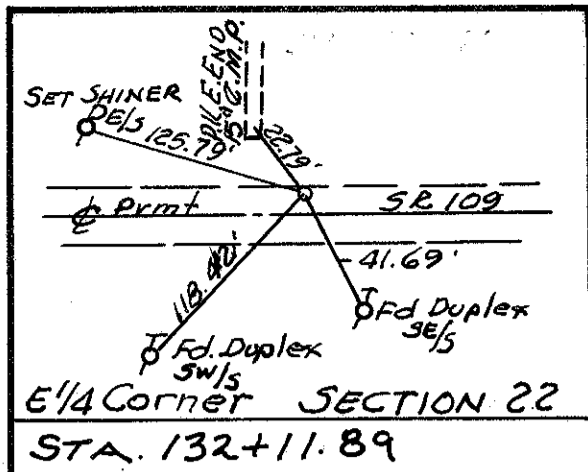

Fd Duplex 5.6 Side	Fo + Top Store Hdl	FHWA REGION	STATE	PROJECT
12" C.M.P.	SR 109	5	OHIO	

HEN-109-(0.49)(2.76)
 JOB No. 028000
 PART 2

26
26
1
1

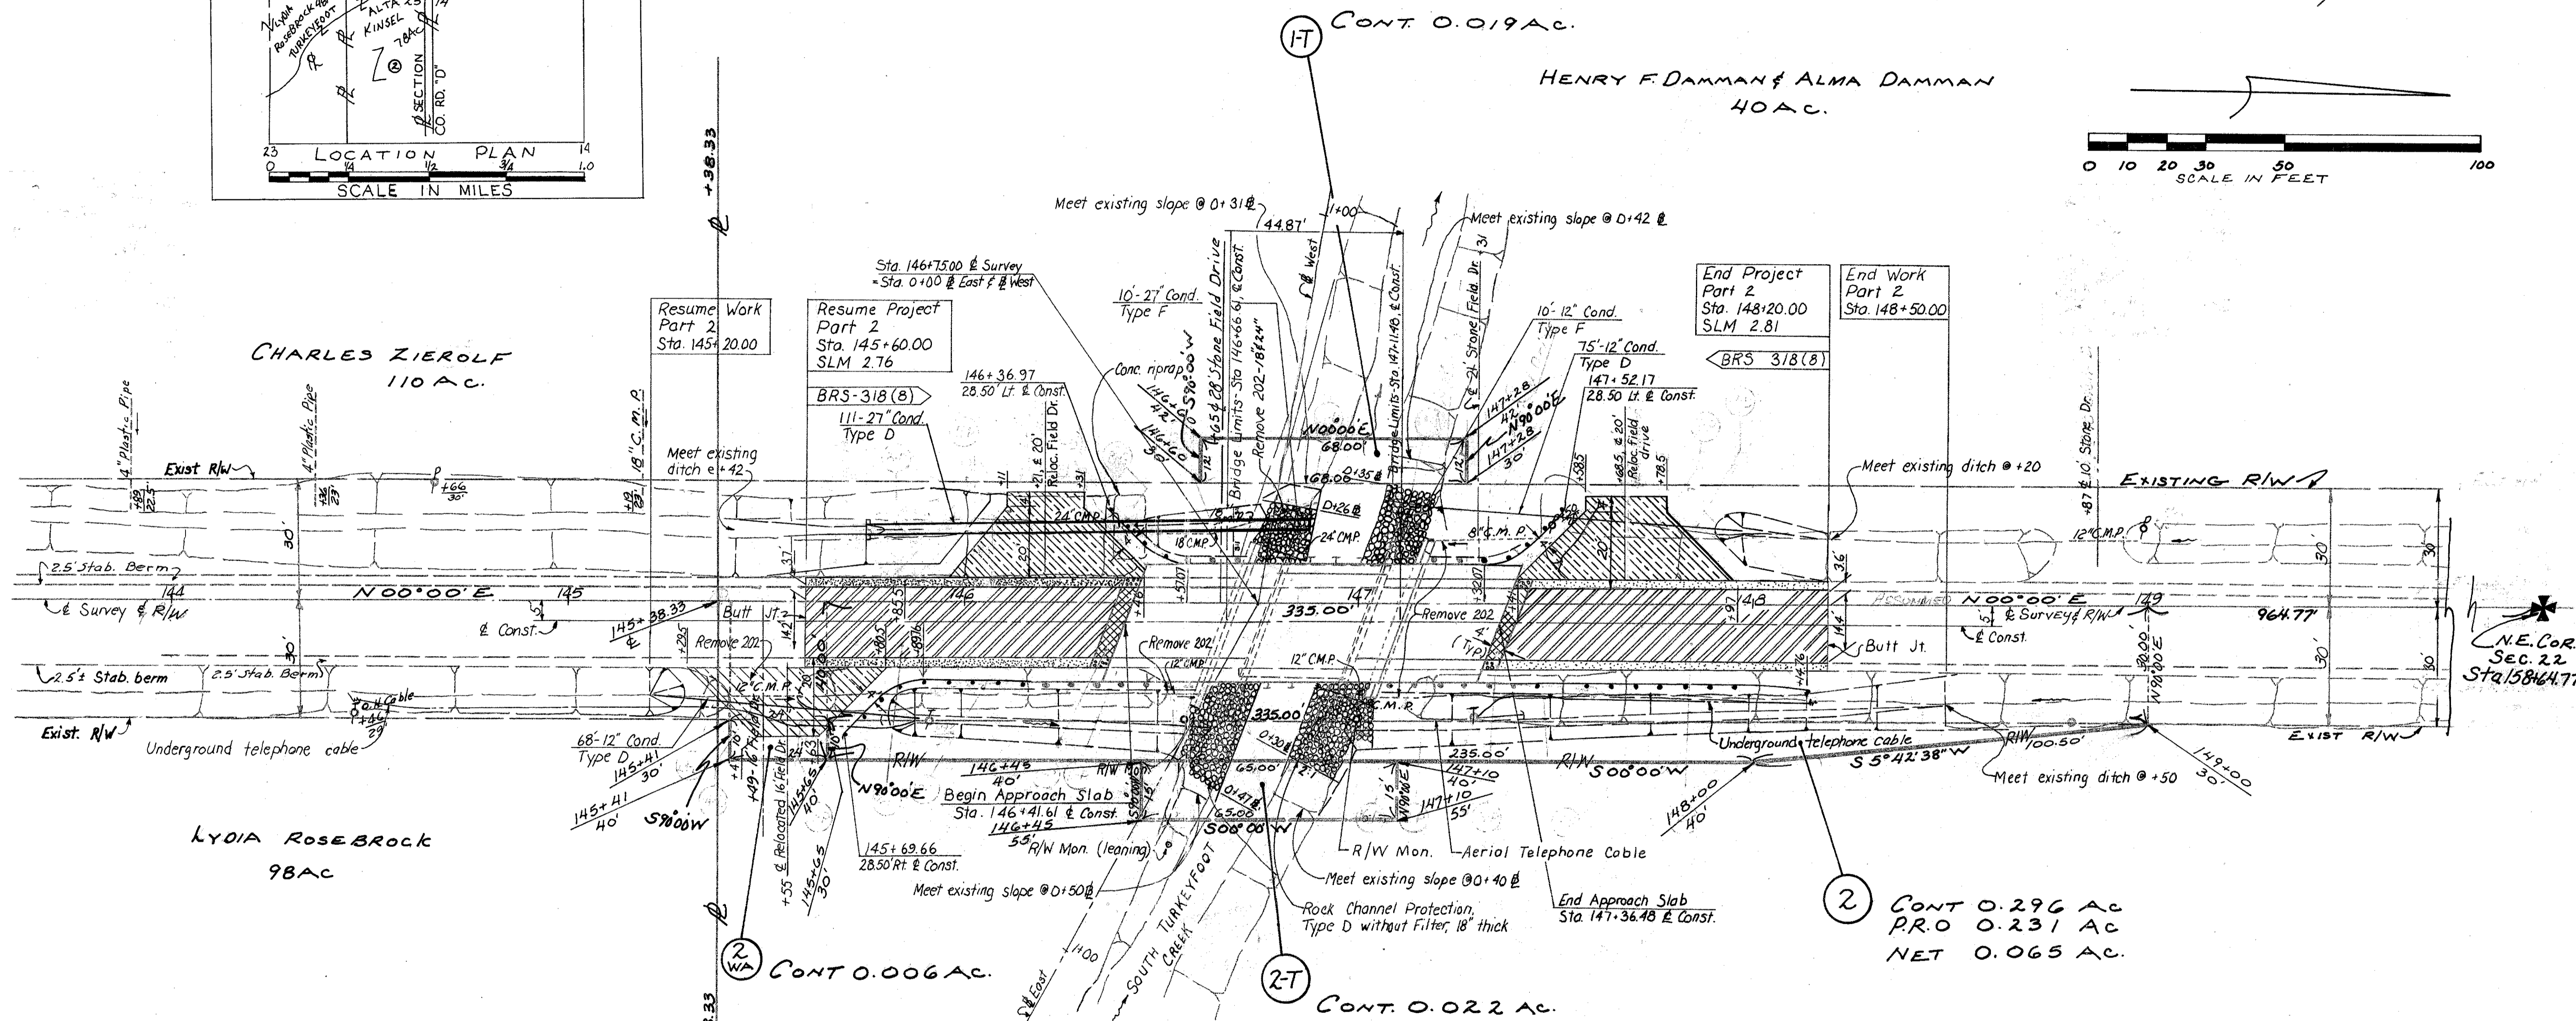

2 CONT 0.296 AC
 P.R.O 0.231 AC
 NET 0.065 AC.

RIGHT OF WAY SUMMARY

PARCEL No	OWNER	DEED RECORD		DEED AREA ACRES	TOTAL PRO ACRES	TOTAL TAKE ACRES	PRO IN TAKE ACRES	NET TAKE ACRES	RESIDUE ACRES	REMARKS
		VOL.	PAGE							
1-T	HENRY F & ALMA DAMMAN	148	373	40.0	Co 0.888 ST 0.909	0.019	0.00	0.019	39.981	TO GRADE DITCH
2	ALTA KINSEL, ET AL	222	937	78.0	Co 0.888 ST 0.909	0.296	0.231	0.065	77.935	AS ACQUIRED
2-T	"	"	"	"	"	0.022	0.00	0.022		TO GRADE DITCH
2-WA	"	"	"	"	"	0.006	0.00	0.006		TO BUILD DRIVE

COMPLETED		
DATE	PAR.	REMARKS