

MAINTENANCE PROGRAM 1982

PART \_\_\_\_\_  
OF \_\_\_\_\_

(TOP) TYPE 404 THICKNESS 1 1/8" PRIORITY 25

(BASE) TYPE \_\_\_\_\_ THICKNESS \_\_\_\_\_ PENETRATION \_\_\_\_\_

END LOG S.L.M. 23.91 ( Fulton Co Line Const Joint )

BEGIN LOG S.L.M. 21.40 ( Liberty Center NCL Const Joint )

P. K. Nail = L.C. N. Corp Line = 1129+92.0

TOTAL LENGTH 2.51

COUNTY Henry SECTION 210 WIDTH (18) 18.5 BERM CURBED  ( )

ROUTE 109 SECTION 23.91 mi WIDTH (18.5) ( ) ( )

SECTION \_\_\_\_\_ WIDTH ( ) ( ) ( )

ORDINANCE \_\_\_\_\_ SECTION \_\_\_\_\_ WIDTH ( ) ( ) ( )

END LOG \_\_\_\_\_ SECTION \_\_\_\_\_ WIDTH ( ) ( ) ( )

BEGIN LOG \_\_\_\_\_ SECTION \_\_\_\_\_ WIDTH ( ) ( ) ( )

EXISTING BERM TYPE stn EXISTING BERM WIDTH ± 2' MAILBOX APPROACHES No. \_\_\_\_\_

(PAVED, STABILIZED, AGGREGATE)

MANHOLES \_\_\_\_\_

PROPOSED BERM TYPE \_\_\_\_\_ PROPOSED BERM WIDTH \_\_\_\_\_ X INLETS CATCH BASINS \_\_\_\_\_

INTERSECTIONS 3-2 WAY ASPHALT DRIVEWAYS 7 CONCRETE DRIVEWAYS 6

STRUCTURES

STRUCTURE NO.	WIDTH	LENGTH	APPR. SLABS

RAILROAD CROSSINGS

NAME R. R.	STATION	( )	( )	No.	TRACKS


\*Indicate length of crossing along  $\xi$  Pav't.  
 Raised Pavement Markers \_\_\_\_\_ Locations  
 Edge Pav't. No. \_\_\_\_\_  
 Centerline Pav't. No. \_\_\_\_\_

NOTES


Liberty Center North Corp Sign = STA 1129+65  
Const. Joint = STA 1130+00  
23' Pav't width @ 1129+92 (1981 project)  
CONST. JOINT = STA 1262+40

PERSONNEL TITLE PERSONNEL TITLE COUNTY Henry DATE 10-1-81  
 Hoffmann \_\_\_\_\_  
 Loehrke \_\_\_\_\_ S. R. 109 WEATHER Part  
 Haushalter \_\_\_\_\_ SEC. 21.40-23.91 TEMP. 55°

DESCRIPTION 1982 Resurfacing JOB NO. \_\_\_\_\_  
 LEFT CENTER LINE RIGHT

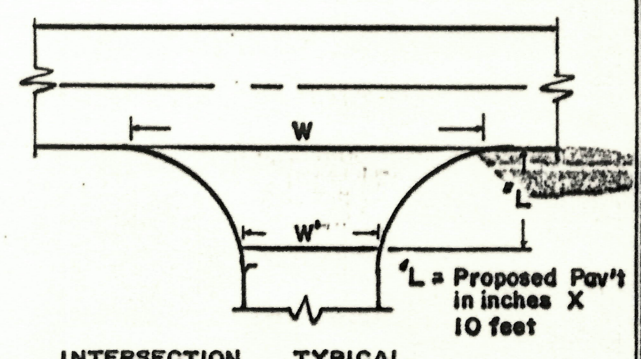

INTERSECTION TYPICAL

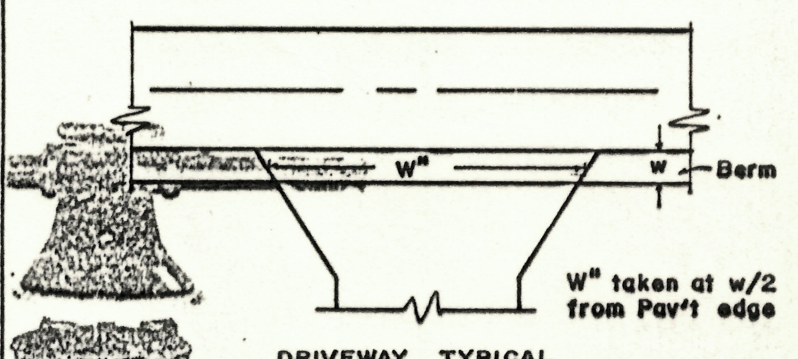

DRIVEWAY TYPICAL

STATION	RT. LT.	L	W	W'	Asph	Conc		STATION	RT. LT.	w	W'	Asph	Conc	Aggr	Dropped Curb Feather NOT Req'd
1156+34	RT	15	65	30	✓	Co.	Rd.	1131+84	LT	2	28	✓			
"	LT	15	52	24	✓		"u"	1134+25	LT	2	33	✓			
								1134+77	LT	2	26		✓		
1204+61	RT	15	67	25	✓	Co.	Rd.	1135+20	LT	2	29		✓		
"	LT	15	82	38	✓		"v"	1136+93	LT	2	37		✓	Drive 15' Low - Feather	
								1174+82	LT	2	38	✓			
1207+00	RT	15	80	38	✓	Heft	at w"	1196+86	LT	2	26	✓			
"	LT	15	95	38	✓	FT	at w"	1198+78	LT	2	30	✓			
							County Line	1208+34	LT	2	28	✓			
								1231+36	RT	2	42		✓		
								1231+92	RT	2	42		✓		
								1240+23	LT	2	49	✓			
								1250+45	RT	2	37		✓		