

# O.D.O.T. DISTRICT 2 SURVEY OFFICE (USE ONLY)

PERSONNEL

REFERENCE NO.   A  

SHEET  16  OF  25 

NOTES   BARRIERE    
 H.C.   MILLER    
 R.C.   BARRIERE  

DATE   10/4/24    
 WEATHER   CLEAR    
 TEMP.   63°  

ROUTE   SR 109    
 COUNTY   HENRY    
 TOWNSHIP   MARION    
 SECTION   10  

DWG BY   BARRIERE   PID   99587  

T   3   N R   7   E

TYPE MONUMENT   MAG NAIL/WASHER  

ON SURFACE - BELOW   ON  

OFFSET  $\odot$  PAVEMENT                      LT : RT


           TO            EDGE PAVEMENT

STATION:   241+38  

HORIZ.DATUM:   OHIO LDP (HENRY)   GEOID:           18  

GRID: NORTHING:                      EASTING:                     

LDP: NORTHING:                      EASTING:                     

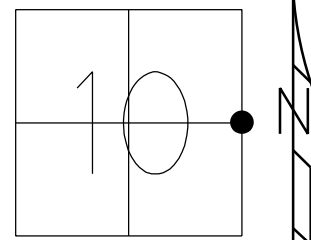

RECORD:  
 FD 1/23/07  
 SET P.K./WASHER  
 9/24/98, MRC  
 FD P.K./WASHER  
 3" DOWN  
 REF 24  
 6/26/08, KPM  
 FD MAG/WASHER  
 REF10  
 2/14/19, JLL  
 FD MAG/WASHER  
 REF24  
 6/27/22, JFO  
 1/11/23, JMR  
 SET MAG/WASHER  
 REFA  
 10/4/24, JAM

