


O.D.O.T. DISTRICT 2 SURVEY OFFICE (USE ONLY)

PERSONNEL _____ REFERENCE NO. 11 A SHEET 18 OF 26
 NOTES CANTERBURY DATE 08-18-1998 ROUTE SR 109
 H.C. ROUSOS WEATHER PRTLY CLDY COUNTY HENRY
 R.C. BARNHISEL TEMP. +80°F TOWNSHIP MARION
 _____ SECTION 3
 _____ T 3 N R 7 E


TYPE MONUMENT RR SPK IN WOOD HUB
~~ON SURFACE~~ - BELOW 2"
 LEFT - ~~PAV'T~~ - RIGHT 20.3'
10' TO LT EDGE PAVEMENT
 S.L.M. 565+27

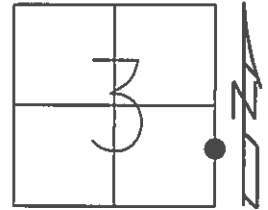

Grid: Northing: _____ Easting: _____

FND SM RR SPK 05-1998

REC:
 FND SMALL RR SPK SET IN
 WOOD HUB 2" BELOW SURFACE
 10' W OF W E.P. E 20.3' W.
 OF C PVMT. SR 18/109

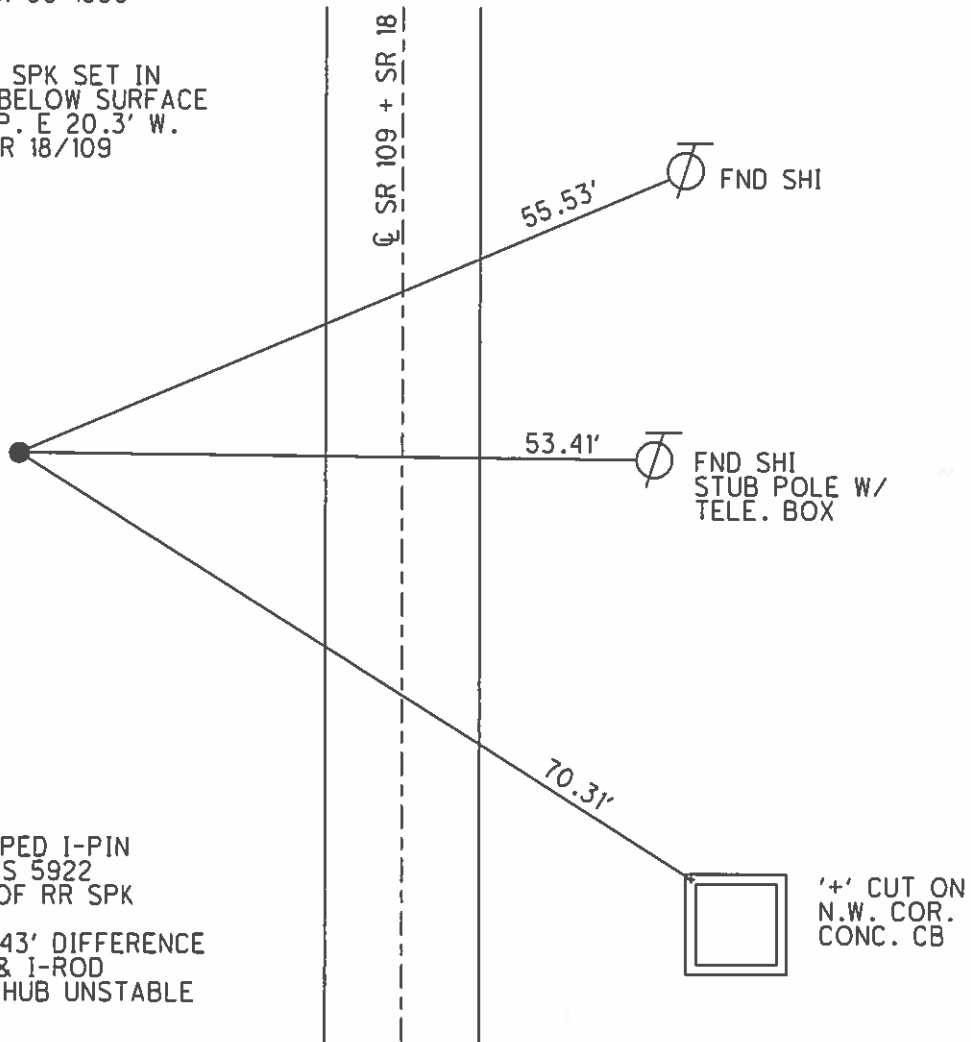

NOTE:
 ALSO FND CAPPED I-PIN
 STAMPED # RLS 5922
 3.5" TO N.E. OF RR SPK

THERE IS A 0.43' DIFFERENCE
 BETWEEN SPK & I-ROD
 SMALL SPK IN HUB UNSTABLE

O.D.O.T. DISTRICT 2 SURVEY OFFICE

PERSONNEL _____

REFERENCE NO. 11A

SHEET 14 OF 21

NOTES Canterbury

H.C. Rousar

R.C. Barnhill

DATE 8-18-98

WEATHER Partly Cldy

TEMP. +80°F

ROUTE SR 109 + 18

COUNTY Henry


TOWNSHIP Marion

SECTION 3

T 3 N 7 E

TYPE MONUMENT Sm. RR spike in wood hub
~~ON SURFACE~~ - BELOW 2" Below
 LEFT- & PAV'T. ~~RIGHT~~ 20, 3' W of &
10' ETO W EDGE PAVEMENT

S.L.M. 17 + 229 SLM (MEASURED STA 565+27)

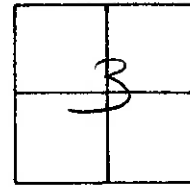

280+98/5.32

OFF PAVEMENT


Note:

Also Found capped I-pin
 STAMPED *RLS 5922
 3.5" to N.E. of RR spike

* THERE IS A 0.43' DIFFERENCE
 BETWEEN SPIKE & I-ROD
 - SMALL SPIKE IN HUB IS UNSTABLE

RECORD:

FIND, SMALL RR SPIKE SET IN
 WOOD HUB 2" BELOW SURFACE
 10' W. OF W. E.P. & 20, 3' W.
 OF & PAVT. SR 18/109

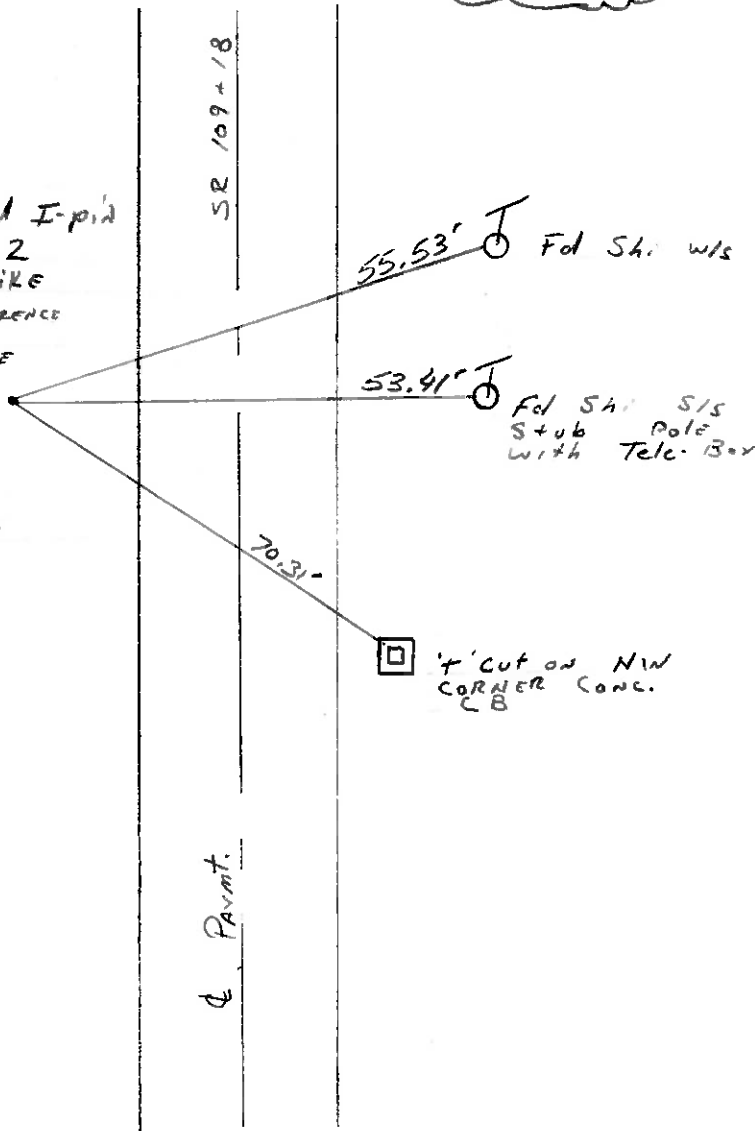

QD.O.T. DISTRICT 2 SURVEY OFFICE

SHEET _____ OF _____

County HENRY S.R. 18/109

Township MARION

Section 3

T3N, R7E

Personnel HOFFMAN

LOEHRKE

HOUSEHOLDER


BARNHISEL

#11-A
SE109

Date 4/25/83

Weather CLEAR

Temp. +60°

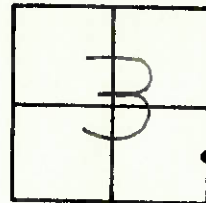

FD. SMALL R.R. SPK. SET
IN WOOD HUB 2"
BELOW SURFACE
10' WEST OF WEST E.P. &
20.3' WEST OF & PAVT.
S.R. 18/109
S.L.M. STA. 565+02±

MEASURED
STA. 565+27

