


O.D.O.T. DISTRICT 2 SURVEY OFFICE (USE ONLY)


PERSONNEL _____ REFERENCE NO. 15 SHEET 23 OF 25
 NOTES NIESE DATE 3/12/21 ROUTE SR 109
 H.C. RHOADES WEATHER SUNNY COUNTY HENRY
 R.C. _____ TEMP. 50° TOWNSHIP MONROE
 DWG BY NIESE PID PAVE TRAIN SECTION 34
 T 4 N R 7 E

TYPE MONUMENT P.K.NAIL
~~ON SURFACE~~ - BELOW 1/2"
 OFFSET \odot PAVEMENT 7.5' LT : ~~RT~~
2.1' TO LT EDGE PAVEMENT
 STATION: 344+03

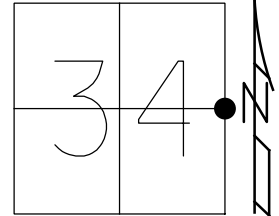

HORZ.DATUM: NAD83 2011 GEOID: NAVD88 2012A
 GRID: NORTHING: 584682.087 EASTING: 1546062.452


RECORD:
 FD P.K./WASHER
 5/18/98, MC
 FD SM.R.R.SPIKE
 SET SM.R.R.SPIKE
 9/28/98, MDB
 FD P.K.NAIL
 0.5' DOWN
 2/25/19, JLL
 REF15
 6/9/20, JFO
 3/12/21, JMR

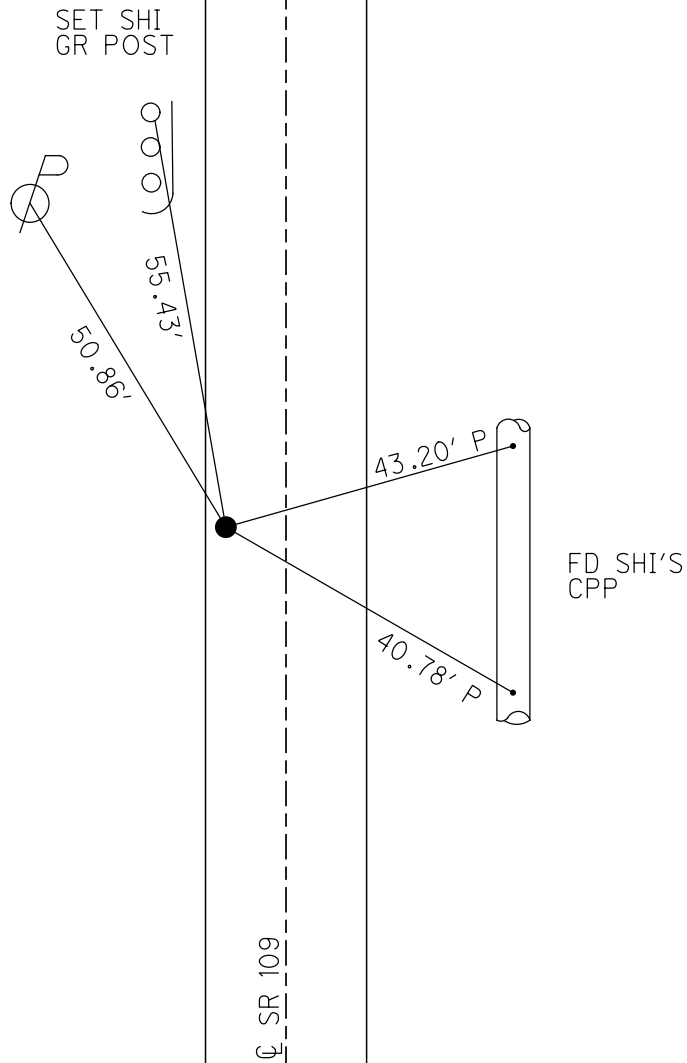

O.D.O.T. DISTRICT 2 SURVEY OFFICE (USE ONLY)

PERSONNEL _____ REFERENCE NO. 15 SHEET 23 OF 26
 NOTES CANTERBURY DATE 05-18-1998 ROUTE SR 109
 H.C. ROUSOS WEATHER SUNNY COUNTY HENRY
 R.C. HUSS TEMP. 80°F TOWNSHIP MONROE
 _____ SECTION 34
 _____ T 4 N R 7 E


TYPE MONUMENT PK & WASHER
 ON SURFACE - ~~BELOW~~ ON
 LEFT - ☉ PAV'T - ~~RIGHT~~ 7.5'
2.1' TO LT EDGE PAVEMENT
 S.L.M. 344+03

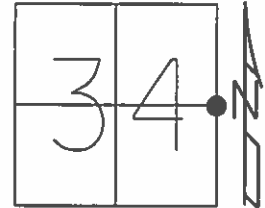

Grid: Northing: _____ Easting: _____

FND SMALL RR SPK

SET SM. RR SPK
 09-28-1998
 M.D.B.

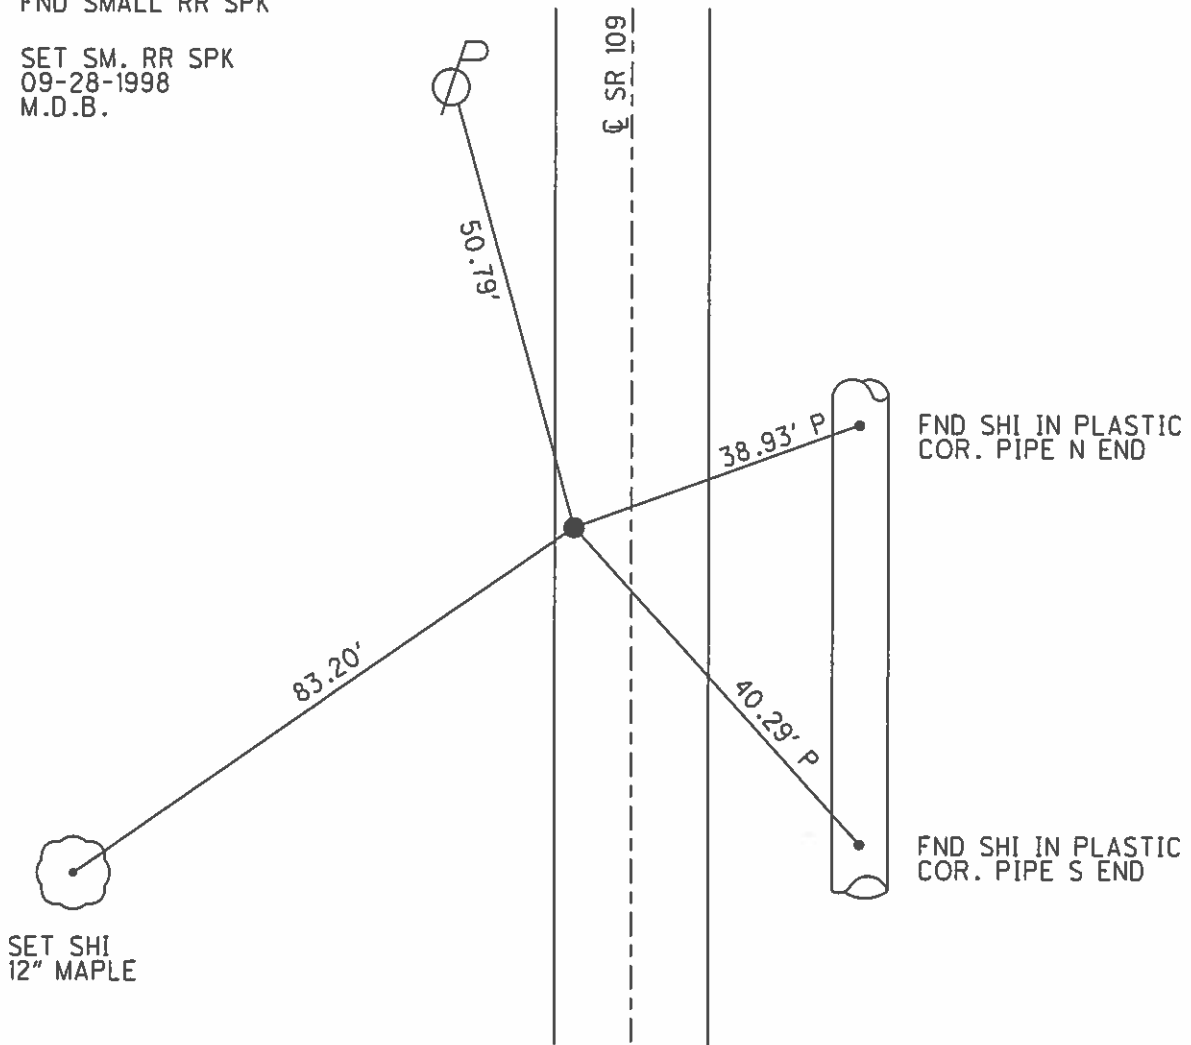

O.D.O.T. DISTRICT 2 SURVEY OFFICE

PERSONNEL

REFERENCE NO. 15

SHEET 18 OF 21

NOTES CANTERBURY

H.C. Rausos

R.C. Huss

DATE 5-18-98

WEATHER SUNNY

TEMP. +80°F

ROUTE 109


COUNTY HENRY

TOWNSHIP MONROE

SECTION 34


T4 N R 7 E

TYPE MONUMENT P.K. & Washer
 ON SURFACE - ~~BELOW~~ Surface
 LEFT- ~~of~~ PAV'T. RIGHT 7.56 of & Pymt.
2.1 TO LT EDGE PAVEMENT
 S.L.M. 10 + 467 SLK (Sta 344.03 km)

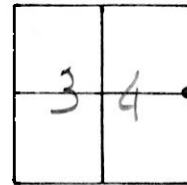

FND. Small RR spike

Set Sm RR spk
 9-28-98
 MDB

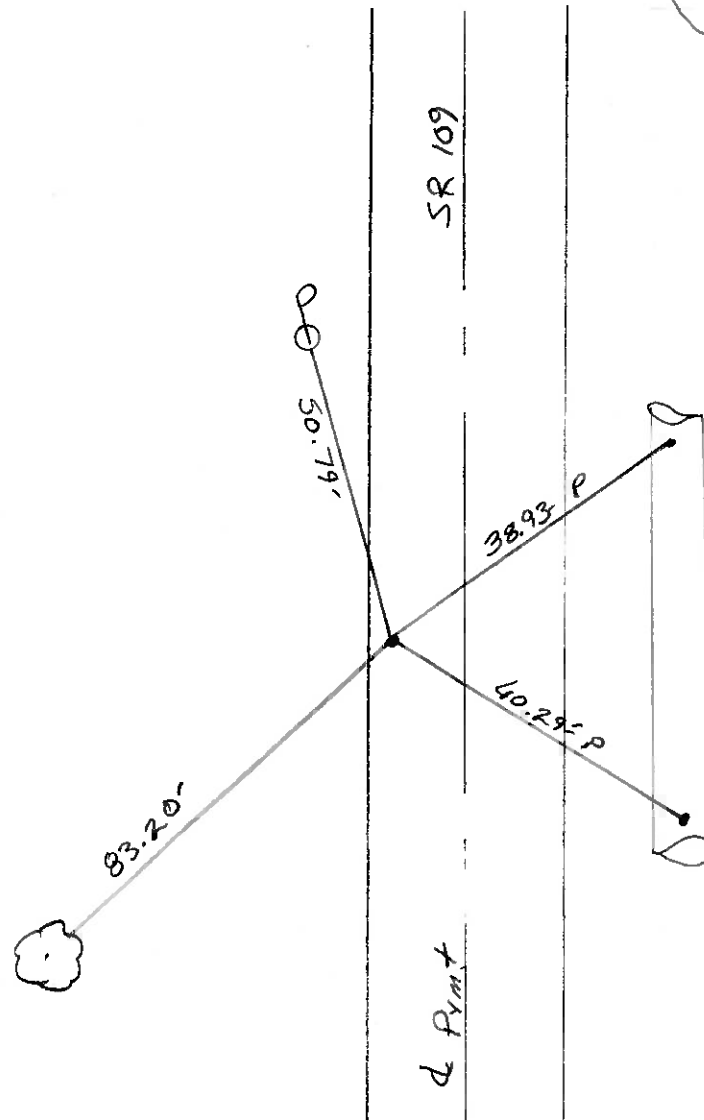

Set Shi
 N/E SIDE 12"
 Maple

Fnd. N+Shi in H. Side
 of 12" Plastic Cor. pipe

Fnd. N+Shi in
 Plastic Cor. Pipe S END

Drawn By TR

O.D.O.T. DISTRICT 2 SURVEY OFFICE

PERSONNEL

REFERENCE NO. 15

SHEET 18 OF _____

NOTES BARNHISEL

H.C. " "

R.C. Loehke

DATE 3-30-89

WEATHER RAIN

TEMP. +40°

ROUTE 109

COUNTY HENRY

TOWNSHIP MONROE

SECTION 34

T 4 N R 7 E



TYPE MONUMENT P.K. & WASHER

ON SURFACE - BELOW YES

LEFT - 0 PAV'T. - RIGHT 7.5

1.7 TO LT. EDGE PAVEMENT

S.L.M. 344 + 03

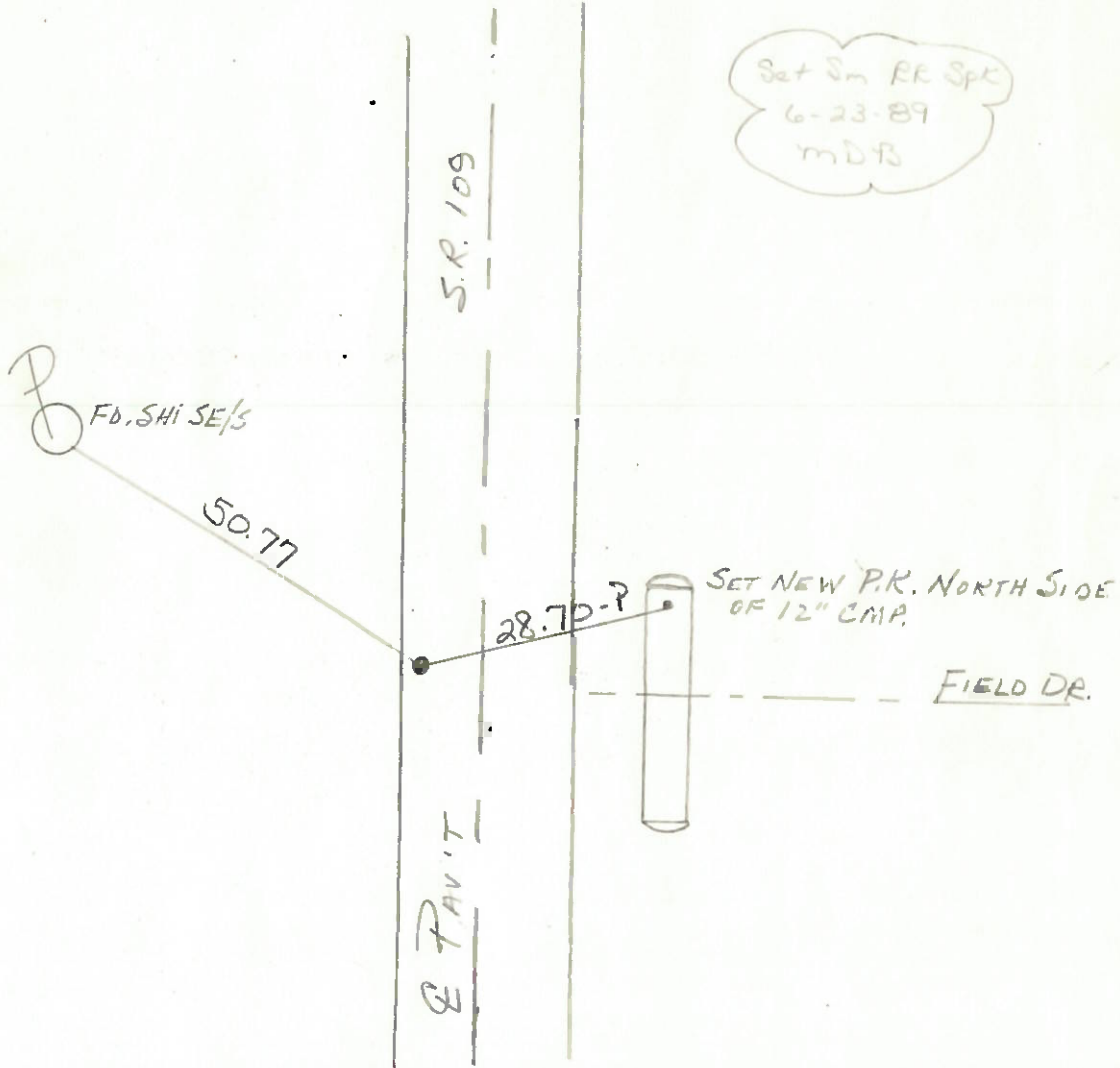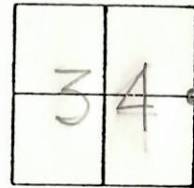

Q.D.O.T. DISTRICT 2 SURVEY OFFICE

SHEET _____ OF _____

County HENRY S.R. 109

Date April 26, 83

Township MONROE

Weather CLEAR

Section 34

Temp. +65°


T4N, R7E

Personnel HOFFMAN

LOEBKE


DARNHISEL

15

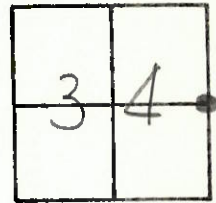

Fd R.R. spk @ surface, SET BY COUNTY
 7.4' Lt. of & PAUT
~~1.8' to wt. EP.~~
 4.5' EAST OF WEST E.P.


SLM 343 +32
 SET. P.K./WASHER
 9-19-83
 SWH

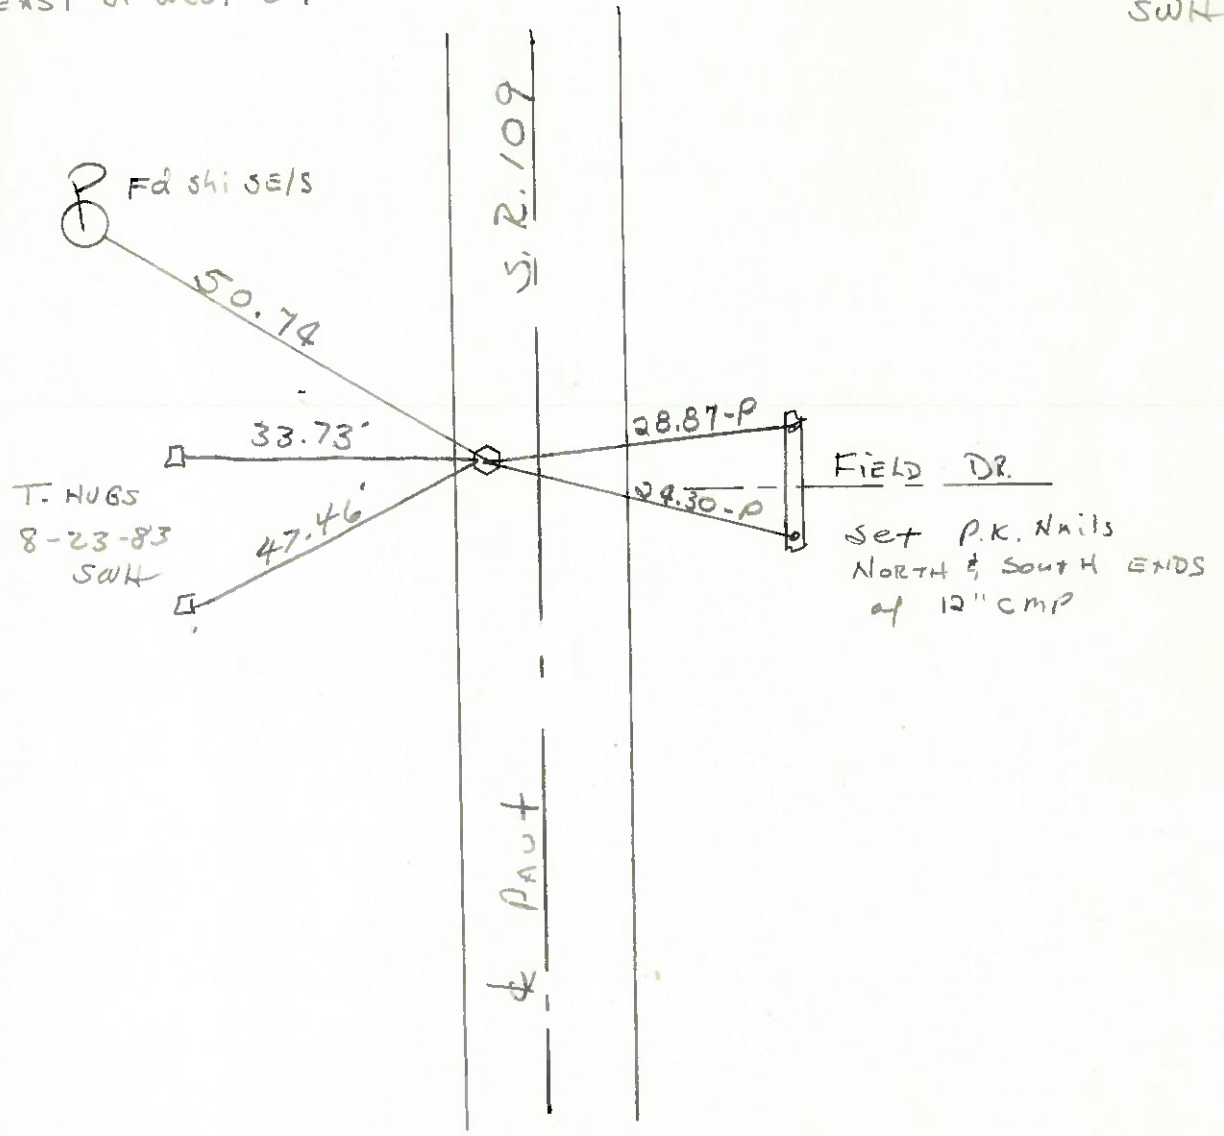

PERSONNEL	TITLE	PERSONNEL	TITLE
Tomsic			
Neuser			
Starr			
Tracy			

COUNTY Henry DATE Nov. 1, 1973
 S. R. 109 WEATHER _____
 SEC. MONROE TWP. TEMP _____

DESCRIPTION _____ LEFT _____ CENTER LINE _____ RIGHT _____ JOB NO. _____

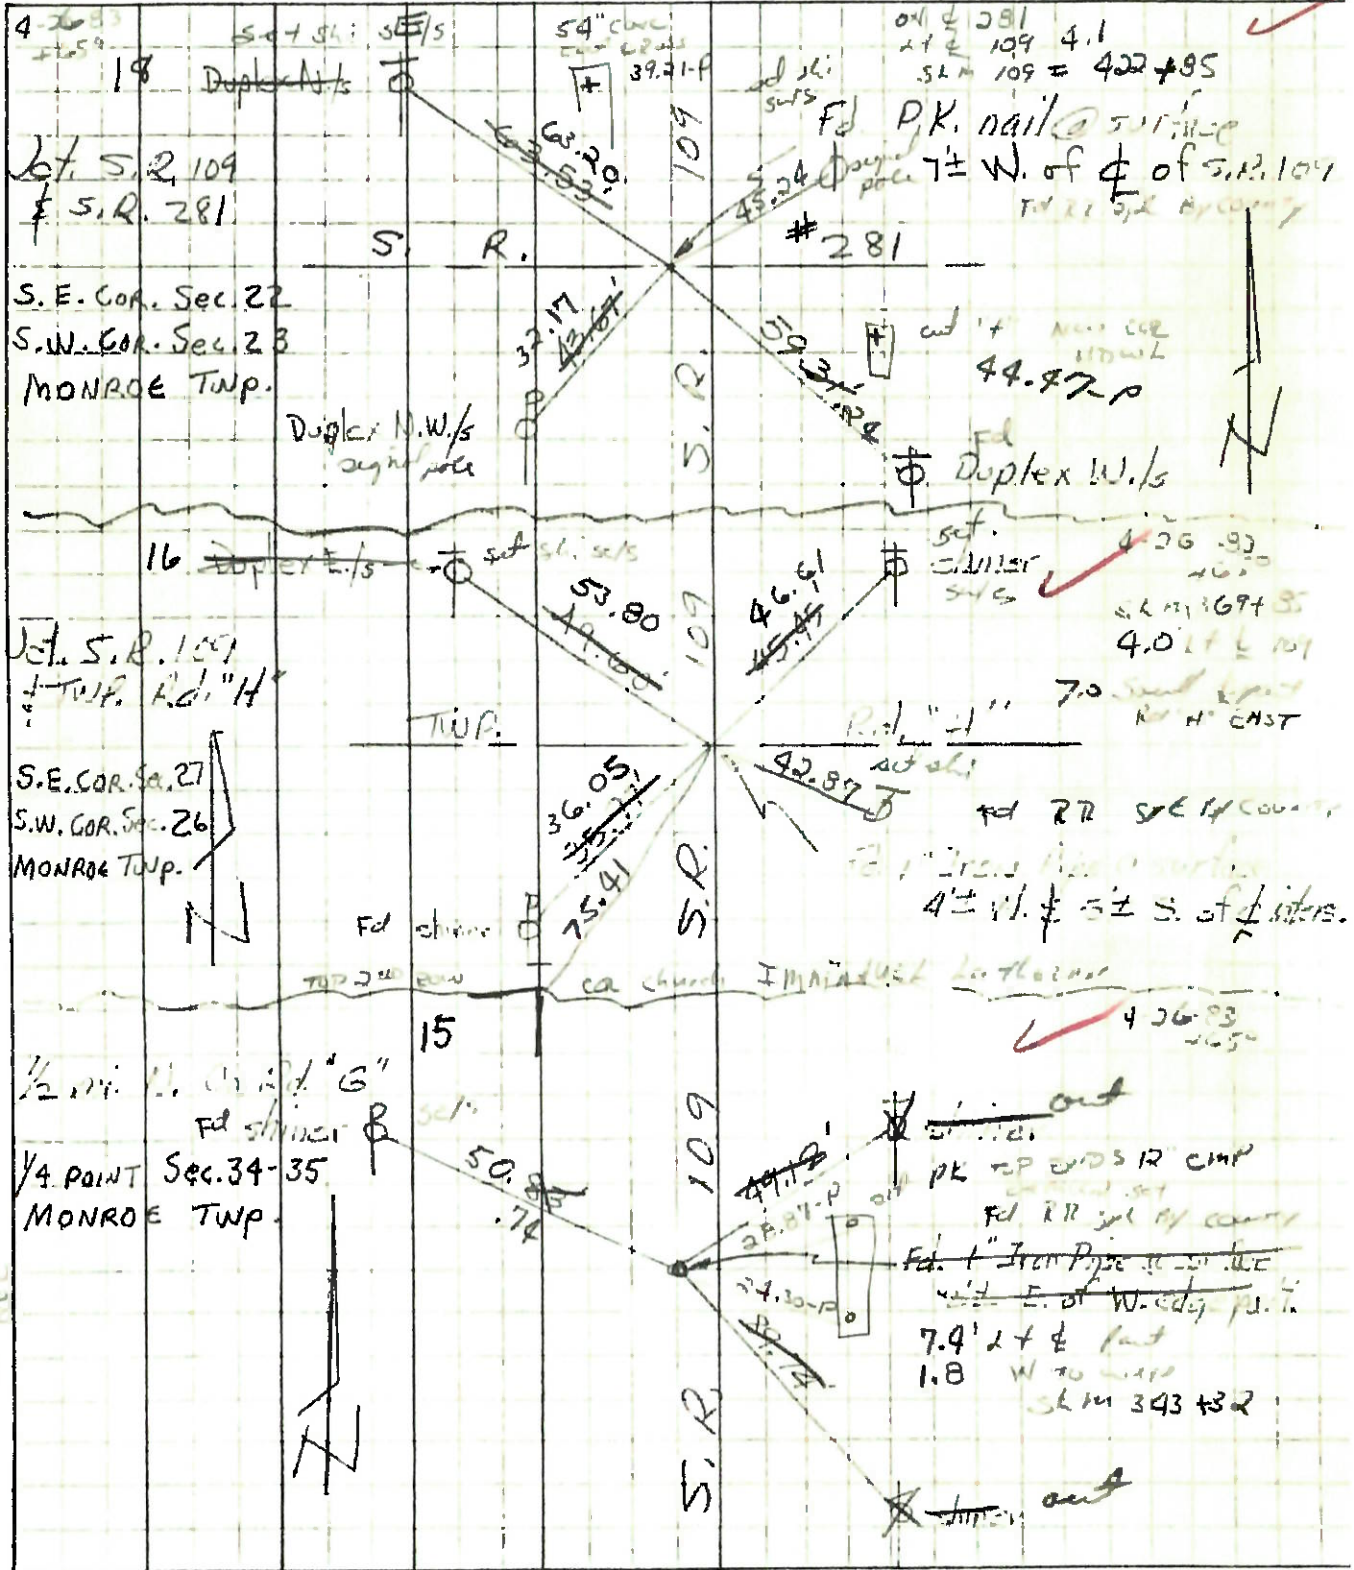

36.30
 11.30