


O.D.O.T. DISTRICT 2 SURVEY OFFICE (USE ONLY)


PERSONNEL _____ REFERENCE NO. 18 SHEET 1 OF 38
 NOTES NIESE DATE 3/12/21 ROUTE SR 109
 H.C. RHOADES WEATHER SUNNY COUNTY HENRY
 R.C. _____ TEMP. 50° TOWNSHIP MONROE
 _____ SECTION 27
 DWG BY NIESE PID PAVE TRAIN T 4 N R 7 E

TYPE MONUMENT LG.R.R.SPIKE
~~ON SURFACE~~ - BELOW 1"
 OFFSET \odot PAVEMENT 8.0' LT : ~~RT~~
 - TO - EDGE PAVEMENT
 STATION: 423+58

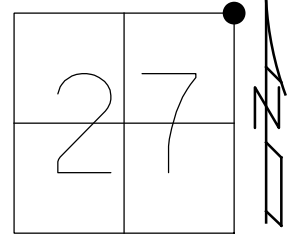

HORZ.DATUM: NAD83(2011) GEOID: NAVD88 2012A
 GRID: NORTHING: 592634.341 EASTING: 1546102.916

RECORD:
 FD SM. RR. SPIKE
 SET P.K./WASHER
 9/2/98, MB
 FD R.R.SPIKE
 2" DOWN
 9/2/15, JFO
 8/3/16, JMR
 FD SM.R.R.SPIKE
 1.5" DOWN
 2/25/19, JLL
 1" DOWN
 REF18
 6/9/20, JFO
 3/12/21, JMR

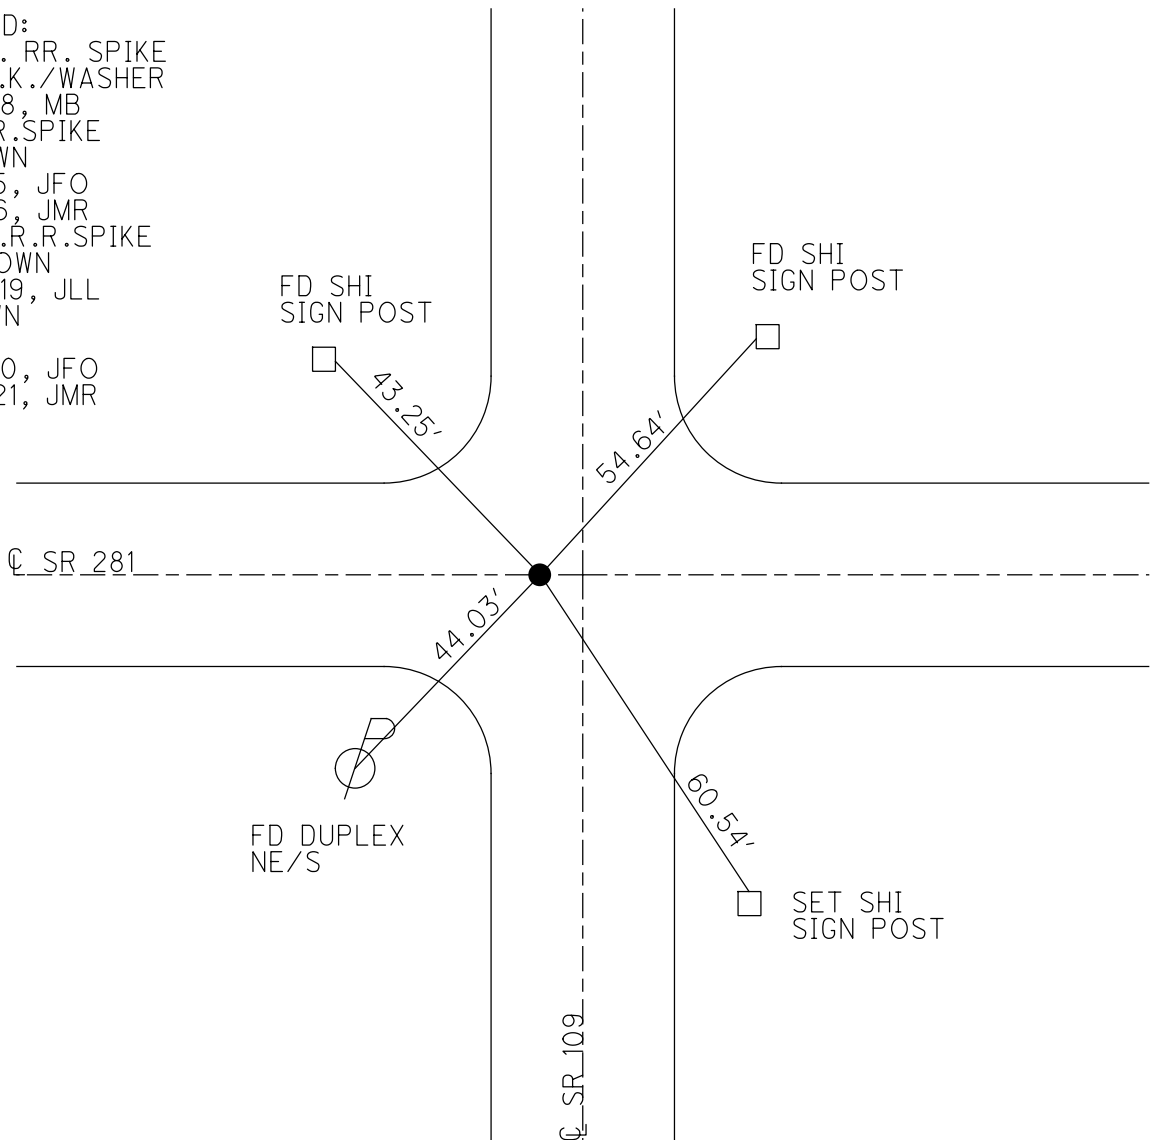

O.D.O.T. DISTRICT 2 SURVEY OFFICE (USE ONLY)

PERSONNEL

REFERENCE NO. 18

SHEET 1 OF 38

NOTES RHOADES

DATE 6/9/20

ROUTE SR 109

H.C. O'DONNELL

WEATHER SUNNY

COUNTY HENRY

R.C. RHOADES

TEMP. 90°

TOWNSHIP MONROE

DWG BY RHOADES

PID PAVE TRAIN

SECTION 27

T 4 N R 7 E

TYPE MONUMENT LG.R.R.SPIKE

~~ON SURFACE~~ - BELOW 1"

OFFSET Q PAVEMENT 8.0' LT : ~~RT~~

- TO - EDGE PAVEMENT


STATION: 423+58

HORZ.DATUM: NAD83 (2011)


GEOID: NAVD88 2012A

GRID: NORTHING: 592634.343

EASTING: 1546102.917

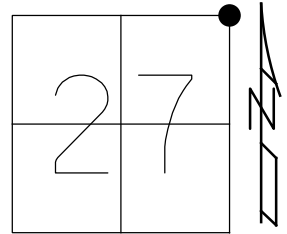

RECORD:
 FD SM. RR. SPIKE
 SET P.K./WASHER
 9-2-98, MB
 FD R.R.SPIKE
 2" DOWN
 9-2-15, JFO
 8-3-16, JMR
 FD SM.R.R.SPIKE
 1.5" DOWN
 2-25-19, JLL
 1" DOWN
 REF18
 6/9/20, JFO

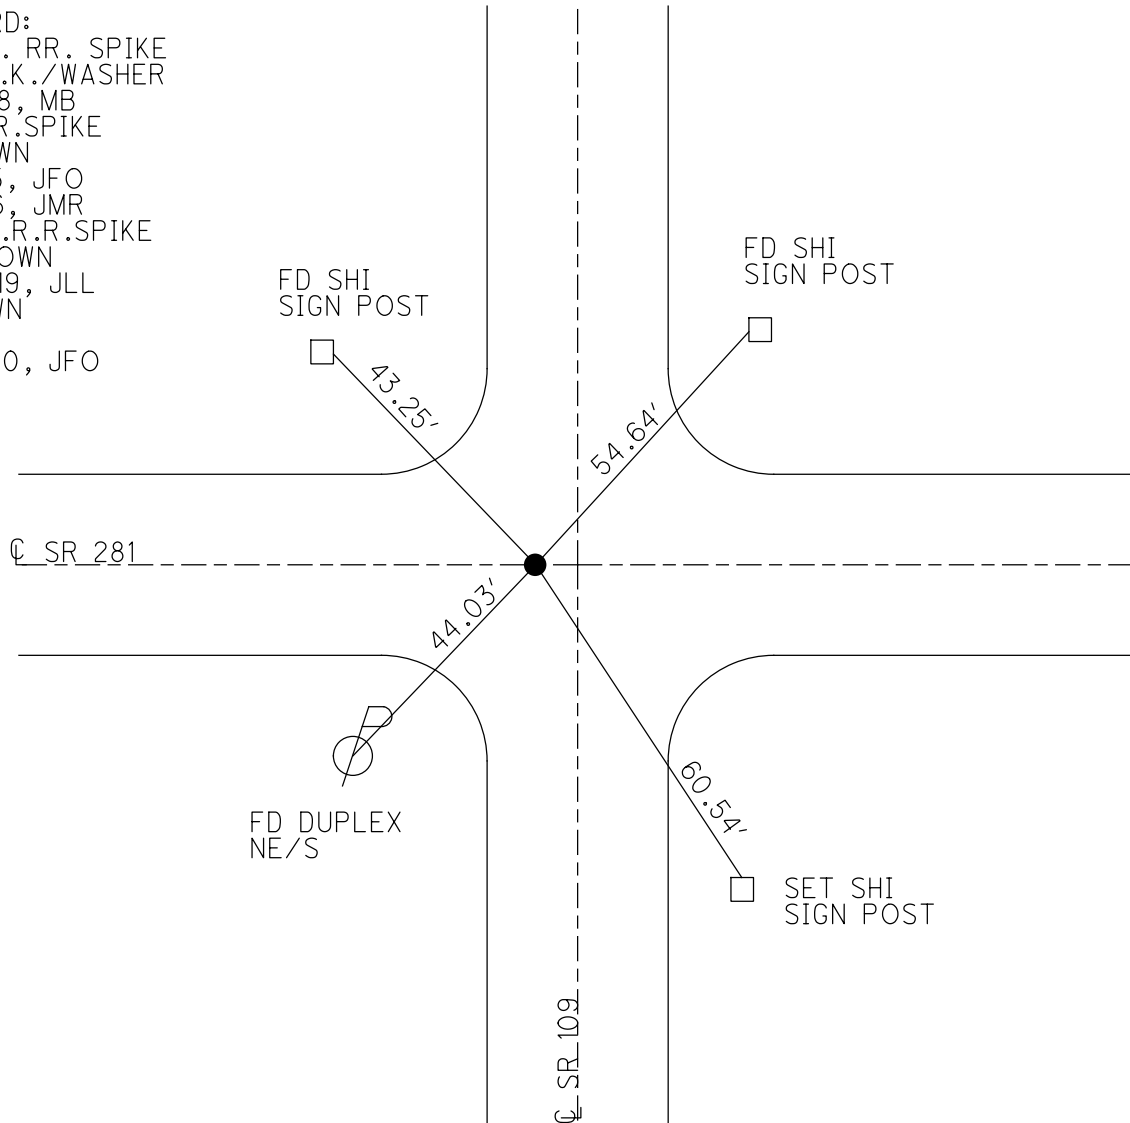


O.D.O.T. DISTRICT 2 SURVEY OFFICE (USE ONLY)

PERSONNEL _____ REFERENCE NO. 18 SHEET 1 OF 38

NOTES CANTERBURY DATE 5-18-98 ROUTE SR 109
 H.C. ROUSUS WEATHER CLOUDY COUNTY HENRY
 R.C. HUSS TEMP. 80°F TOWNSHIP MONROE
 SECTION 27
 T 4 N R 7 E

TYPE MONUMENT PK/WASHER
 ON SURFACE - ~~BELOW~~ ON _____
 LEFT - Q PAV'T - ~~RIGHT~~ 8.0'
 - TO - EDGE PAVEMENT
 S.L.M. 423+58

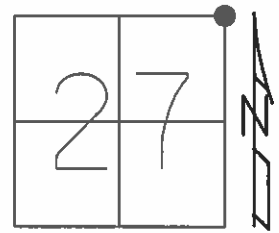


Grid: Northing: 592634.2994 Easting: 1546103.0132

RECORD:
 FD SM. RR. SPIKE
 SET BY MDB

SET PK/WASHER
 9-2-98, MB

FD RR. SPK
 2" BELOW
 GPS, REG18
 9-2-15, JFO

NOT COVERED
 8-3-16 JMR

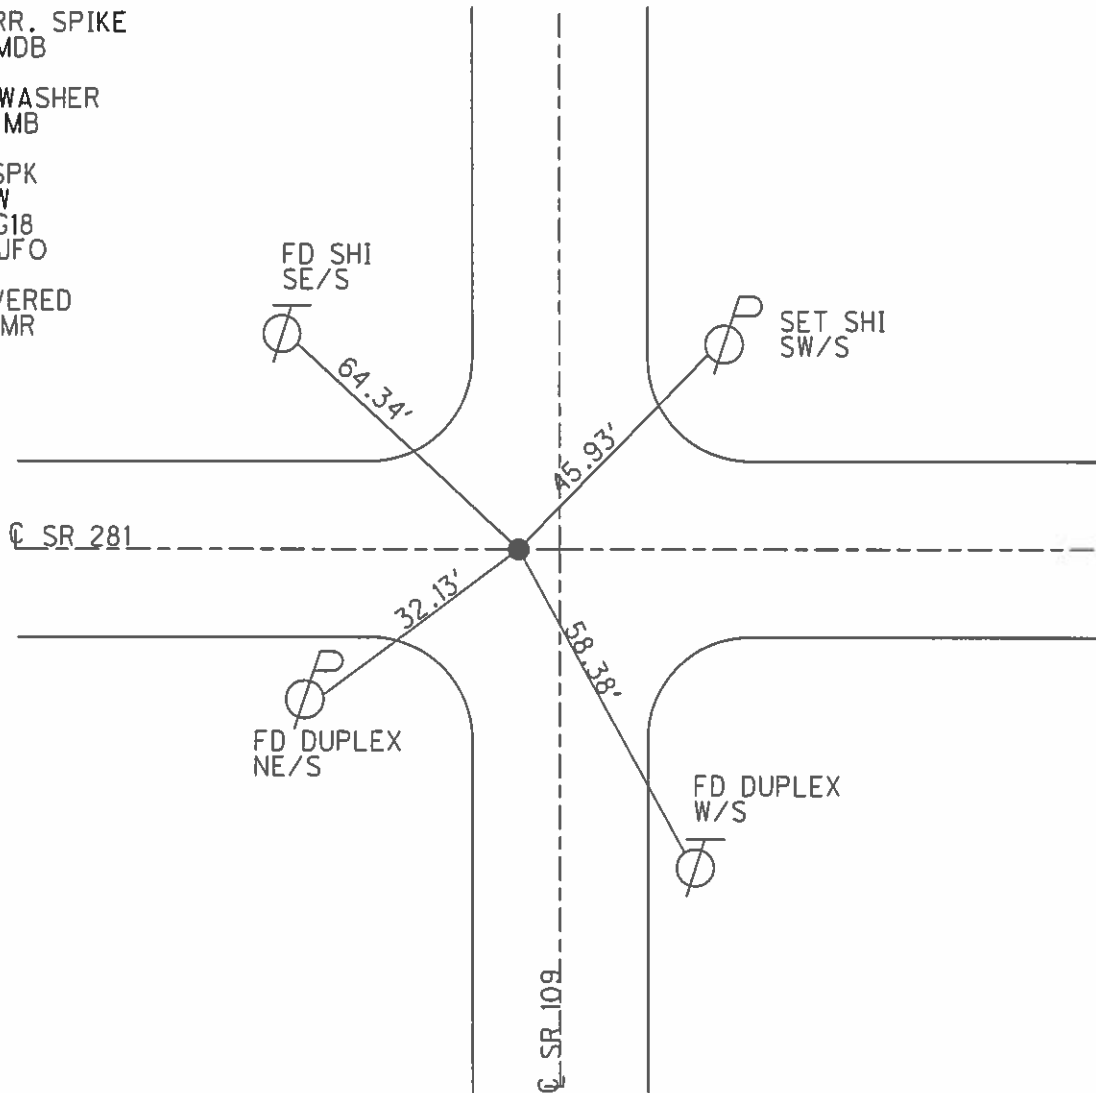

O.D.O.T. DISTRICT 2 SURVEY OFFICE

PERSONNEL _____

REFERENCE NO. 18

SHEET 21 OF 21

NOTES Canterbury

H.C. Rouss

R.C. Huss

DATE 5-18-98

WEATHER Cloudy

TEMP. +80°F

ROUTE 109

COUNTY Henry

TOWNSHIP MONROE

SECTION 27

T 4 N R 7 E


TYPE MONUMENT PK & WASHER

ON SURFACE - ~~BELOW~~ ON SURFACE

LEFT - Q PAV'T. - ~~RIGHT~~ 20 ft of SR 109 & Rmt


~~TO~~ EDGE PAVEMENT ON Q of Rmt. SR 281

S.L.M. 12+899 sck (423+58 sck)

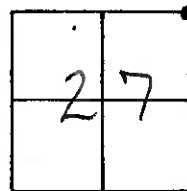

Fnd. Sm. RR spk. @ Surface
Set by MDB on 6-23-89

RESET PK & WASHER
9-23-98
MB

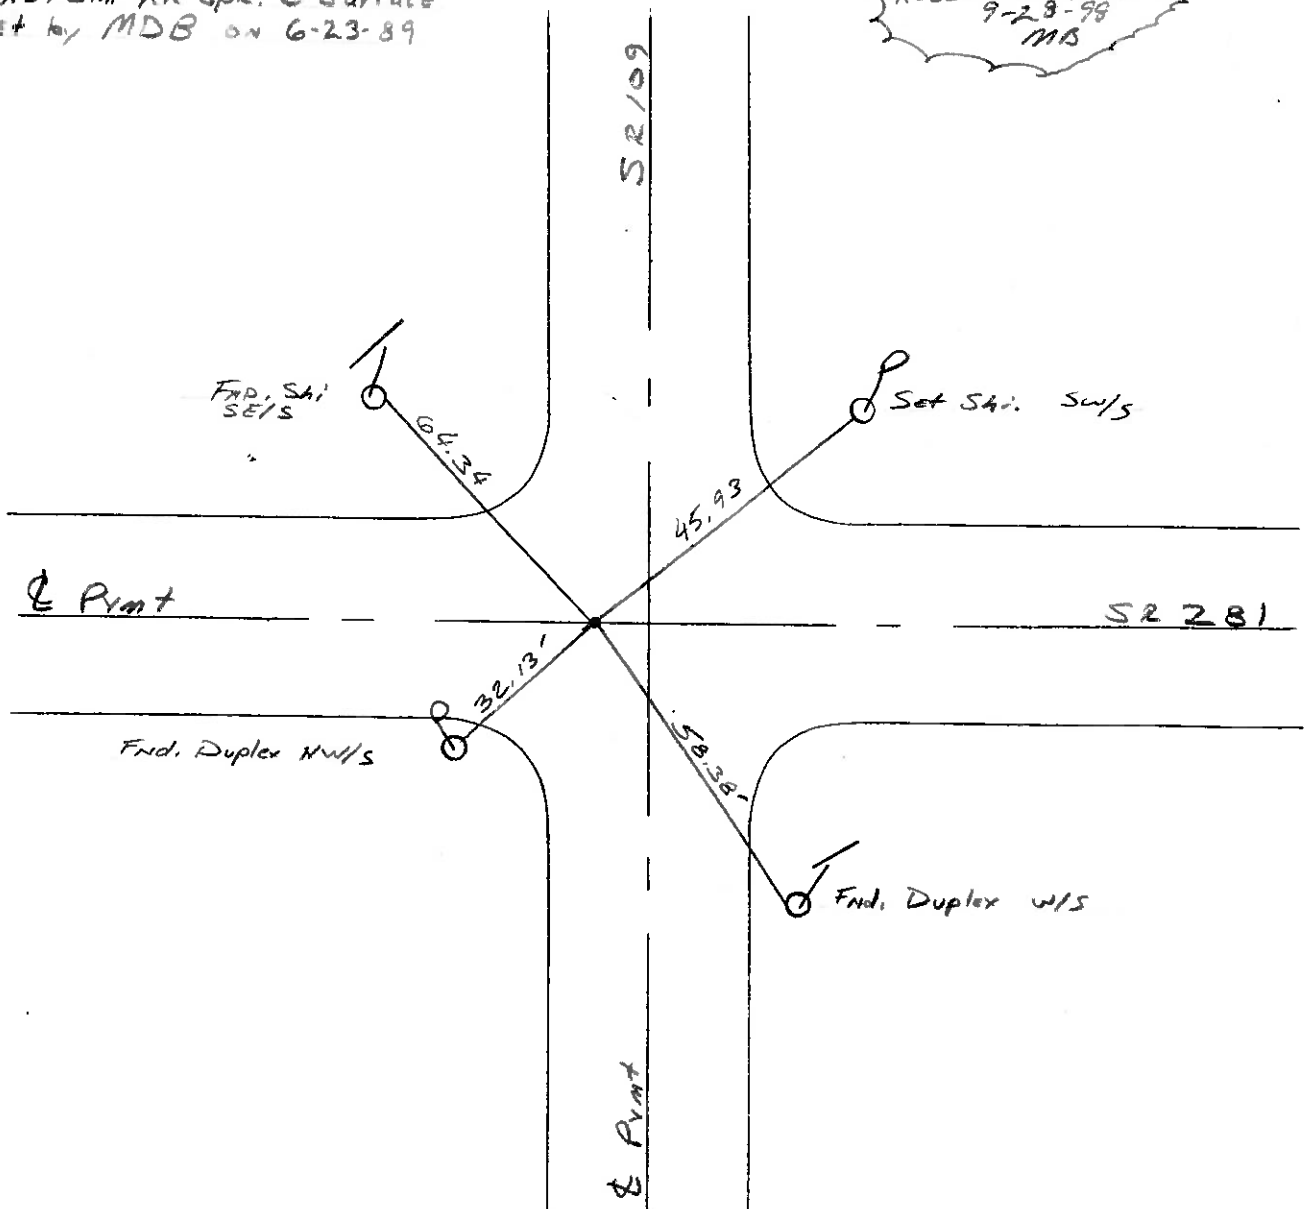

DRAWN BY TR

O.D.O.T. DISTRICT 2 SURVEY OFFICE

PERSONNEL _____

REFERENCE NO. 18

SHEET 2 OF _____

NOTES BARNHISEL

H.C. " "

R.C. Locheke

DATE 3-30-89

WEATHER RAIN

TEMP. +40°

ROUTE 109 @ 281

COUNTY HENRY

TOWNSHIP MONROE

SECTION 27

T 4 N 7 E


TYPE MONUMENT PK & WASHER

ON SURFACE - BELOW YES


LEFT - CL PAV'T. - RIGHT 7.3' OF S.R. 109

TO EDGE PAVEMENT ON R PAV'T OF S.R. 281

S.L.M. 423+58

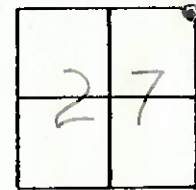

Set 3m RR Spk
6-23-89
MDB

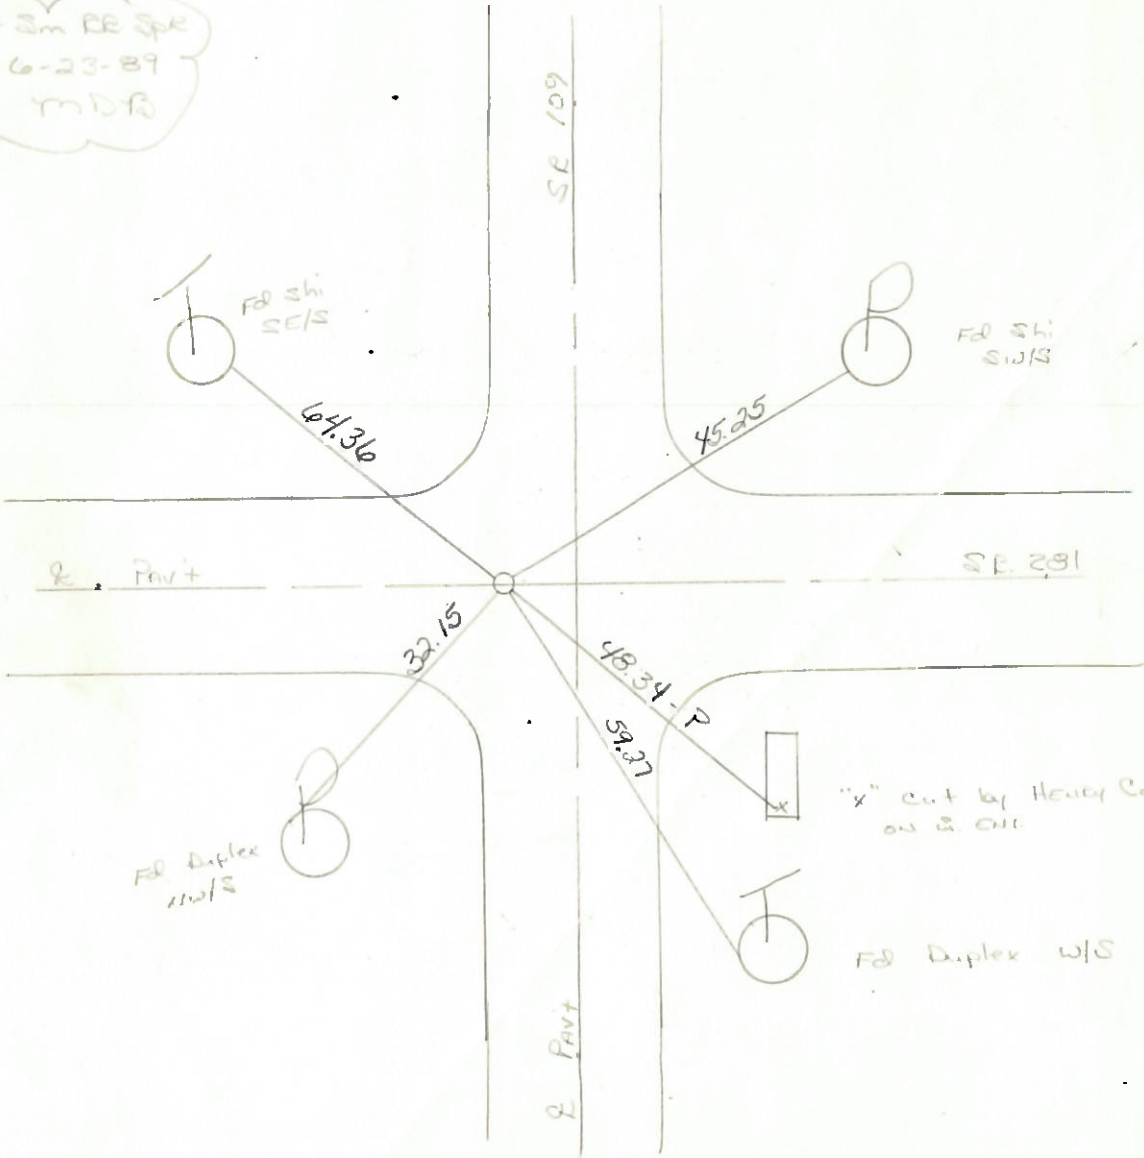

OD.O.T. DISTRICT 2 SURVEY OFFICE

SHEET _____ OF _____

County HENRY S.R. 109 @ 281

Date April 26 83

Township MONROE

Weather CLEAR

Section 27

Temp. +65°


T4N, R7E

Personnel HOFFMAN

LOEHRKE

HOUSE HOLDER


#18

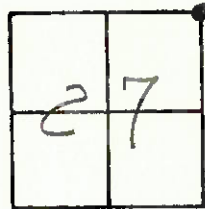

Fd R.R. SPL @ SURFACE, SET BY COUNTY
ON & PAUT SR 281
~~2.5~~ Lt. of & PAUT SR 109
7.3'

SR 109 S. 2. 11. 422 + 85

SET P.K./WASHER
9-19-83 SWH

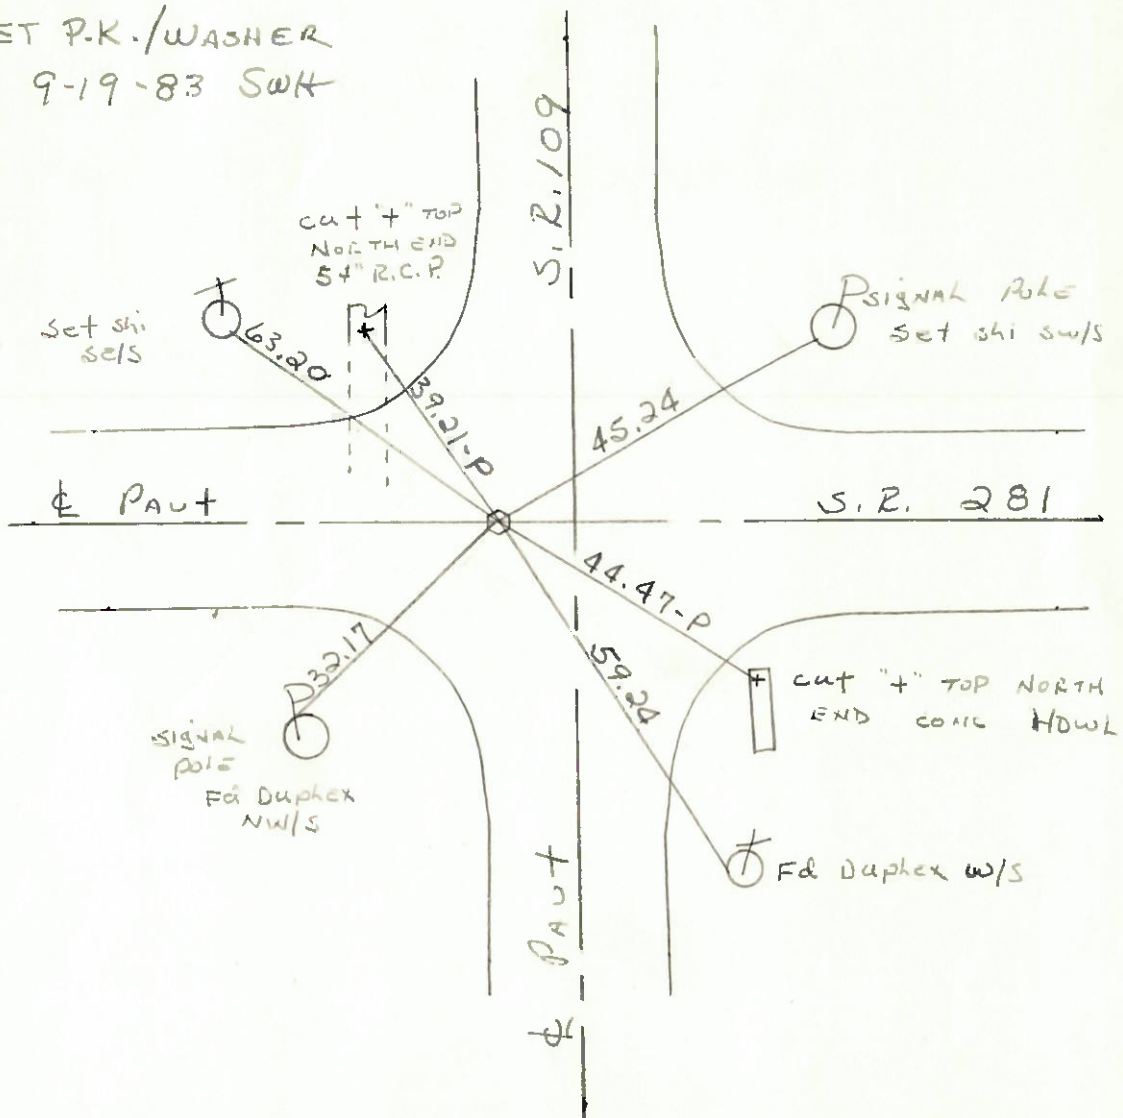

PERSONNEL	TITLE	PERSONNEL	TITLE
Tomsic			
Neuser			
Starr			

COUNTY Henry DATE Nov. 1, 1973
 S. R. 109 WEATHER _____
 SEC. MONROE TWP. TEMP _____

DESCRIPTION _____ LEFT _____ CENTER LINE _____ RIGHT _____ JOB NO. _____

