


O.D.O.T. DISTRICT 2 SURVEY OFFICE (USE ONLY)


PERSONNEL _____ REFERENCE NO. 23 A SHEET 9 OF 38
 NOTES CANTERBURY DATE 8-31-04 ROUTE SR 109
 H.C. BARNHISEL WEATHER SUNNY COUNTY HENRY
 R.C. HOOKER TEMP. 70°F TOWNSHIP MONROE
 _____ SECTION 11
 _____ T 4 N R 7 E

TYPE MONUMENT PK/WASHER
 ON SURFACE - ~~BELOW~~ ON
~~LEFT~~ - Q PAV'T - RIGHT 0.5'
10.6' TO LT EDGE PAVEMENT
 S.L.M. 571+15

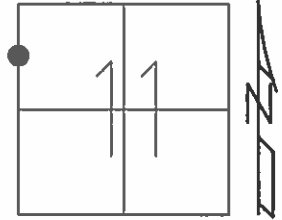

Grid: Northing: 640291.0714 Easting: 1572289.2497

RECORD:
 SET MAG/WASHER
 10-28-04, MC

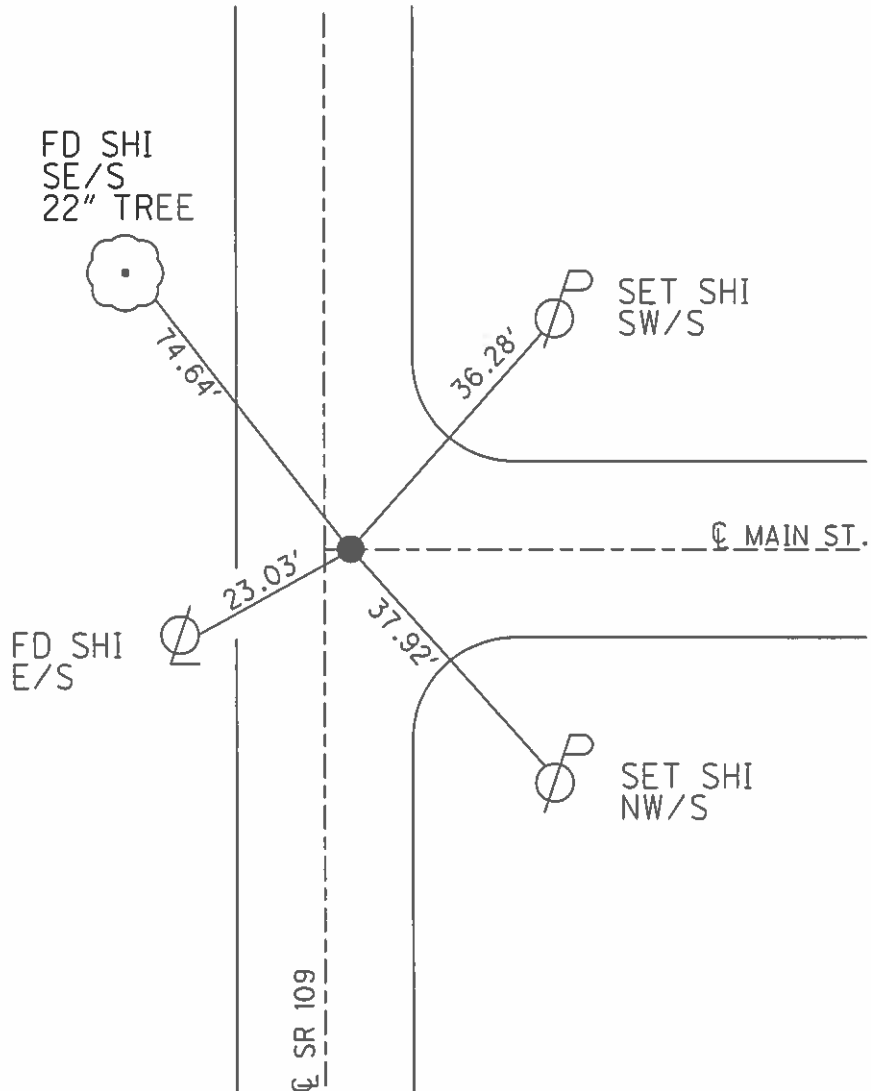

O.D.O.T. DISTRICT 2 SURVEY OFFICE

PERSONNEL

REFERENCE NO. 23-A

SHEET 8 OF 23

NOTES CANTERBURY

H.C. BARNHISEL

R.C. HOOGER

DATE 8-31-04

WEATHER SUN

TEMP. +70°

ROUTE 109

COUNTY HENRY

TOWNSHIP MONROE

SECTION 11

T4 N R 7 E


TYPE MONUMENT P.K. / WASHER

ON SURFACE - ~~BELOW~~ SURFACE


~~LEFT~~ - PAV'T. - RIGHT 0.5' RT E

10.6' TO LT EDGE PAVEMENT ON E EAST

S.L.M. 571 +15

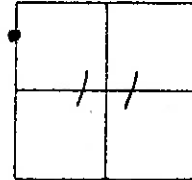

RESET MAG / WASHER
 10/28/04
 M.C.

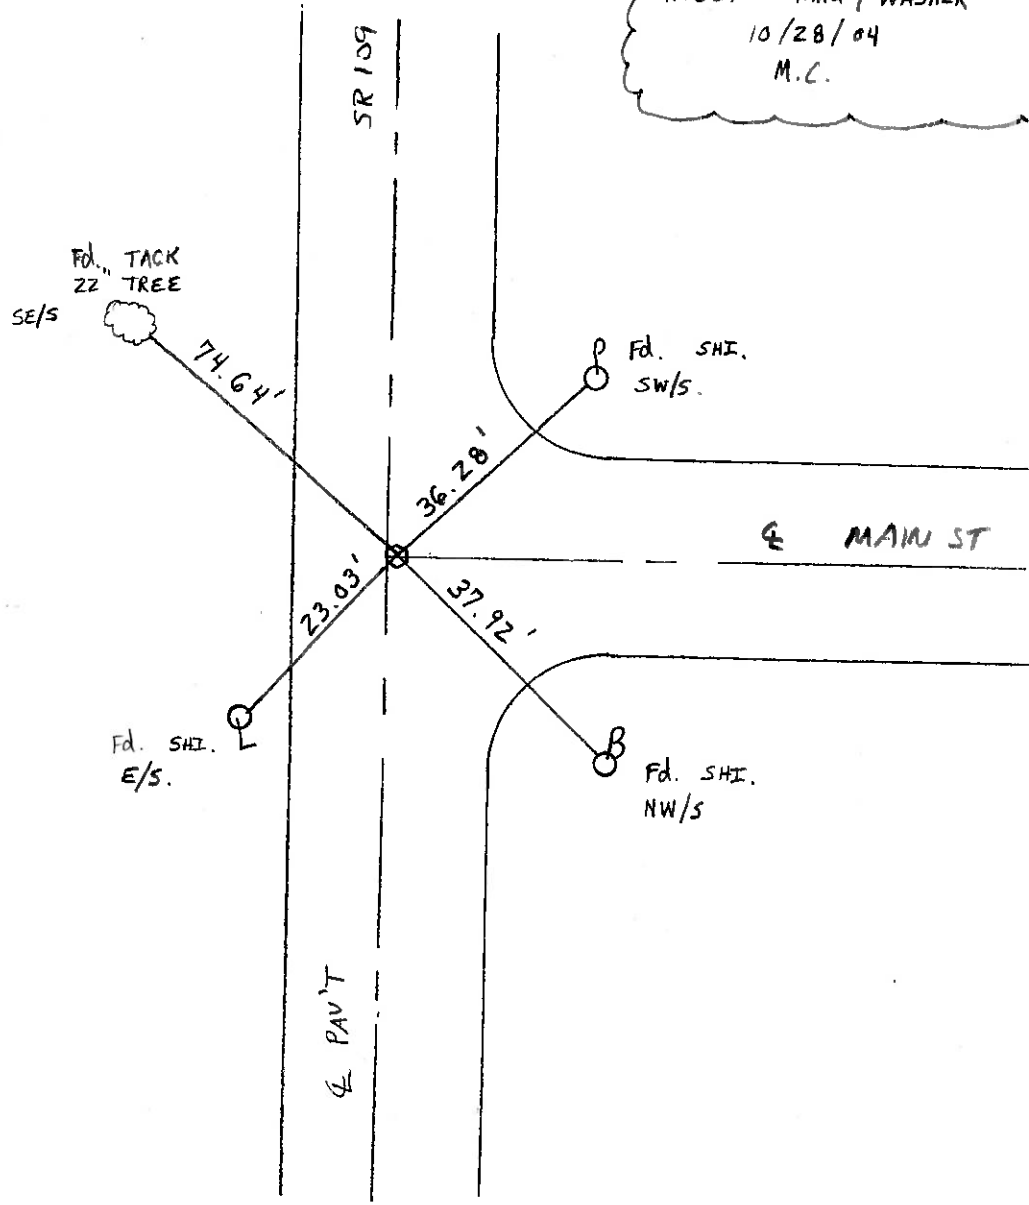

O.D.O.T. DISTRICT 2 SURVEY OFFICE

PERSONNEL

REFERENCE NO. 23-A

SHEET _____ OF _____

NOTES BARNHISEL

H.C. VAN DUSEN

DATE 8-17-93

ROUTE 109

R.C. KUSZ

WEATHER Fog

COUNTY HENRY

TEMP. +81° F.

TOWNSHIP MONROE

SECTION 11

T4 N R 7 E



TYPE MONUMENT BOLT SPK.

~~ON SURFACE~~ - BELOW 2" DOWN


LEFT- & PAV'T. - RIGHT YES

10.6 TO LT. EDGE PAVEMENT

S.L.M. 571+15

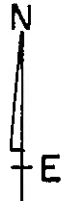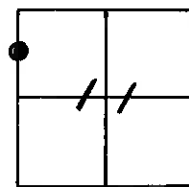

SET PK & WASHER
8-27-93
MB

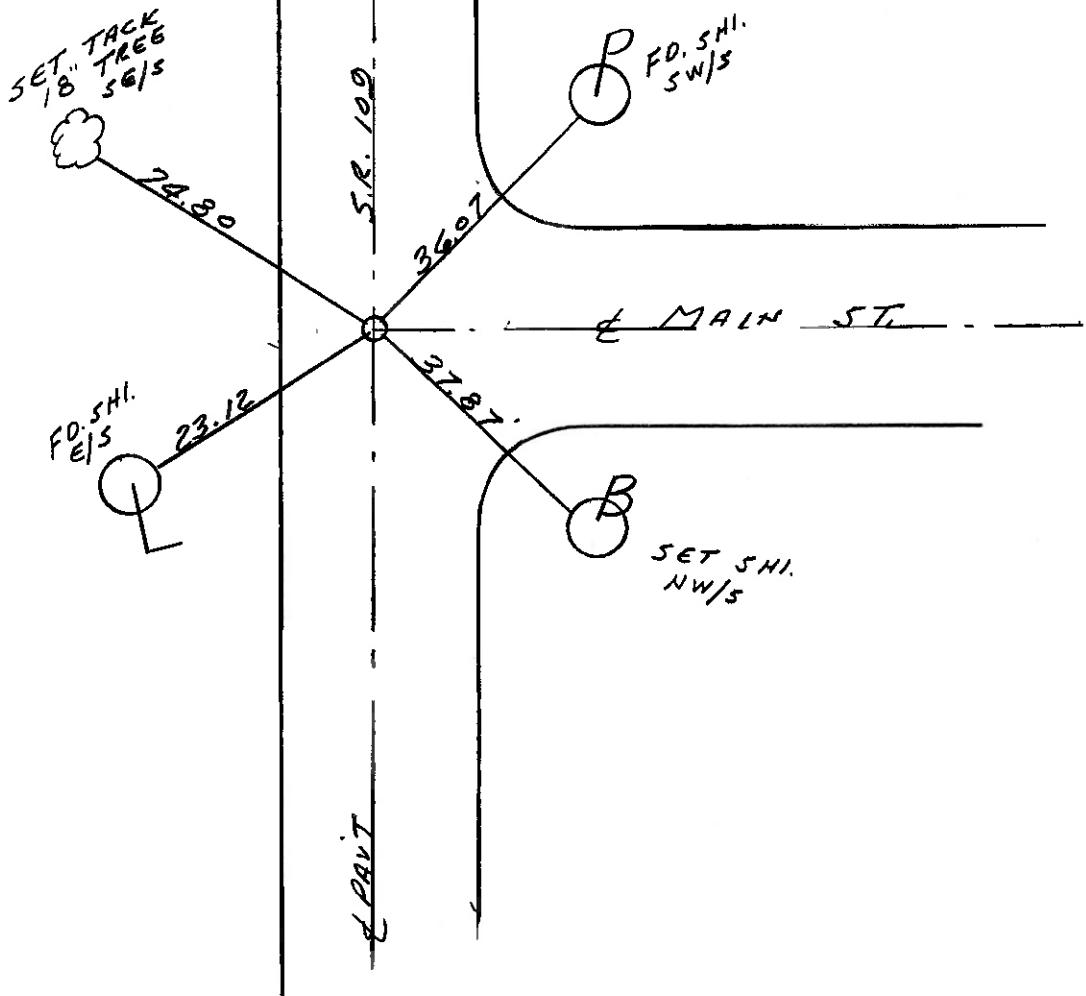

O.D.O.T. DISTRICT 2 SURVEY OFFICE

PERSONNEL

REFERENCE NO. 23-A

SHEET _____ OF _____

NOTES Barnhisel

H.C. Hoffman

DATE 4-8-85

ROUTE 109

R.C. Loehrke

WEATHER cloudy

COUNTY Henry

TEMP. +350

TOWNSHIP Monroe

SECTION 11

T 4 N R 7 E



TYPE MONUMENT Bolt spk

ON SURFACE - BELOW ✓

~~LEFT~~ - ~~PAV'T.~~ - RIGHT ✓

10.4 TO .4+ EDGE PAVEMENT

S.L.M. 570+57

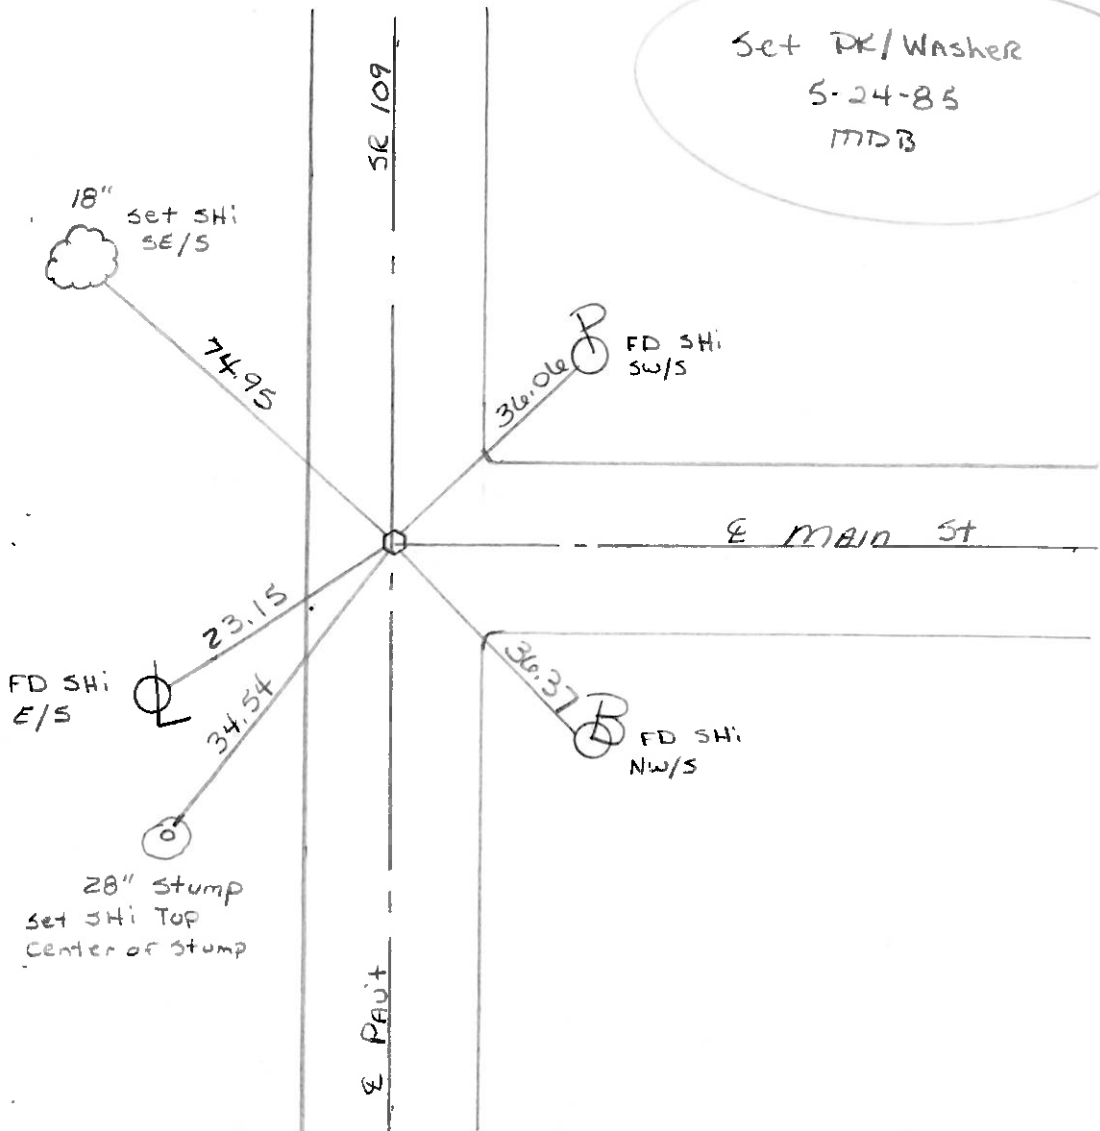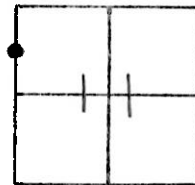

| PERSONNEL | TITLE | PERSONNEL | TITLE |
|-----------|-------|-----------|-------|
| Tomsic | | | |
| Nolzer | | | |
| Granata | | | |
| Vanyo | | | |

COUNTY: HENRY DATE: Nov. 1, 1973
 S. R. 109 WEATHER _____
 SEC. MONROE TWP. TEMP. _____

DESCRIPTION _____ LEFT _____ CENTER LINE _____ RIGHT _____ JOB NO. _____

