

O.D.O.T. DISTRICT 2 SURVEY OFFICE (USE ONLY)

PERSONNEL

REFERENCE NO. 26 A

SHEET 14 OF 36

NOTES RHOADES

DATE 6/27/22

ROUTE SR 109

H.C. AUBLE

WEATHER SUNNY

COUNTY HENRY

R.C. RHOADES

TEMP. 67°

TOWNSHIP MONROE

DWG BY RHOADES

PID PAVETRAIN

SECTION 2

T 4 N R 7 E

TYPE MONUMENT MAG/WASHER

ON SURFACE - ~~BELOW~~ ON

OFFSET \odot PAVEMENT 19' \pm : RT

0.5' TO S EDGE PAVEMENT


STATION: 637+82

HORZ. DATUM: NAD83 2011


GEOID: NAVD88 2018

GRID: NORTHING: 613988.724

EASTING: 1546192.375

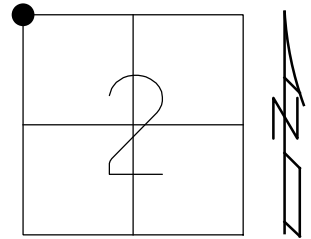


RECORD:
 SET MAG/WASHER
 10-28-04, MC
 FD MAG/WASHER
 REFA26
 9-2-15, JFO
 8-3-16, JMR
 REFA26
 6/27/22, DSA
 1/11/23, JMR

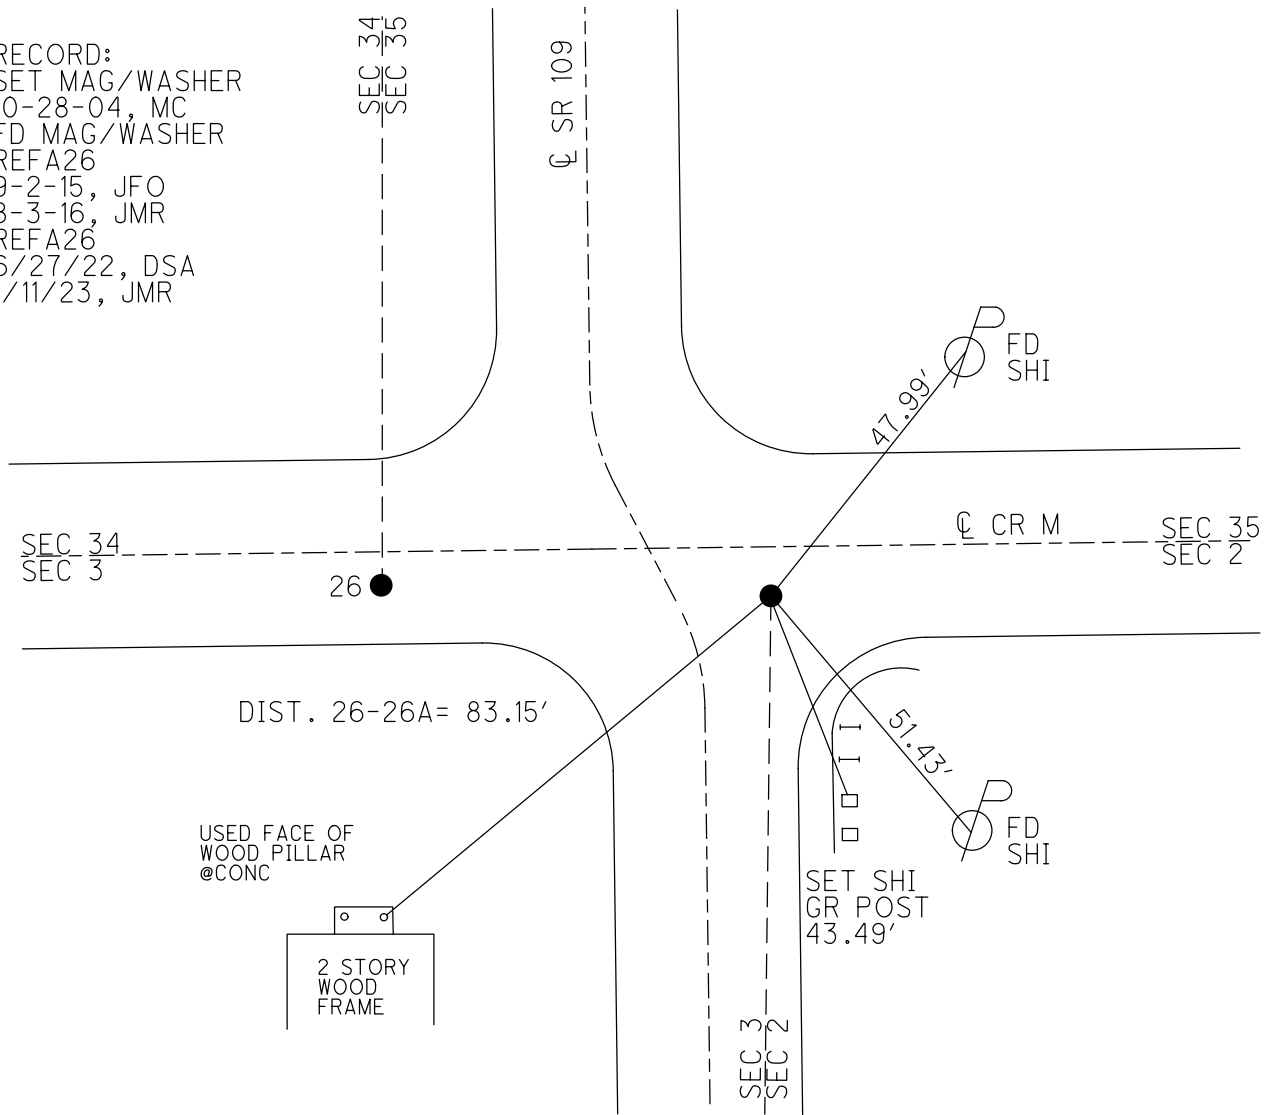

O.D.O.T. DISTRICT 2 SURVEY OFFICE (USE ONLY)

PERSONNEL _____ REFERENCE NO. 26 A SHEET 14 OF 38
 NOTES RHOADES DATE 9-3-15 ROUTE SR 109
 H.C. O'DONNELL WEATHER CLEAR COUNTY HENRY
 R.C. RHOADES TEMP. 88°F TOWNSHIP MONROE
 SECTION 2
 T 4 N R 7 E


TYPE MONUMENT PK/WASHER
 ON SURFACE - ~~BELOW~~ ON _____
~~LEFT~~ - Q PAV'T - RIGHT 19'
0.5' TO S EDGE PAVEMENT
 S.L.M. 638+17

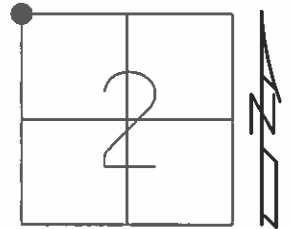

Grid: Northing: 613988.7243 Easting: 1546192.3745

RECORD:
 SET MAG/WASHER
 10-28-04, MC
 FD MAG/WASHER
 GPS, REFA26
 9-2-15, JFO
 NOT COVERED
 8-3-16, JMR

DIST. 26-26A= 83.15'

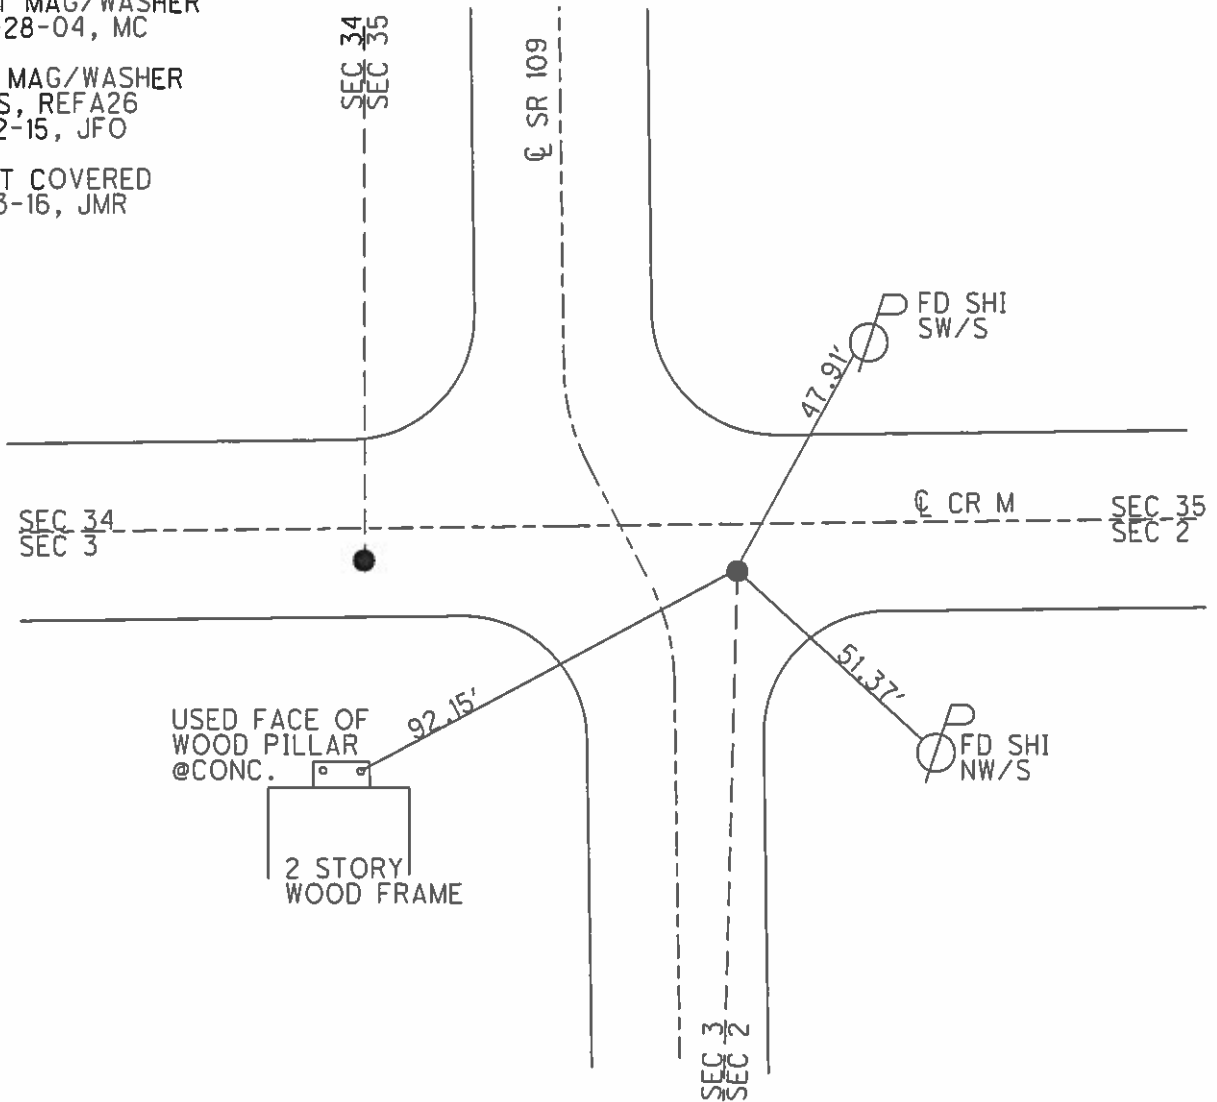

O.D.O.T. DISTRICT 2 SURVEY OFFICE

PERSONNEL

REFERENCE NO. 26

SHEET 12 OF 23

NOTES CANTERBURY

H.C. BARNHISEL

R.C. HOOVER

DATE 8/31/04

WEATHER SUN

TEMP. +70°

ROUTE SR 109

COUNTY HENRY

TOWNSHIP MONROE

SECTION 2, 3, 34, 35

T 4 N R 7 E

PT "A"

PT "B"

TYPE MONUMENT LG R.R. SPK.

P.K./WASHER

ON SURFACE - BELOW 2" DOWN

SURFACE

LEFT - ☉ PAV'T. - RIGHT 83.1' LT ☉


19' RT ☉

PT "A" 5.0' TO S. EDGE PAVEMENT 3.3' S. OF M.C. ☉


0.5' S. OF CO. RD. "M"

S.L.M. 638+17

638+17

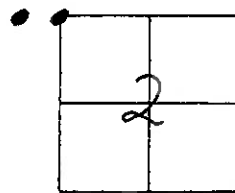

PT "A" NOT COVERED
 RESET MARK/WASHER @ PT "B"
 10/28/04
 M.C.

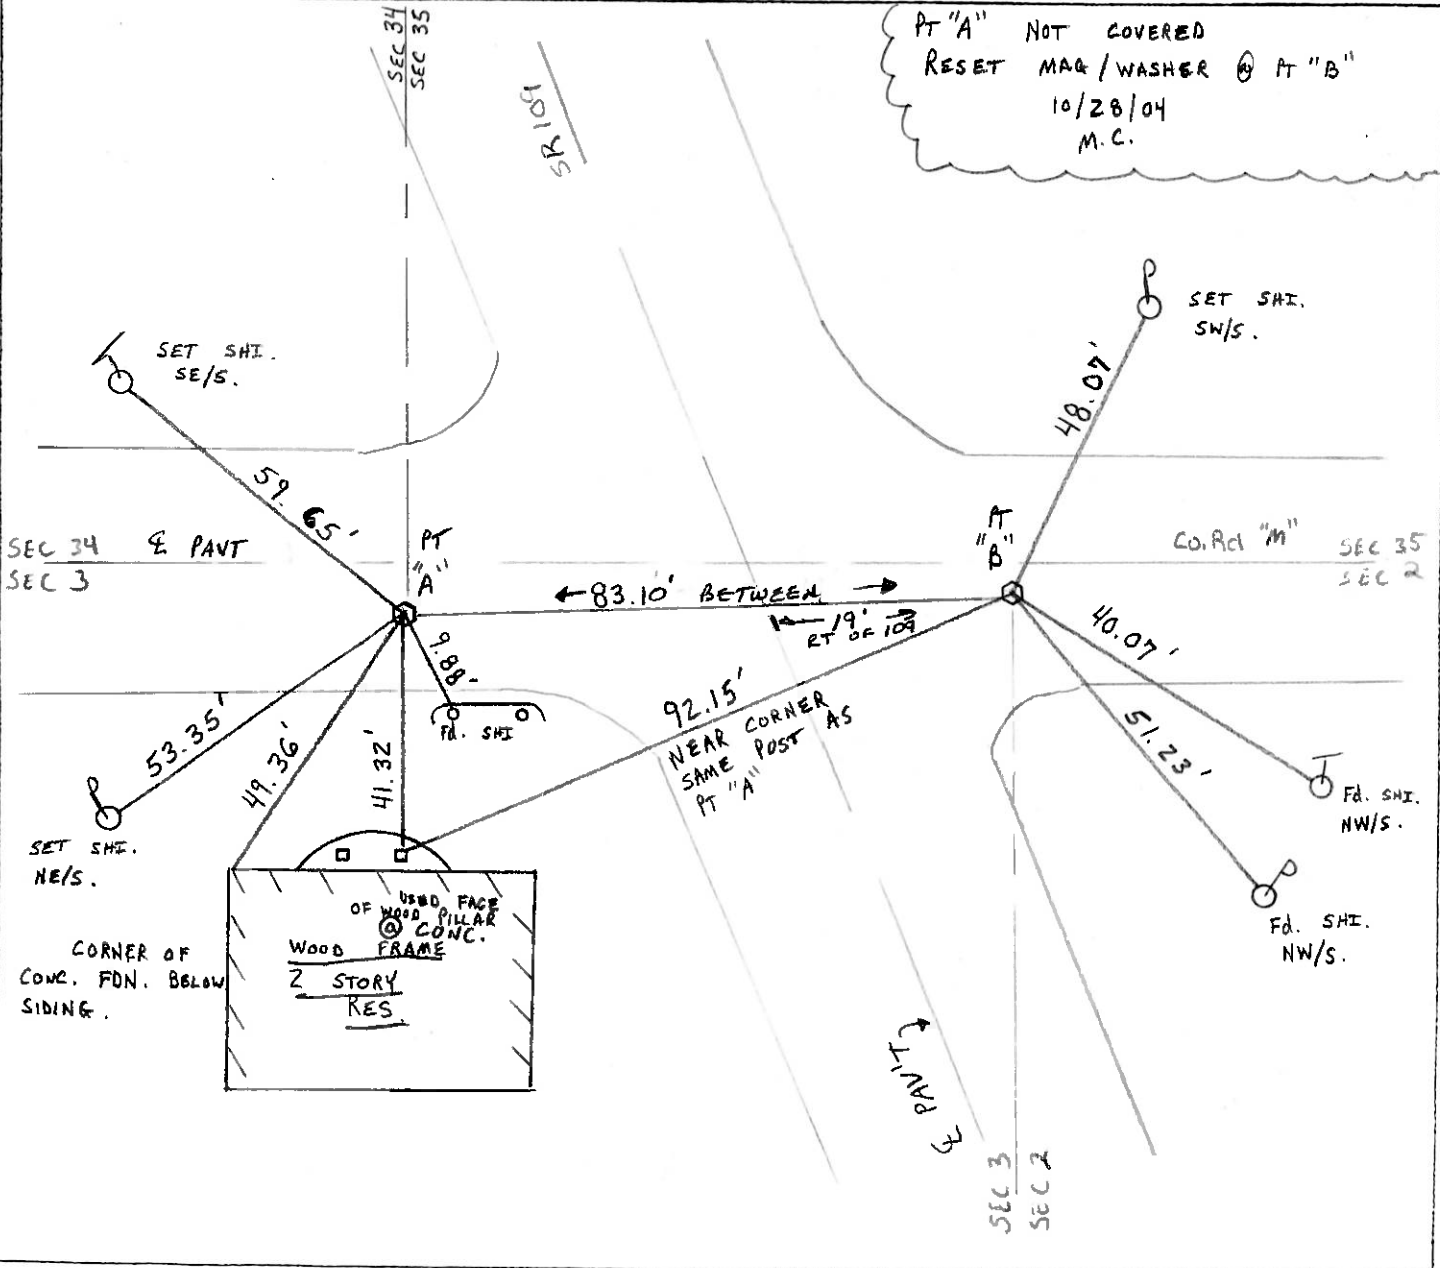

O.D.O.T. DISTRICT 2 SURVEY OFFICE

PERSONNEL

REFERENCE NO. 26

SHEET OF

NOTES BARNHISEL

H.C. VAN DUSEN

DATE 8-13-93

ROUTE SR 109

R.C. BARNHISEL

WEATHER JUNNY

COUNTY HENRY

TEMP. +80° F

TOWNSHIP MONROE

SECTION 2, 3, 34, 35

T 4 N R 7 E


TYPE MONUMENT LG. RR/SPK.

ON SURFACE - ~~BELOW~~ YES


LEFT - 0 PAV'T. - RIGHT PT. A 3.3 PT. B 1.5 Co. RD. "M"

PT. A 5.0 TO RT. EDGE PAVEMENT

S.L.M. 638 + 0 6

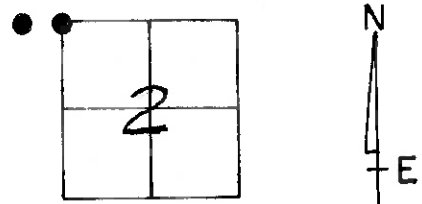

PT "A" WAS NOT COVERED
 SET PK & WASHER @ PT. "B"
 8-27-93
 MB

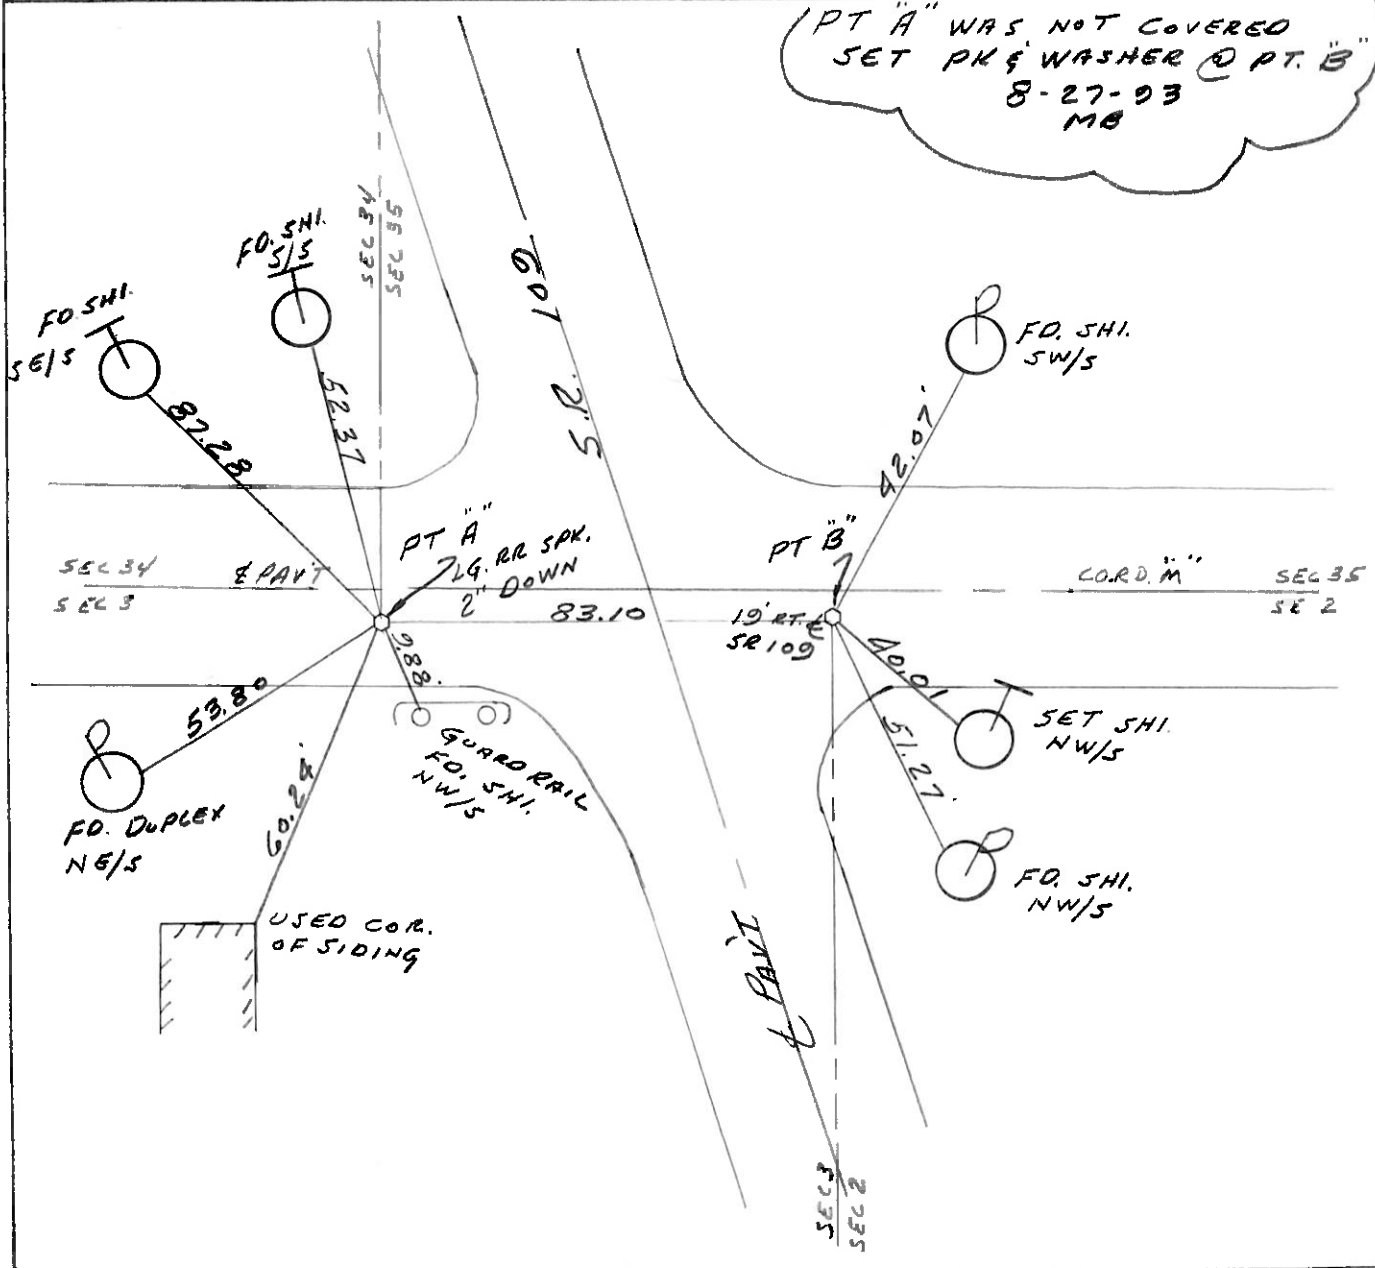

O.D.O.T. DISTRICT 2 SURVEY OFFICE

PERSONNEL

REFERENCE NO. 26

SHEET OF

NOTES Baehisel

H.C. Hoffman

R.C. Loehrke

DATE 4-8-85

WEATHER Cloudy - Flurries

TEMP. +35°

ROUTE 109

COUNTY Henry

TOWNSHIP Monroe

SECTION 2

T 4 N R 7 E

TYPE MONUMENT Lg RR/SPK


ON SURFACE - BELOW ✓

LEFT - C PAV'T. - RIGHT Pt "A" 3.5 Pt "B" 1.5

S.3 TO R+ EDGE PAVEMENT

S.L.M. 637+54

Co Rd "M"

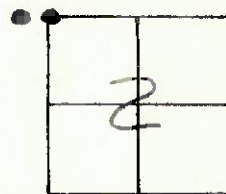

Set PK/Washer Pt "B"
Not Covered Pt "A"
5-24-85
MDTB

Pt "A"

