

O.D.O.T. DISTRICT 2 SURVEY OFFICE (USE ONLY)

PERSONNEL

REFERENCE NO. 28

SHEET 16 OF 36

NOTES RHOADES

DATE 6/27/22

ROUTE SR 109

H.C. AUBLE

WEATHER SUNNY

COUNTY HENRY

R.C. RHOADES

TEMP. 67°

TOWNSHIP HARRISON

SECTION 35

DWG BY RHOADES

PID PAVETRAIN

T 5 N R 7 E

TYPE MONUMENT MAG/WASHER

ON SURFACE - ~~BELOW~~ ON

OFFSET 8' LT : RT

2' TO RT EDGE PAVEMENT


STATION: 691+15.2

HORIZ.DATUM: NAD83 2011


GEOID: NAVD88 2018

GRID: NORTHING: 619288.527

EASTING: 156202.286

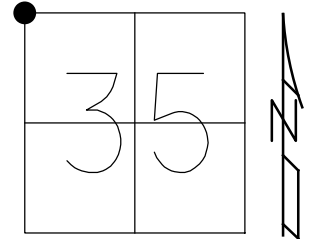

RECORD:
 SET MAG/WASHER
 10-28-04, MC
 FD MAG/WASHER
 REF28
 9-1-15, JFO
 8-3-16, JMR
 REF28
 6/27/22, DSA
 1/11/23, JMR

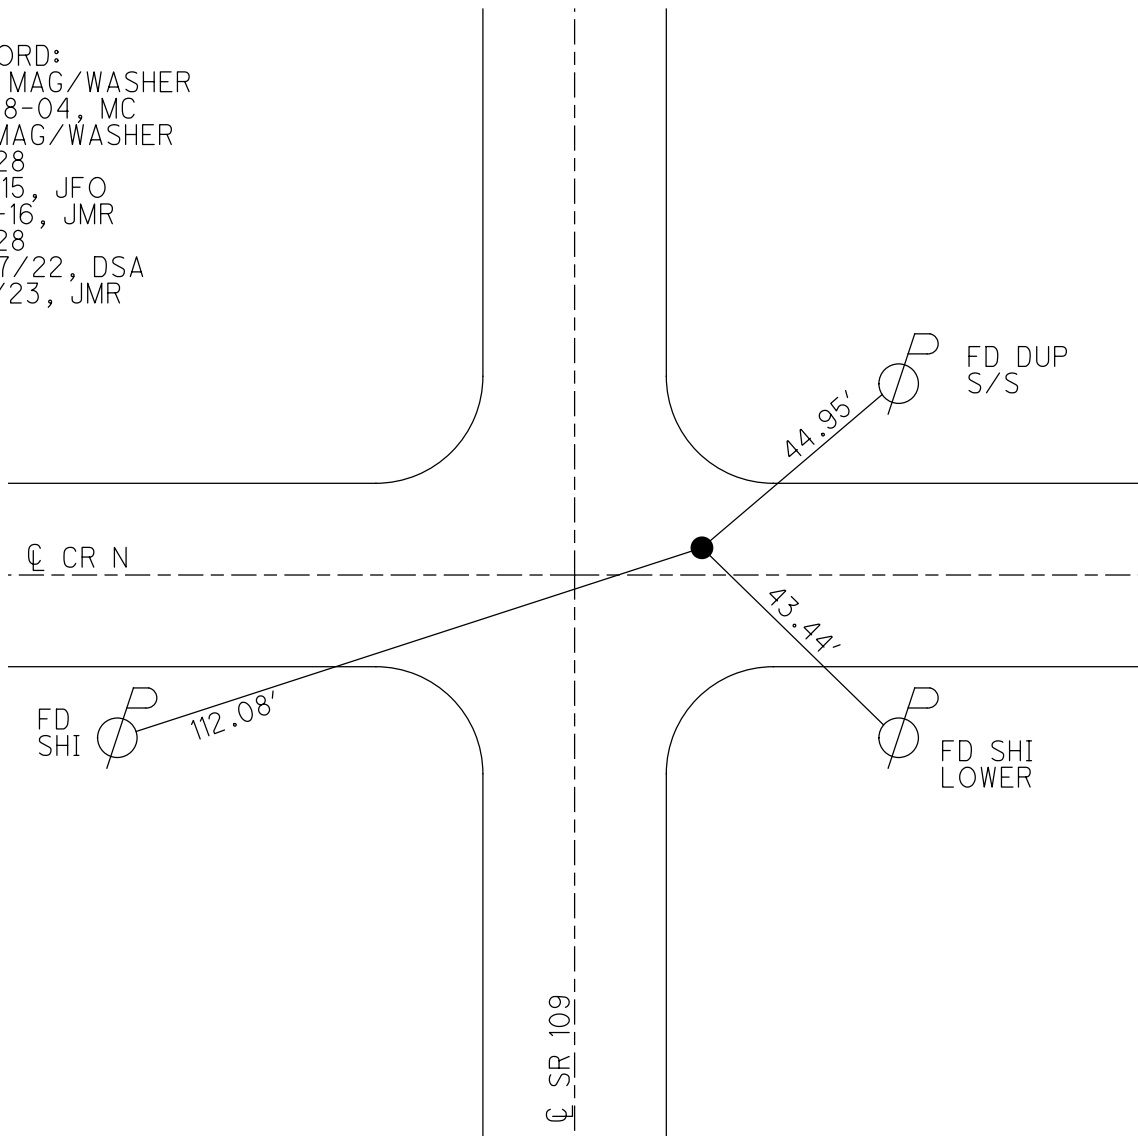

O.D.O.T. DISTRICT 2 SURVEY OFFICE (USE ONLY)

PERSONNEL _____ REFERENCE NO. 28 SHEET 16 OF 39

NOTES RHOADES DATE 9-3-15 ROUTE SR 109
 H.C. O'DONNELL WEATHER CLEAR COUNTY HENRY
 R.C. RHOADES TEMP. 88°F TOWNSHIP HARRISON
 _____ SECTION 35
 _____ T 5 N R 7 E


TYPE MONUMENT MAG/WASHER

ON SURFACE - ~~BELOW~~ ON

~~LEFT~~ - CL PAV'T - RIGHT 8.0'
2.0' TO RT EDGE PAVEMENT

S.L.M. 691+09


Grid: Northing: 619288.5271 Easting: 156202.2864

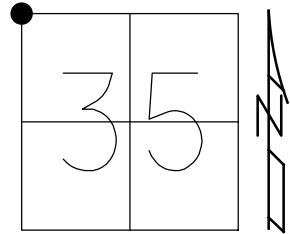

RECORD:
 SET MAG/WASHER
 10-28-04, MC

FD MAG/WASHER
 GPS, REF28
 9-1-15, JFO

NOT COVERED
 8-3-16, JMR

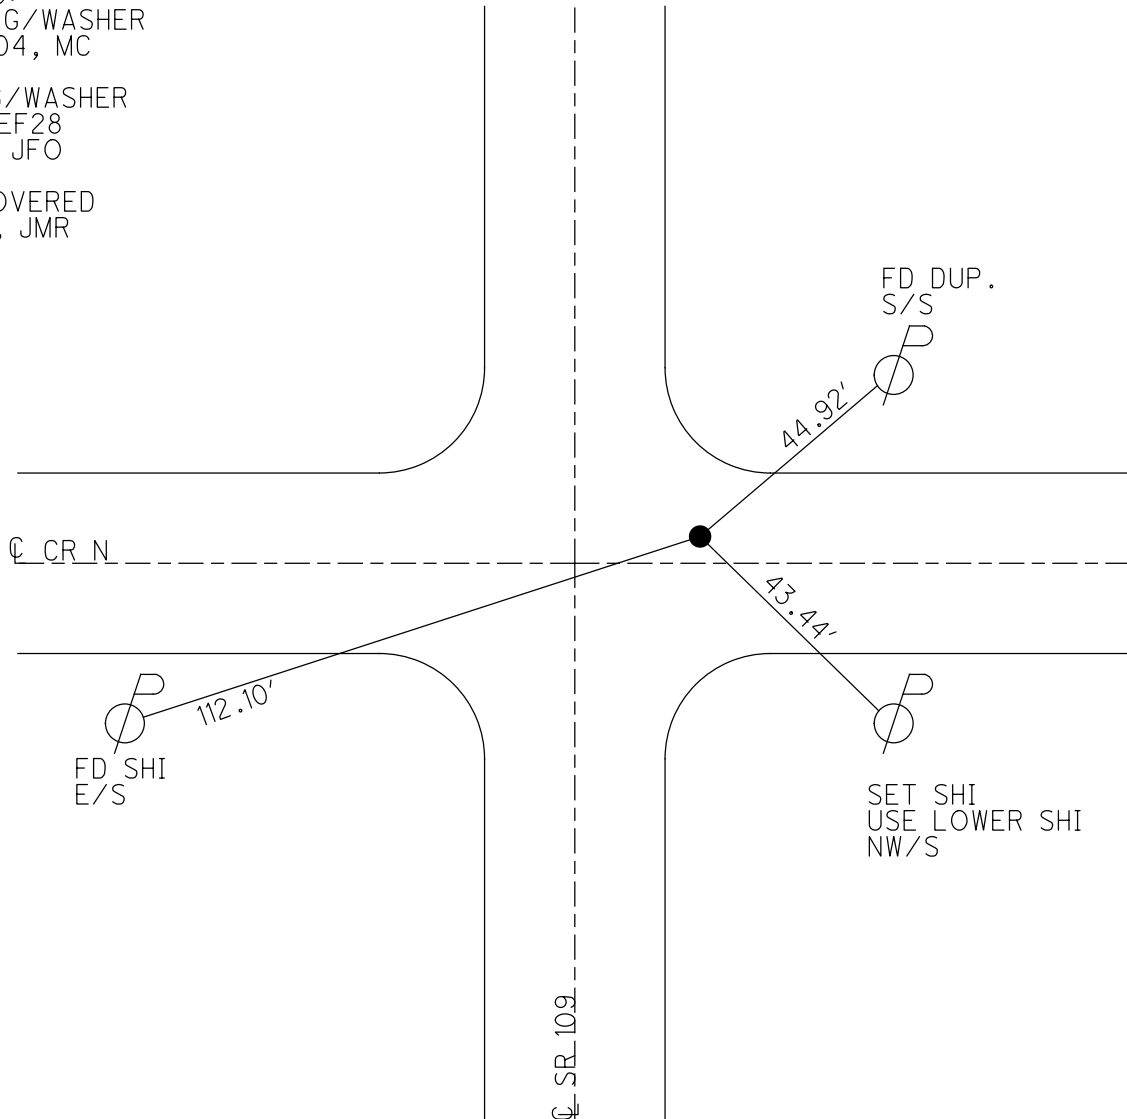

O.D.O.T. DISTRICT 2 SURVEY OFFICE

PERSONNEL

REFERENCE NO. 28

SHEET 14 OF 23

NOTES CANTERBURY

H.C. BARNHISEL

R.C. HOOVER

DATE 8-31-04

WEATHER SUN

TEMP. +75°

ROUTE 109

COUNTY HENRY

TOWNSHIP HARRISON

SECTION 35

T5 N R 7 E


TYPE MONUMENT P.K. / WASHER

ON SURFACE - ~~BELOW~~ SURFACE


~~LEFT -~~ PAV'T. - RIGHT 8.0'

2.0' TO RT. EDGE PAVEMENT 1' NORTH OF E EAST

S.L.M. 691 + 09

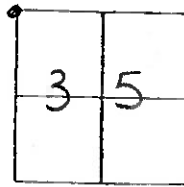

RESET MAG/WASHER
 10/28/04
 M.C.

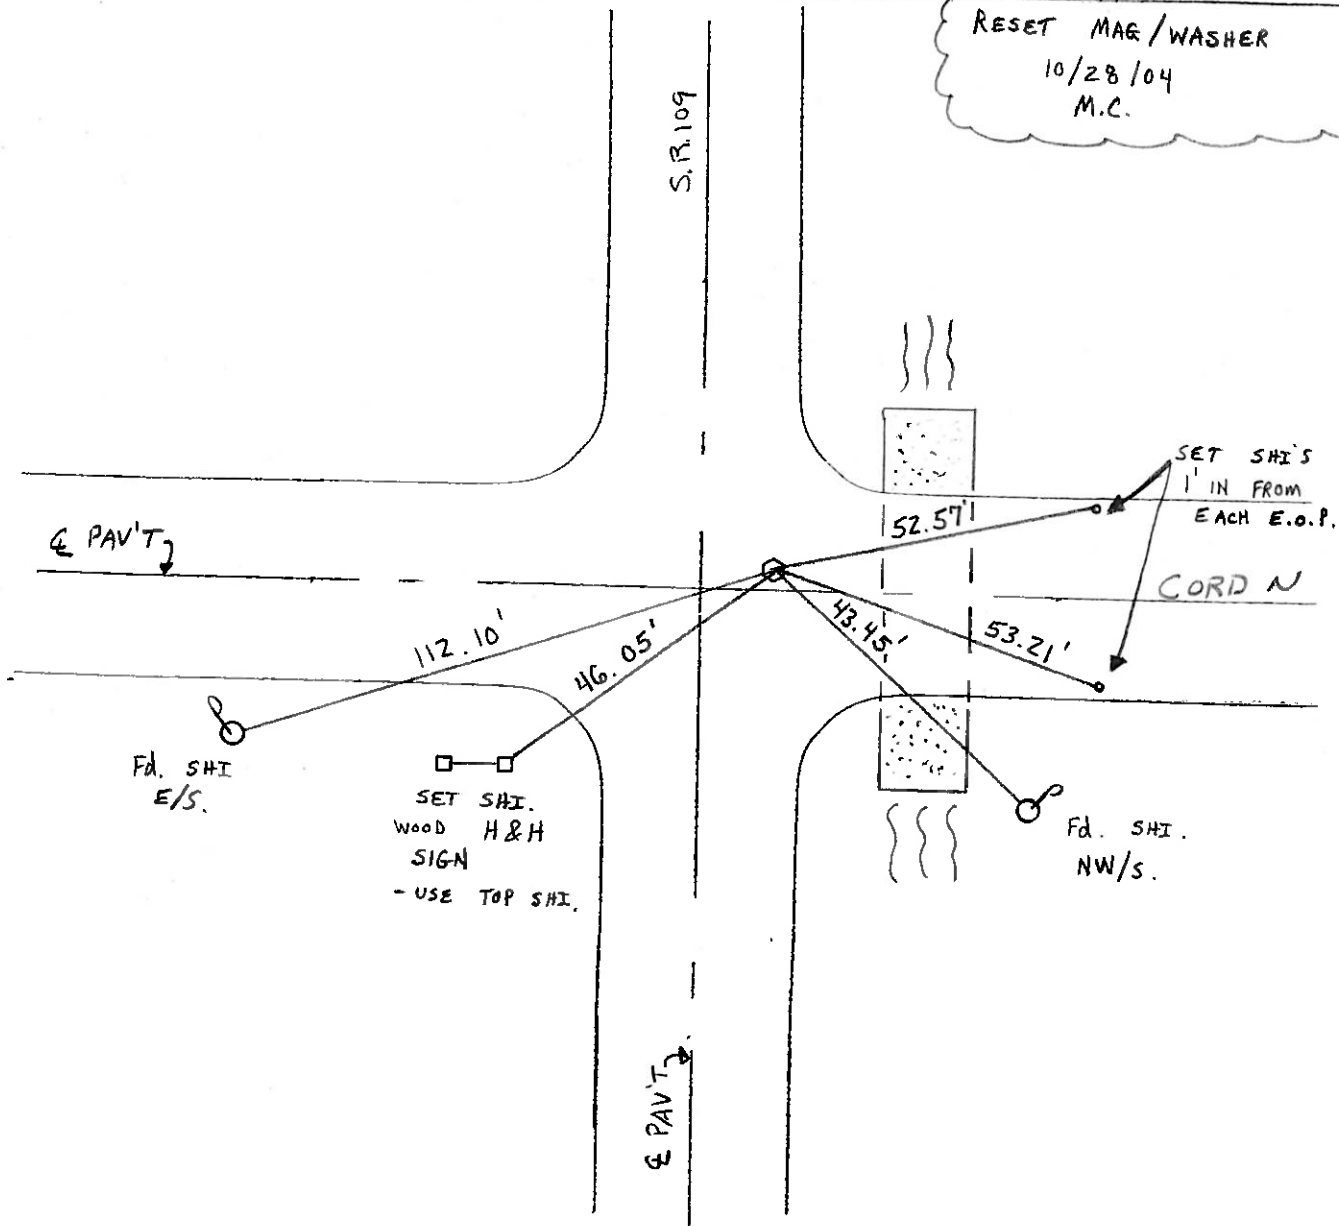

O.D.O.T. DISTRICT 2 SURVEY OFFICE

PERSONNEL

REFERENCE NO. 28

SHEET OF

NOTES BARNHISEL

H.C. VAN DUJEN

R.C. BARNHISEL

DATE 8-13-93

WEATHER JUNNY

TEMP. + 80° F

ROUTE SR 109


COUNTY HENRY

TOWNSHIP HARRISON


SECTION 35

T 5 N R 7 E

TYPE MONUMENT LARGE RR/SPK. HOLE ^{PUNCH}
 ON SURFACE - BELOW YES
 LEFT - & PAV'T. - RIGHT 8.0
2.0' TO RT. EDGE PAVEMENT
 S.L.M. 691+02

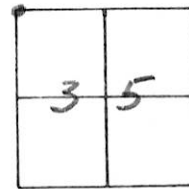

SET PK& WASHER
 8-27-93
 MB

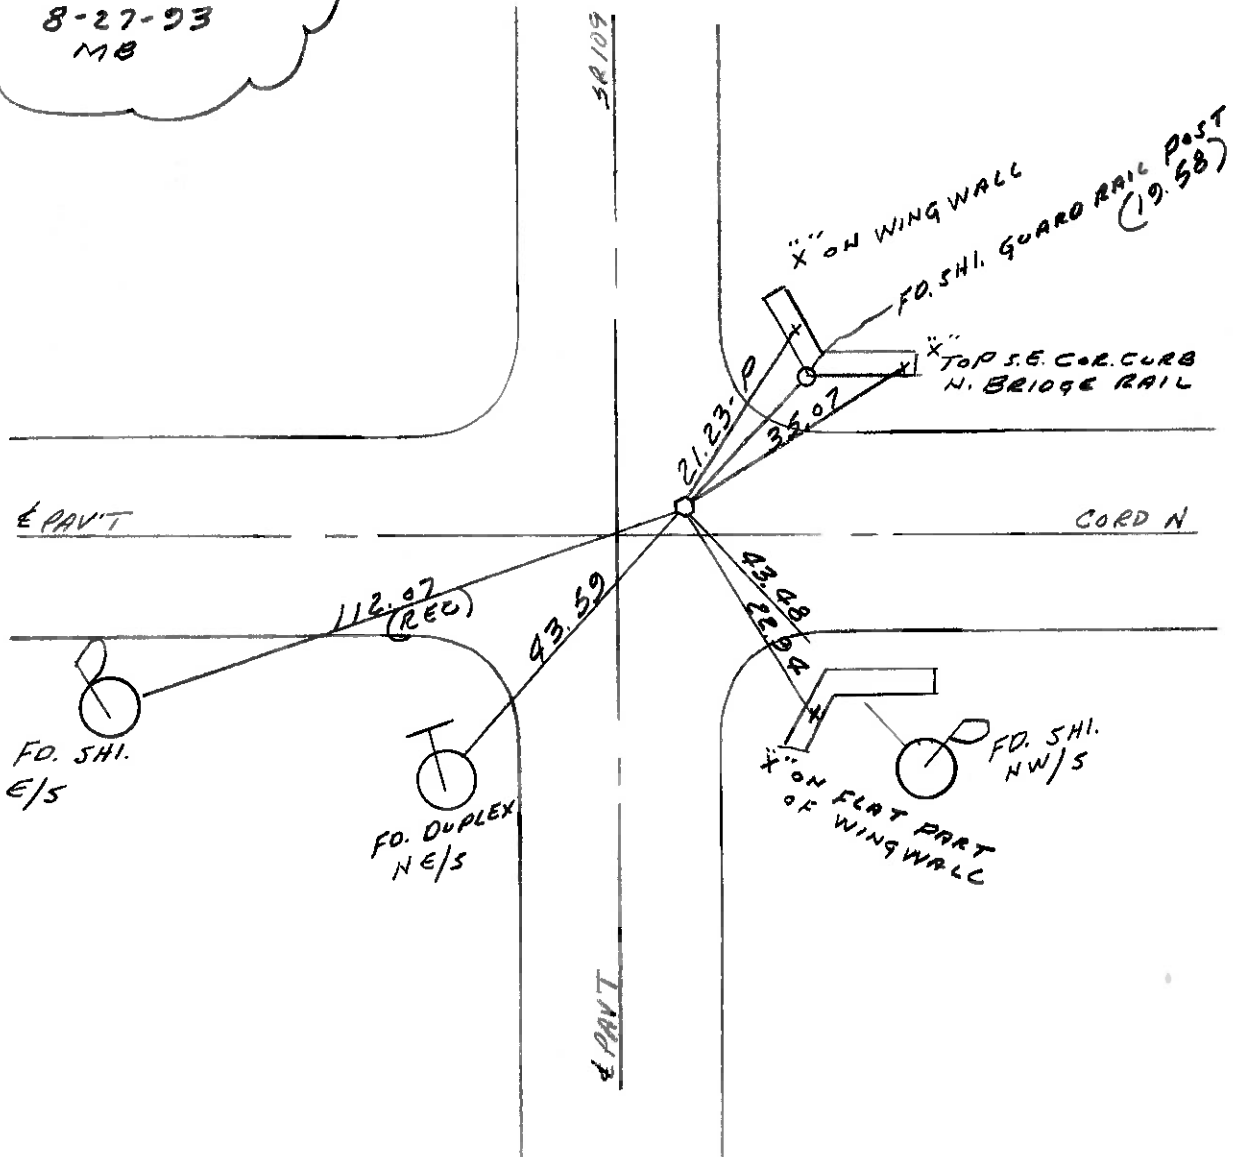

O.D.O.T. DISTRICT 2 SURVEY OFFICE

PERSONNEL _____

REFERENCE NO. 28

SHEET _____ OF _____

NOTES BARNHISEL

H.C. Hoffman

R.C. Loehrke

DATE 4-8-85

WEATHER cloudy

TEMP. +350

ROUTE 109

COUNTY Henry

TOWNSHIP Harrison

SECTION 35

T 5 N R 7 E



TYPE MONUMENT Lg RR/spk Punch hole

ON SURFACE - BELOW ✓

LEFT - € PAV'T. - RIGHT 8.0

2.0 TO Rt EDGE PAVEMENT

S.L.M. 690+62

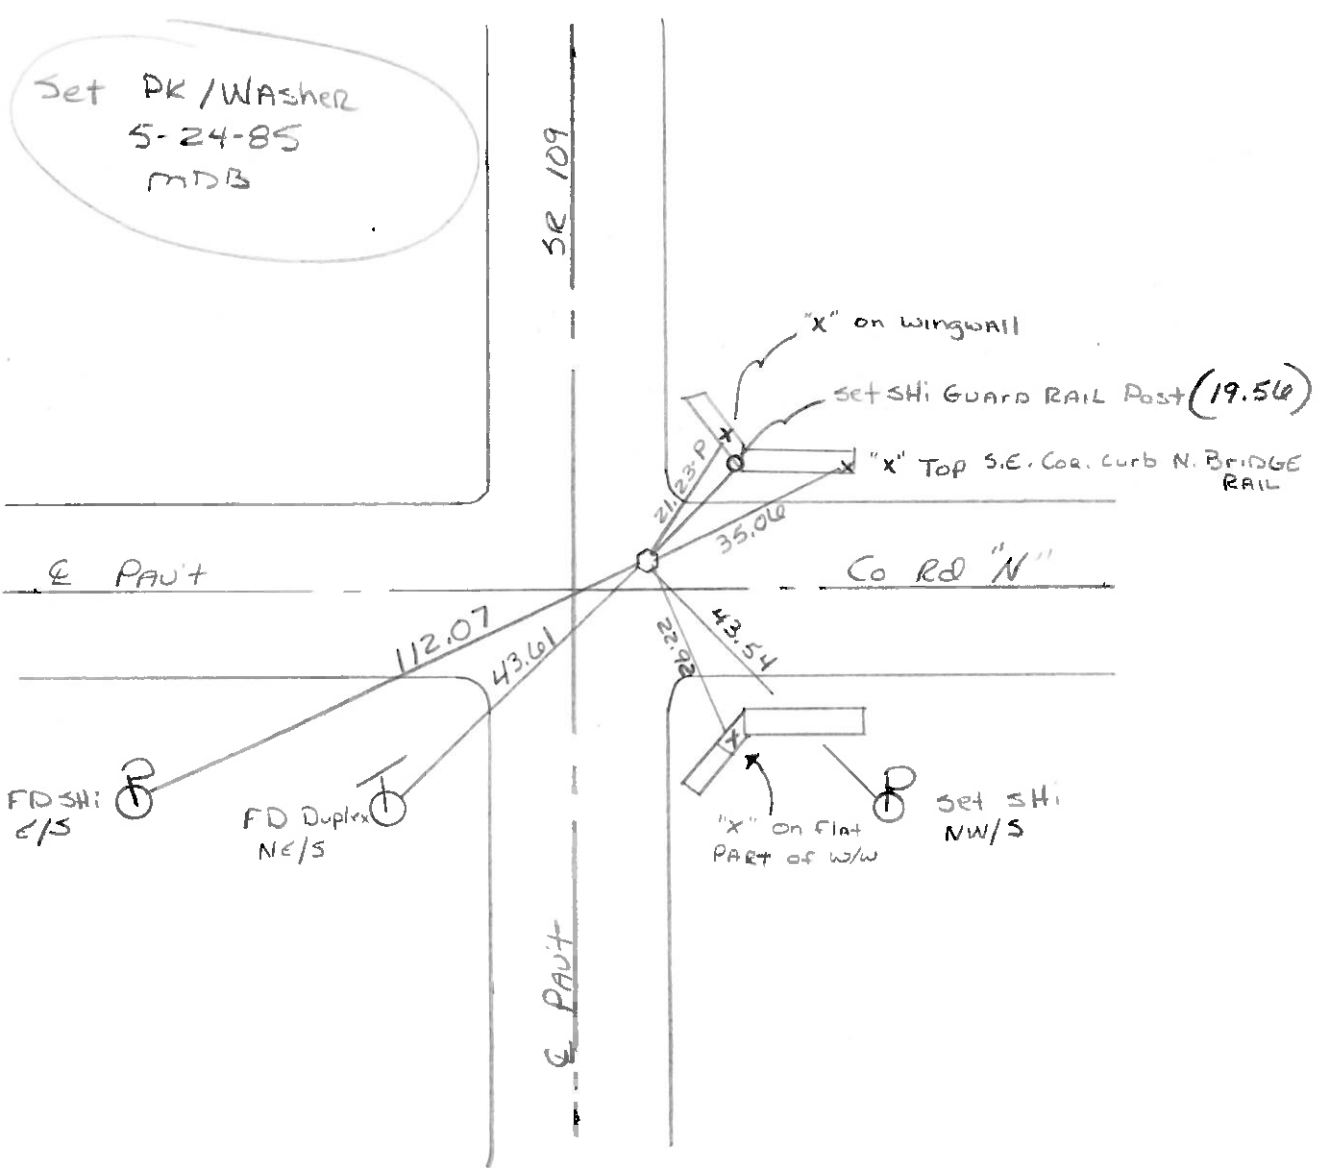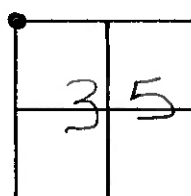

ODOT. DISTRICT 2 SURVEY OFFICE

SHEET _____ OF _____

County Henry S.R. 109

Township Harrison

Section 35

T5N, R7E

Personnel Hoffman

Lochke


Hauscholder

#28

Date 6-1-82

Weather cloudy


Temp. +72°

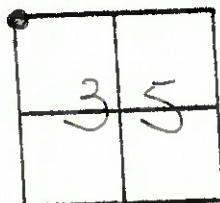

Fd R.R. spk @ surface set by County

7.7' rt. of & part S.R. 109

0.8' North of & part Co. Rd. "N"

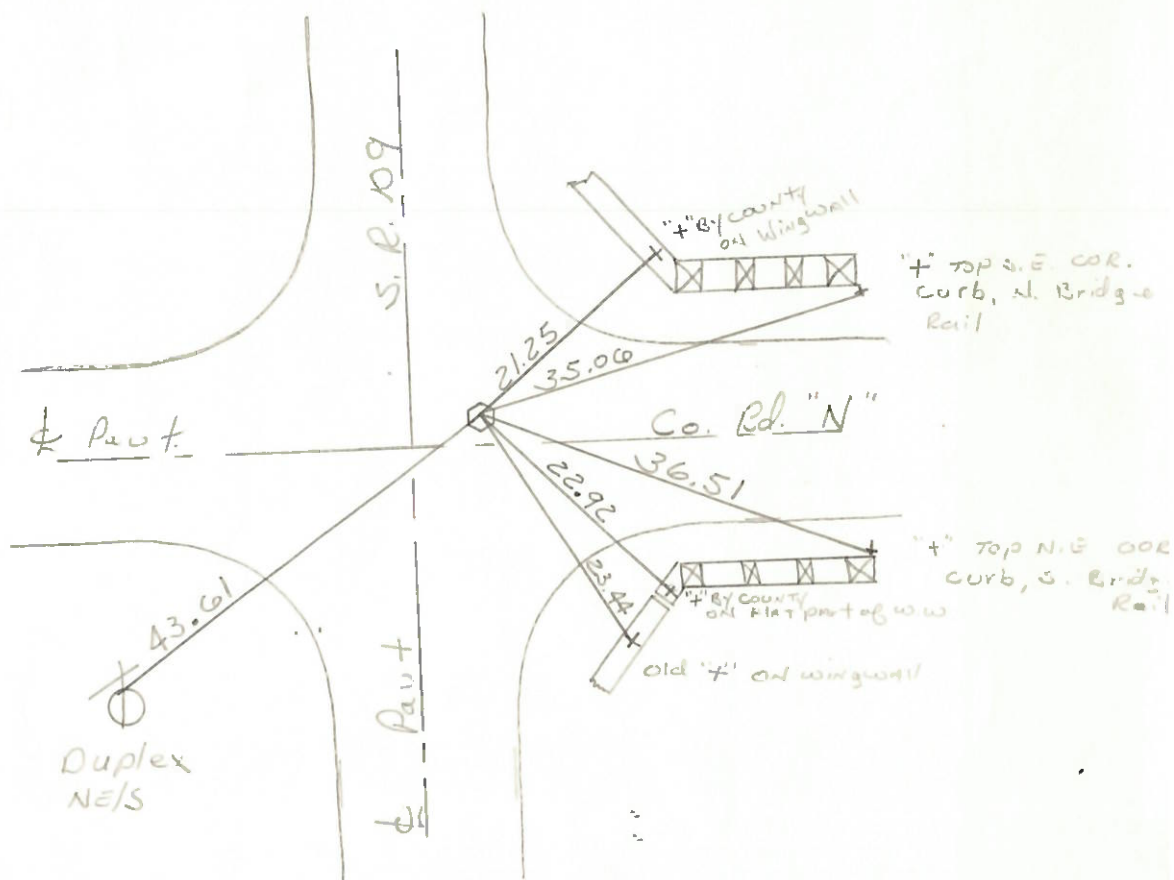

PERSONNEL	TITLE	PERSONNEL	TITLE
PURNSIDE			
SMITH			
BOWERS			
MEAD			

COUNTY HENRY DATE 9-17-76
 S. R. 109 WEATHER CLOUDY-SHOWE
 SEC. W 1/4 Post SEC. 35 TEMP. +65°

DESCRIPTION REF TO CONTROL POINTS JOB NO. _____
 LEFT CENTER LINE RIGHT

