

O.D.O.T. DISTRICT 2 SURVEY OFFICE (USE ONLY)

PERSONNEL

REFERENCE NO. 30 A

SHEET 19 OF 39

NOTES RHOADES DATE 9/3/15

H.C. O'DONNELL WEATHER CLEAR

R.C. RHOADES TEMP. 88°

ROUTE SR 109

COUNTY HENRY

TOWNSHIP HARRISON

SECTION 23

DWG BY RHOADES PID PAVTRAIN

T N R E

TYPE MONUMENT MAG/WASHER

ON SURFACE - ~~BELOW~~ ON

OFFSET \odot PAVEMENT ON LT : RT

9.7' TO LT EDGE PAVEMENT


STATION: 757+16

HORZ. DATUM: NAD83 2011


GEOID: NAVD88 2018

GRID: NORTHING: 625899.104

EASTING: 1546338.985

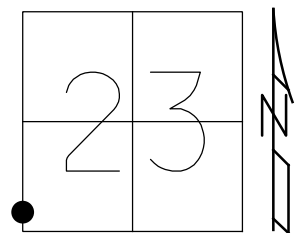


RECORD:
 SET MAG/WASHER
 10-29-04, D.H
 FD MAG/WASHER
 REFA30
 9-1-15, JFO
 8-3-16, JMR
 FD MAG/WASHER
 REFA30
 6/16/21, TDN
 10/5/21, JFO

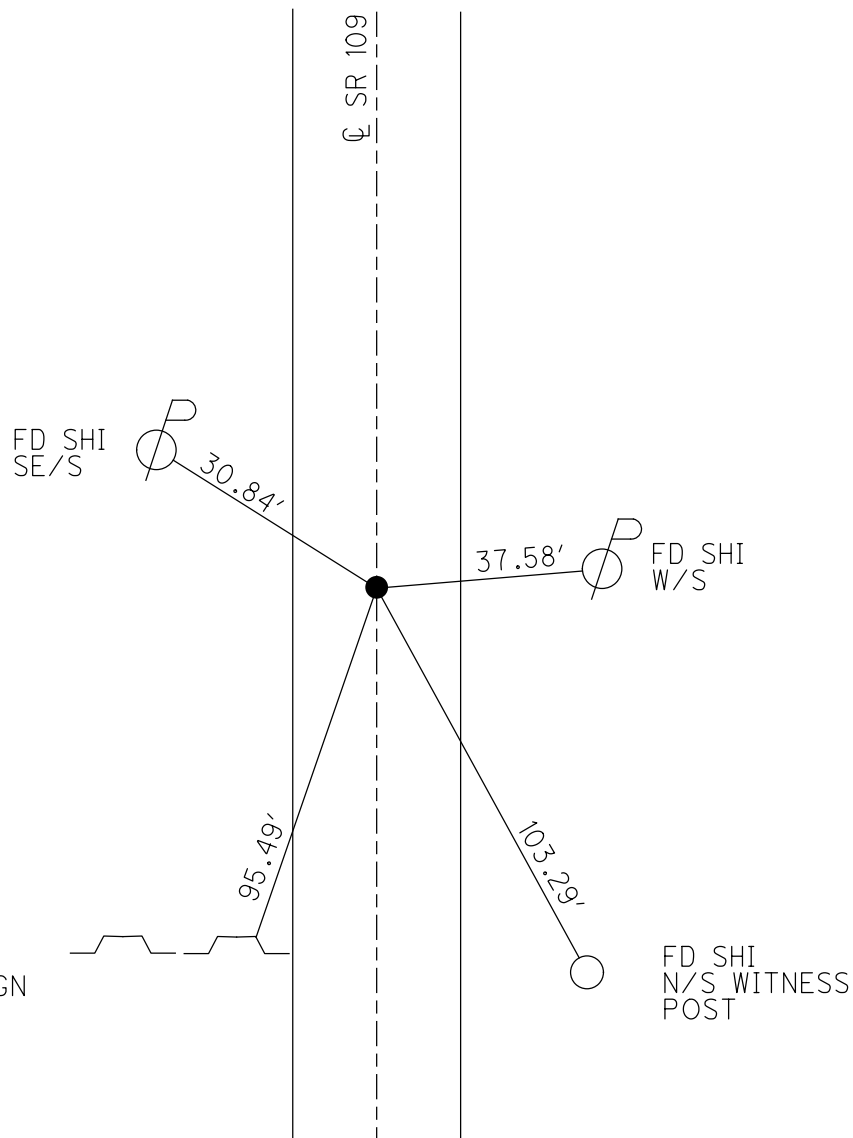

O.D.O.T. DISTRICT 2 SURVEY OFFICE (USE ONLY)


PERSONNEL _____ REFERENCE NO. 30 A SHEET 19 OF 38
 NOTES RHOADES DATE 9-3-16 ROUTE SR 109
 H.C. O'DONNELL WEATHER CLEAR COUNTY HENRY
 R.C. RHOADES TEMP. 88°F TOWNSHIP HARRISON
 SECTION 23
 T 5 N R 7 E

TYPE MONUMENT MAG/WASHER
 ON SURFACE - ~~BELOW~~ ON
 LEFT - ☉ PAV'T - RIGHT ON
9.7' TO LT EDGE PAVEMENT
 S.L.M. 757+16

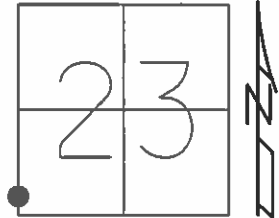

Grid: Northing: 625899.1166 Easting: 1546338.9579

RECORD:
 SET MAG/WASHER
 10-29-04, D.H
 FD MAG/WASHER
 GPS, REFA30
 9-1-15, JFO
 UNCOVERED
 8-3-16, JMR

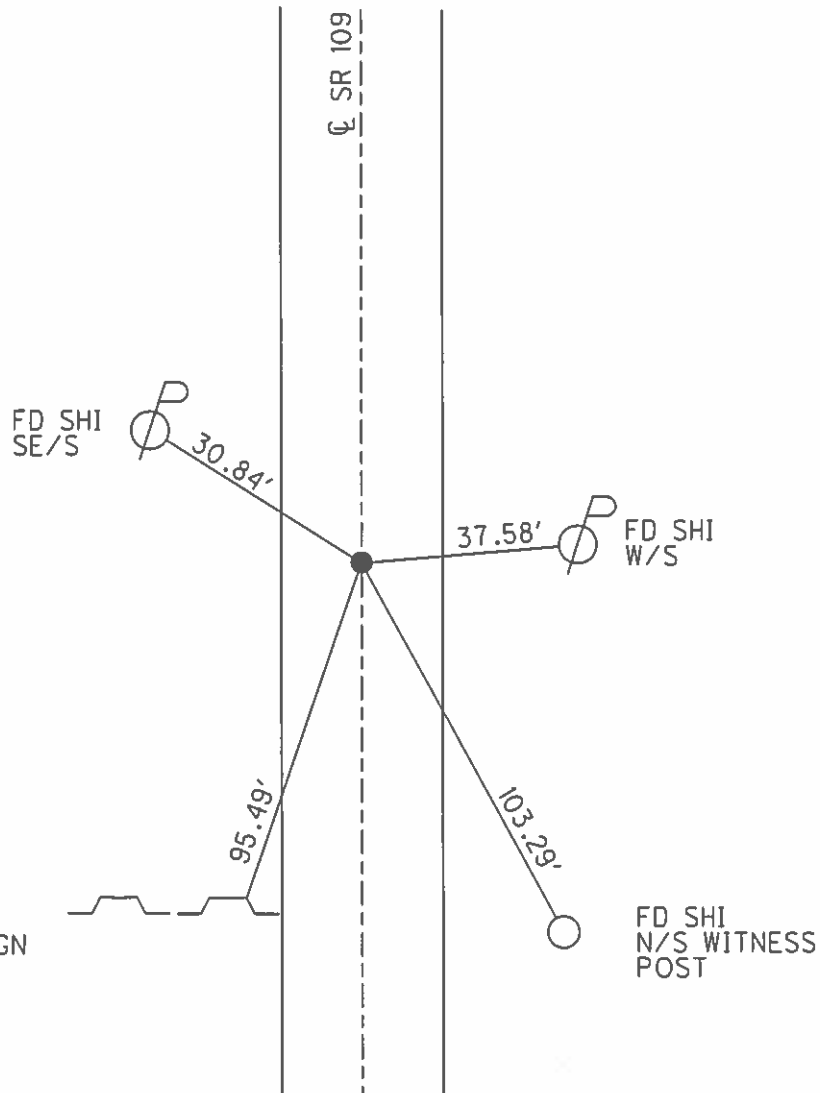

O.D.O.T. DISTRICT 2 SURVEY OFFICE

PERSONNEL

REFERENCE NO. 30-A

SHEET 17 OF 23

NOTES CORDES

H.C. BARNHISEL

R.C. HOOVER

CANTERBURY - DRAWING

DATE 8/27/04

WEATHER OVERCAST

TEMP. + 80°

ROUTE 109

COUNTY HENRY

TOWNSHIP HARRISON

SECTION 23

T5 N R 7 E


TYPE MONUMENT P.K. / WASHER

ON SURFACE - BELOW SURFACE


LEFT - Q PAV'T. - RIGHT 0.5' LT Q

9.7 TO LT. EDGE PAVEMENT

S.L.M. 757 + 16

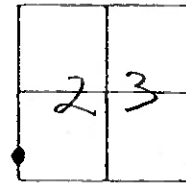

RESET MAG/WASHER
10/29/04
D.H.

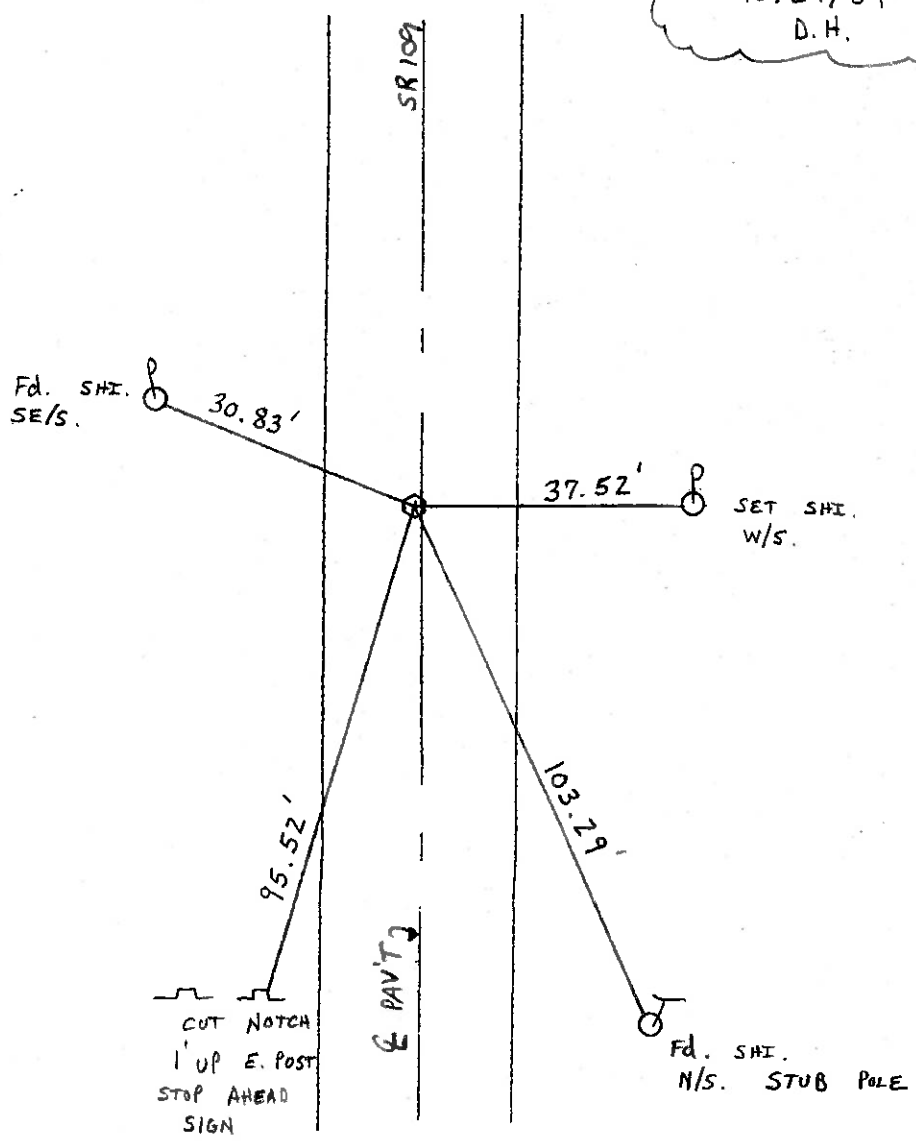

O.D.O.T. DISTRICT 2 SURVEY OFFICE

PERSONNEL _____

REFERENCE NO. _____

SHEET _____ OF _____

NOTES BARNHISEL

H.C. " "

R.C. HOFFMAN

DATE 9-25-90

WEATHER Clear - Windy

TEMP. +70°

ROUTE 109

COUNTY Henry

TOWNSHIP HARRISON

SECTION 23

T 5 N R 7 E


TYPE MONUMENT P.K. NAIL & Washer

ON SURFACE - ~~BELOW~~ yes


~~LEFT - & PAV'T. - RIGHT~~ yes

9.9 TO LT EDGE PAVEMENT

S.L.M. 757+16

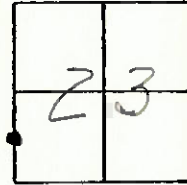

SET P.K. & Washer
 10-4-90
 MB

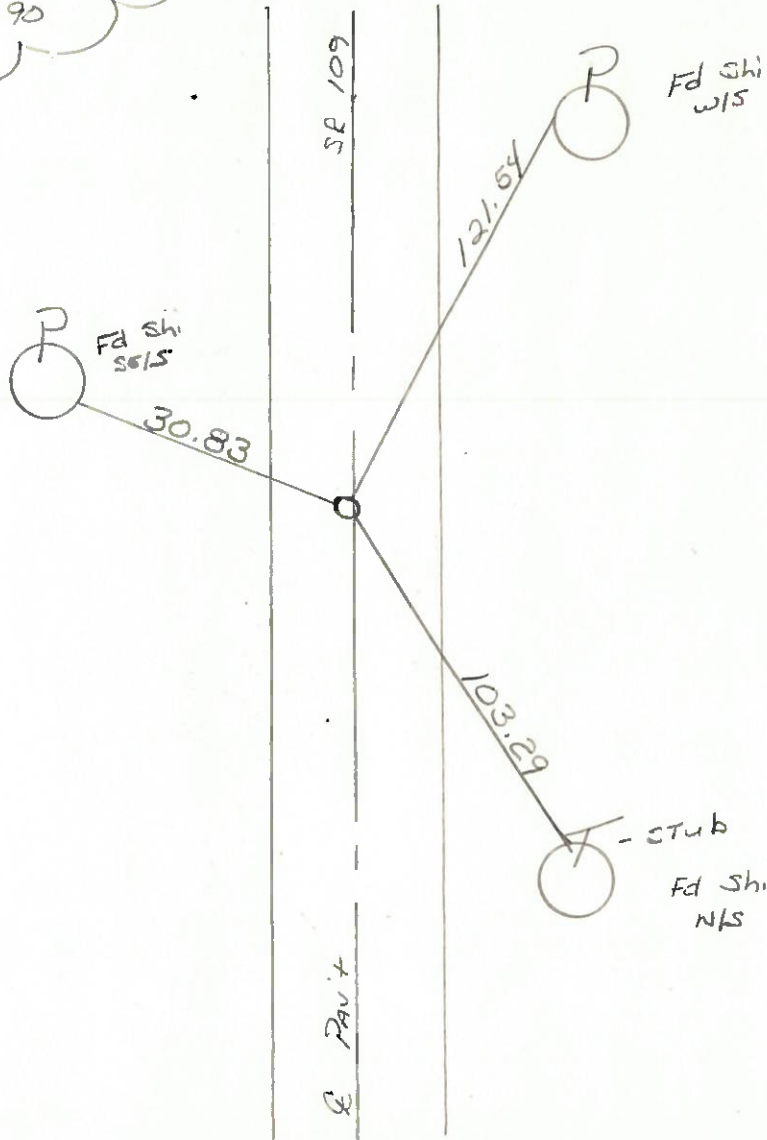

ODOT DISTRICT 2 SURVEY OFFICE

SHEET _____ OF _____

County HENRY S.R. 109

Date 3-19-84

Township HARRISON

Weather OVERCAST

Section 23

Temp. +30


T5N, R7E

Personnel HOFFMAN

LOEHRKE

HOUSEHOLDER R.C.

BARNHISEL H.C.

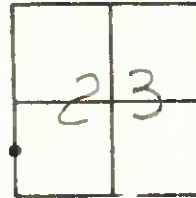

Fd R.P. spk 1" below surface
on R Pavt
8.9' to Lt. EP
9.2' to Rt. EP

SLM 757 +18

SET PK/WASHER
8-23-84
SWH

