

O.D.O.T. DISTRICT 2 SURVEY OFFICE (USE ONLY)

PERSONNEL

REFERENCE NO. 30 B

SHEET 20 OF 39

NOTES RHOADES DATE 9/3/15
 H.C. O'DONNELL WEATHER CLEAR
 R.C. RHOADES TEMP. 88°

ROUTE SR 109
 COUNTY HENRY
 TOWNSHIP HARRISON
 SECTION 23
 T 5 N R 7 E

DWG BY RHOADES PID PAVTRAIN

TYPE MONUMENT MAG/WASHER

ON SURFACE - ~~BELOW~~ ON

OFFSET \varnothing PAVEMENT 1.0' ~~±~~ : RT

10.5' TO LT EDGE PAVEMENT


STATION: 767+41

HORIZ.DATUM: NAD83 2011


GEOID: NAVD88 2018

GRID: NORTHING: 626924.182

EASTING: 1546360.213

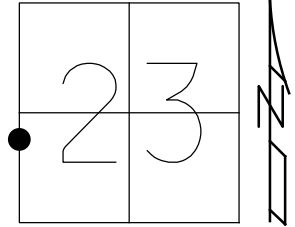

RECORD:
 SET MAG/WASHER
 10-29-04, D.H
 FD MAG/WASHER
 REFB30
 9-1-15, JFO
 8-3-16, JMR
 FD MAG/WASHER
 REFB30
 6/16/21, TDN
 10/5/21, JFO

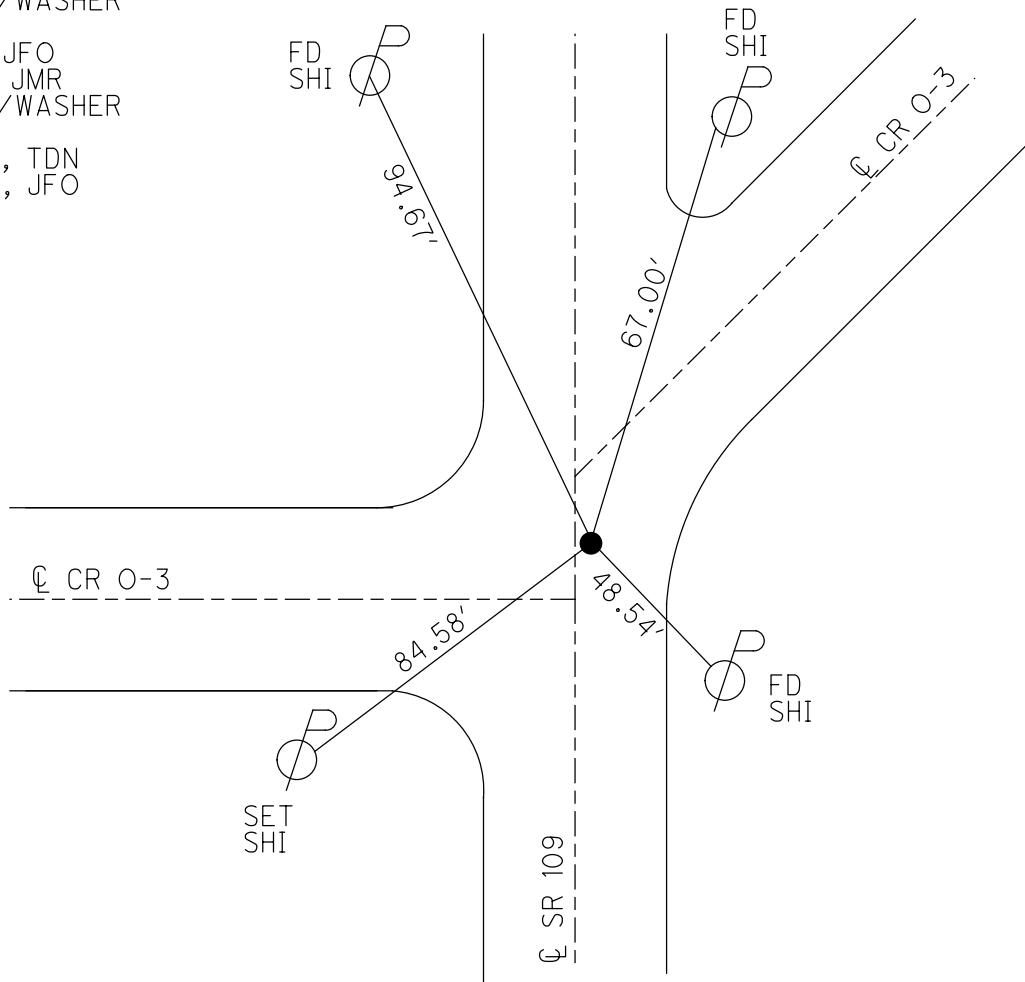

O.D.O.T. DISTRICT 2 SURVEY OFFICE (USE ONLY)

PERSONNEL _____ REFERENCE NO. 30 B SHEET 20 OF 38

NOTES RHOADES DATE 9-3-15 ROUTE SR 109
 H.C. O'DONNELL WEATHER CLEAR COUNTY HENRY
 R.C. RHOADES TEMP. 88°F TOWNSHIP HARRISON
 _____ SECTION 23
 _____ T 5 N R 7 E

TYPE MONUMENT MAG/WASHER


ON SURFACE - ~~BELOW~~ ON _____

~~LEFT~~ - ☉ PAV'T - RIGHT 1.0'

10.5' TO LT EDGE PAVEMENT

S.L.M. 767+41


Grid: Northing: 626924.214 Easting: 1546360.2099

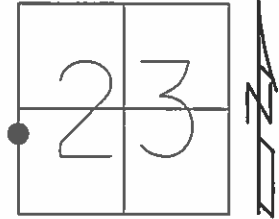

RECORD:
 SET MAG/WASHER
 10-29-04, D.H

FD MAG/WASHER
 GPS, REFB30
 9-1-15, JFO

UNCOVERED
 8-3-16, JMR

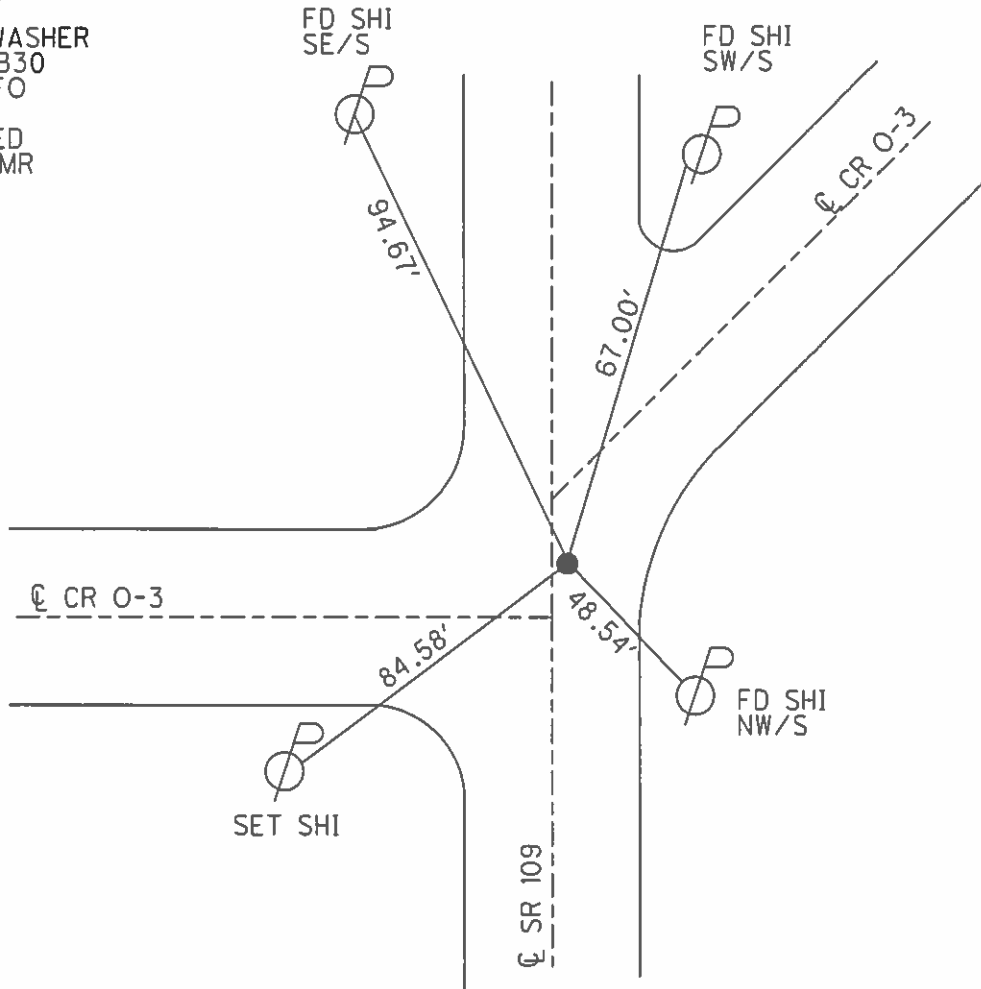

NOTE:
 42' N. OF ☉ WEST

O.D.O.T. DISTRICT 2 SURVEY OFFICE

PERSONNEL

REFERENCE NO. 30-B

SHEET 18 OF 23

NOTES CORDES

H.C. BARNHISEL

R.C. HOOVER

MC - DRAWING

DATE 8/27/04

WEATHER OVERCAST

TEMP. + 80°

ROUTE SR 109

COUNTY HENRY

TOWNSHIP HARRISON

SECTION 23

T 5 N R 7 E

TYPE MONUMENT P.K. / WASHER



ON SURFACE - ~~BELOW~~ SURFACE

~~LEFT - & PAV'T.~~ - RIGHT 0.5' RT &

10.5 TO LT. EDGE PAVEMENT

S.L.M. 767 + 41

42' N. OF & WEST

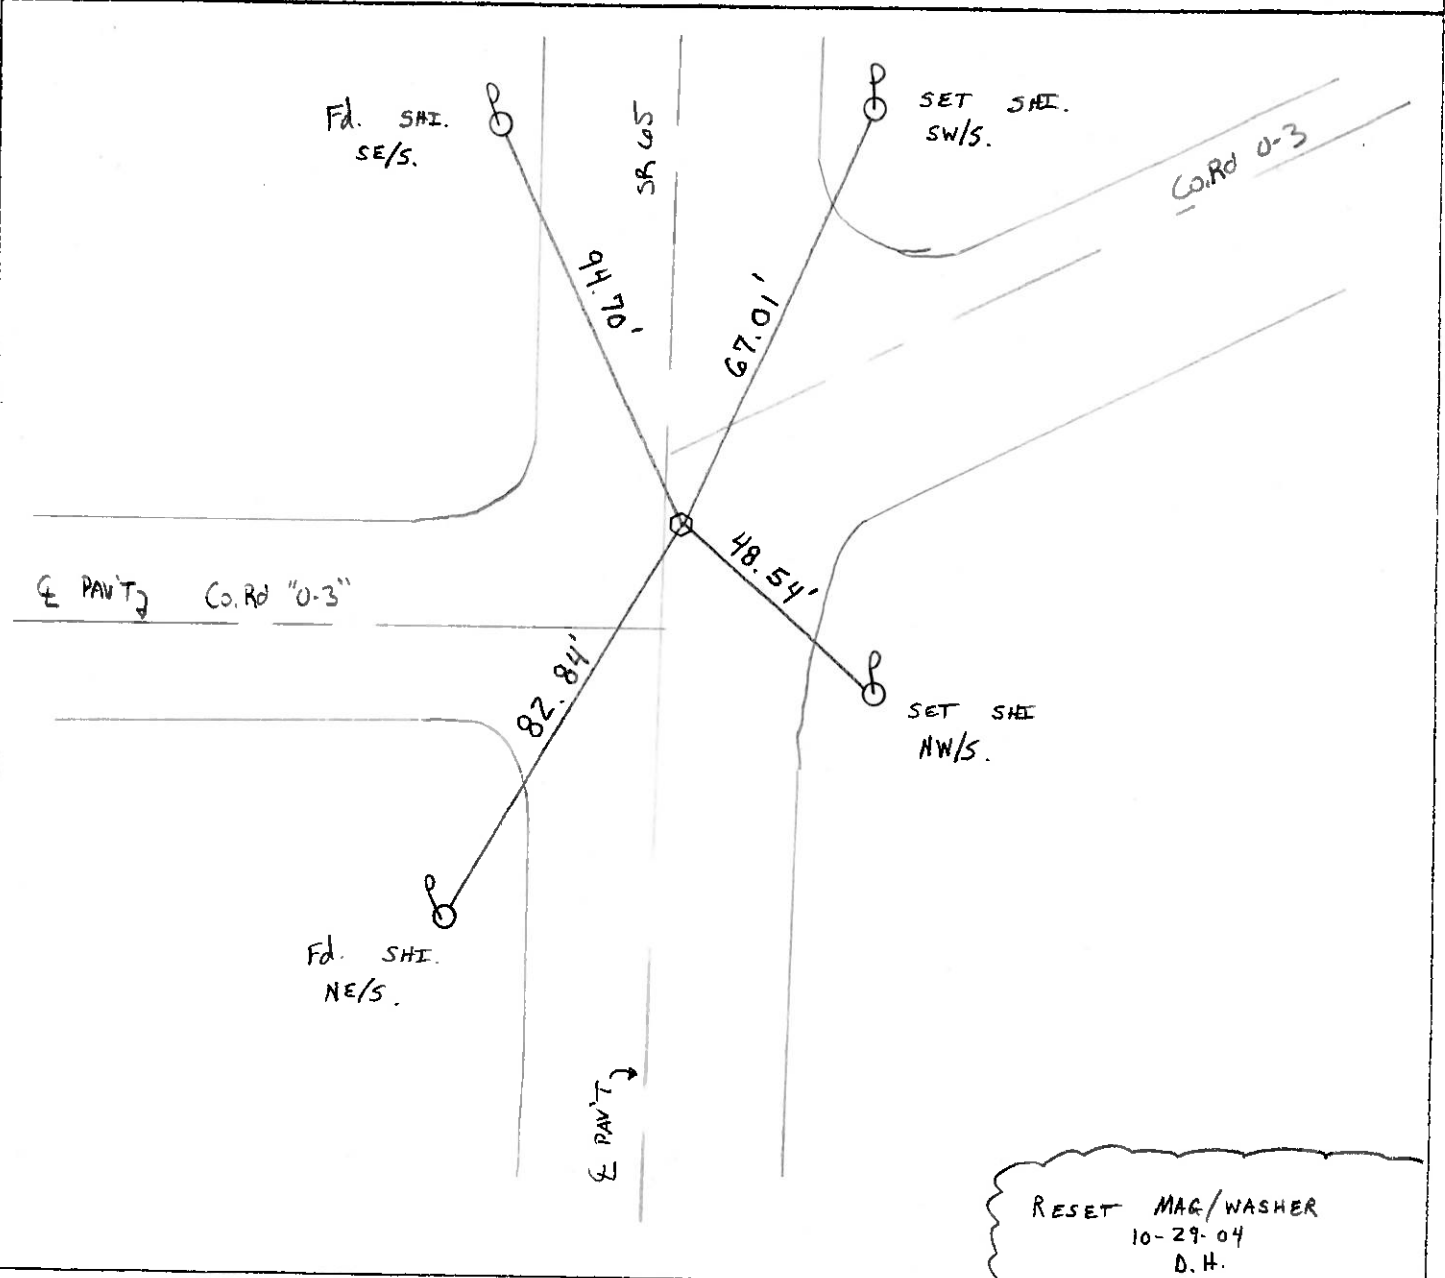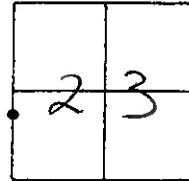

O.D.O.T. DISTRICT 2 SURVEY OFFICE

PERSONNEL _____

REFERENCE NO. _____

SHEET 1 OF 2

NOTES HOFFMAN

H.C. BANKHISEL

R.C. _____

DATE 3-29-91

WEATHER CLEAR

TEMP. 48°

ROUTE SR 109

COUNTY HENRY

TOWNSHIP HARRISON

SECTION 23

T S N R 7 E

TYPE MONUMENT P.K. NAIL/WASHER


ON SURFACE - BELOW YES

LEFT - & PAV'T. - RIGHT 0.6


9.3 JOINT EDGE PAVEMENT

S.L.M. 767+40

Re-Set
P.I.C./WASHER
5-9-91
MB

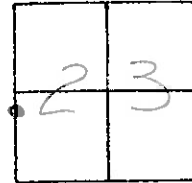

PLAN (1990) sta. =

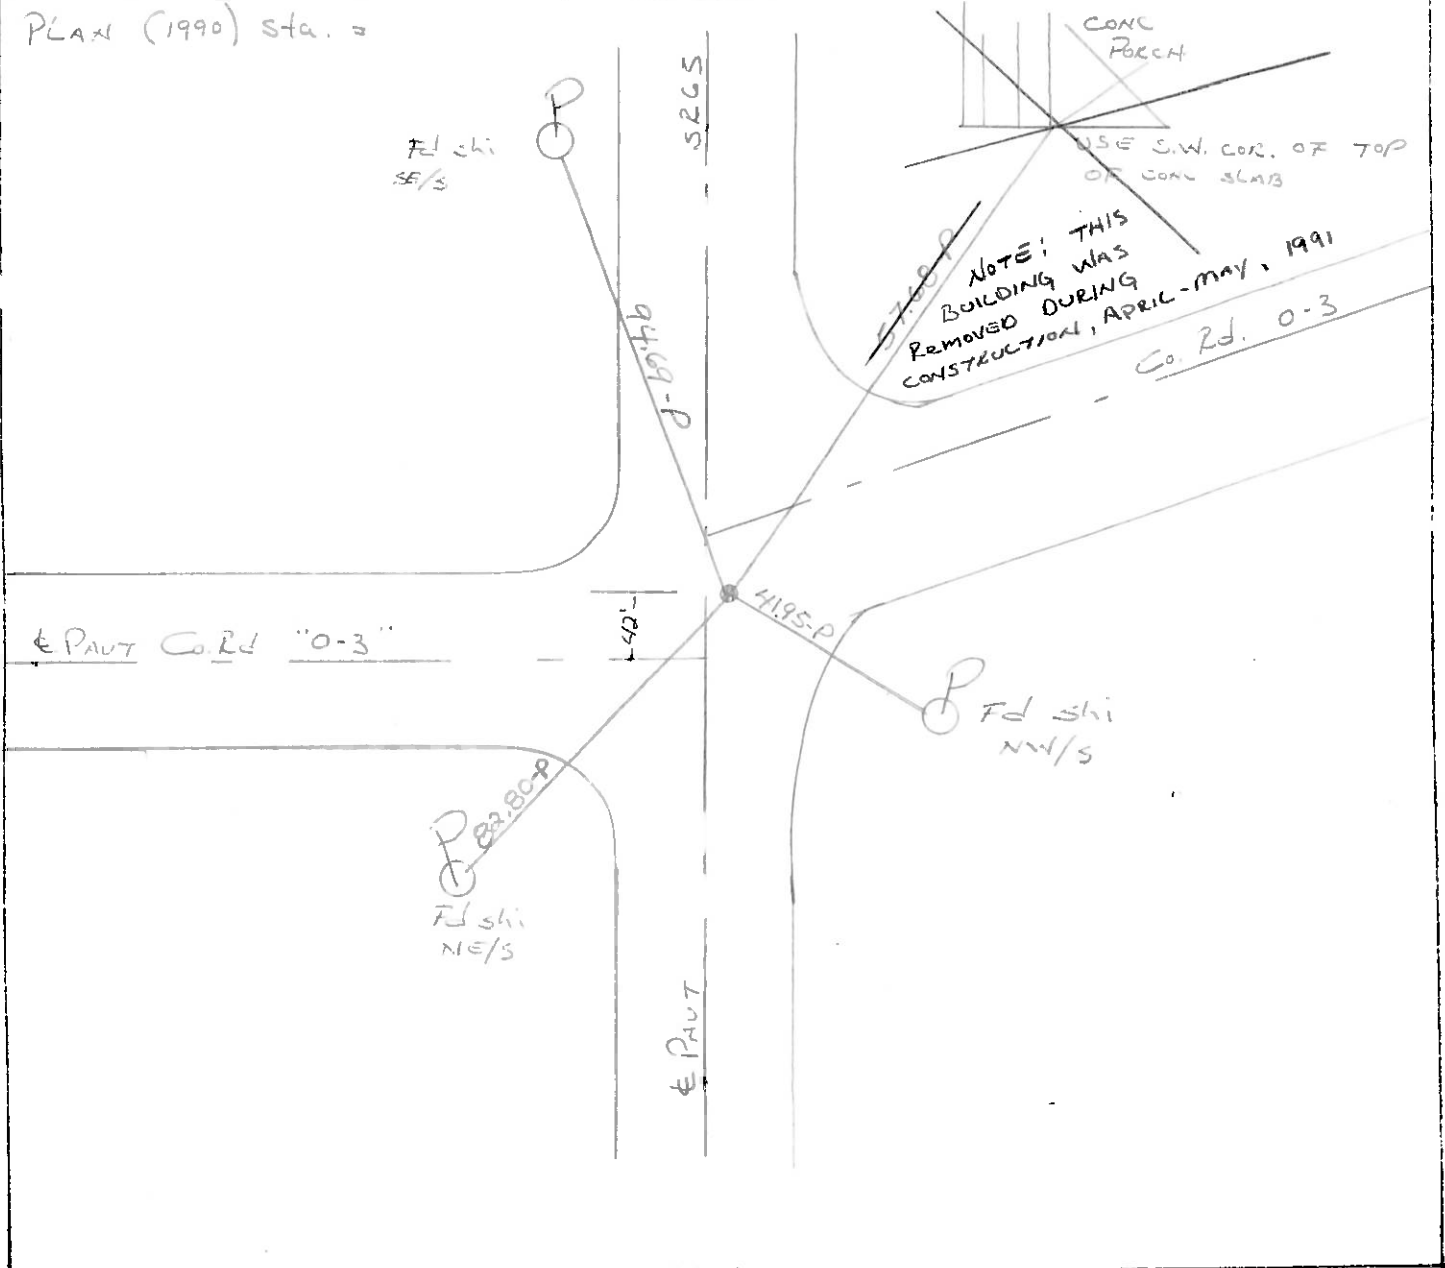

O.D.O.T. DISTRICT 2 SURVEY OFFICE

PERSONNEL _____

REFERENCE NO. _____

SHEET _____ OF _____

NOTES BARNHISEL

H.C. " "

R.C. HOFFMAN

DATE 9-25-90

WEATHER clear-windy

TEMP. +70°

ROUTE 109

COUNTY HENRY

TOWNSHIP HARRISON

SECTION 23

T 5 N R 7 E



TYPE MONUMENT PK NAIL & Washer

ON SURFACE - ~~BELOW~~ YES

LEFT - & PAV'T. - RIGHT 0.6

9.3 TO RT EDGE PAVEMENT

S.L.M. 767 + 40

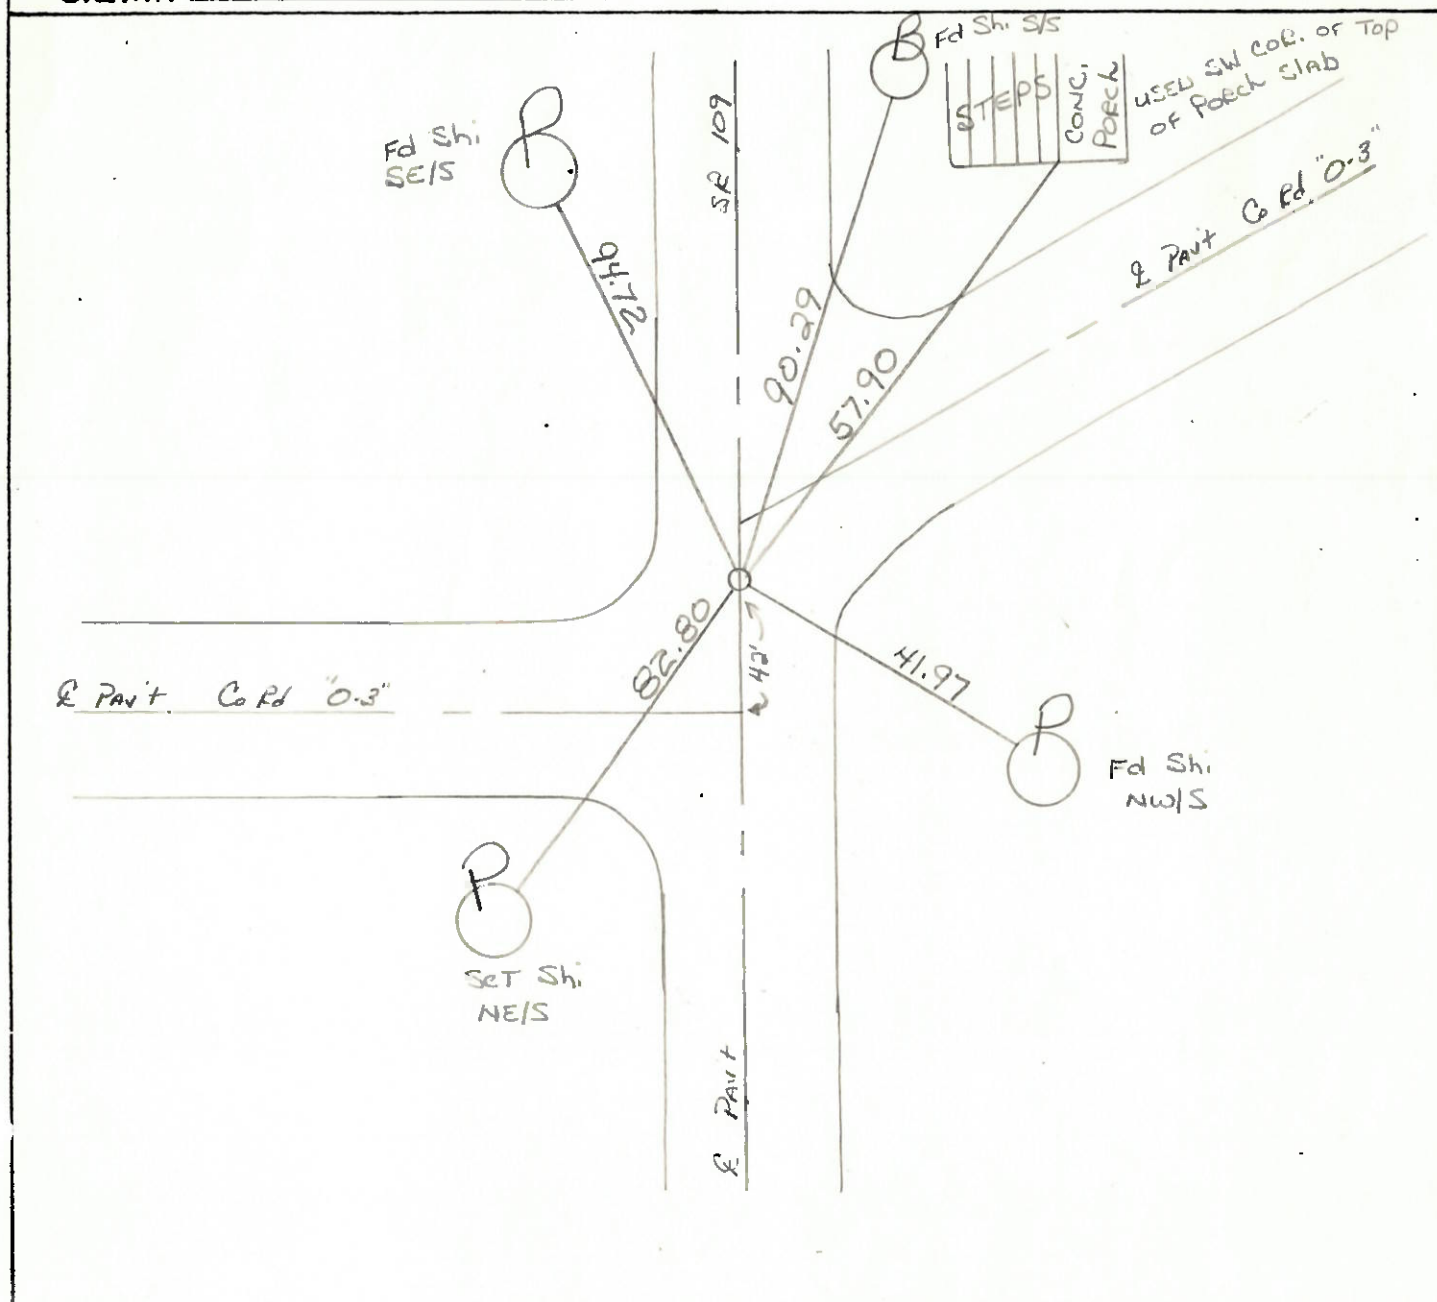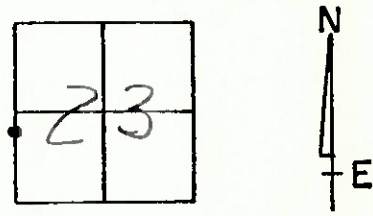

Q.D.O.T. DISTRICT 2 SURVEY OFFICE

SHEET _____ OF _____

County HENRY S.R. 109

Date 3-19-84

Township HARRISON


Weather OVERCAST

Section 23

Temp. +30°

T5N, R7E

Personnel HOFFMAN

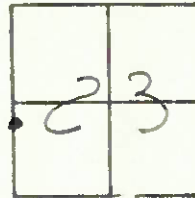

LOEBRKE

HOUSEHOLDER R.C.

BARNHISEL H.C.

Fd P.K. Nail @ surface
ORIGIN UNKNOWN

S.L.M. = 766 + 44

SET PK/WASHER
8-23-84
S.W.H.

