

O.D.O.T. DISTRICT 2 SURVEY OFFICE (USE ONLY)

PERSONNEL _____ REFERENCE NO. 31 SHEET 21 OF 39

NOTES CORDES DATE 8/27/04 ROUTE SR 109
 H.C. BARNHISEL WEATHER OVERCAST COUNTY HENRY
 R.C. HOOVER TEMP. 80° TOWNSHIP HARRISON

SECTION 23
 T 5 N R 7 E

DWG BY RHOADES PID PVTRAIN

TYPE MONUMENT MONBOX W/IPIN


ON SURFACE - ~~BELOW~~ ON _____

OFFSET \odot PAVEMENT 1.4' ~~LT~~ : RT
8.6' TO RT EDGE PAVEMENT


STATION: 770+40

HORZ. DATUM: NAD83 2011 GEOID: NAVD88 2018

GRID: NORTHING: 627222.507 EASTING: 1546366.373

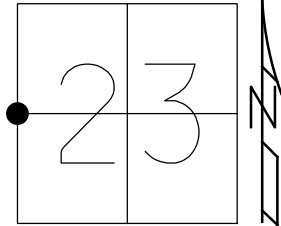


RECORD:
 FD R.R. SPIKE
 SET BY HENRY CO.
 9-4-80
 FD MONBOX
 MONREF31
 9-1-15, JFO
 8-3-16, JMR
 FD MONBOX
 SHOT TOP
 REF31
 6/16/21, TDN
 10/5/21, JFO

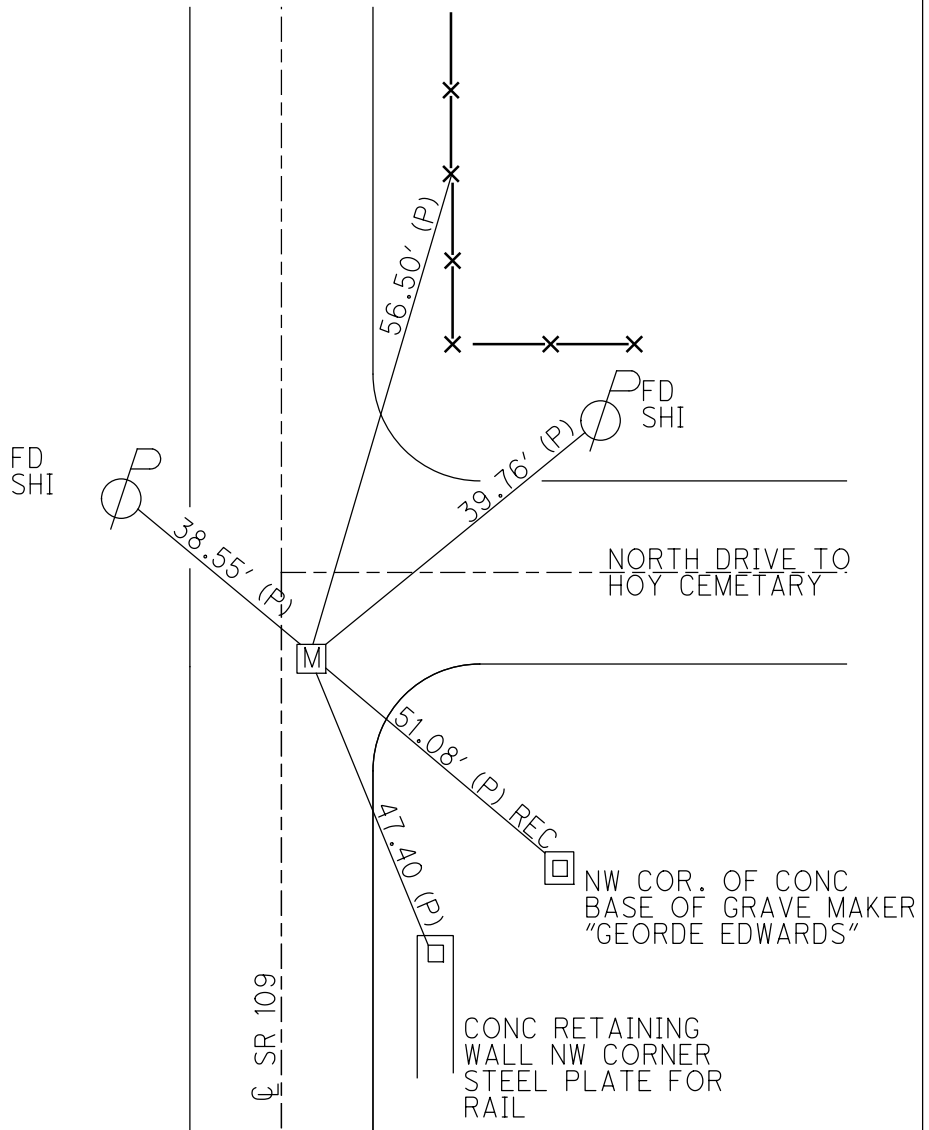


O.D.O.T. DISTRICT 2 SURVEY OFFICE (USE ONLY)

PERSONNEL _____ REFERENCE NO. 31 SHEET 21 OF 38
 NOTES CORDES DATE 8-27-04 ROUTE SR 109
 H.C. BARNHISEL WEATHER OVERCAST COUNTY HENRY
 R.C. HOOVER TEMP. 80°F TOWNSHIP HARRISON
 _____ SECTION 23
 _____ T 5 N R 7 E

TYPE MONUMENT MON BOX W/ IPIN
 ON SURFACE - ~~BELOW~~ ON
~~LEFT~~ - CL PAV'T - RIGHT 1.4'
8.6' TO RT EDGE PAVEMENT
 S.L.M. 770+40
 Grid: Northing: 627222.5674 Easting: 1546366.3801

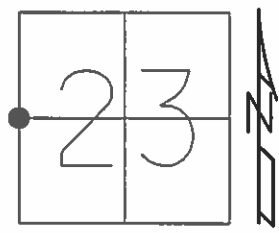

RECORD:
 FD RR. SPIKE
 SET BY HENRY COUNTY
 9-4-80
 FD MON BOX
 GPS, MONREF31
 9-1-15, JFO
 NOT COVERED
 POOR CONDITION
 8-3-16, JMR

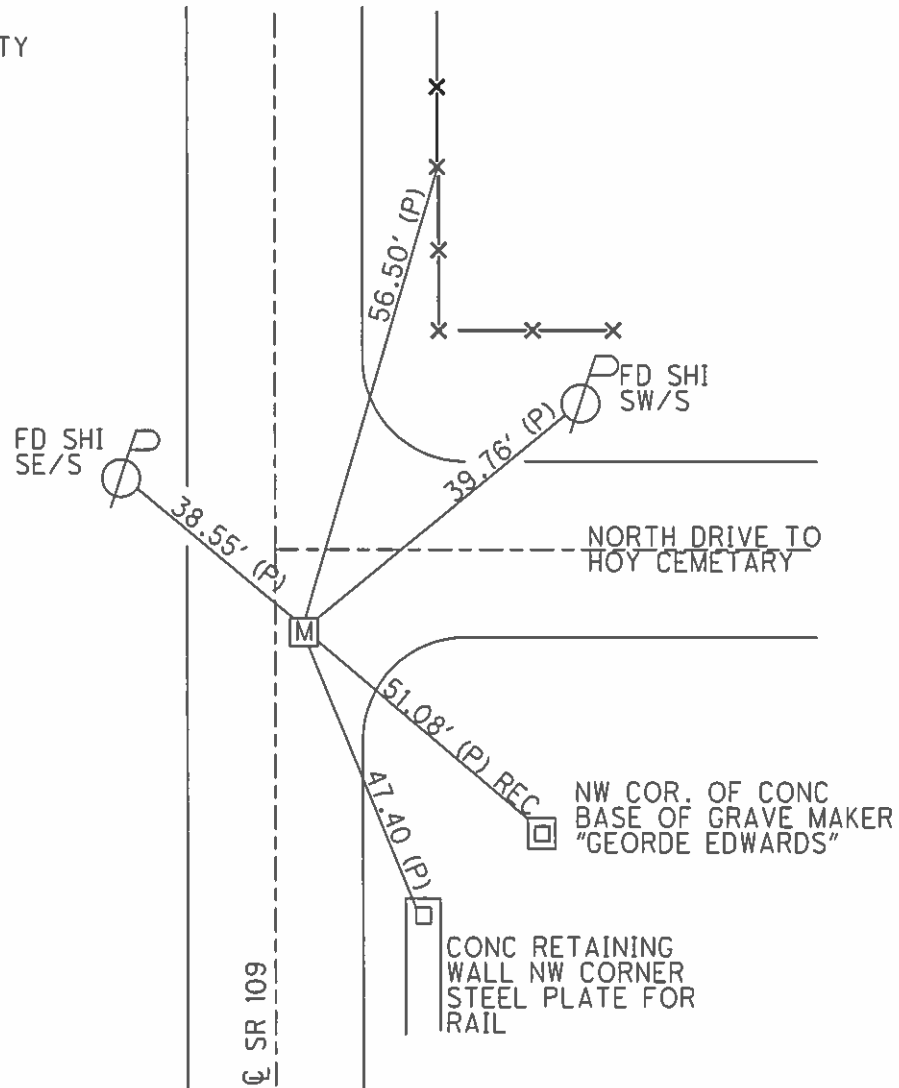

O.D.O.T. DISTRICT 2 SURVEY OFFICE

PERSONNEL

REFERENCE NO. 31

SHEET 19 OF 23

NOTES CORDES

H.C. BARNHISEL

R.C. HOOVER

DATE 8/27/04

WEATHER OVERCAST

TEMP. + 80°

ROUTE SR 109

COUNTY HENRY

TOWNSHIP HARRISON

SECTION 23

T 5 N R 7 E


TYPE MONUMENT MON BOX W/ I PIN

ON SURFACE - ~~BELOW~~ SURFACE


~~LEFT - & PAV'T. - RIGHT~~ 1.4' RT &

8.6 TO RT. EDGE PAVEMENT

S.L.M. 770 + 40

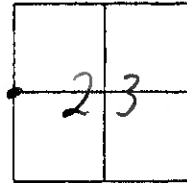

RECORD: FD R.R. SPIKE
SET BY HENRY COUNTY
9-4-80

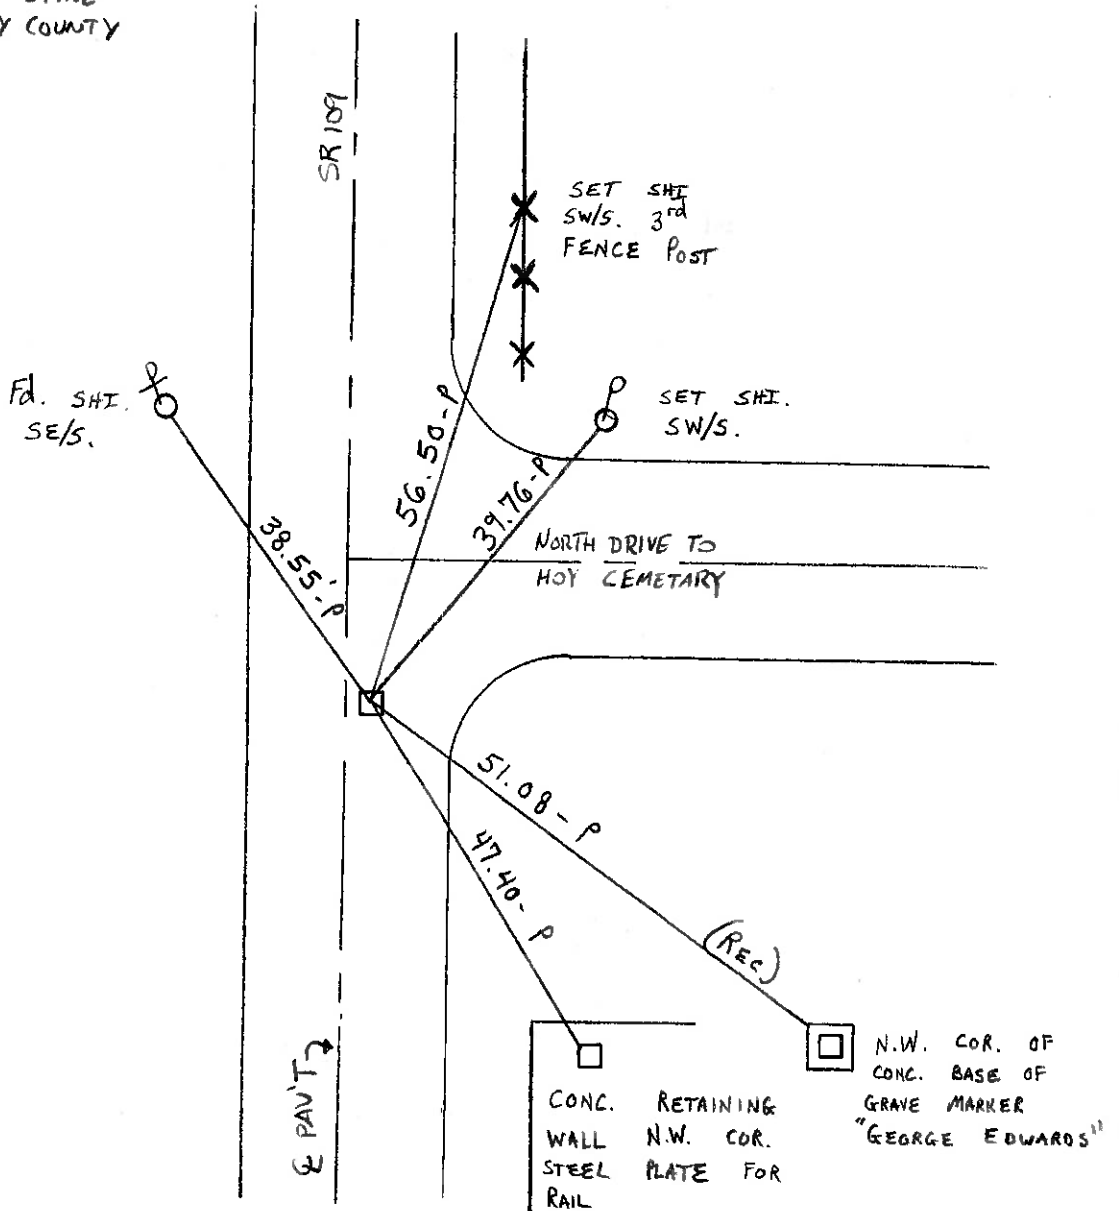

O.D.O.T. DISTRICT 2 SURVEY OFFICE

PERSONNEL _____

REFERENCE NO. 31

SHEET 2 OF 2

NOTES HOFFMAN

H.C. BARNISEL

R.C. _____

DATE 3-29-91

WEATHER CLEAR

TEMP. 48°

ROUTE SR 109

COUNTY HENRY

TOWNSHIP HARRISON

SECTION 23

T 5 N R 7 E


TYPE MONUMENT R.R. SPIKE / Center PUNCH HOLE

ON SURFACE - BELOW 1 1/2"

LEFT - C PAV'T. - RIGHT 1.1'


B.C. TO RT. EDGE PAVEMENT

S.L.M. 770 + 39

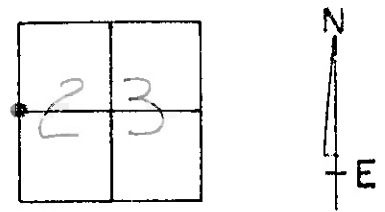

PLAN (1990) STA. =
 Record: FJ R.R SPIKE SET
 BY HENRY COUNTY 9-4-80

NOTE: Re-set P.I.C. FOR
 CONTROL POINT AND 4
 NAILS FOR STRADDLE TIES
 TO BE USED BY THE
 CONTRACTOR TO SET A
 NEW MONUMENT BOX,
 5-9-91 MB & CL

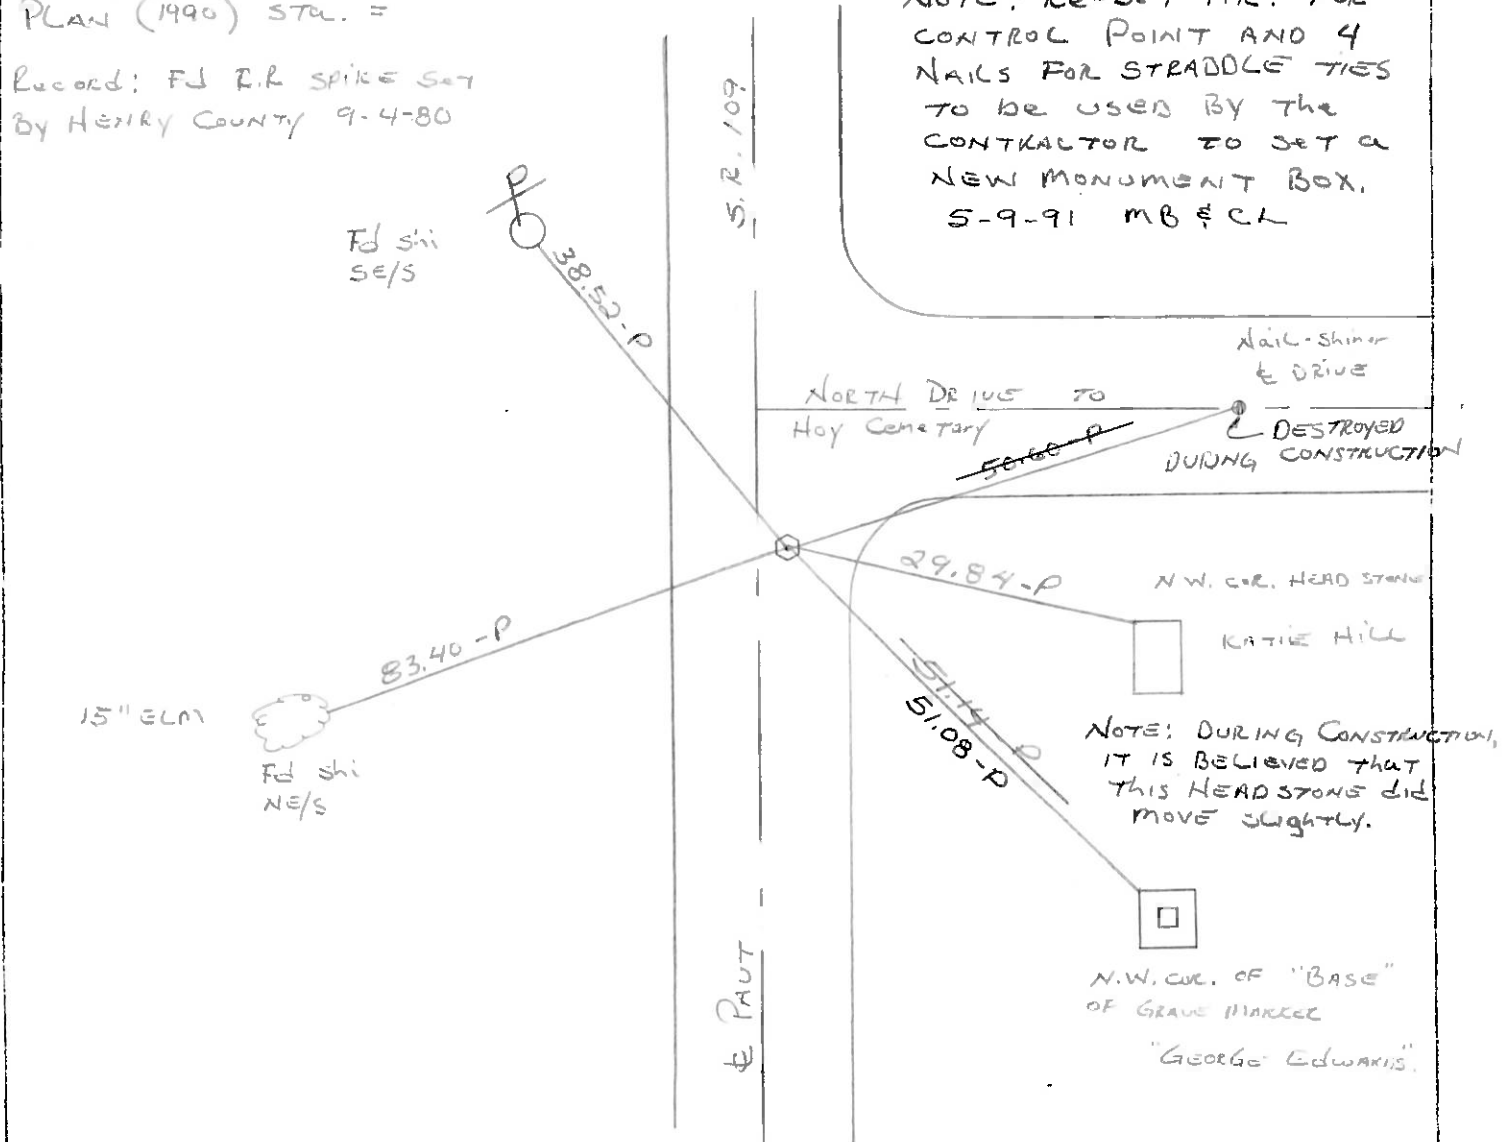

NOTE: DURING CONSTRUCTION,
 IT IS BELIEVED THAT
 THIS HEADSTONE DID
 MOVE SLIGHTLY.

N.W. COR. OF "BASE"
 OF GRAVE MARKER
 "George Edwards"

O.D.O.T. DISTRICT 2 SURVEY OFFICE

PERSONNEL _____

REFERENCE NO. 31

SHEET _____ OF _____

NOTES BAENHISEL

H.C. " "

R.C. HOFFMAN

DATE 9-25-90

WEATHER CLEAR - WINDY

TEMP. +70°

ROUTE 109

COUNTY HENRY

TOWNSHIP HARRISON

SECTION 23

T. 5 N. R. 7 E.



TYPE MONUMENT PK NAIL & Washers

ON SURFACE - ~~BELOW~~ YES

LEFT - ☉ PAV'T. - RIGHT 1.1

8.6 TO RT EDGE PAVEMENT

S.L.M. 770 + 39

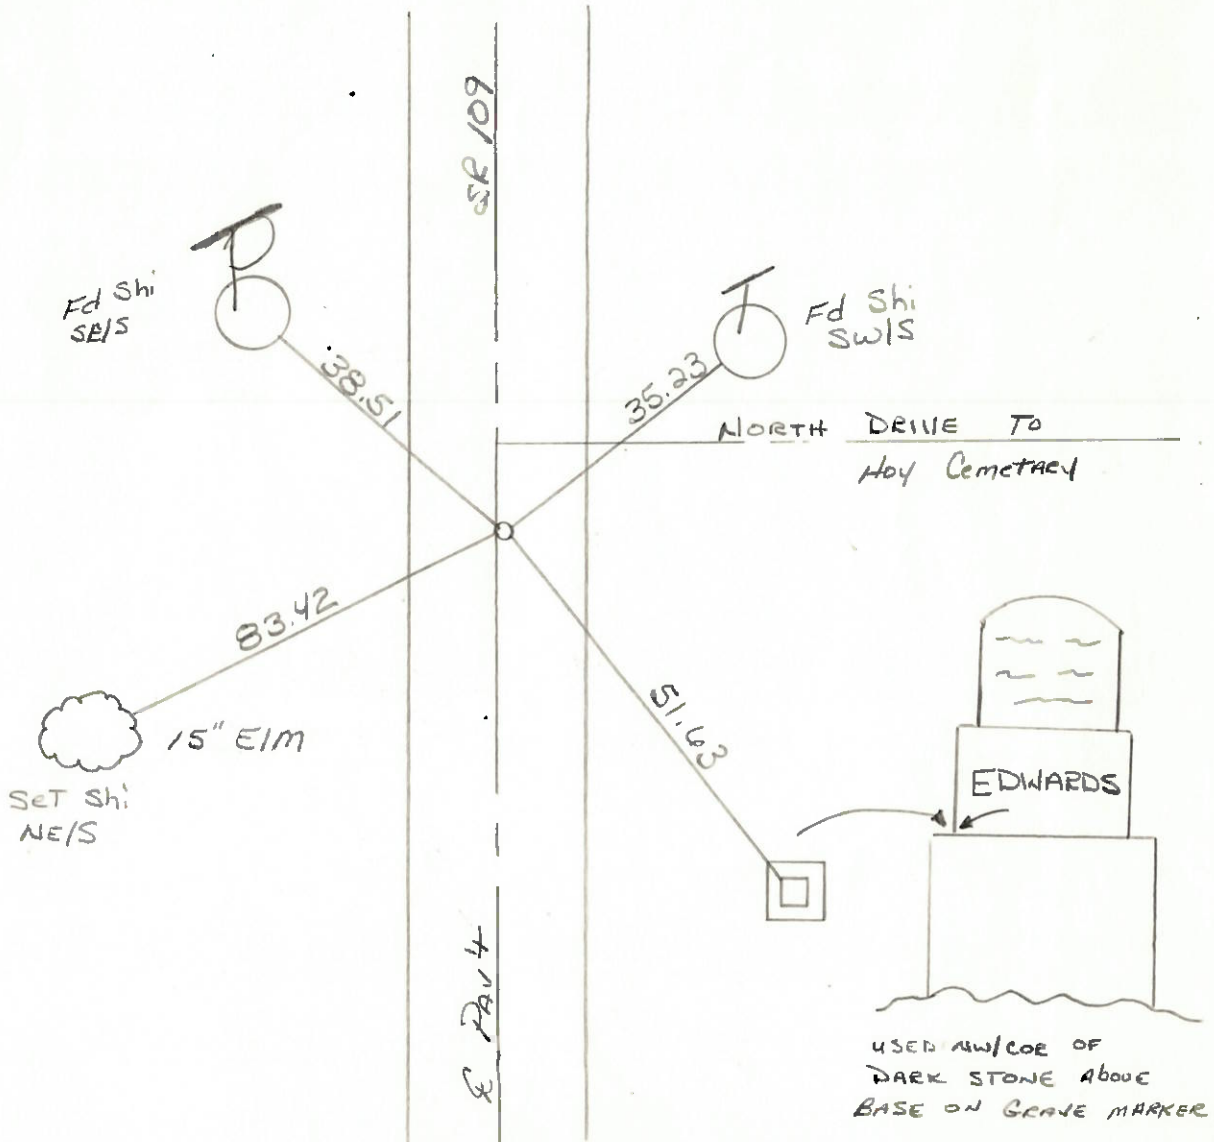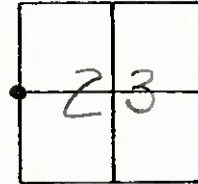

County HENRY S.R. 109

Township HARRISON

Section 23

TSN, R7E

Personnel HOFFMAN

LOCHARKE

HOUSEHOLDER R.C.


BARNHISEL H.C.

#31

Date 3-19-84

Weather OVERCAST

Temp. +30°

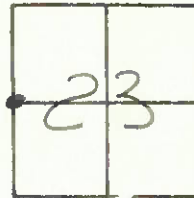

Fd R.R. SPK/CTR PAINT HOLE @ surface

Set BY COUNTY

1.0' RT of & PAINT

10.0' LT EP

0.3 RT EP

S.L.M. = 770 + 43

SET PK/WASHER

8-23-84

S.W.H.

