

O.D.O.T. DISTRICT 2 SURVEY OFFICE (USE ONLY)

PERSONNEL

REFERENCE NO. 32

SHEET 22 OF 39

NOTES RHOADES

DATE 9/3/15

ROUTE SR 109

H.C. O'DONNELL

WEATHER CLEAR

COUNTY HENRY

R.C. RHOADES

TEMP. 88°

TOWNSHIP HARRISON

SECTION 23

DWG BY RHOADES PID PAVTRAIN

T 5 N R 7 E

TYPE MONUMENT MAG/WASHER

ON SURFACE - ~~BELOW~~ ON

OFFSET 6' LT : ~~RT~~

- TO - EDGE PAVEMENT


STATION: 796+79

HORZ.DATUM: NAD83 2011

GEOID: NAVD88 2018


GRID: NORTHING: 629863.161

EASTING: 1546421.292



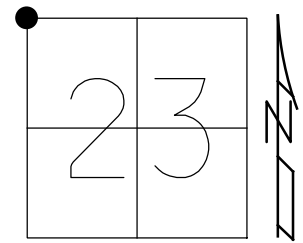


SHARON
METHODIST
CHURCH SIGN

TOP OF 4TH
BRICK UP
SOUTH COR. OF
CHURCH SIGN

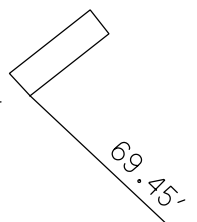

RECORD:
SET MAG/WASHER
10-29-04, DH
FD MAG SHANK
REF32
9-1-15, JFO
8-3-16, JMR
FD MAG/WASHER
REF32
6/16/21, TDN
10/5/21, JFO

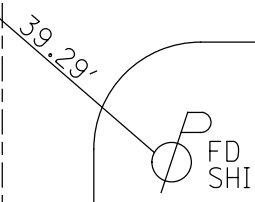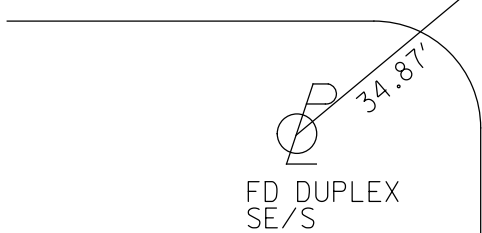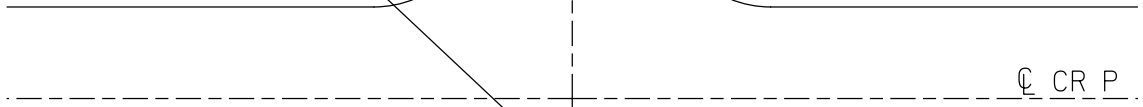


CR SR 109

O.D.O.T. DISTRICT 2 SURVEY OFFICE (USE ONLY)

PERSONNEL _____ REFERENCE NO. 32 SHEET 22 OF 38

NOTES RHOADES DATE 9-3-15 ROUTE SR 109
 H.C. O'DONNELL WEATHER CLEAR COUNTY HENRY
 R.C. RHOADES TEMP. 88°F TOWNSHIP HARRISON
 _____ SECTION 23
 _____ T 5 N R 7 E

TYPE MONUMENT MAG/WASHER
 ON SURFACE - ~~BELOW~~ ON
 LEFT - ☉ PAV'T - ~~RIGHT~~ 6.0'
 - TO - EDGE PAVEMENT
 S.L.M. 796+79

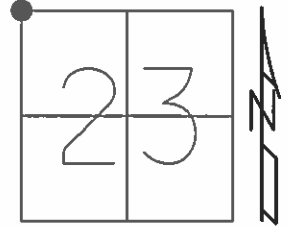


Grid: Northing: 629863.1833 Easting: 1546421.3330

RECORD:
 SET MAG/WASHER
 10-29-04, DH

FD SHANK
 GPS, REF32
 9-1-15, JFO

NOT COVERED
 8-3-16, JMR

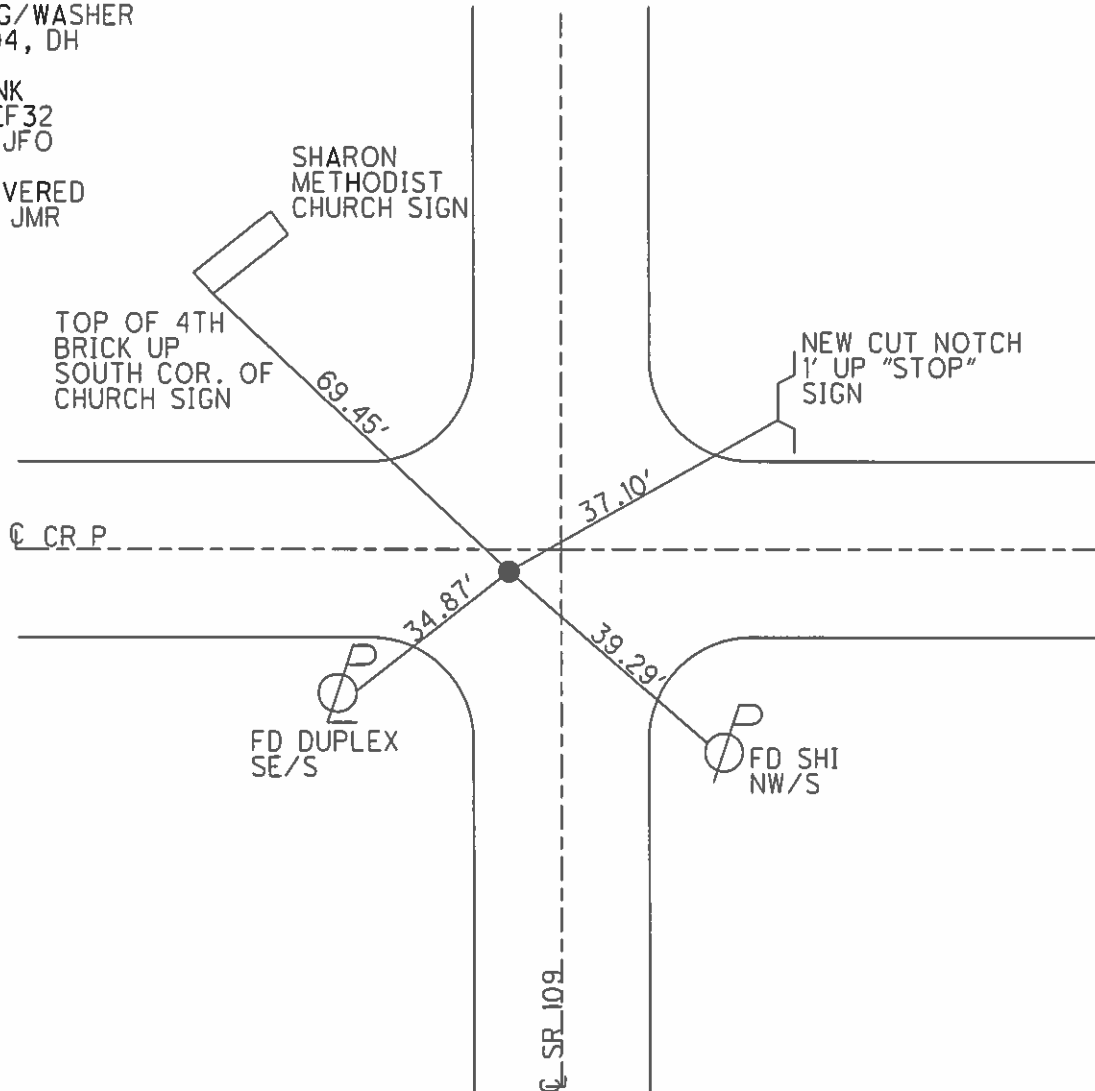

O.D.O.T. DISTRICT 2 SURVEY OFFICE

PERSONNEL

REFERENCE NO. 32

SHEET 20 OF 23


NOTES CORDES
 H.C. BARNHISEL
 R.C. HOOVER

DATE 8/27/04
 WEATHER OVERCAST
 TEMP. + 80°


ROUTE 109
 COUNTY HENRY
 TOWNSHIP HARRISON
 SECTION 23
 T N R 7 E

MC - DRAWING

TYPE MONUMENT P.K. / WASHER
 ON SURFACE - ~~BELOW~~ SURFACE
 LEFT - ~~€ PAV'T.~~ RIGHT 6.0' LT &
TO EDGE PAVEMENT
 S.L.M. 796 + 79

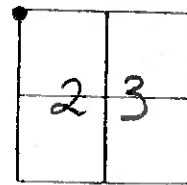

RESET MAG/WASHER
 10-29-04
 D.H.

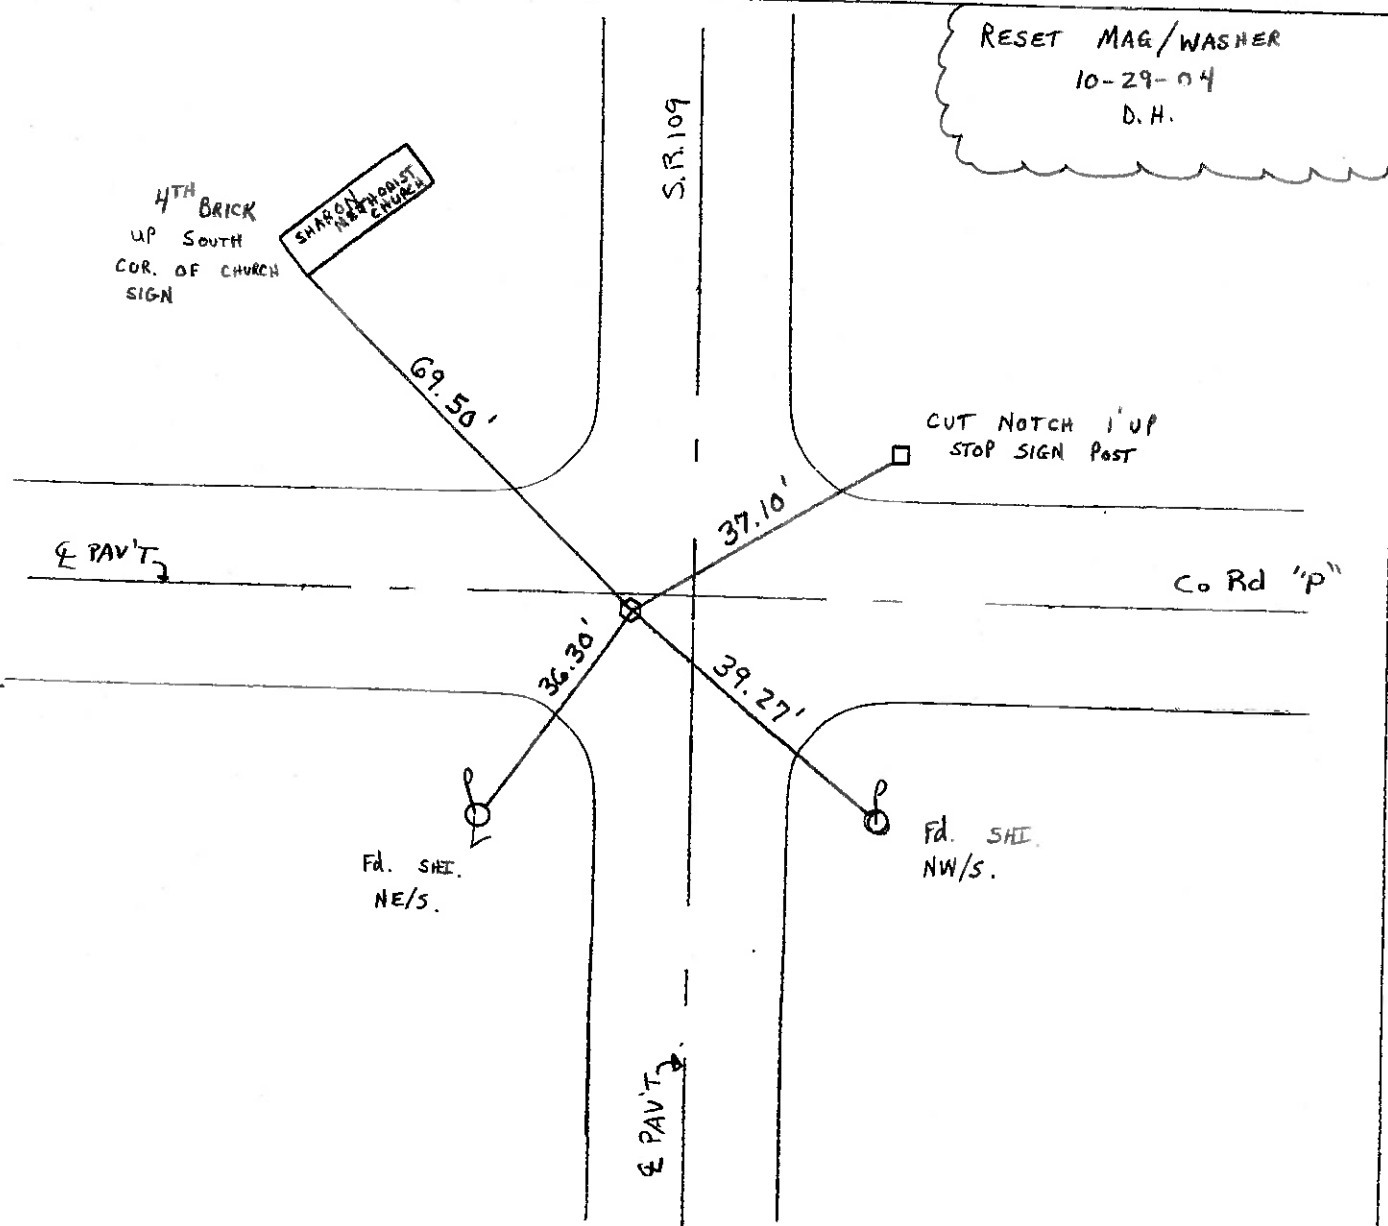

O.D.O.T. DISTRICT 2 SURVEY OFFICE

PERSONNEL _____ REFERENCE NO. 32 SHEET _____ OF _____

NOTES BARNHISEL

H.C. _____ DATE 9-25-90 ROUTE 109

R.C. HOFFMAN WEATHER clear - Windy COUNTY HENRY

_____ TEMP. +70° TOWNSHIP HARRISON

_____ SECTION 23

_____ T. 5 N. R 7. E



TYPE MONUMENT PK NAIL & Washer

ON SURFACE - BELOW YES

LEFT - PAV'T. - RIGHT 5.5

- TO - EDGE PAVEMENT 2.8 S. OF E PAVT Co. Rd "P"

S.L.M. 796 + 79

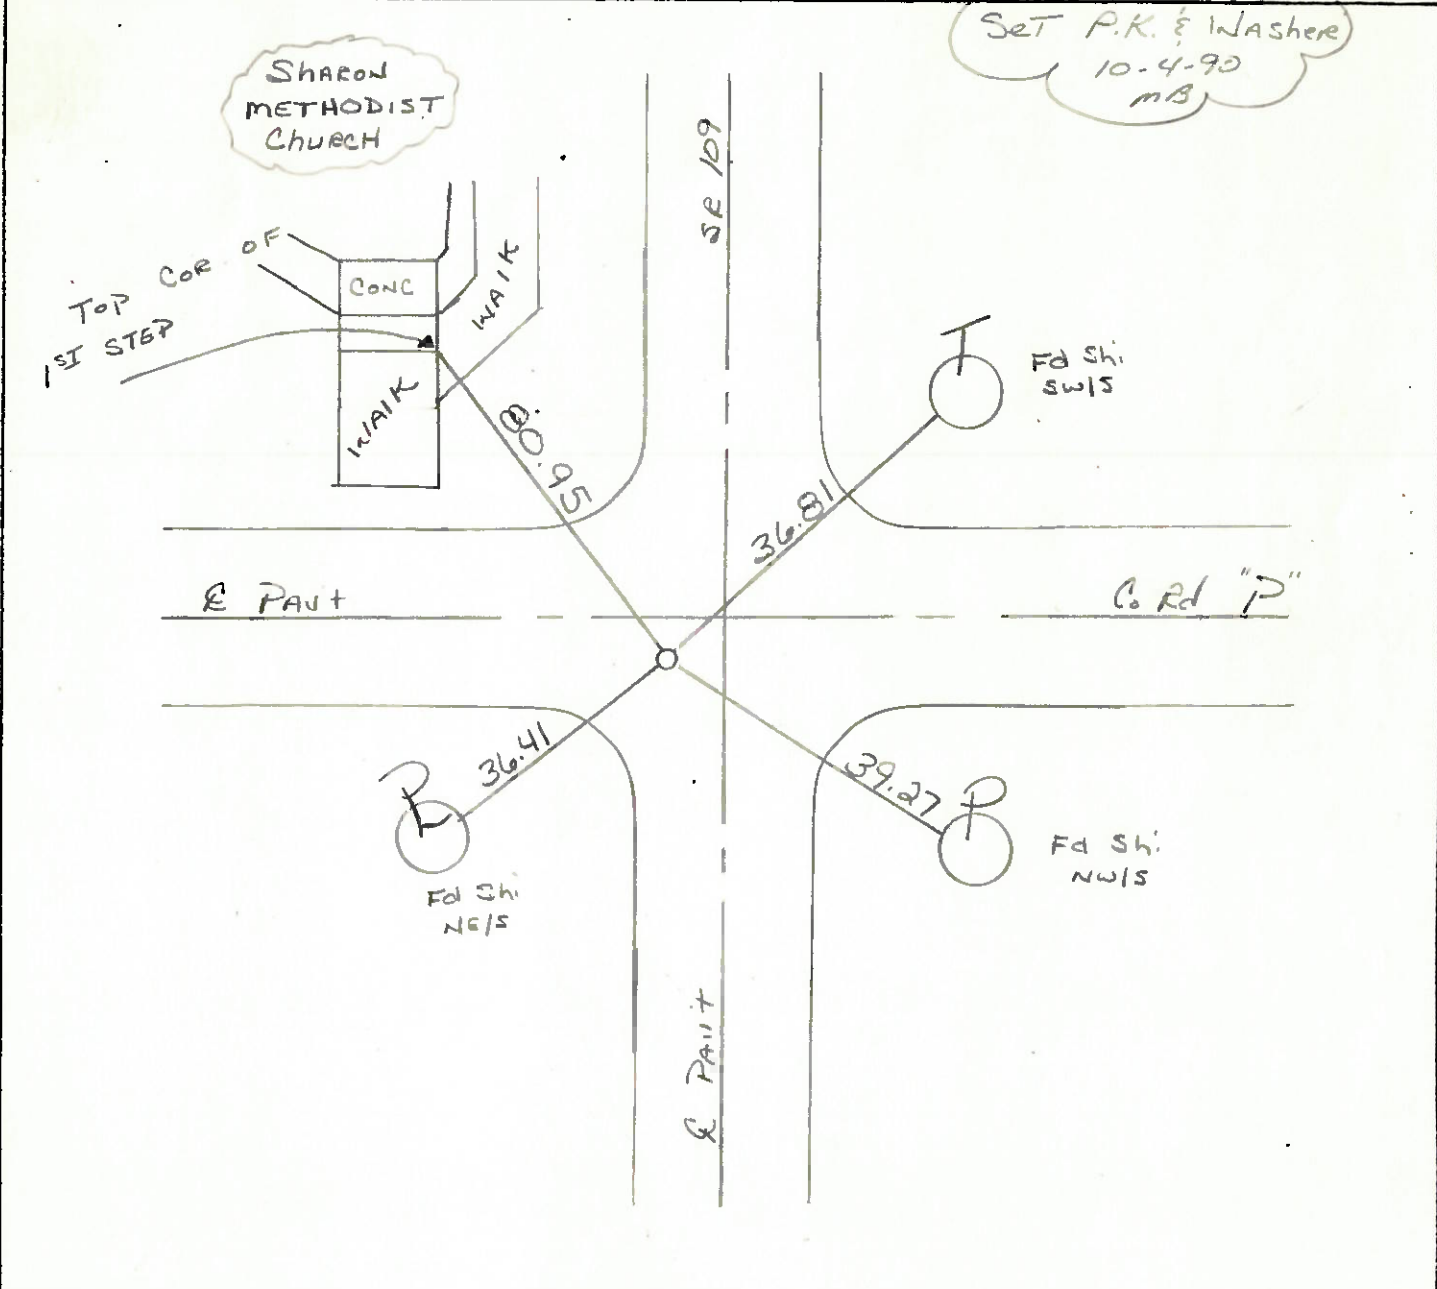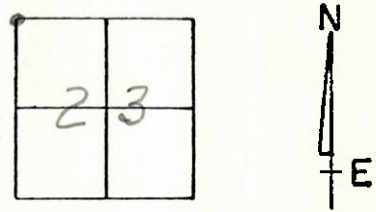

County HENRY S.R. 109

Township HARRISON

Section 23

T5N, R1E

Personnel HOFFMAN

LOSHREE


HOUSEHOLDER R.C.

BRANHISEL H.C.

Date 3-19-84

Weather OVERCAST

Temp. +30°

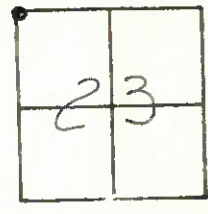

#32

Fd R.R. SPR / CTR PUNCH @ SURFACE

6.0' LT. of & PAUT SR109
2.8' SOUTH of & PAUT Co. Rd. "P"

SLM 796 + 84

SET PK/WASHER
B-23-84
S.W.H.

SHALON.
METHODIST
CHURCH



USE SE/COR STEP
1/2 WAY DOWN

80.96

SR 109

& PAUT

Co. Rd "P"

36.82

Set shi sw/s

39.28

P 36.51

Set shi NE/S

P

Set shi NW/S


& PAUT

SHEET # 7-A

32

23 HARRISON TOWNSHIP

Section 23 Town N. Range E.

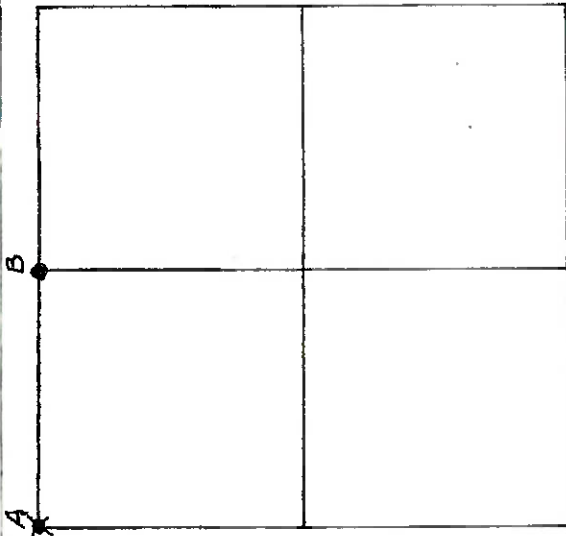

Sept. 1973 Paul Westhoven
 Found stone - placed I. Pin. Top over stone
 69.85 NE to SW cor. Grange Bldg. (Wood cor.)
 76.46 NW to SE cor. 10' Conc. Sidewalk.
 85.97 SW to Spk n. s. S
 5.5' W of E. Pavement
 6.0' N & E to P.K.s in Tave

Sept. 1973 Paul Westhoven & H. Hoiberg
 Found Iron Pipe Survey Vol. 1, Page 579
 Placed Iron Pin inside pipe
 45.00 NE to P.K. S&S S
 28.34 NNE to P.K. S&S S
 24.87 NE to "X" Wdrill Hole on Ctr. Hdwl.
 19.53 SE to "X" Wdrill hole on Ctr. Hdwl.
 2.0' to Nails S & WSW