


O.D.O.T. DISTRICT 2 SURVEY OFFICE (USE ONLY)


PERSONNEL _____ REFERENCE NO. 36 SHEET 26 OF 39
 NOTES RHOADES DATE 8/31/15 ROUTE SR 109
 H.C. O'DONNELL WEATHER FAIR COUNTY HENRY
 R.C. RHOADES TEMP. 76° TOWNSHIP HARRISON
 _____ SECTION 11
 DWG BY RHOADES PID PAVTRAIN T 5 N R 7 E

TYPE MONUMENT MAG NAIL
 ON SURFACE - ~~BELOW~~ ON
 OFFSET C PAVEMENT 1' LT : ~~RT~~
10.4' TO N EDGE PAVEMENT
 STATION: 874+02

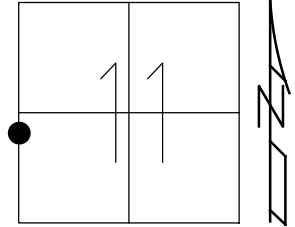

HORZ.DATUM: NAV83 2011 GEOID: NAVD88 2018
 GRID: NORTHING: 637588.512 EASTING: 1546596.837


RECORD: P.I
 STA= 280+41.65
 $\Delta = 0^\circ 30' \text{ RT}$
 $D = 0^\circ 10'$
 $T = 150'$
 $L = 300'$
 $E = 0.38'$
 $R = 34,377.48$
 SET P.K./WASHER
 10-11-90, MB
 FD MAG NAIL
 REF12
 8-3-16, JMR
 FD 3/4" IPIPE
 4" DOWN
 REF36
 6/16/21, TDN

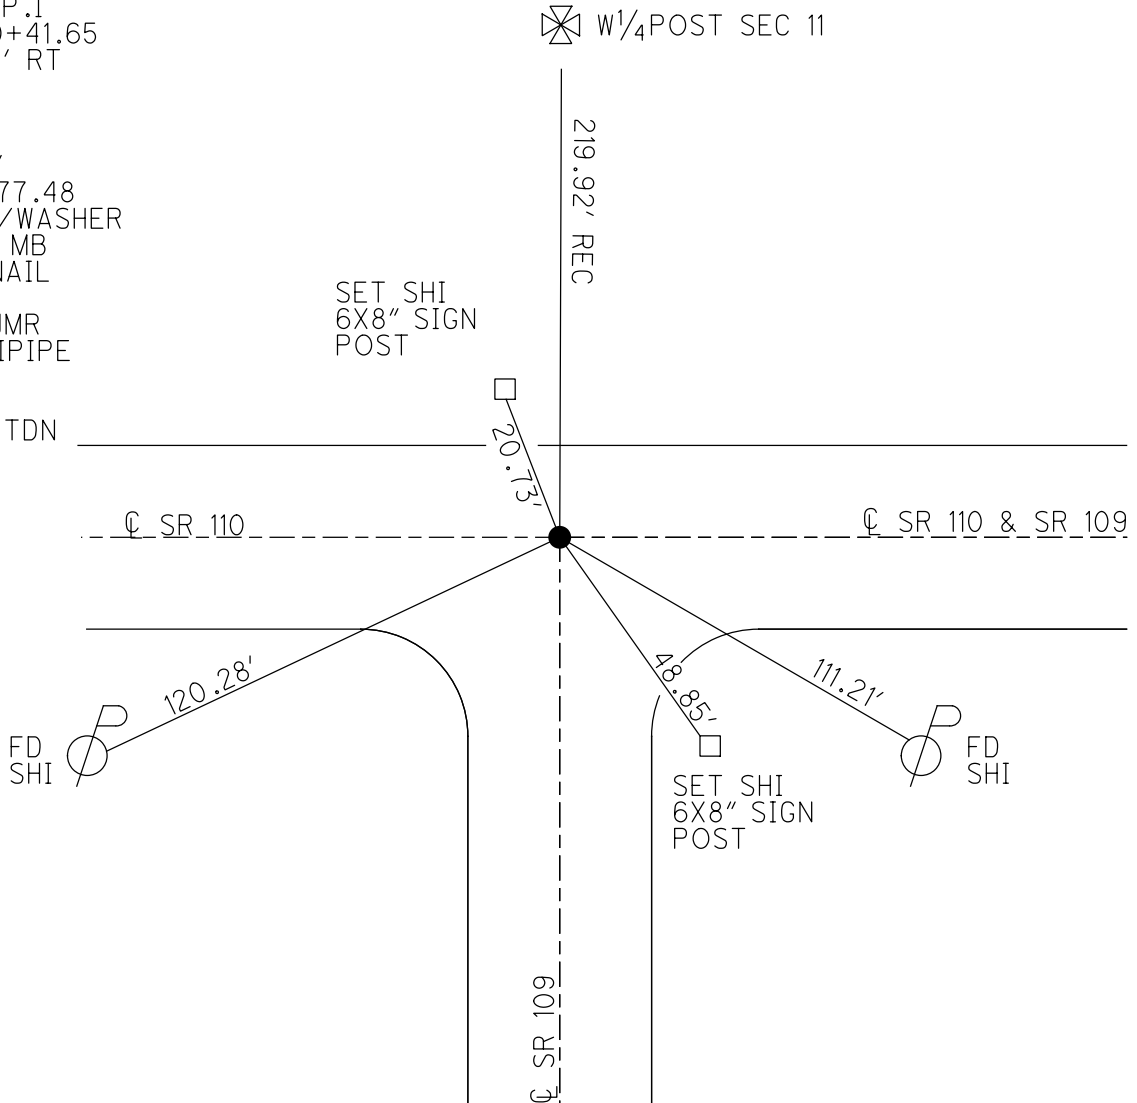

O.D.O.T. DISTRICT 2 SURVEY OFFICE (USE ONLY)

PERSONNEL _____ REFERENCE NO. 36 SHEET 26 OF 38
 NOTES RHOADES DATE 8-31-15 ROUTE SR 109
 H.C. O'DONNELL WEATHER FAIR COUNTY HENRY
 R.C. RHOADES TEMP. 76°F TOWNSHIP HARRISON
 _____ SECTION 11
 _____ T 5 N R 7 E

TYPE MONUMENT MAG NAIL
 ON SURFACE - ~~BELOW~~ ON _____
 LEFT - ☉ PAV'T - ~~RIGHT~~ 1' _____
10.4' TO N EDGE PAVEMENT
 S.L.M. 874+02

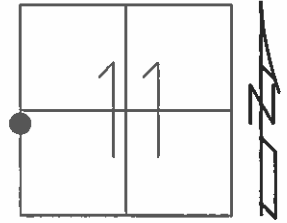

Grid: Northing: 637588.6766 Easting: 1546596.8230


RECORD:
 P.I STA.=280+41.65
 $\Delta=0^{\circ}30'RT$
 $D=0^{\circ}10'$
 $T=150'$
 $L=300'$
 $E=0.38'$
 $R=34,377.48$

SR 109 874+11.8
 1984

SET PK/WASHER
 10-11-90, MB

FD MAG NAIL
 GPS, REF 12

NOT COVERED
 8-3-16, JMR

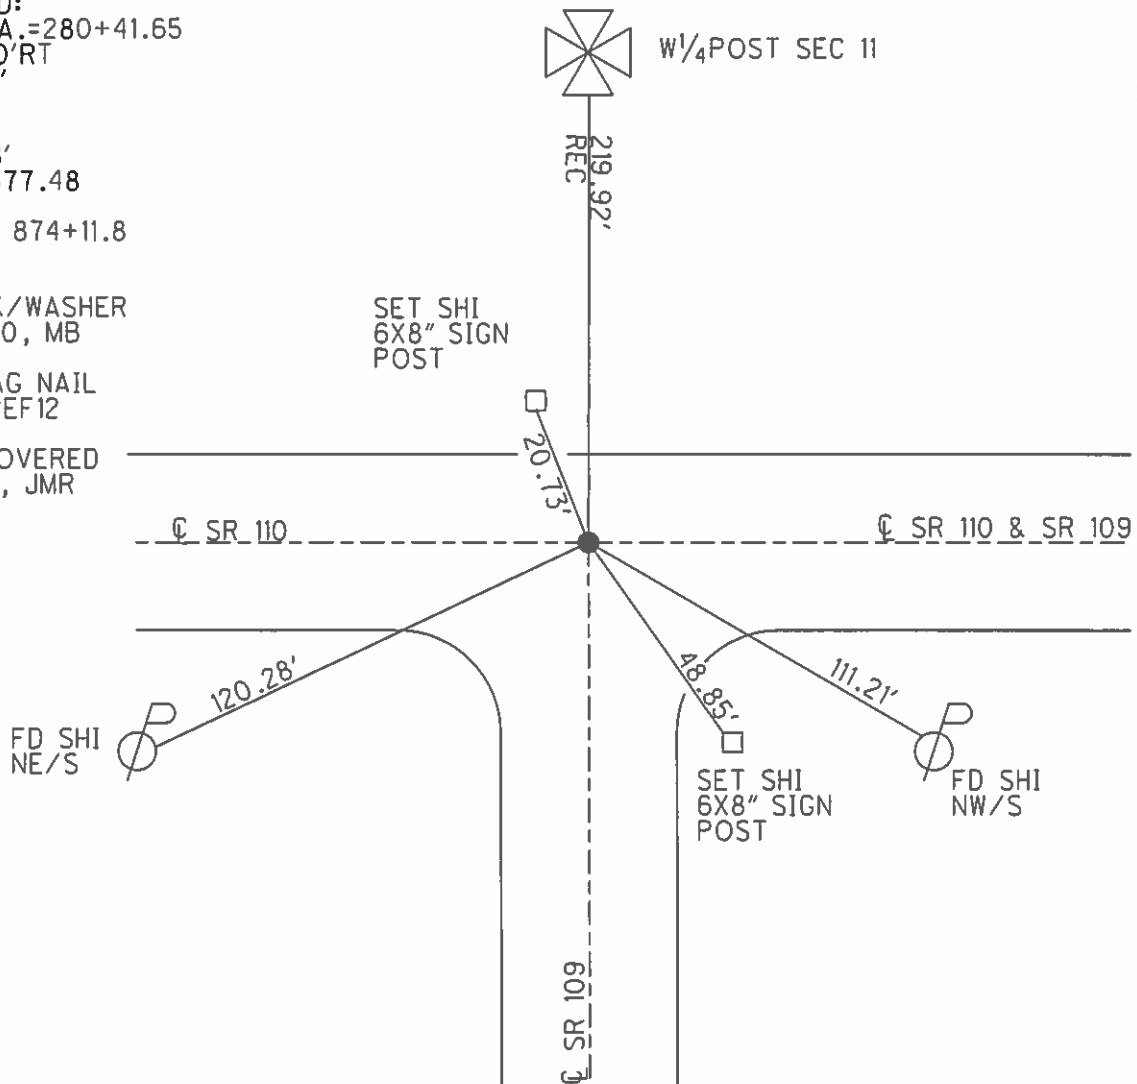

O.D.O.T. DISTRICT 2 SURVEY OFFICE

PERSONNEL _____

REFERENCE NO. 36⁻¹⁰⁹

SHEET _____ OF _____

NOTES HOMAN

H.C. ROUSOS

R.C. BEAUMONT

DATE 8/13/02

WEATHER SUNNY

TEMP. 75°

ROUTE 109 @ 110

COUNTY HENRY

TOWNSHIP HARRISON

SECTION 11

T 5 N R 2 E



TYPE MONUMENT SM. RR. SPK

~~ON SURFACE~~ BELOW 2" BELOW

~~LEFT & PAV'T. - RIGHT~~ BOTH

10.4 TO N EDGE PAVEMENT

S.L.M. SR 109 - 874+02 SR 110 - 275+06

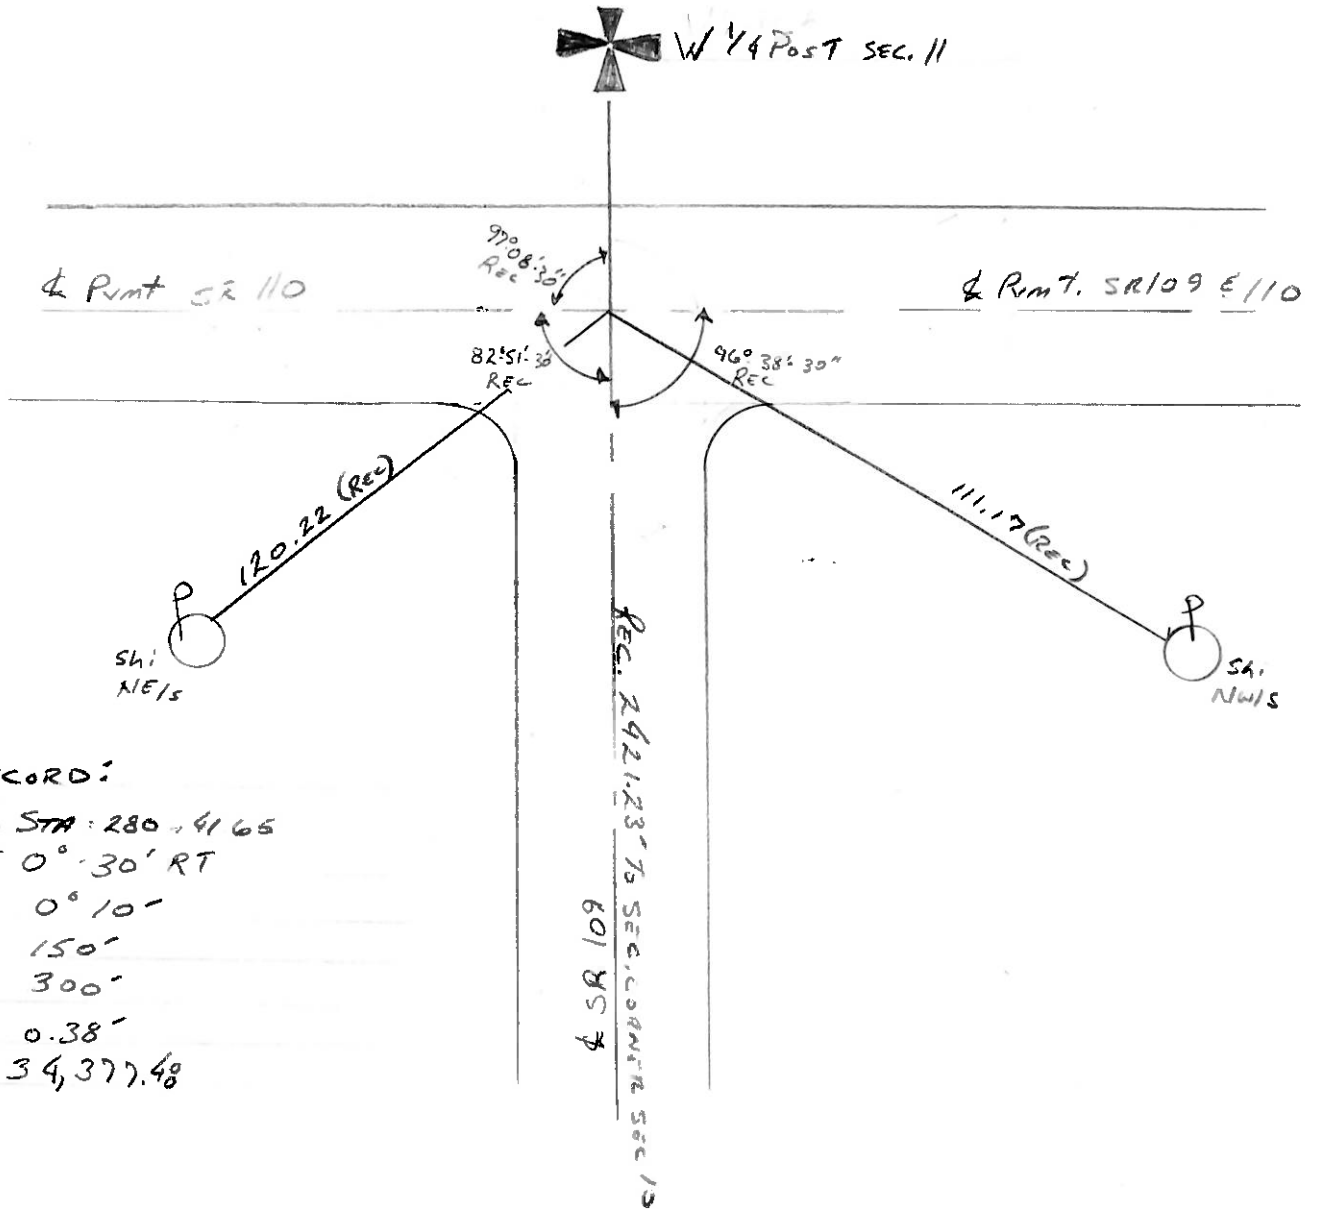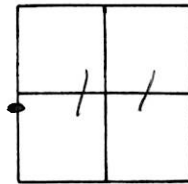

RECORD:
 P.I. STA: 280+41.65
 $\Delta = 0^\circ 30' RT$
 $D = 0^\circ 10'$
 $T = 150'$
 $L = 300'$
 $E = 0.38'$
 $R = 34,377.48'$

O.D.O.T. DISTRICT 2 SURVEY OFFICE

PERSONNEL

REFERENCE NO. 360-107 SHEET 1 OF 9

NOTES BARNHISEL

H.C. " "

R.C. HOFFMAN

DATE 9-28-90

WEATHER clear

TEMP. +65°

ROUTE 109 @ 110 ^{S.R.}

COUNTY HENRY

TOWNSHIP HARRISON

SECTION 11

T 5 N R 7 E



TYPE MONUMENT 5m RR Spk

ON SURFACE - ~~BELOW~~ yes

LEFT- & PAV'T. - RIGHT BOTH

10.4 TO N. EDGE PAVEMENT

S.L.M. SR 109-874+02 SR 110-275+06

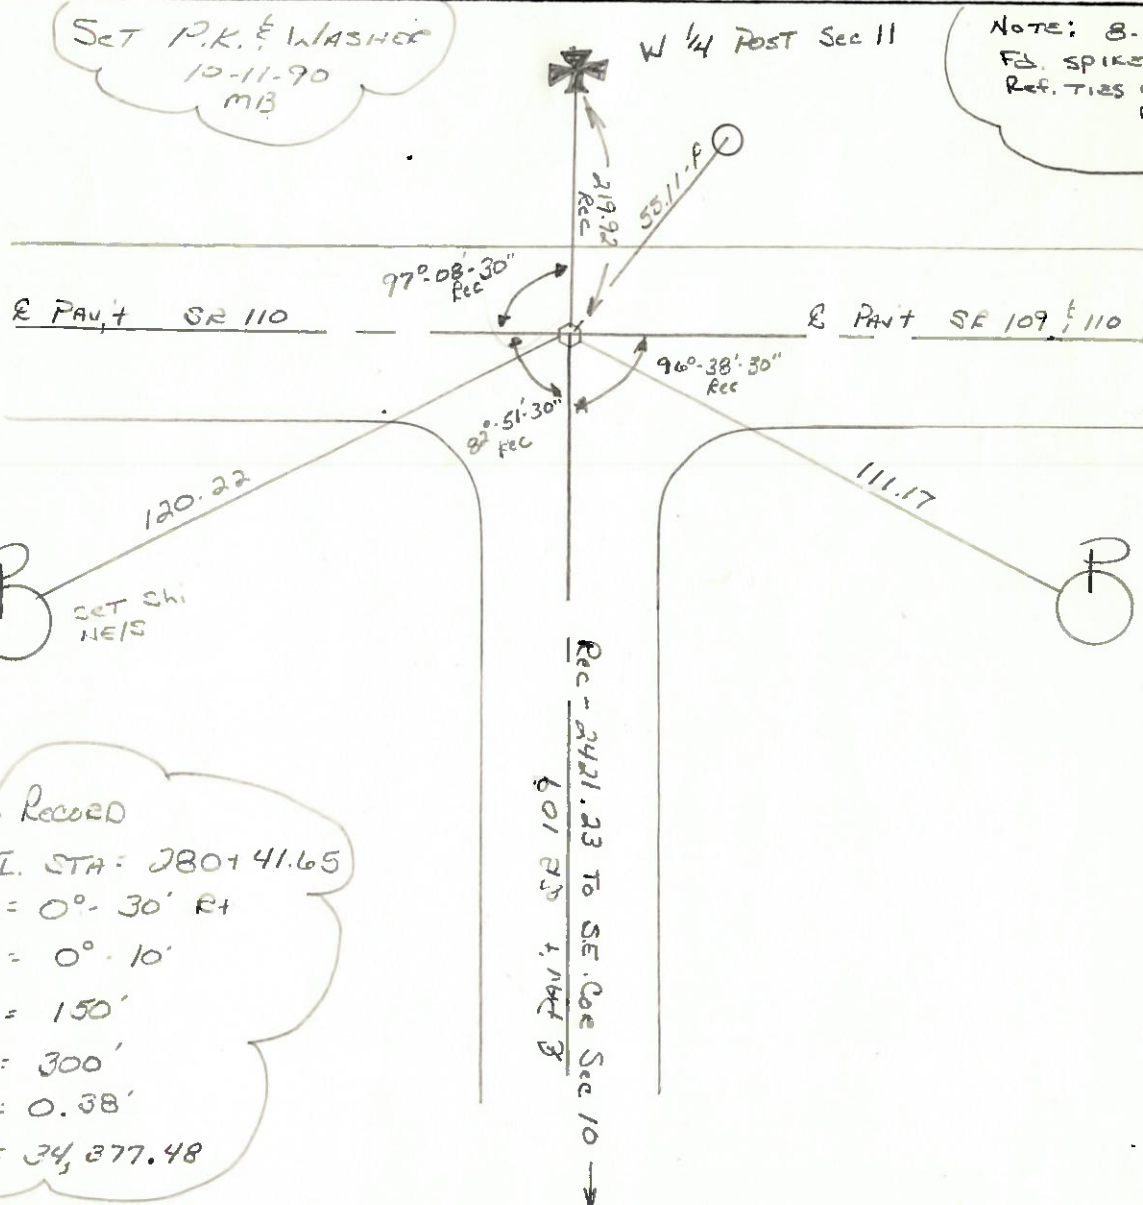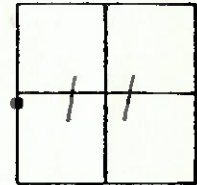

Note: 8-13-02
Fol SPIKE
Ref. TIES check
DH

Record
 P.I. STA = 280141.65
 A = 0°-30' Rt
 D = 0°-10'
 T = 150'
 L = 300'
 E = 0.38'
 R = 34,877.48

Q.D.O.T. DISTRICT 2 SURVEY OFFICE

SHEET _____ OF _____

County HENRY S.R. 109 @ 110

Date 3-19-84

Township HARRISON

Weather OVERCAST

Section 11

Temp. +30°

T5N, R7E


Personnel HOFFMAN

LOEHRKE

HOUSEHOLDER R.C.

BARNHISEL H.C.

#36-109

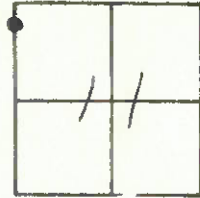

Fd 3/4" I. Pipe 2" below surface
ON & BOTH PAVEMENTS
10.4' TO N.E.P.


SLM SR 110 275 + 18

SLM SR 109 874 + 11.8

SET SMALL RR SPIK

8-23-84

S.W.H.

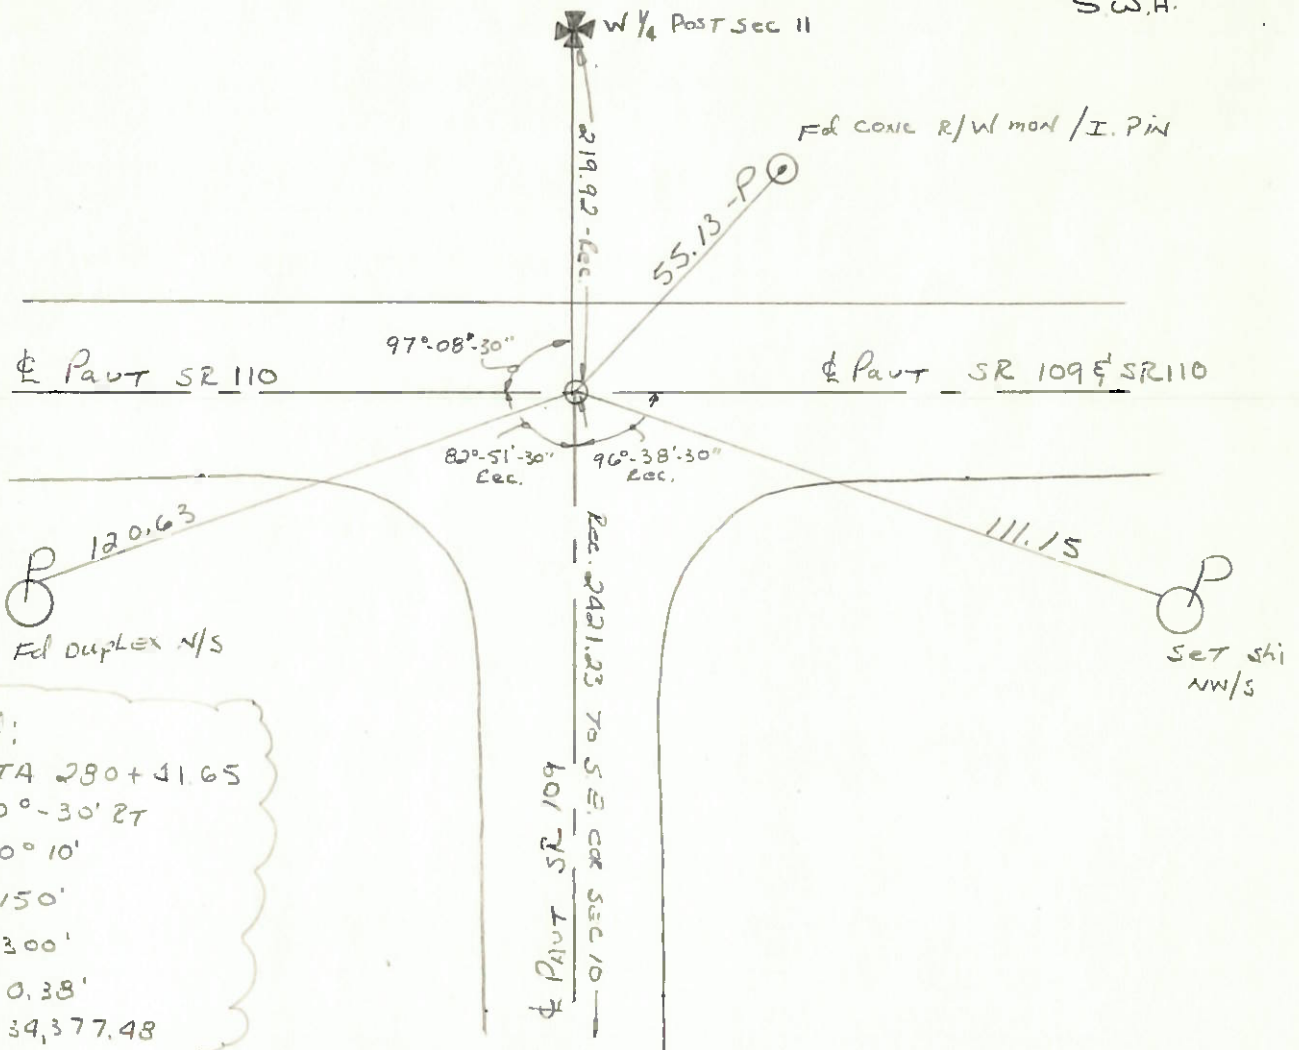

Record:

P.I. STA 280+41.65

$\Delta = 0^\circ - 30' 27''$

$D = 0^\circ 10'$

$T = 150'$

$L = 300'$

$E = 0.38'$

$R = 34,377.48$

PERSONNEL	TITLE	PERSONNEL	TITLE
Tomsic			
Neuser			
Vanya			
Ceranata			

COUNTY HENRY DATE DEC. 14, 1973

S. R. 109 WEATHER _____

SEC. _____ TEMP. 32°

DESCRIPTION _____ LEFT _____ CENTER LINE _____ RIGHT _____ JOB NO. _____

