


O.D.O.T. DISTRICT 2 SURVEY OFFICE (USE ONLY)

PERSONNEL _____ REFERENCE NO. 36 A SHEET 27 OF 36
 NOTES BARNHEISEL DATE 9/28/90 ROUTE SR 109
 H.C. BARNHEISEL WEATHER CLEAR COUNTY HENRY
 R.C. HOFFMAN TEMP. 65° TOWNSHIP HARRISON
 _____ SECTION 11
 DWG BY RHOADES PID PAVETRAIN T 5 N R 7 E


TYPE MONUMENT P.K./WASHER
 ON SURFACE - ~~BELOW~~ ON _____
 OFFSET \odot PAVEMENT ON _____ LT : RT
10.7' TO RT EDGE PAVEMENT
 STATION: 883+78±

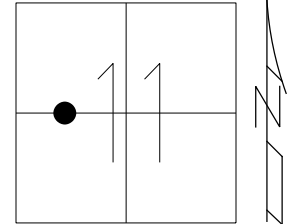

HORZ. DATUM: _____ GEOID: _____
 GRID: NORTHING: _____ EASTING: _____

RECORD: P.O.T.
 FD P.K.NAIL
 SET P.K./WASHER
 10-11-90, MB
 D.N.F.
 TIES CROSS
 8-13-02, DCH
 D.N.F.
 12/20/21, DSA

NOTE: REF 12A SR 110

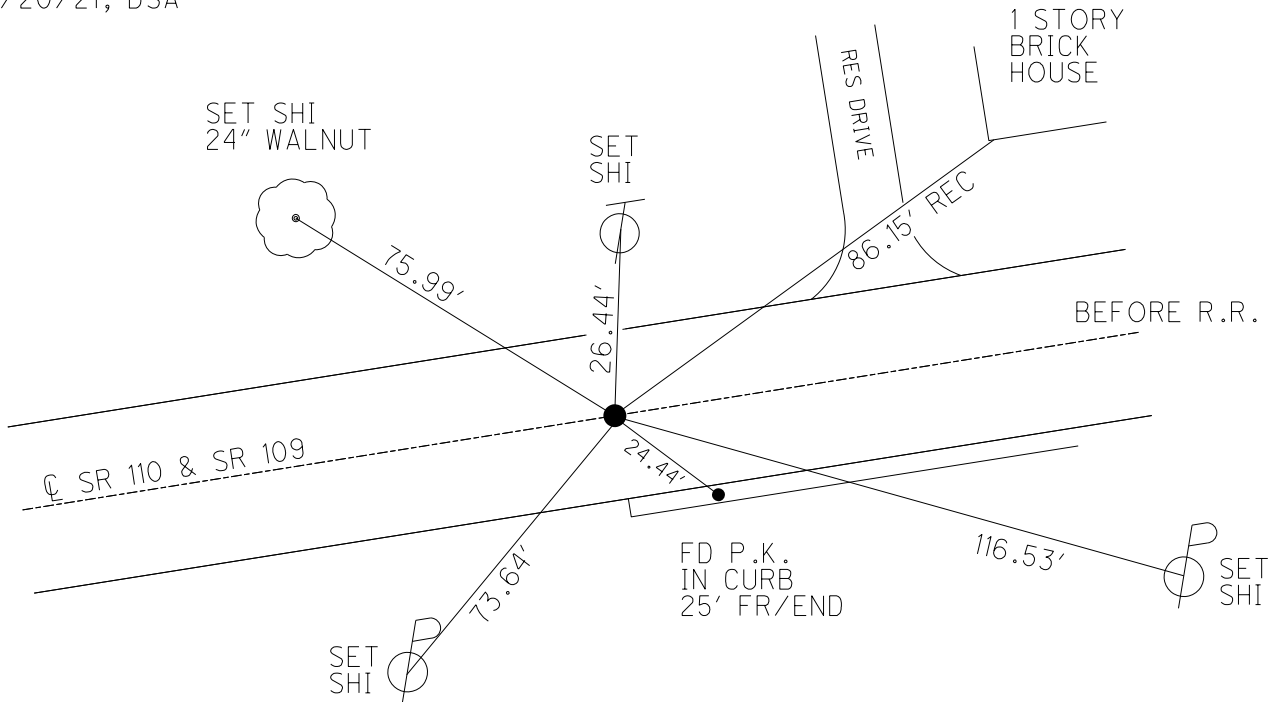

O.D.O.T. DISTRICT 2 SURVEY OFFICE

PERSONNEL _____

REFERENCE NO. _____

SHEET _____ OF _____

NOTES Homan

H.C. Harrison

R.C. Beaumont

DATE 8-13-02

WEATHER Sunny

TEMP. 80°F

ROUTE 109 & 110

COUNTY HENRY

TOWNSHIP HARRISON

SECTION 11

T S N R 7 E


TYPE MONUMENT PK & WASHER

ON SURFACE - ~~BELOW~~ YES

~~LEFT- & PAV'T.~~ - RIGHT YES


TO _____ EDGE PAVEMENT

S.L.M. _____

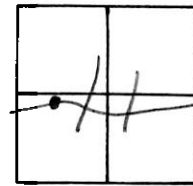

RECORD:
P.O.T.
FWD PK NAIL


10-11-90
SET PK/WASHER
M.B.

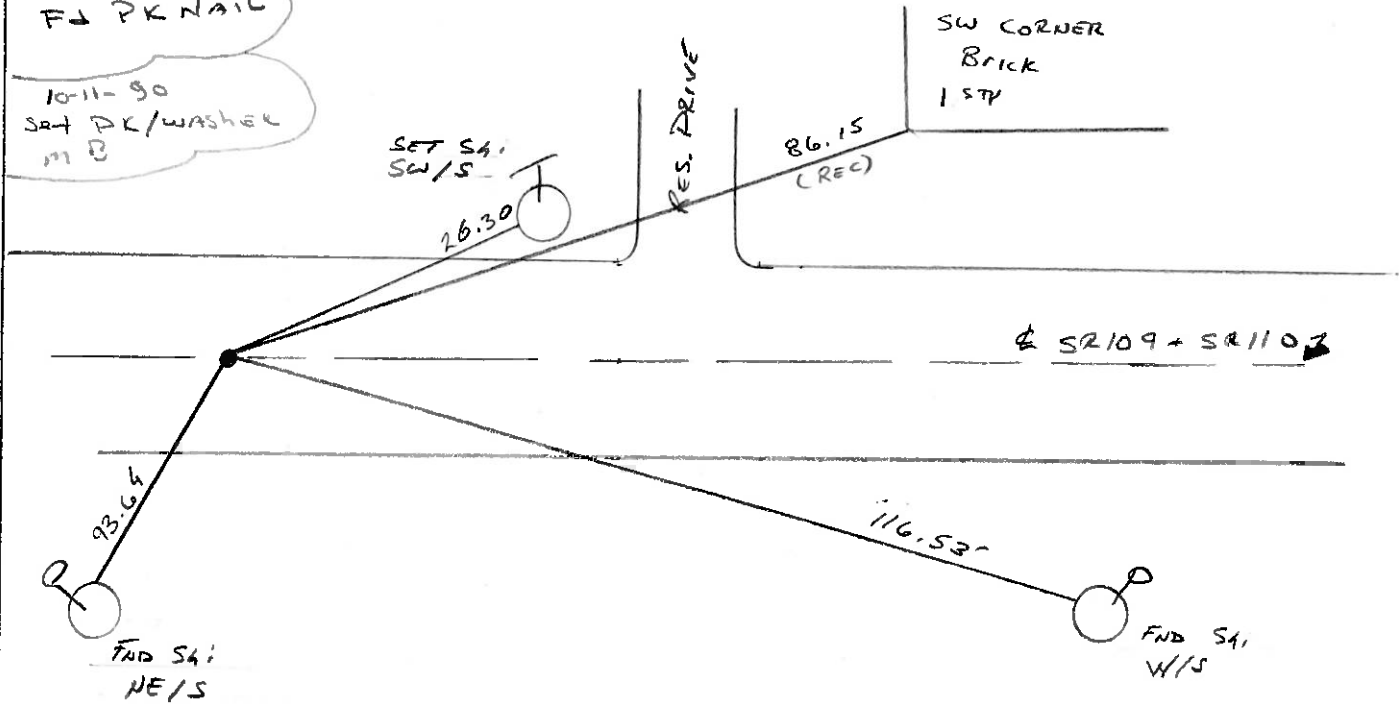

O.D.O.T. DISTRICT 2 SURVEY OFFICE (USE ONLY)

PERSONNEL _____ REFERENCE NO. 36 A SHEET 27 OF 38
 NOTES BARNHISEL DATE 9-28-90 ROUTE SR 109
 H.C. BARNHISEL WEATHER CLEAR COUNTY HENRY
 R.C. HOFFMAN TEMP. 65°F TOWNSHIP HARRISON
 _____ SECTION 11
 _____ T 5 N R 7 E


TYPE MONUMENT PK/WASHER
 ON SURFACE - ~~BELOW~~ ON
 LEFT - ☉ PAV'T - RIGHT ON
10.7' TO RT EDGE PAVEMENT
 S.L.M. 883+78
 Grid: Northing: - _____ Easting: - _____

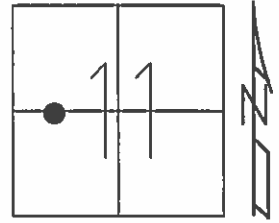

RECORD:
 POT
 FD PK NAIL

NOTE: BEFORE R.R.


SET PK/WASHER
 10-11-90, MB
 REF TIES CROSS
 NO NAIL FD
 8-13-02, DH

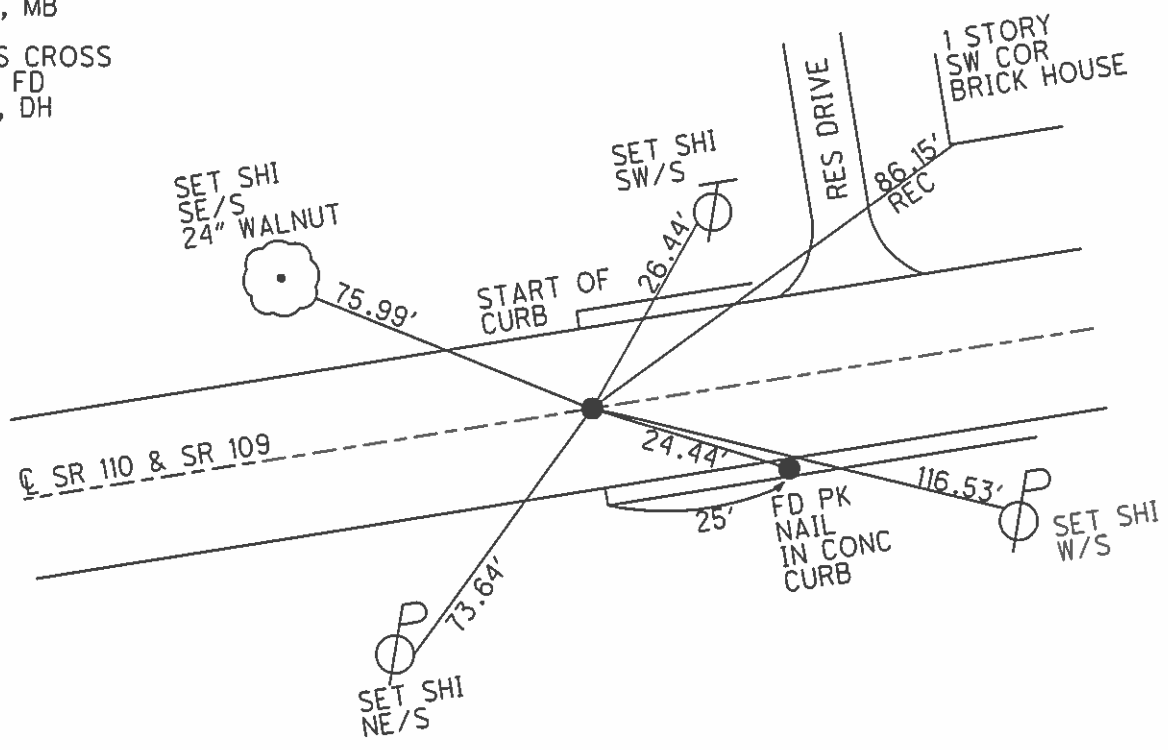

O.D.O.T. DISTRICT 2 SURVEY OFFICE

PERSONNEL _____ REFERENCE NO. 36A SHEET 2 OF 9
 NOTES BARNHISEL
 H.C. _____ DATE 9-28-90 ROUTE 109 & 110
 R.C. HOFFMAN WEATHER Clear COUNTY HENRY
 _____ TEMP. +65° TOWNSHIP HARRISON
 _____ SECTION 11
 _____ T S N R 7 E


TYPE MONUMENT P.K. & Washer
 ON SURFACE - BELOW yes
 LEFT - CL PAV'T. - RIGHT yes
10.7 TO RT EDGE PAVEMENT
 S.L.M. 883+78

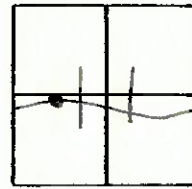

Record: P.O.T.
Fd PK NAIL

Set P.K. & Washer
10-11-90
mB

Note:
Ref. Ties cross
No Nail Fd.
D.H.
8-13-02

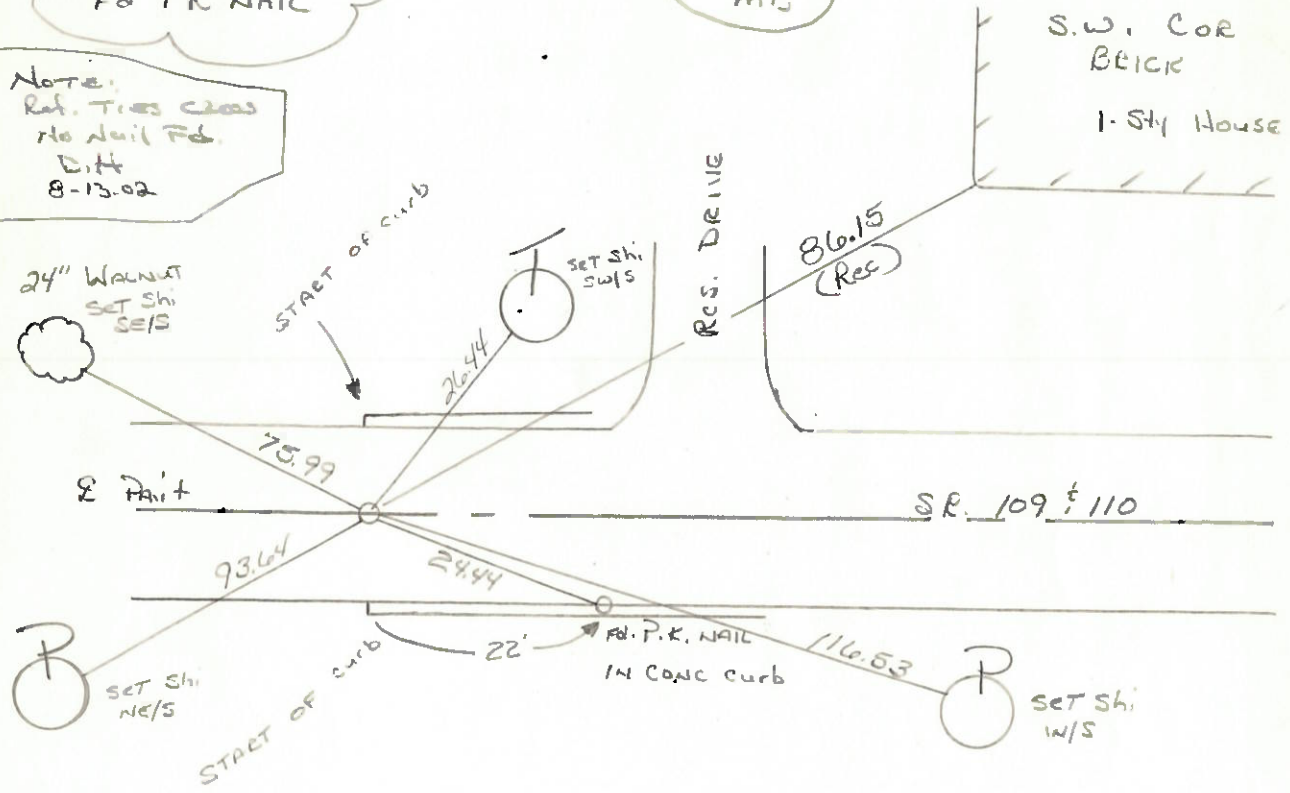

NOTE: BEFORE
THE RR.

Q.D.O.T. DISTRICT 2 SURVEY OFFICE

SHEET _____ OF _____

County HENRY S.R. 109 & SR 110

Date 3-23-84

Township HARRISON

Weather Clear

Section 11

Temp. +25°


TSN, RSE

Personnel HOFFMAN

LOSHRKE

HOUSEHOLDER

BARNHISEL

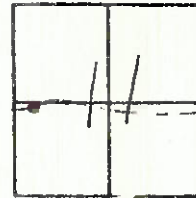

Record: P.O.T.
F&R P.K. Nail

Did not find point

SL 11 993+10

SET PK./WASHE

8-24-84

ON & PAVT

10.3 TO L&EP

10.7 TO R&EP

