

O.D.O.T. DISTRICT 2 SURVEY OFFICE (USE ONLY)

PERSONNEL _____ REFERENCE NO. 38 A SHEET 34 OF 36
 NOTES ASTON DATE 5/25/23 ROUTE SR 109
 H.C. AUBLE WEATHER CLOUDY COUNTY HENRY
 R.C. MILLER TEMP. 55° TOWNSHIP HARRISON
 SECTION 12
 DWG BY RHOADES PID PAVTRAIN T 5 N R 7 E

TYPE MONUMENT MAG/WASHER

ON SURFACE - ~~BELOW~~ ON


OFFSET \odot PAVEMENT 5.9' LT : ~~RT~~

4' TO LT EDGE PAVEMENT

STATION: 938+41


HORZ. DATUM: NAD83 2011 GEOID: NAVD88 2018

GRID: NORTHING: 637242.092 EASTING: 1553012.281

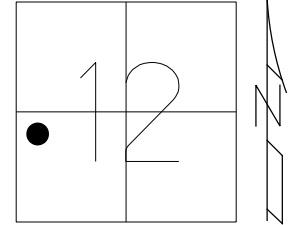

RECORD: P.I.
 $\Delta = 5^\circ 11' 00''$ RT
 FD P.K./WASHER
 8/13/02
 SET MAG/WASHER
 9-20-02, DCH
 FD MAG/WASHER
 REFA38
 6/17/21, TDN
 10/5/21, JFO
 FD MAG/WASHER
 REF14
 12/20/23, DSA

NOTE: REF 14AB SR 110

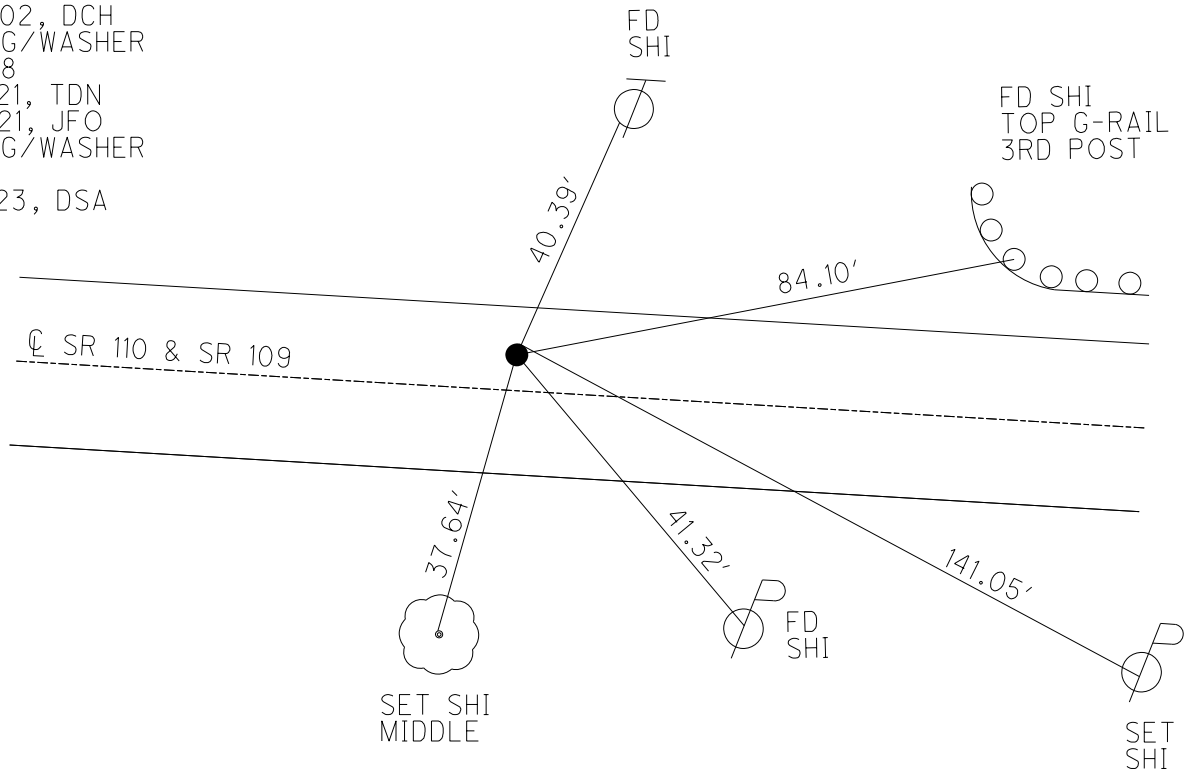

O.D.O.T. DISTRICT 2 SURVEY OFFICE (USE ONLY)

PERSONNEL

REFERENCE NO. 38 A

SHEET 35 OF 39

NOTES HOMAN DATE 8/13/02

H.C. ROUSOS WEATHER CLOUDY

R.C. BEAUMONT TEMP. 80°

ROUTE SR 109

COUNTY HENRY

TOWNSHIP HARRISON

SECTION 12

T 5 N R 7 E

DWG BY RHOADES PID PAVTRAIN

TYPE MONUMENT P.K./WASHER

ON SURFACE - BELOW ON

OFFSET \odot PAVEMENT 5.9' LT : RT

4' TO LT EDGE PAVEMENT


STATION: 938+41

HORZ. DATUM: NAD83 2011


GEOID: NAVD88 2018

GRID: NORTHING: 637242.092

EASTING: 1553012.281

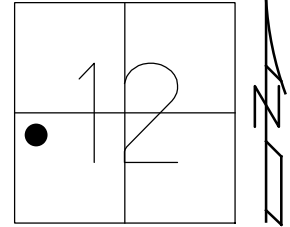


RECORD: P.I.
 $\Delta = 5^\circ 11' 00''$ RT
 FD P.K./WASHER
 8/13/02
 SET MAG/WASHER
 9-20-02, DCH
 FD MAG/WASHER
 REFA38
 6/17/21, TDN
 10/5/21, JFO

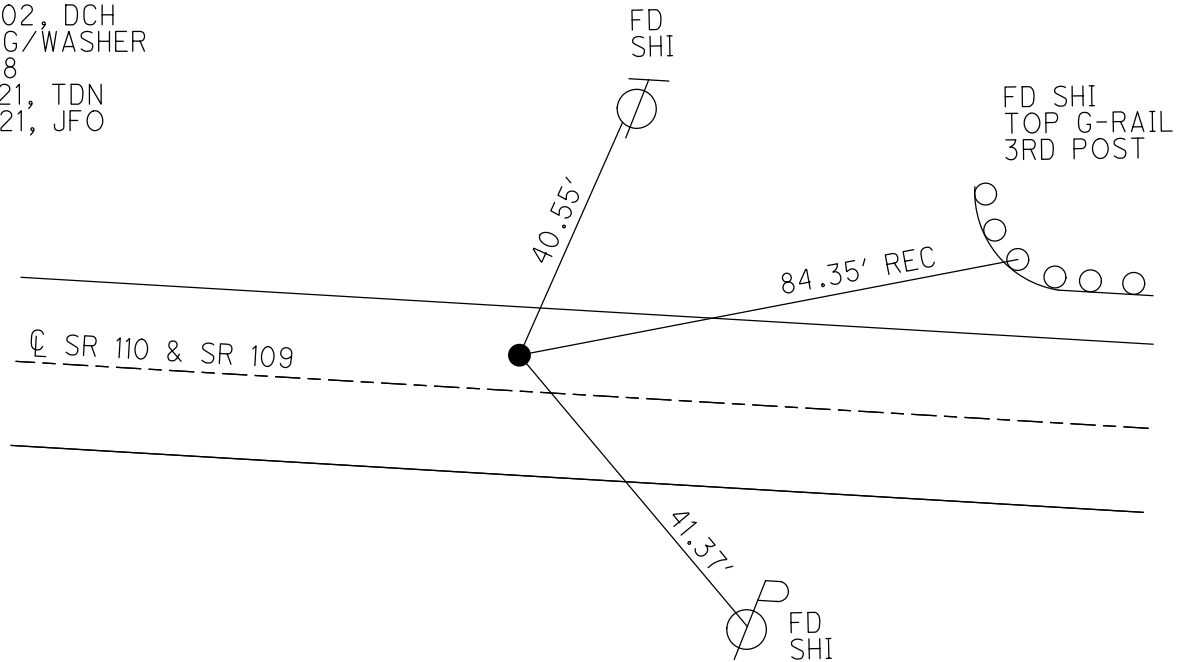

O.D.O.T. DISTRICT 2 SURVEY OFFICE (USE ONLY)

PERSONNEL _____ REFERENCE NO. 38 A SHEET 35 OF 38
 NOTES HOMAN DATE 8-13-02 ROUTE SR 109
 H.C. ROUSOS WEATHER CLOUDY COUNTY HENRY
 R.C. BEAUMONT TEMP. 80°F TOWNSHIP HARRISON
 _____ SECTION 12
 _____ T 5 N R 7 E


TYPE MONUMENT PK/WASHER
 ON SURFACE - ~~BELOW~~ ON _____
 LEFT - ☉ PAV'T - ~~RIGHT~~ 5.9'
4' TO LT EDGE PAVEMENT
 S.L.M. 938+41

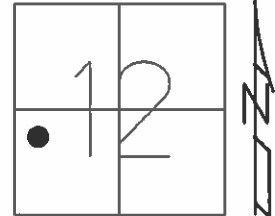

Grid: Northing: - _____ Easting: - _____

RECORD: P.I.
 $\Delta=5^{\circ}11'00''RT$

SET MAG/WASHER
 9-20-02, DCH

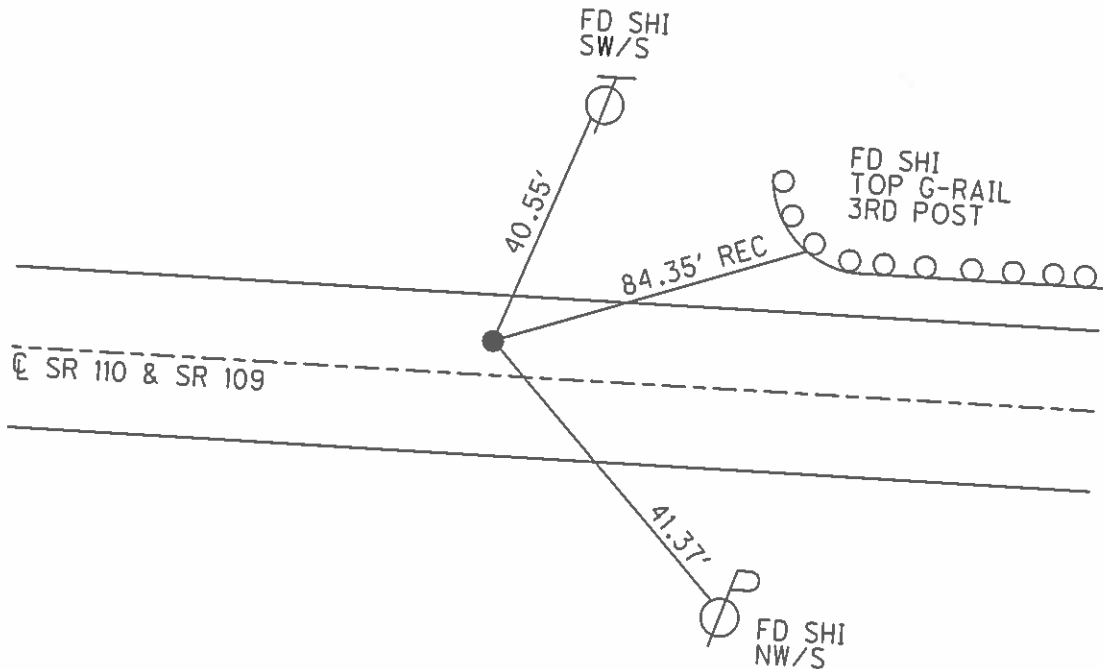

O.D.O.T. DISTRICT 2 SURVEY OFFICE

PERSONNEL

REFERENCE NO. 38A

SHEET 7 OF 9

NOTES HOMAN

DATE 8-13-02

ROUTE S.R. 109

H.C. ROUSOS

WEATHER CLOUDY

COUNTY HENRY

R.C. BEAUMONT

TEMP. 80

TOWNSHIP HARRISON

SECTION 12

T 5 N R 7 E


TYPE MONUMENT PK & WASHER

ON SURFACE - ~~BELOW~~ ON

LEFT - ~~Q PAVT~~ - ~~RIGHT~~ 5.9'

4' TO LT EDGE PAVEMENT

S.L.M. 938+41

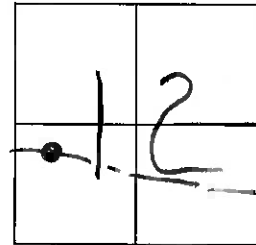

RECORD P.I.


$\Delta = 5^\circ 11' \text{ ~~00'~~ RT}$

SET MAG NAIL

& WASHER

9-20-02

DCH

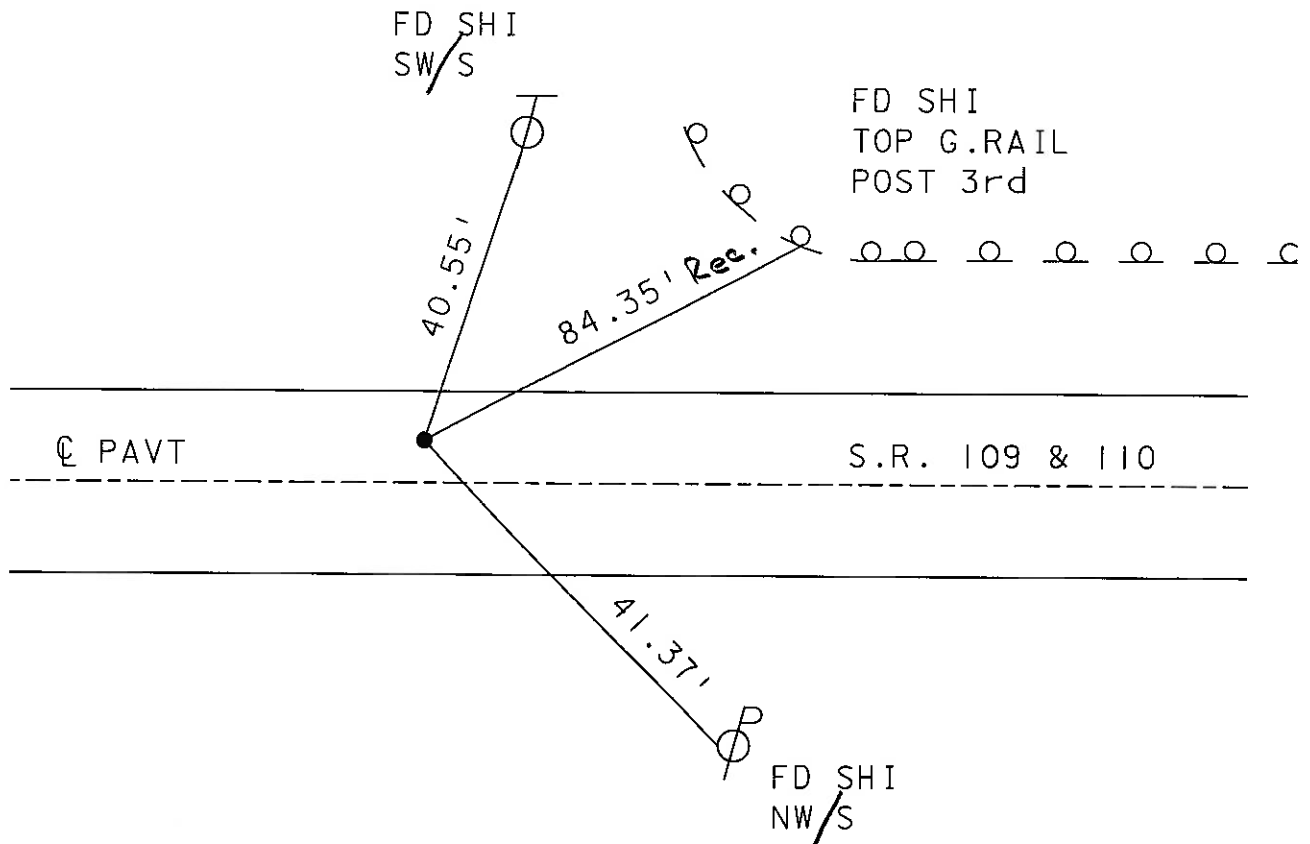

O.D.O.T. DISTRICT 2 SURVEY OFFICE

PERSONNEL _____ REFERENCE NO. _____ SHEET _____ OF _____

NOTES BARNHISEL

H.C. _____

R.C. HOFFMAN

DATE 9-28-90

WEATHER Clear

TEMP. +65°

ROUTE 109 & 110

COUNTY HENRY

TOWNSHIP HARRISON

SECTION 12

T 5 N R 7 E

TYPE MONUMENT P.K. & WASHER

ON SURFACE - BELOW yes

LEFT- & PAV'T. - RIGHT 5.9


3.6 TO LT EDGE PAVEMENT

S.L.M. 938 + 41



RECORDED: P.I.
Δ = 50-11' Rt

Set P.K. & Washer
10-11-90
MB

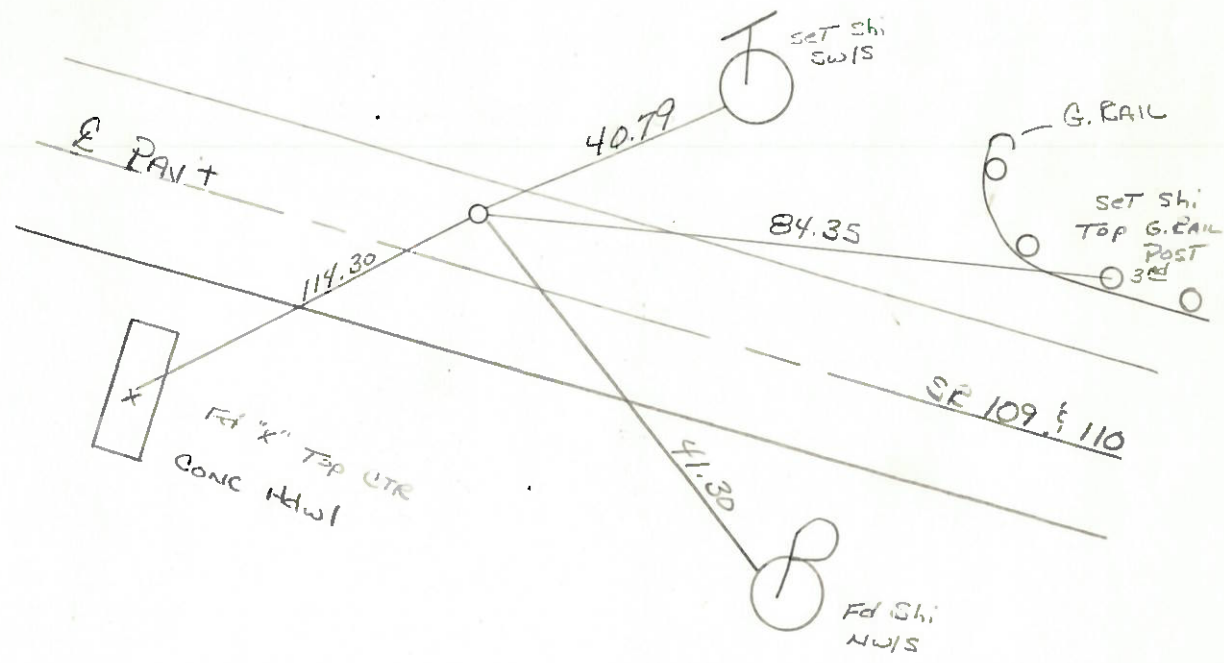

ODOT DISTRICT 2 SURVEY OFFICE

SHEET _____ OF _____

County HENRY S.R. 109^E SR 110

Date 3-23-84

Township HARRISON

Weather Clear

Section 12

Temp. +25°


T5N, R7E

Personnel HOFFMAN

LOEHRKE

HOUSEHOLDER

BARNHISEL

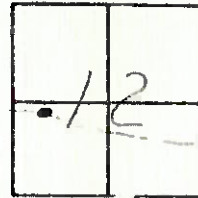

Fd P.K. Nail 1 1/2" Below surface

5.8' LT. of & PAUT

3.0' TO LT. EP

14.9' TO RT. EP

S.I.M. 938 + 57

Recor'd: P.T.
Δ = 5° - 11' RT.

SET PK/WASHER

8-24-84

S.W.H.

