

O.D.O.T. DISTRICT 2 SURVEY OFFICE (USE ONLY)

PERSONNEL _____ REFERENCE NO. 39 A SHEET 8 OF 11
 NOTES NIESE DATE 3/16/23 ROUTE SR 109
 H.C. NIESE WEATHER CLEAR COUNTY HENRY
 R.C. MILLER TEMP. 47° TOWNSHIP HARRISON
 DWG BY RHOADES PID CHIP SEAL SECTION 12
 T 5 N R 7 E

TYPE MONUMENT MAG/WASHER

ON SURFACE - ~~BELOW~~ ON _____

OFFSET \varnothing PAVEMENT 6' LT : ~~RT~~

6.5' TO LT EDGE PAVEMENT



STATION: 985+64.59

HORZ. DATUM: NAD83 2011

GEOID: NAVD88 2012A

GRID: NORTHING: 639594.934

EASTING: 1554490.938

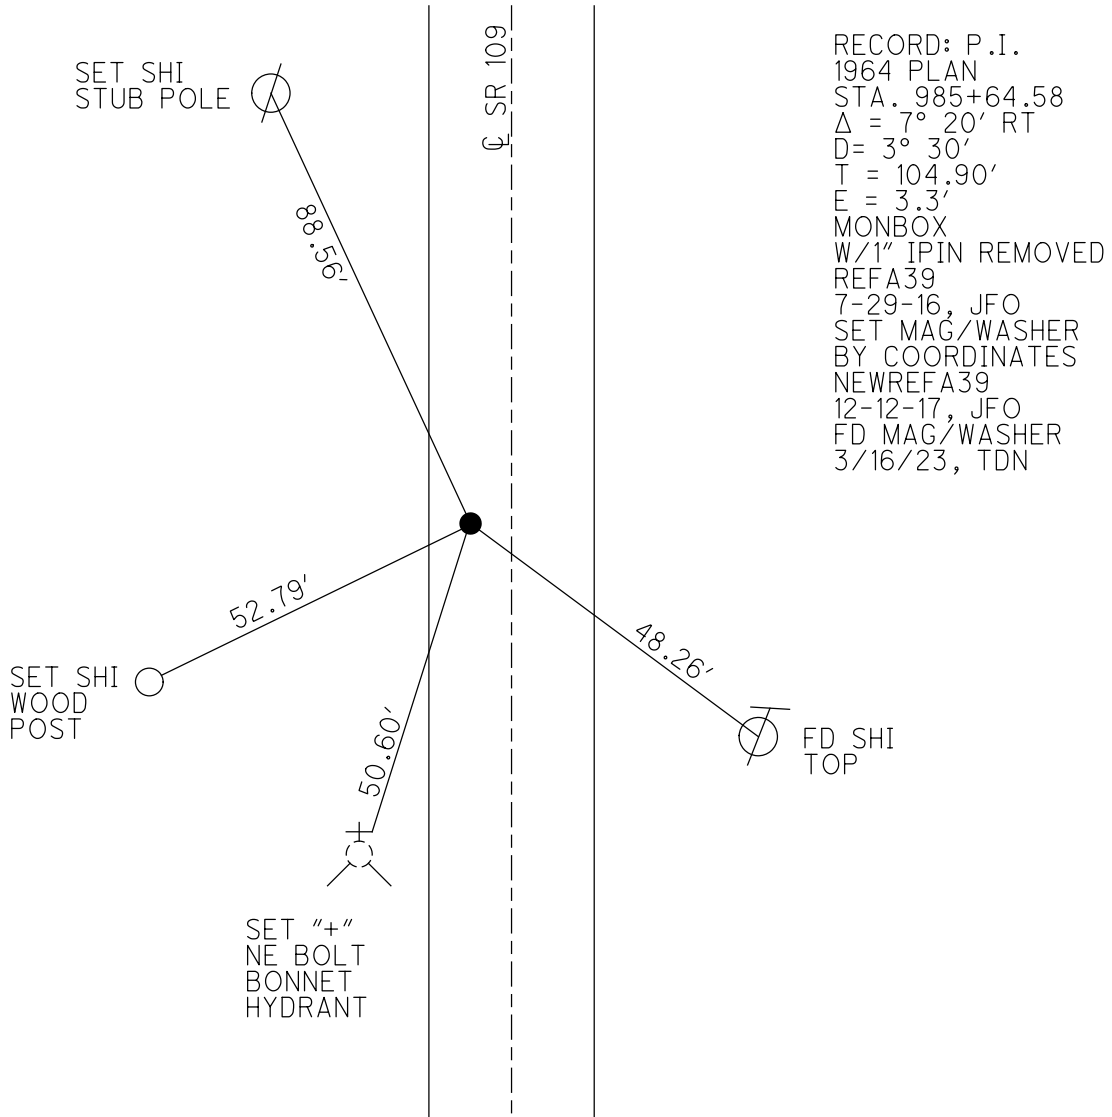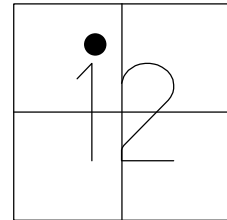



RECORD: P.I.
 1964 PLAN
 STA. 985+64.58
 $\Delta = 7^\circ 20' RT$
 $D = 3^\circ 30'$
 $T = 104.90'$
 $E = 3.3'$
 MONBOX
 W/1" IPIN REMOVED
 REFA39
 7-29-16, JFO
 SET MAG/WASHER
 BY COORDINATES
 NEWREFA39
 12-12-17, JFO
 FD MAG/WASHER
 3/16/23, TDN

O.D.O.T. DISTRICT 2 SURVEY OFFICE (USE ONLY)

PERSONNEL _____ REFERENCE NO. 39 A SHEET 8 OF 8
 NOTES O'DONNELL DATE 12/12/17 ROUTE SR 109
 H.C. O'DONNELL WEATHER SNOW COUNTY HENRY
 R.C. FARKAS TEMP. 22° TOWNSHIP HARRISON
 _____ SECTION 12
 DWG BY RHOADES PID 90991 T 5 N R 7 E

TYPE MONUMENT MAG/WASHER
 ON SURFACE - ~~BELOW~~ ON
 OFFSET CL PAVEMENT 6' LT : ~~RT~~
7' TO LT EDGE PAVEMENT
 STATION: 985+64.59

HORZ.DATUM: NAD83 2011 GEOID: NAVD88 2012A
 GRID: NORTHING: 639594.934 EASTING: 1554490.938

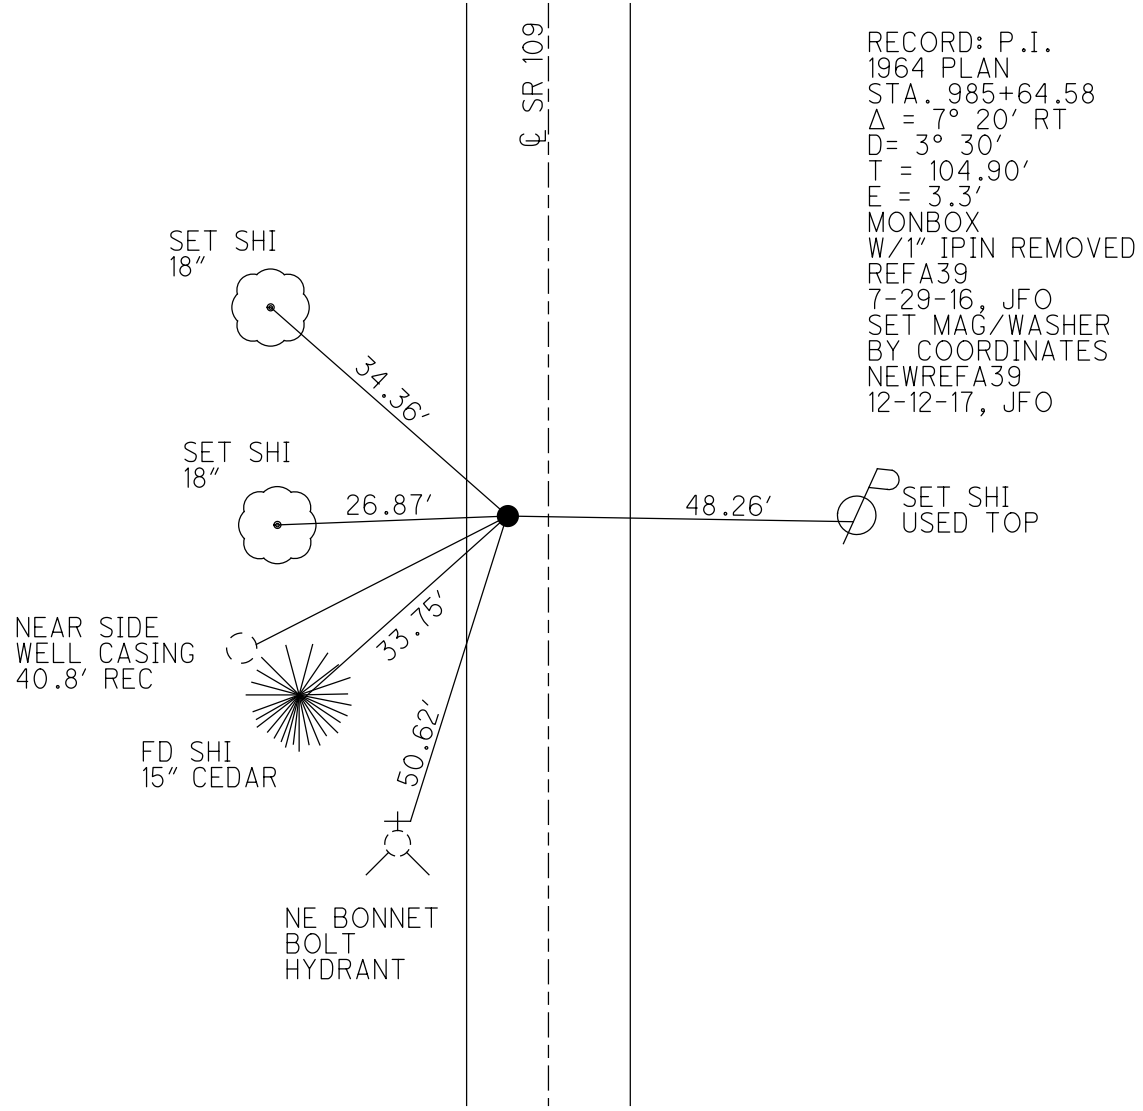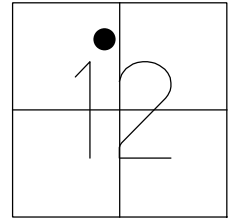

RECORD: P.I.
 1964 PLAN
 STA. 985+64.58
 $\Delta = 7^\circ 20' RT$
 $D = 3^\circ 30'$
 $T = 104.90'$
 $E = 3.3'$
 MONBOX
 W/1" IPIN REMOVED
 REFA39
 7-29-16, JFO
 SET MAG/WASHER
 BY COORDINATES
 NEWREFA39
 12-12-17, JFO

O.D.O.T. DISTRICT 2 SURVEY OFFICE

PERSONNEL

REFERENCE NO. 39A

SHEET 1 OF 27

NOTES HOMAN

DATE 7-19-02

ROUTE S.R. 109

H.C. ROUSOS

WEATHER CLOUDY

COUNTY HENRY

R.C. HOMAN

TEMP. 88

TOWNSHIP LIBERTY

SECTION 12

T 5 N R 7 E


TYPE MONUMENT MON BOX FD DID NOT OPEN

ON SURFACE - ~~BELOW~~ ON

LEFT - ~~Q PAVT~~ - ~~RIGHT~~ 4.3'


7' TO LT EDGE PAVEMENT

S.L.M. 985+39

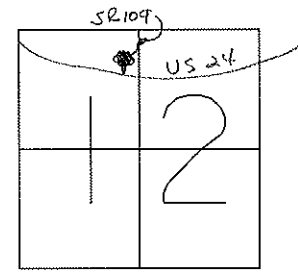

1964 PLAN
 P.I. 985+64.58
 $\Delta = 7^\circ 20'$ RT
 $D = 3^\circ 30'$
 $T = 104.90'$
 $E = 3.3'$

NEAR SIDE
 WELL CASING

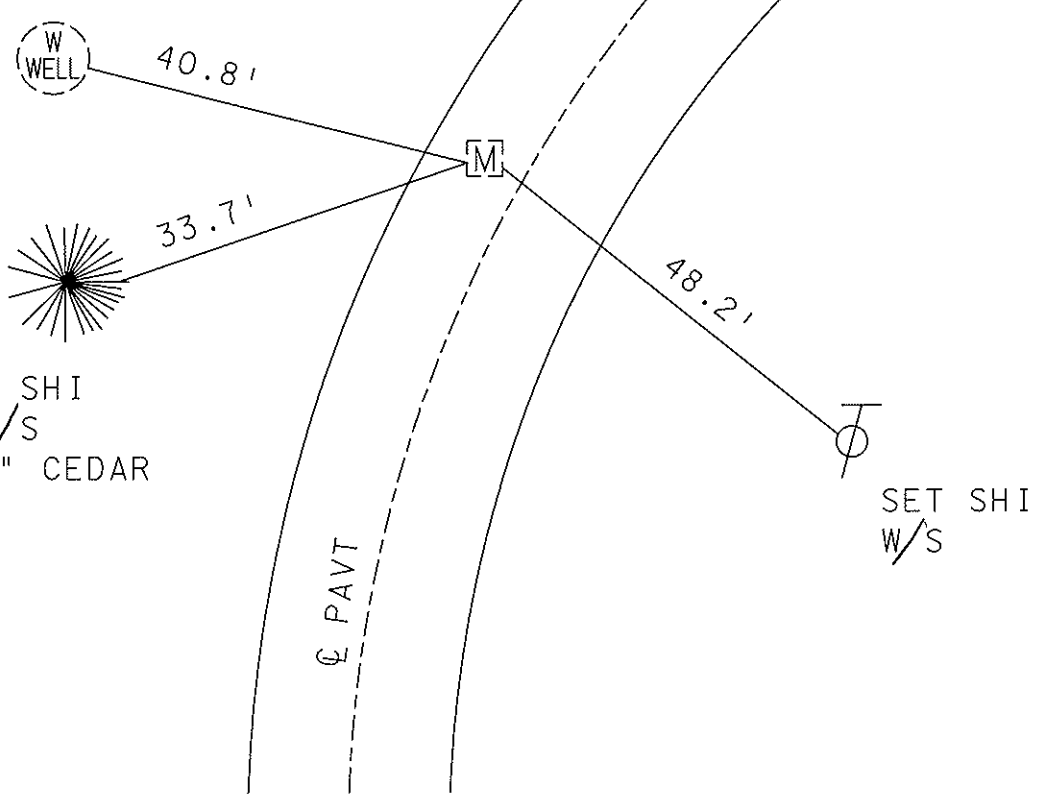

MILLED & Resurfaced 2002

O.D.O.T. DISTRICT 2 SURVEY OFFICE

PERSONNEL _____

REFERENCE NO. _____

SHEET _____ OF _____

NOTES HOFFMAN

H.C. BARNHISEL

R.C. LOENRKE

DATE 1-9-87

WEATHER OVERCAST

TEMP. 30°

ROUTE SR 109

COUNTY HENRY

TOWNSHIP LIBERTY

SECTION 12

T 5 N R 7 E


TYPE MONUMENT MONUMENT BOX

~~ON SURFACE~~ - BELOW 2"

LEFT - ~~C~~ PAV'T. - RIGHT 4.3'

7.0' TO Lt EDGE PAVEMENT

S.L.M. 985+39

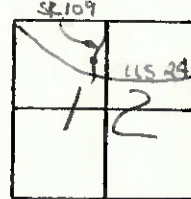

1964 PLAN

P.I. 985+64.58

$\Delta = 70.20' \text{ Rt.}$

$D = 30-30'$

$T = 104.90$

$E = 3.3$

