


O.D.O.T. DISTRICT 2 SURVEY OFFICE (USE ONLY)


PERSONNEL	REFERENCE NO. <u>40</u>	SHEET <u>10</u> OF <u>11</u>
NOTES <u>NIESE</u>	DATE <u>3/5/21</u>	ROUTE <u>SR 109</u>
H.C. <u>RHOADES</u>	WEATHER <u>SUNNY</u>	COUNTY <u>HENRY</u>
R.C. _____	TEMP. <u>30°</u>	TOWNSHIP <u>LIBERTY</u>
DWG BY <u>NIESE</u>	PID <u>PAVETRAIN</u>	SECTION <u>1</u>
		T <u>5</u> N R <u>7</u> E

TYPE MONUMENT MONBOX W/ 1" IPIN  
 ON SURFACE - ~~BELOW~~ ON  
 OFFSET Q PAVEMENT 12' ~~LT~~ : RT  
ON TO RT EDGE PAVEMENT  
 STATION: 1002+67

HORZ. DATUM: NAD83 2011 GEOID: NAVD88 2012A  
 GRID: NORTHING: 641320.318 EASTING: 1554665.040

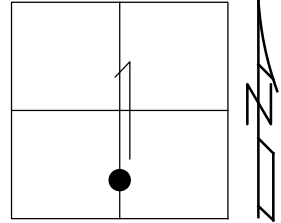

RECORD: P.I.  
 1964 PLAN  
 $\Delta = 8^\circ 52' 30''$  LT  
 $D = 1^\circ 28'$   
 $T = 303.16'$   
 $E = 11.72'$   
 FD MONBOX  
 7/19/02, DCH  
 FD MONBOX  
 W/ 1" IPIN  
 REF40  
 8/6/20, DSA  
 3/5/21, JMR  
 3/16/23, TDN

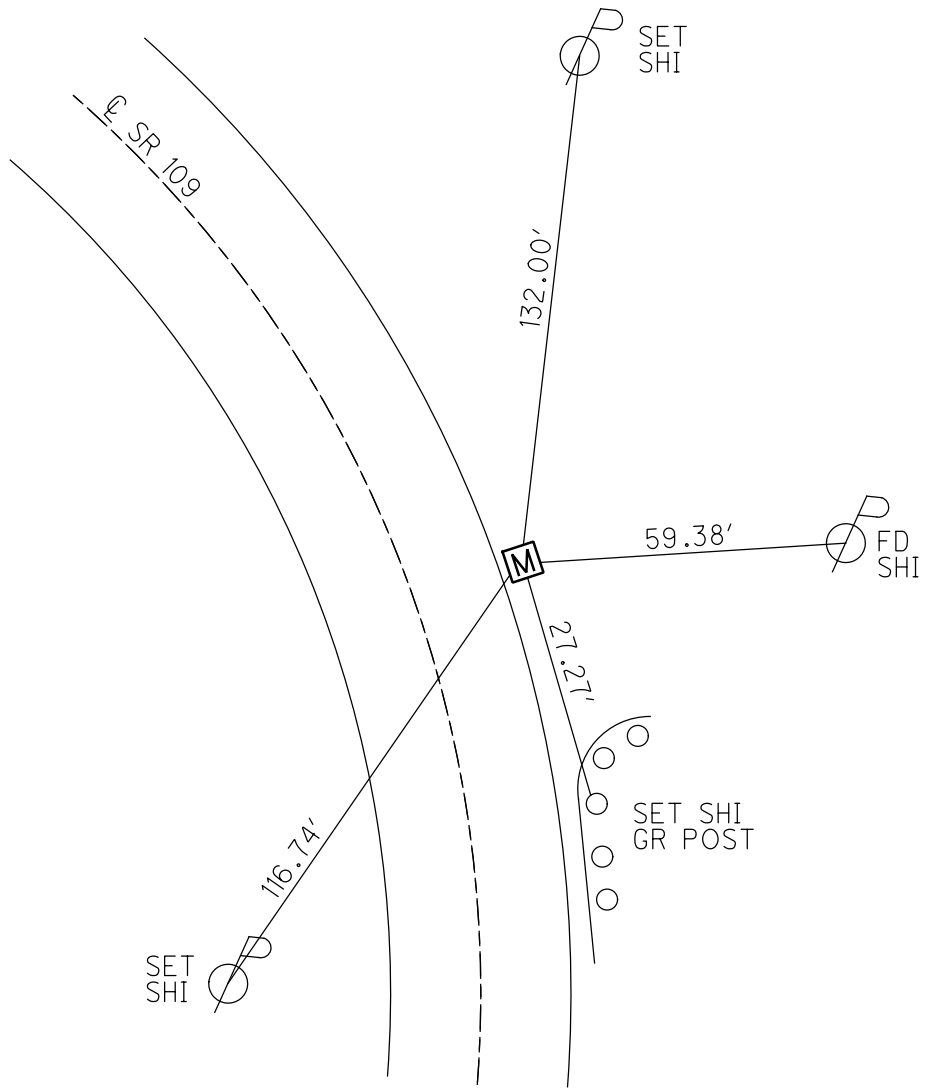

O.D.O.T. DISTRICT 2 SURVEY OFFICE (USE ONLY)

PERSONNEL

REFERENCE NO. 40

SHEET 10 OF 11

NOTES NIESE

DATE 3/5/21

ROUTE SR 109

H.C. RHOADES

WEATHER SUNNY

COUNTY HENRY

R.C. \_\_\_\_\_

TEMP. 30°

TOWNSHIP LIBERTY

DWG BY NIESE

PID PAVETRAIN

SECTION 12

T 5 N R 7 E

TYPE MONUMENT MONBOX W/ 1" IPIN

ON SURFACE - ~~BELOW~~ ON

OFFSET Q PAVEMENT 12' LT : RT

ON TO RT EDGE PAVEMENT


STATION: 1002+67

HORZ. DATUM: NAD83 2011


GEOID: NAVD88 2012A

GRID: NORTHING: 641320.318

EASTING: 1554665.040

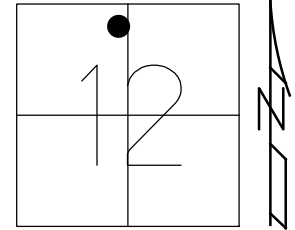

RECORD: P.I.  
 1964 PLAN  
 $\Delta = 8^\circ 52' 30''$  LT  
 $D = 1^\circ 28'$   
 $T = 303.16'$   
 $E = 11.72'$   
 FD MONBOX  
 7/19/02, DCH  
 FD MONBOX  
 W/ 1" IPIN  
 REF40  
 8/6/20, DSA  
 3/5/21, JMR

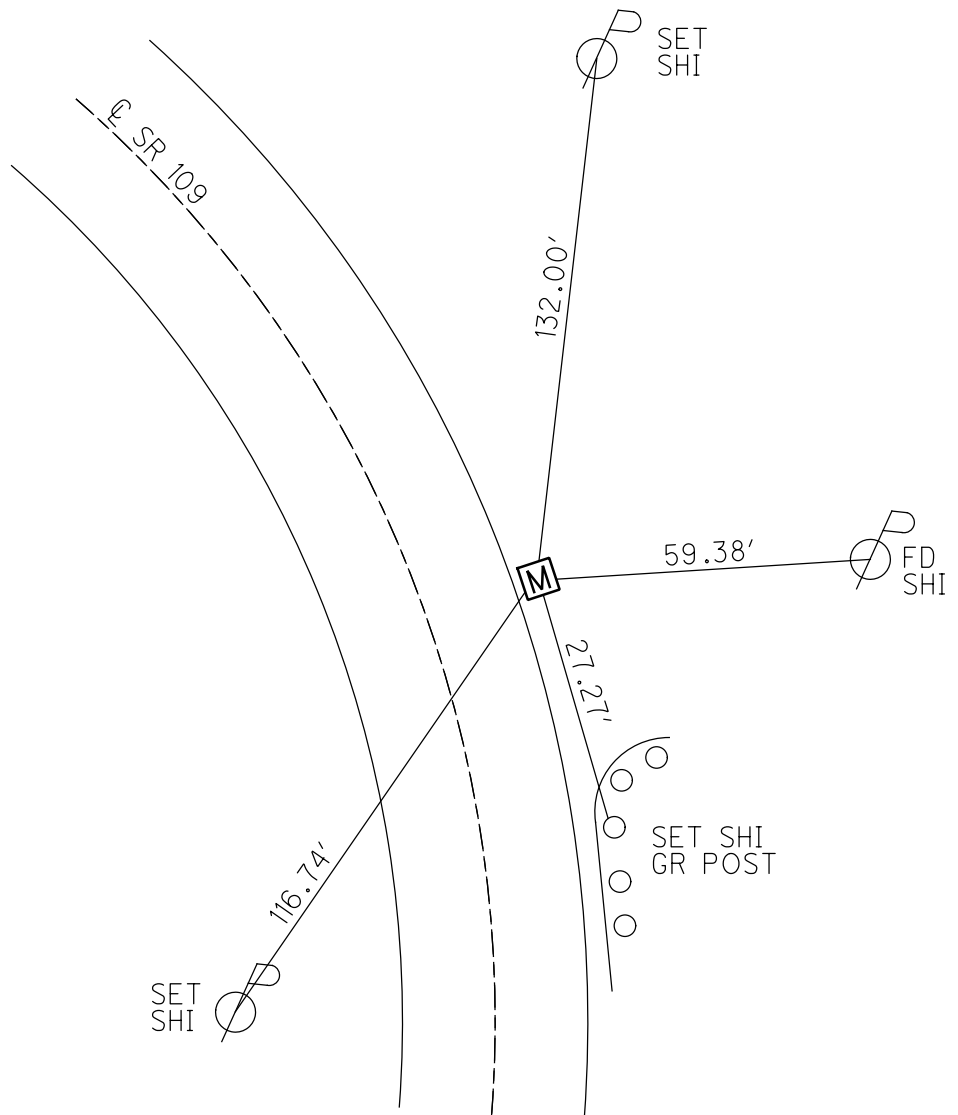

O.D.O.T. DISTRICT 2 SURVEY OFFICE

PERSONNEL

REFERENCE NO. 40

SHEET 3 OF 27

NOTES HOMAN

DATE 7-19-02

ROUTE S.R. 109

H.C. ROUSOS

WEATHER CLOUDY

COUNTY HENRY

R.C. HOMAN

TEMP. 88

TOWNSHIP LIBERTY

SECTION 12

T 5 N R 7 E


TYPE MONUMENT MON BOX FD DID NOT OPEN

ON SURFACE - BELOW ON

LEFT - Q PAV'T - RIGHT 12'

ON TO RT EDGE PAVEMENT

S.L.M. 1002+67

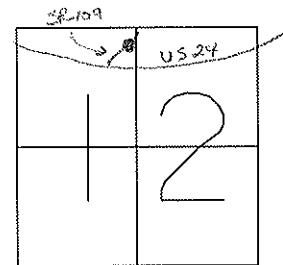

1964 PLAN


P.I. 1003+01.59

$\Delta = 8^{\circ} 52' 30''$  LT

D =  $1^{\circ} 28'$

T = 303.16'

E = 11.72'

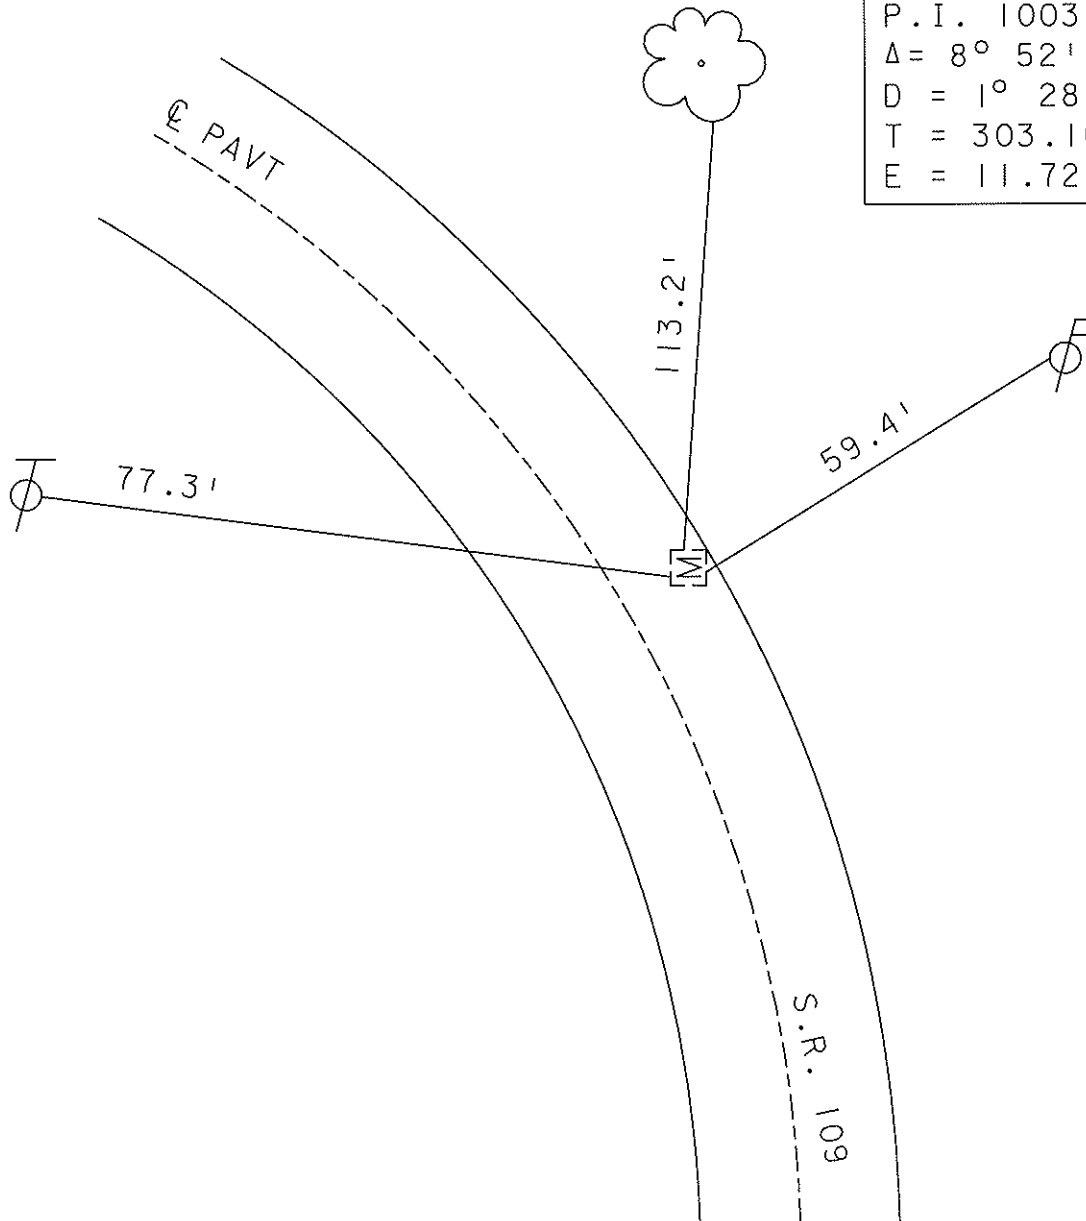

# O.D.O.T. DISTRICT 2 SURVEY OFFICE

PERSONNEL \_\_\_\_\_

REFERENCE NO. \_\_\_\_\_

SHEET \_\_\_\_\_ OF \_\_\_\_\_

NOTES HOFFMAN

H.C. BARNHISEL

R.G. LOENRKE

DATE 1-9-87

WEATHER OVERCAST

TEMP. 30°

ROUTE SR 109

COUNTY HENRY

TOWNSHIP LIBERTY

SECTION 12

T 5 N R 7 E


TYPE MONUMENT Monument Box - Did Not Open

ON SURFACE - BELOW 3"

~~LEFT - C PAV'T.~~ - RIGHT 12.1

ON TO RT EDGE PAVEMENT

S.L.M. 1002 + 67

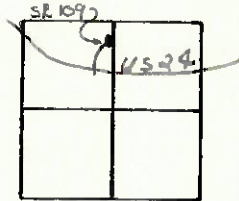

1964 PLAN

P.I. 1003 + 01.59

$\Delta = 8^{\circ} - 52' - 30'' \Delta$

$D = 1^{\circ} - 28'$

$T = 303.16$

$E = 11.72$

