


O.D.O.T. DISTRICT 2 SURVEY OFFICE (USE ONLY)


PERSONNEL _____ REFERENCE NO. 41 SHEET 11 OF 11
 NOTES NIESE DATE 3/5/21 ROUTE SR 109
 H.C. RHOADES WEATHER SUNNY COUNTY HENRY
 R.C. _____ TEMP. 30° TOWNSHIP LIBERTY
 DWG BY NIESE PID PAVETRAIN SECTION 1
 T 5 N R 7 E

TYPE MONUMENT MONBOX W/ 1" IPIN
 ON SURFACE - ~~BELOW~~ ON
 OFFSET C PAVEMENT 0.5' LT : ~~RT~~
10' TO LT EDGE PAVEMENT
 STATION: 1005+35

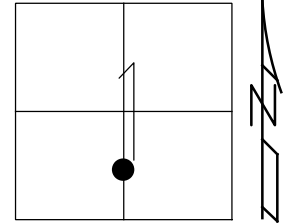

HORIZ.DATUM: NAD83 2011 GEOID: NAVD88 2012A
 GRID: NORTHING: 641590.113 EASTING: 1554668.691

RECORD:
 1964 PLAN
 FD MONBOX
 W/ 1" IPIN
 REF 41
 8/6/20, DSA
 3/5/21, JMR
 FD MONBOX
 W/BROKEN LID
 3/16/23, TDN

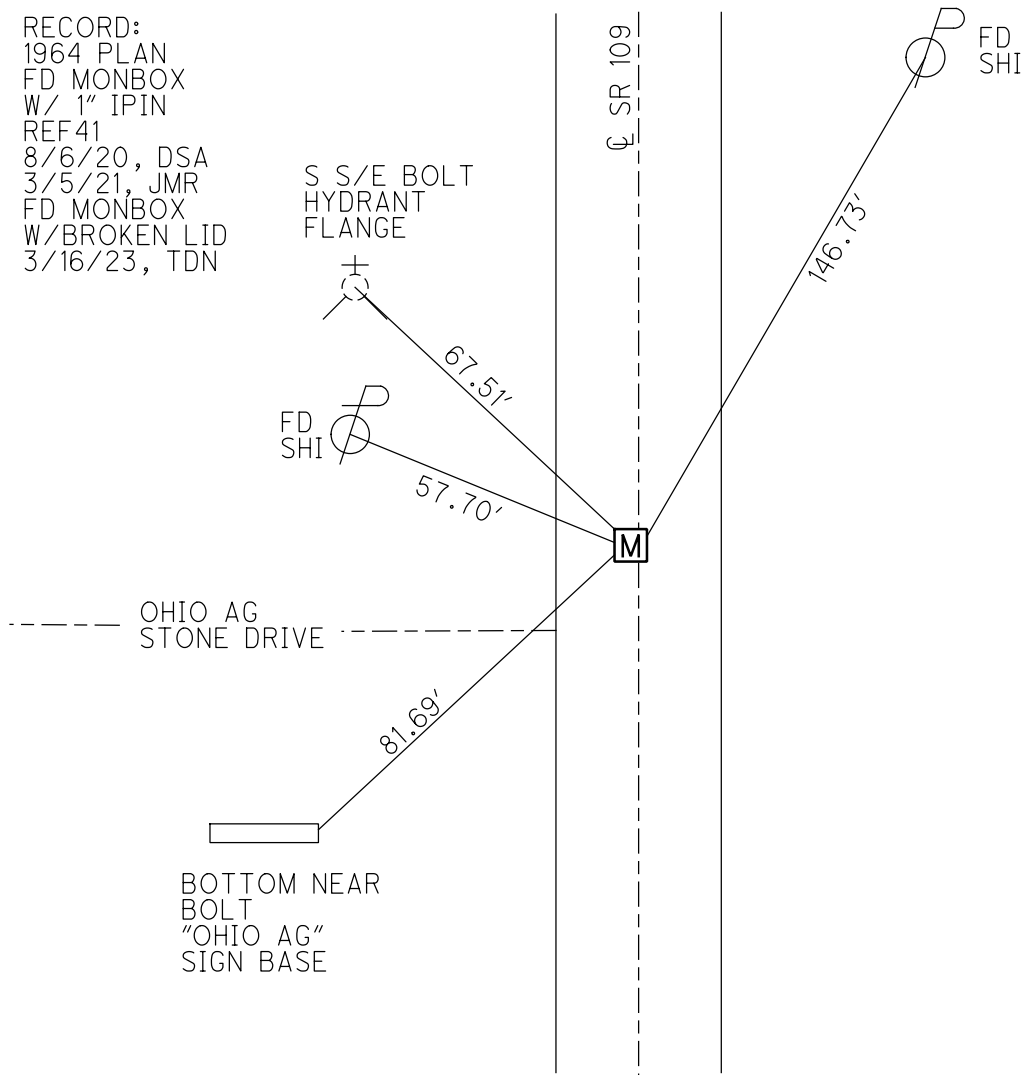

O.D.O.T. DISTRICT 2 SURVEY OFFICE (USE ONLY)

PERSONNEL _____

REFERENCE NO. 41

SHEET 11 OF 11

NOTES NIESE

DATE 3/5/21

ROUTE SR 109

H.C. RHOADES

WEATHER SUNNY

COUNTY HENRY

R.C. _____

TEMP. 30°

TOWNSHIP LIBERTY

DWG BY NIESE

PID PAVETRAIN

SECTION 1

T 5 N R 7 E

TYPE MONUMENT MONBOX W/ 1" IPIN

ON SURFACE - ~~BELOW~~ ON

OFFSET \varnothing PAVEMENT 0.5' LT : ~~RT~~

10' TO LT EDGE PAVEMENT


STATION: 1005+35

HORZ.DATUM: NAD83 2011


GEOID: NAVD88 2012A

GRID: NORTHING: 641590.113

EASTING: 1554668.691

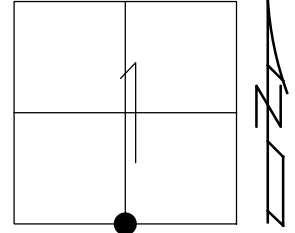

RECORD:
1964 PLAN
FD MONBOX
W/ 1" IPIN
REF 41
8/6/20, DSA
3/5/21, JMR

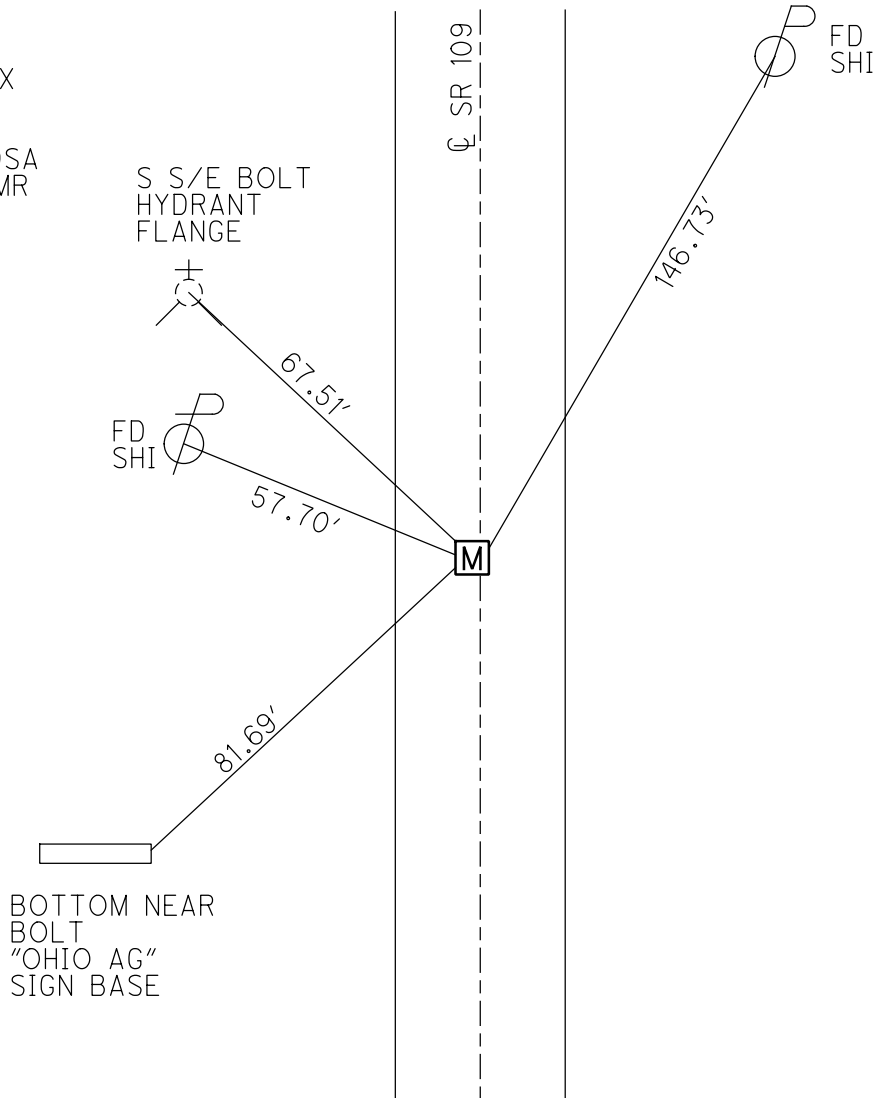

O.D.O.T. DISTRICT 2 SURVEY OFFICE

PERSONNEL

REFERENCE NO. 41

SHEET 4 OF 27

NOTES HOMAN

DATE 7-19-02

ROUTE S.R. 109

H.C. ROUSOS

WEATHER CLOUDY

COUNTY HENRY

R.C. HOMAN

TEMP. 88

TOWNSHIP LIBERTY

SECTION 1

T 5 N R 7 E


TYPE MONUMENT MON BOX FD DID NOT OPEN

ON SURFACE - ~~BELOW~~ ON

LEFT - ~~Q PAVT~~ - ~~RIGHT~~ 0.5'


10' TO LT EDGE PAVEMENT

S.L.M. 1005+35

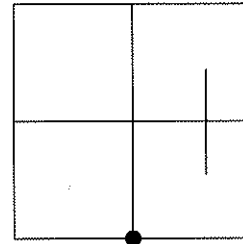


1964 PLAN
SE CORNER OF
SW 1/4 SEC 1
2' LT OF Q SR 109

FD SHI
SE S

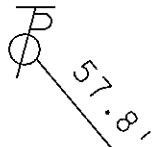


S.R. 109

Q. PVMT.

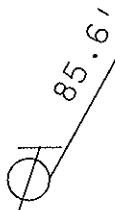

M

FD SHI
NE S

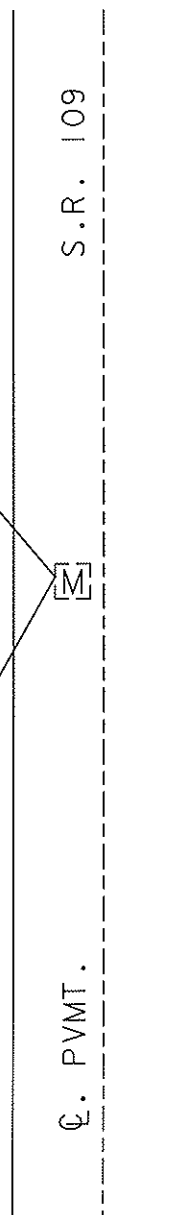

O.D.O.T. DISTRICT 2 SURVEY OFFICE

PERSONNEL _____

REFERENCE NO. _____

SHEET _____ OF _____

NOTES HOFFMAN

H.C. BARWISCH

R.C. LOENRKE

DATE 1-9-87

WEATHER OVERCAST

TEMP. 30°

ROUTE SR 109

COUNTY HENRY

TOWNSHIP LIBERTY

SECTION 1

T 5 N R 7 E


TYPE MONUMENT Monument Box - Did Not Open

ON SURFACE - BELOW 2"

LEFT - ~~C~~ PAV'T. - ~~RIGHT~~ 1.2'

10.1 TO LT EDGE PAVEMENT

S.L.M. 1005 + 35

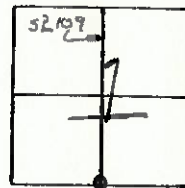

1964 PLAN

SE CORNER of

SW 1/4 Sec 1

2' Lt of SR 109

