

O.D.O.T. DISTRICT 2 SURVEY OFFICE (USE ONLY)

PERSONNEL

REFERENCE NO. 43

SHEET 2 OF 31

NOTES NIESE DATE 3/5/21  
H.C. RHOADES WEATHER SUNNY  
R.C. \_\_\_\_\_ TEMP. 30°

ROUTE SR 109  
COUNTY HENRY  
TOWNSHIP LIBERTY  
SECTION 1  
T 5 N R 7 E

DWG BY NIESE PID PAVE TRAIN

TYPE MONUMENT R.R.SPIKE

ON SURFACE - ~~BELOW~~ ON

OFFSET Q PAVEMENT 1.7' LT : ~~RT~~

8.0' TO LT EDGE PAVEMENT


STATION: 1031+74

HORIZ.DATUM: NAD83 2011

GEOID: NAVD88 2012A

GRID: NORTHING: \_\_\_\_\_

EASTING: \_\_\_\_\_

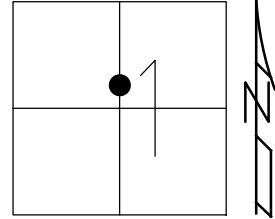

RECORD:  
FD R.R.SPIKE  
7/19/02, DCH  
SET MAG/WASHER  
12/2/02, DCH  
D.N.F.  
2/26/19, JLL  
8/6/20, DSA  
3/5/21, JMR

Q SR 109



CONC DR

88.82'



FD  
SHI

O.D.O.T. DISTRICT 2 SURVEY OFFICE

PERSONNEL

REFERENCE NO. 43

SHEET 6 OF 27

NOTES HOMAN

DATE 7-19-02

ROUTE S.R. 109

H.C. HOMAN

WEATHER CLOUDY

COUNTY HENRY

R.C. ROUSOS

TEMP. 90

TOWNSHIP LIBERTY

SECTION 1

T 5 N R 7 E


TYPE MONUMENT RR SPIKE

ON SURFACE - ~~BELOW~~ ON

LEFT - ~~Q PAVT~~ - ~~RIGHT~~ 1.7'


8' TO LT EDGE PAVEMENT

S.L.M. 1031+74

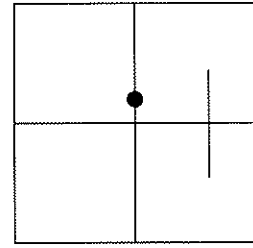

SET MAG NAIL  
& WASHER  
12-02-02  
DCH

FD SHI  
SE/S

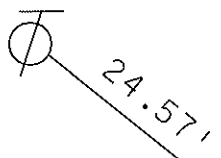


24.57'

S.R. 109




4th BRICK  
UP FROM DRIVE

Q CONC DR

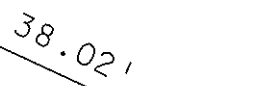

4th BRICK  
UP FROM DRIVE

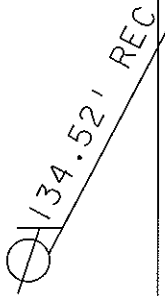

134.52' REC

Q. PVMT.

FD SHI  
NE/S

38.02'

88.82'



SET SHI  
NW/S

# O.D.O.T. DISTRICT 2 SURVEY OFFICE

PERSONNEL \_\_\_\_\_

REFERENCE NO. 43

SHEET \_\_\_\_\_ OF \_\_\_\_\_

NOTES BARNHISEL

H.C. Loehcke

DATE 5-13-87

ROUTE SR 109

R.C. \_\_\_\_\_

WEATHER Sunny

COUNTY HENRY

TEMP. +75°

TOWNSHIP LIBERTY

SECTION 1

T 5 N R 7 E

TYPE MONUMENT R.R. SPIKE


*Set SMALL  
RR SPIKE  
6-16-87  
SWH*

ON SURFACE - BELOW 2"


LEFT - ~~C~~ PAVT. - RIGHT 1.7

Z.S.JO L + EDGE PAVEMENT

S.L.M. 1031 + 74

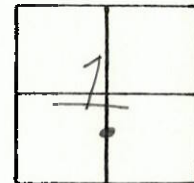


Record:  
1/4 mi S. of Rd "S"

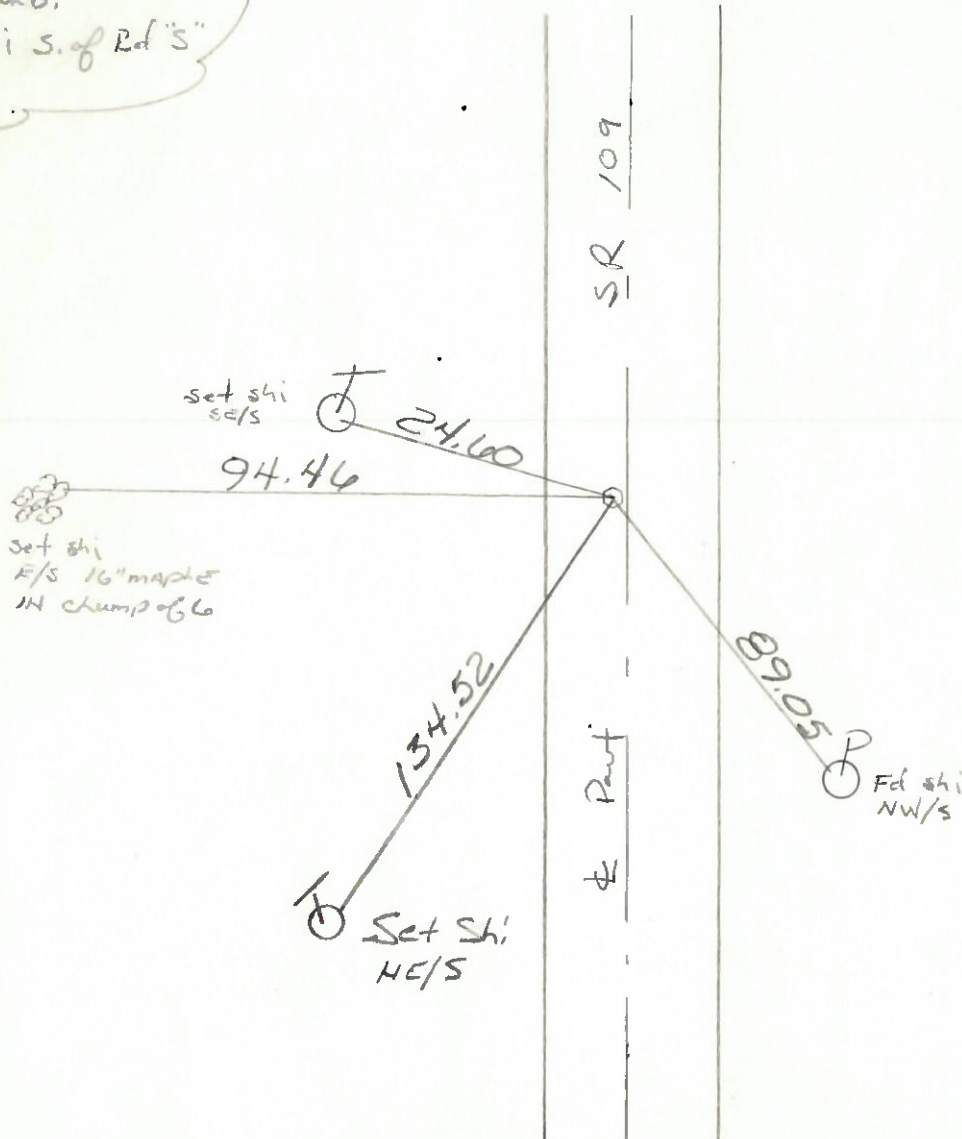

PERSONNEL	TITLE	PERSONNEL	TITLE	COUNTY	DATE
Toussic				HENRY	DEC. 17, 1973
Neuser				S. R. 109	WEATHER
Vanyo				SEC. HARRISON TWP.	TEMP.
Granata					

DESCRIPTION	LEFT	CENTER LINE	RIGHT	JOB NO.
-------------	------	-------------	-------	---------

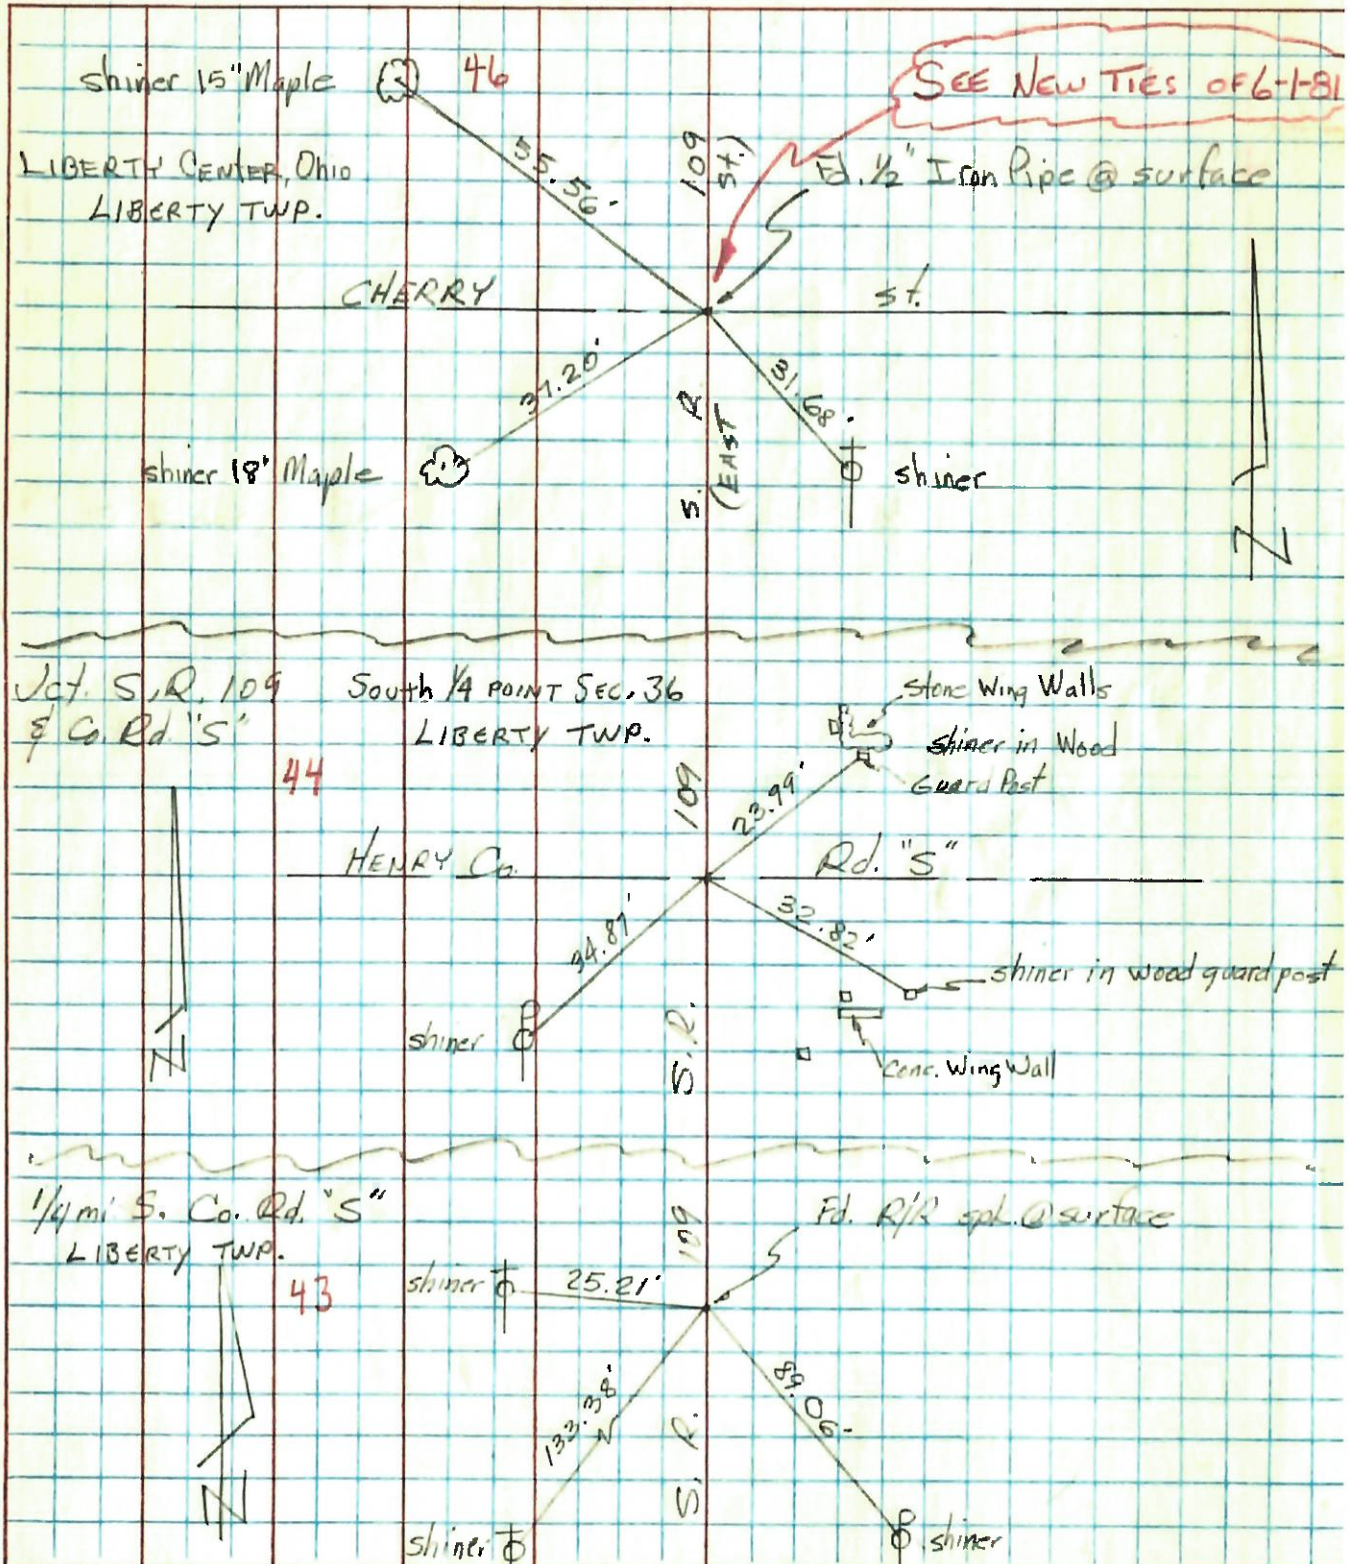

PERSONNEL	TITLE	PERSONNEL	TITLE	COUNTY	DATE	WEATHER	TEMP.
Tomsic				HENRY	DEC. 17-73		
Neusec				S. R. 109			
Vandy				SEC. LIBERTY TWP.			
Granata							

