

O.D.O.T. DISTRICT 2 SURVEY OFFICE (USE ONLY)

PERSONNEL _____ REFERENCE NO. 45 SHEET 5 OF 31

NOTES LEU DATE 4/25/17 ROUTE SR 109
 H.C. LEU WEATHER CLOUDY COUNTY HENRY
 R.C. HELMAN TEMP. 60° TOWNSHIP LIBERTY
 _____ SECTION 36
 _____ T 6 N R 7 E

TYPE MONUMENT MAG/WASHER


~~ON SURFACE~~ - BELOW 2"

LEFT - ℄ PAV'T - ~~RIGHT~~ 1'


8.1' TO LT EDGE PAVEMENT

S.L.M. 1070+72.31

GRID: NORTHING: 648118.333 EASTING: 1554808.209

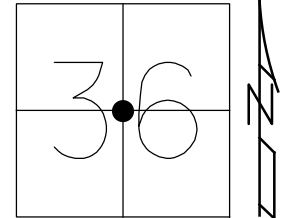


RECORD:
 FD R.R.SPIKE
 2" DOWN
 8/13/02, DCH
 SET MAG/WASHER
 12/02/02, DCH
 FD MAG/WASHER
 REF45
 2/5/16
 SET MAG/WASHER
 8/4/17, JLL

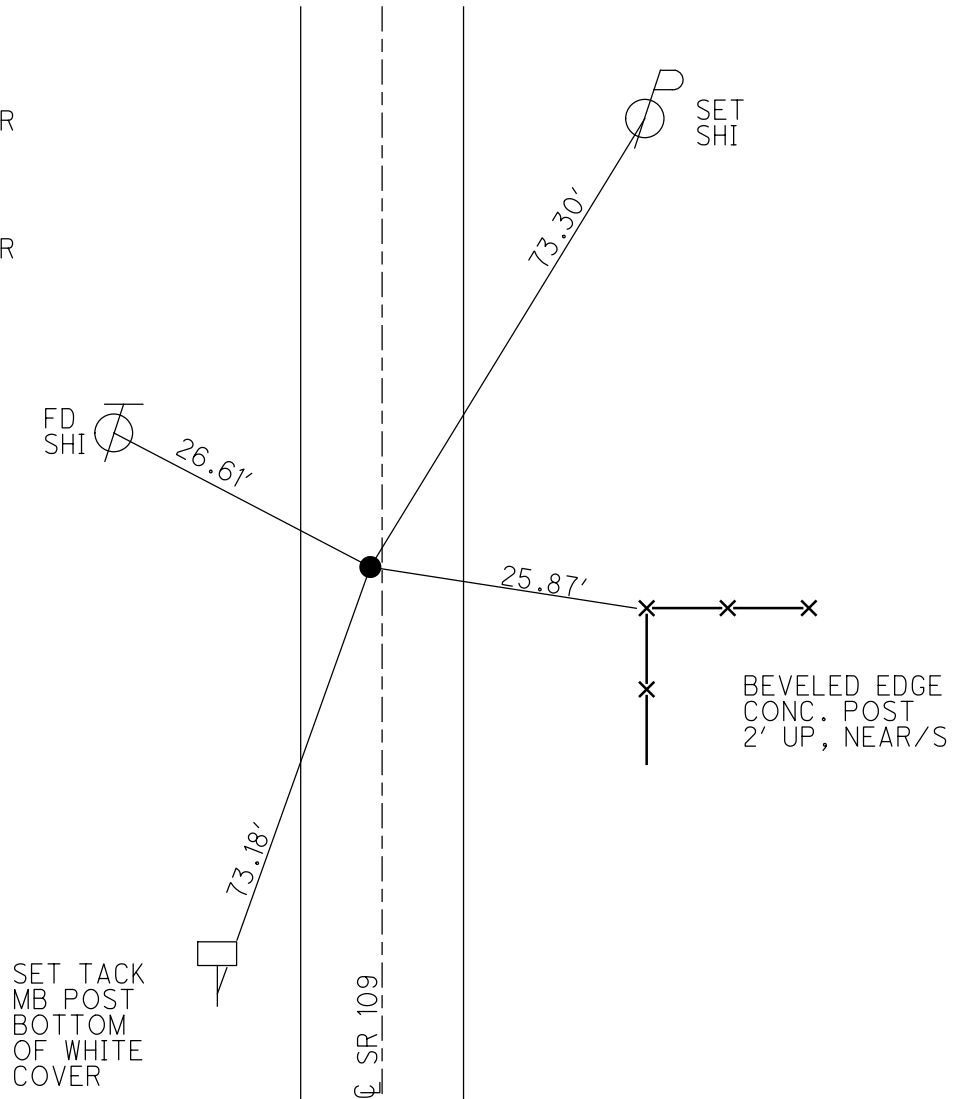

O.D.O.T. DISTRICT 2 SURVEY OFFICE (USE ONLY)


PERSONNEL _____ REFERENCE NO. 45 SHEET 1 OF 8
 NOTES LEU DATE 4/25/17 ROUTE SR 109
 H.C. LEU WEATHER CLOUDY COUNTY HENRY
 R.C. HELMAN TEMP. 60° TOWNSHIP LIBERTY
 SECTION 36
 T 6 N R 7 E

TYPE MONUMENT MAG/WASHER
~~ON SURFACE~~ - BELOW 2"
 LEFT - CL PAV'T - ~~RIGHT~~ 1'
8.1' TO LT EDGE PAVEMENT
 S.L.M. 1070+72.31

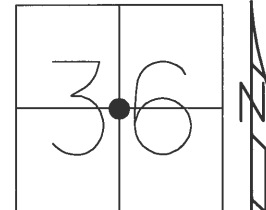

GRID: NORTHING: 648118.333 EASTING: 1554808.209

RECORD:
 FD R.R. SPIKE
 2" DOWN
 8/13/02, DCH
 SET MAG/WASHER
 12/02/02, DCH
 FD MAG/WASHER
 REF 45
 2/5/16
 SET MAG/WASHER
 8/4/17, JLL

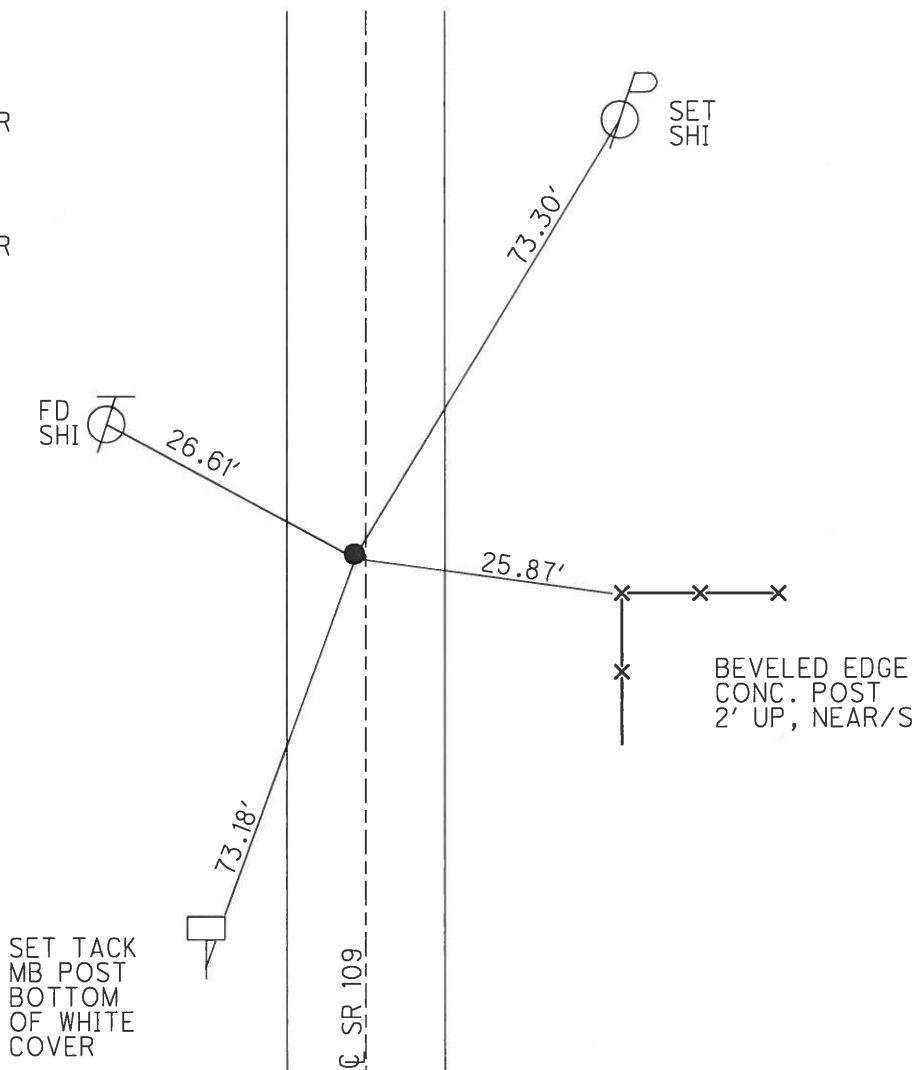

O.D.O.T. DISTRICT 2 SURVEY OFFICE

PERSONNEL

REFERENCE NO. 45

SHEET 8 OF 27

NOTES HOMAN

DATE 8-13-02

ROUTE S.R. 109

H.C. ROUSOS

WEATHER CLOUDY

COUNTY HENRY

R.C. BEAUMONT

TEMP. 90

TOWNSHIP LIBERTY

SECTION 36

T 6 N R 7 E


TYPE MONUMENT R.R. SPIKE

ON SURFACE - BELOW 2"


LEFT - Q PAV'T - RIGHT 1.4'

8.1 TO LT EDGE PAVEMENT

S.L.M. 1070+72

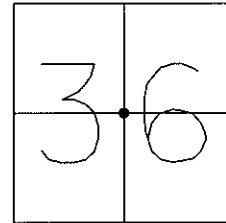

SET MAG NAIL
& WASHER
12-02-02
DCH

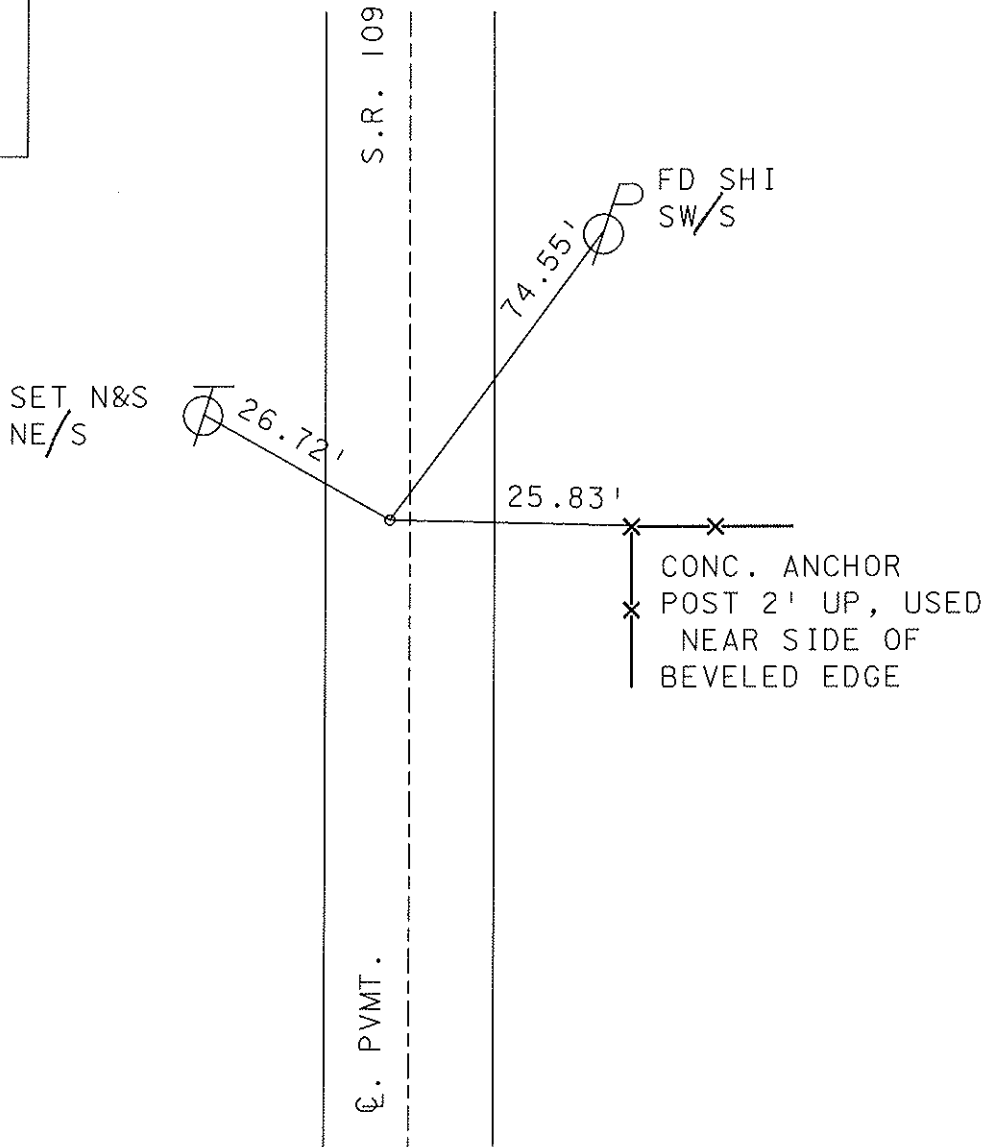

O.D.O.T. DISTRICT 2 SURVEY OFFICE

PERSONNEL _____

REFERENCE NO. 45

SHEET _____ OF _____

NOTES BARNHISEL

H.C. Lochake

R.C. _____

DATE 5-13-87

WEATHER Sunny

TEMP. +75°

ROUTE SR 109

COUNTY HENRY

TOWNSHIP LIBERTY

SECTION 36

T. 6 N. R. 7 E.

TYPE MONUMENT R.R. SPIKE

ON SURFACE - BELOW 2"

LEFT-~~C~~ PAV'T. - RIGHT 14

8.1 TO L EDGE PAVEMENT

S.L.M. 1070 +72

Set small
R.R. spike
6-16-87
SWA

