


O.D.O.T. DISTRICT 2 SURVEY OFFICE (USE ONLY)


PERSONNEL _____ REFERENCE NO. 47 DE SHEET 16 OF 31
 NOTES NIESE DATE 3/5/21 ROUTE SR 109
 H.C. RHOADES WEATHER SUNNY COUNTY HENRY
 R.C. _____ TEMP. 30° TOWNSHIP LIBERTY
 DWG BY NIESE PID PAVE TRAIN SECTION 25
 T 6 N R 7 E

TYPE MONUMENT P.K./WASHER
 ON SURFACE - ~~BELOW~~ ON
 OFFSET \odot PAVEMENT ON LT : RT
10.0' TO LT EDGE PAVEMENT
 STATION: 1138+17.4

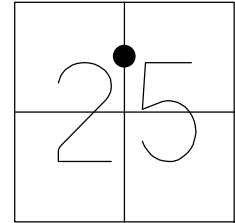

HORZ. DATUM: _____ GEOID: _____
 GRID: NORTHING: _____ EASTING: _____


RECORD:
 FD P.K./WASHER
 8/19/02, TMR
 SET MAG/WASHER
 12/2/02, DCH
 D.N.F.
 6/11/20, JFO
 3/5/21,
 1/11/23, JMR

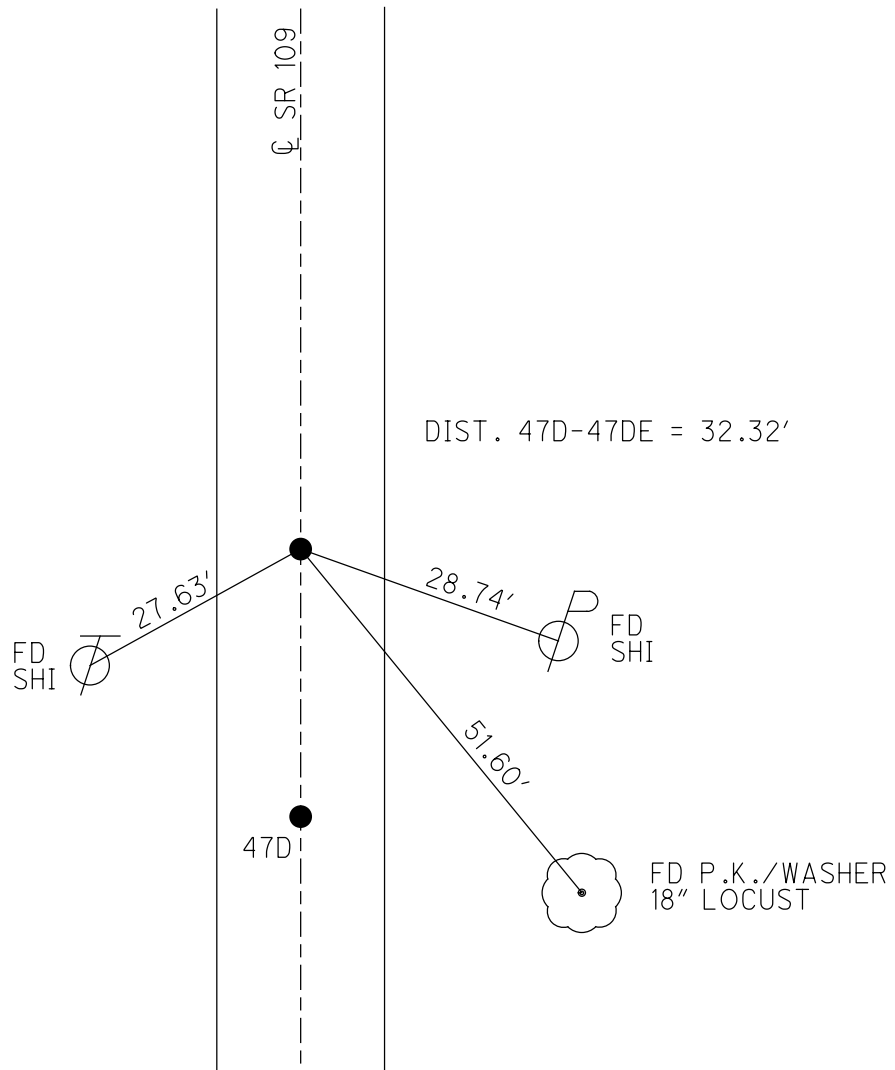

O.D.O.T. DISTRICT 2 SURVEY OFFICE (USE ONLY)


PERSONNEL _____ REFERENCE NO. 47 DE SHEET 16 OF 31
 NOTES NIESE DATE 3/5/21 ROUTE SR 109
 H.C. RHOADES WEATHER SUNNY COUNTY HENRY
 R.C. _____ TEMP. 30° TOWNSHIP LIBERTY
 _____ SECTION 25
 DWG BY NIESE PID PAVE TRAIN T 6 N R 7 E

TYPE MONUMENT P.K./WASHER
 ON SURFACE - ~~BELOW~~ ON
 OFFSET Q PAVEMENT ON LT : RT
10.0' TO LT EDGE PAVEMENT
 STATION: 1138+18

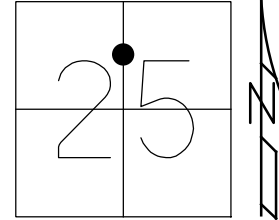

HORZ. DATUM: NAD83 2011 GEOID: NAVD88 2012A
 GRID: NORTHING: _____ EASTING: _____

RECORD:
 FD P.K./WASHER
 8/19/02, TMR
 SET MAG/WASHER
 12/2/02, DCH
 D.N.F.
 6/11/20, JFO
 3/5/21, JMR

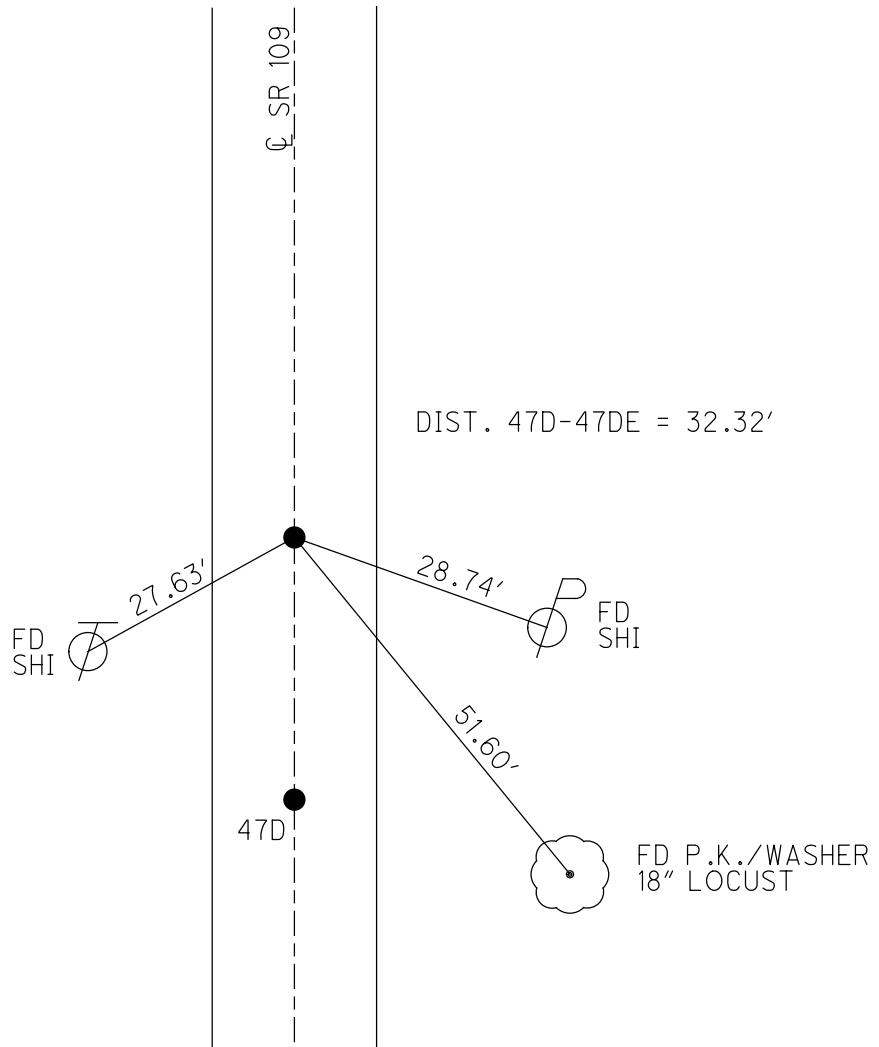

O.D.O.T. DISTRICT 2 SURVEY OFFICE

PERSONNEL _____ REFERENCE NO. 47-D SHEET _____ OF _____

NOTES VAN DUJEN

H.C. BARNHISEL

R.C. KUSZ

DATE 8-3-92

WEATHER CLEAR

TEMP. + 75° F

ROUTE S.R. 109


COUNTY HENRY

TOWNSHIP LIBERTY

SECTION 25


T 6 N R 7 E

TYPE MONUMENT P.K. & WASHER
 ON SURFACE - BELOW YES
 LEFT- & PAV'T. - RIGHT 0.6
10.8 TO LT. EDGE PAVEMENT
 S.L.M. PT. A 1137+86

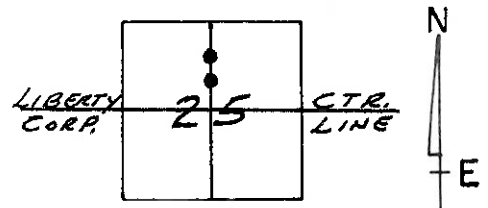

SET PK'S & WASHERS
 9-28-92
 MB

NOTE: "RECORD INFORMATION"
 ORIGINAL POINTS FOUND
 ON 11-17-81 WERE NOT
 SET BY ODOT.

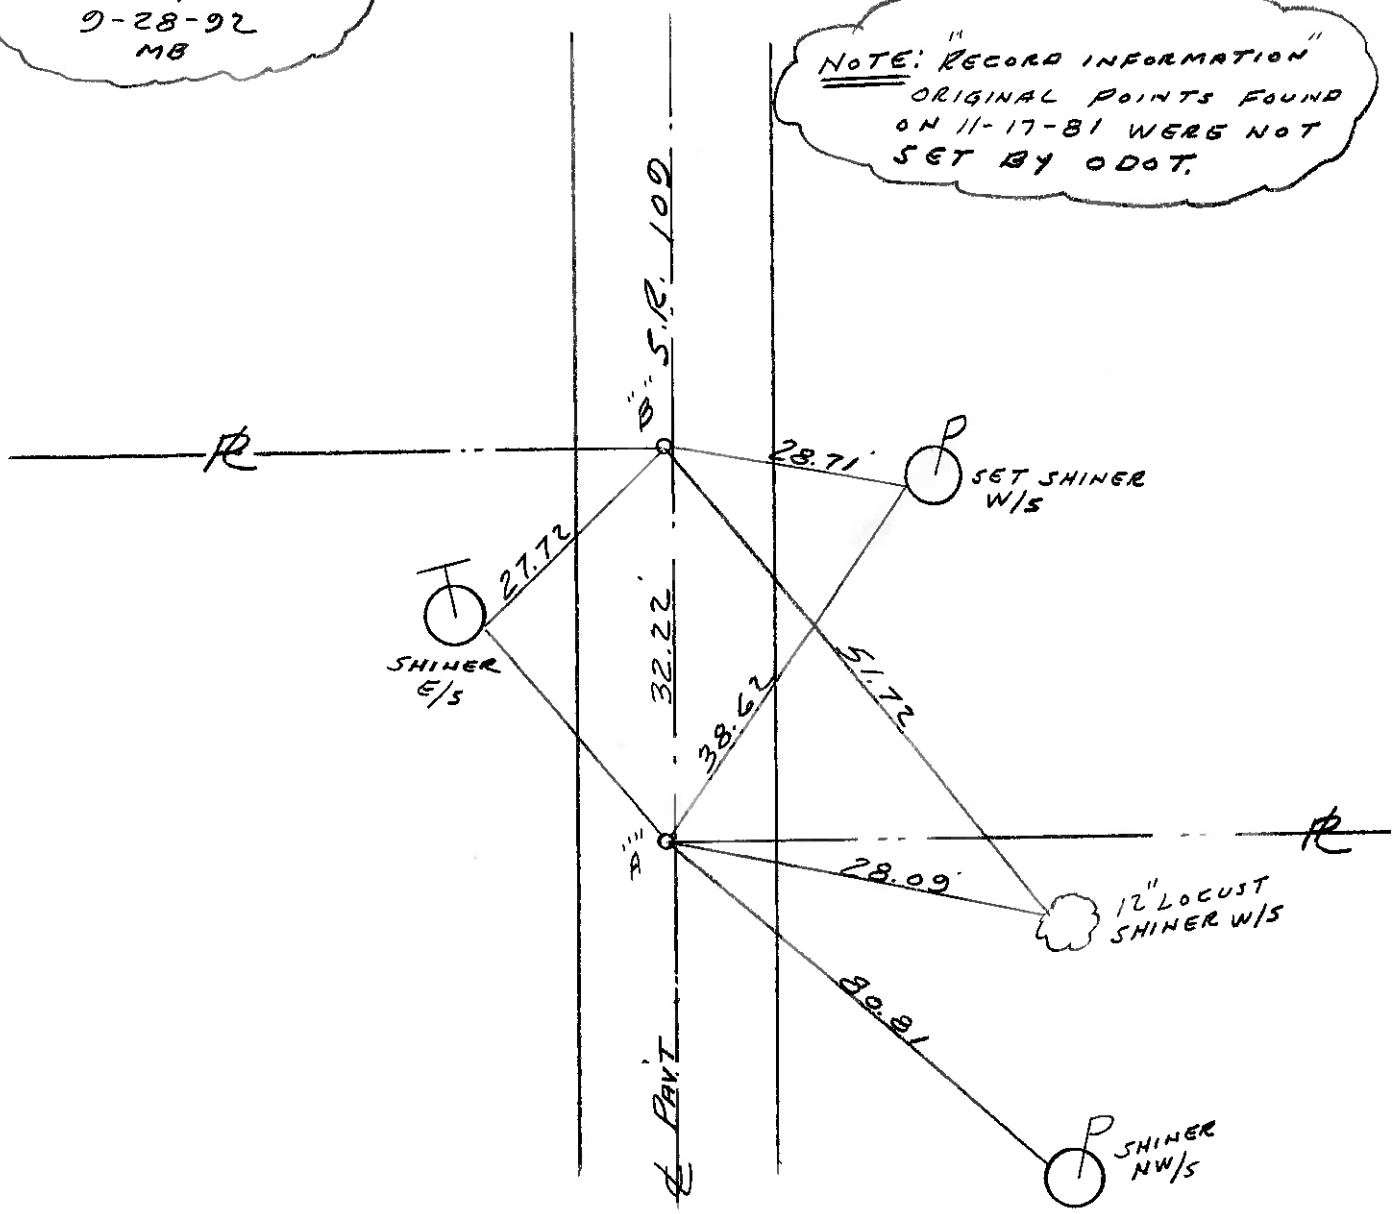

ODOT DISTRICT 2 SURVEY OFFICE

SHEET _____ OF _____

County Henry S.R. 109

Date 11-17-81

Township Liberty

Weather overcast

Section 25

Temp. +40°


T6N, R7E

Personnel Hoffman

Henschel

Loehrke

47-D

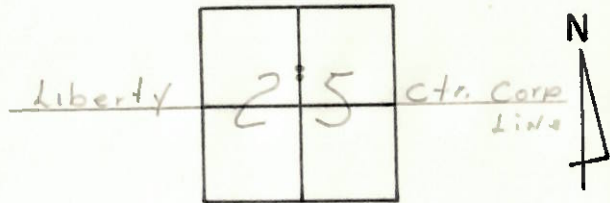

Pt. 'A' Nail @ surface @ k

Pt. 'A' STA ± 1138+77

Pt. 'B' P.K. @ surface @ k

Re. Set P.K. & WASHER 5-17-82 S.W.M.

Not set BY ODOT

