

O.D.O.T. DISTRICT 2 SURVEY OFFICE (USE ONLY)

PERSONNEL

REFERENCE NO. 51 C

SHEET 25 OF 31

NOTES NIESE

DATE 3/5/21

ROUTE SR 109

H.C. RHOADES

WEATHER SUNNY

COUNTY HENRY

R.C. _____

TEMP. 30°

TOWNSHIP LIBERTY

DWG BY NIESE PID PAVE TRAIN

SECTION 13

T 6 N R 7 E

TYPE MONUMENT MAG/WASHER

ON SURFACE - ~~BELOW~~ ON

OFFSET 0 PAVEMENT ON LT : RT

10' TO LT EDGE PAVEMENT



STATION: 1239+44.1

HORIZ.DATUM: NAD83 2011

GEOID: NAVD88 2012A

GRID: NORTHING: 664400.625

EASTING: 1555115.007

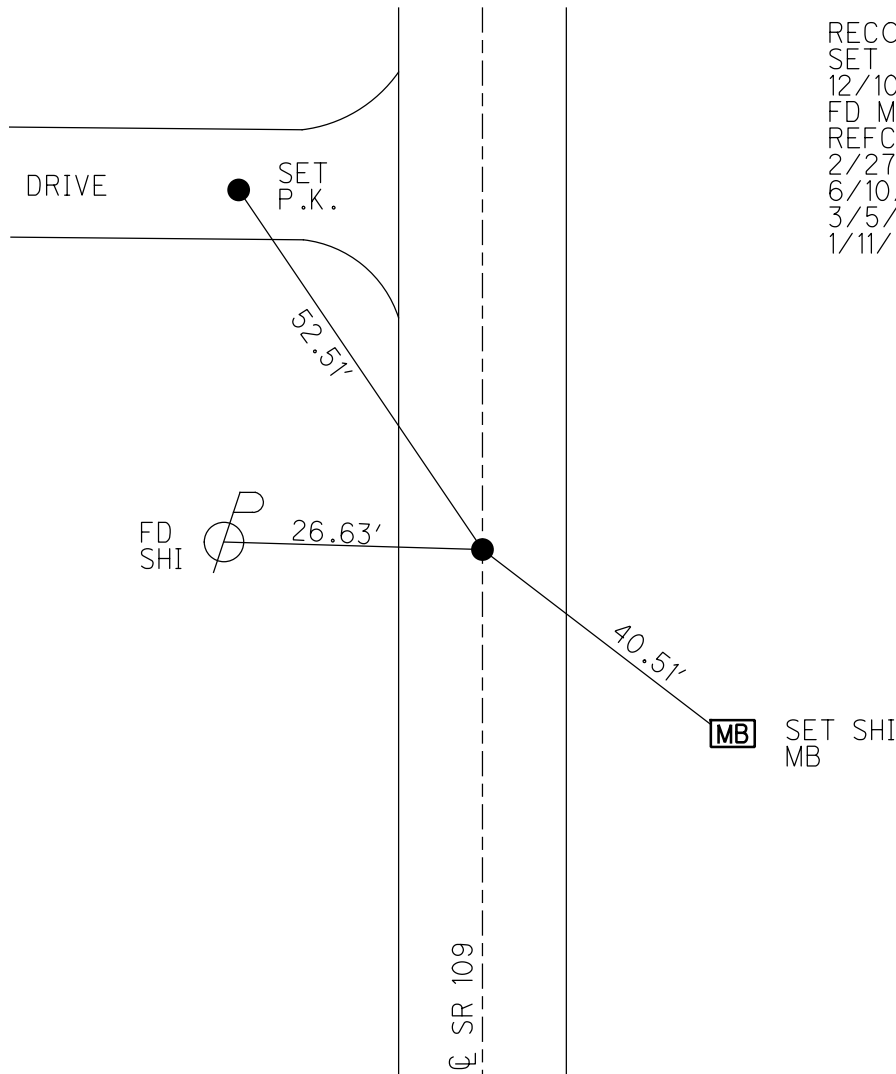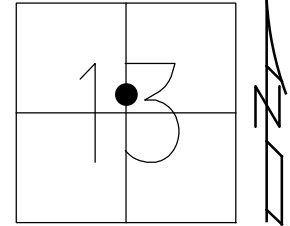



RECORD:
 SET MAG/WASHER
 12/10/02, DCH
 FD MAG/WASHER
 REFC51
 2/27/19, JLL
 6/10/20, JFO
 3/5/21,
 1/11/23, JMR

O.D.O.T. DISTRICT 2 SURVEY OFFICE (USE ONLY)

PERSONNEL _____ REFERENCE NO. 51 C SHEET 25 OF 31
NOTES NIESE DATE 3/5/21 ROUTE SR 109
H.C. RHOADES WEATHER SUNNY COUNTY HENRY
R.C. _____ TEMP. 30° TOWNSHIP LIBERTY
DWG BY NIESE PID PAVE TRAIN SECTION 13
T 6 N R 7 E

TYPE MONUMENT MAG/WASHER
ON SURFACE - ~~BELOW~~ ON
OFFSET Q PAVEMENT ON LT : RT
10' TO LT EDGE PAVEMENT
STATION: 1239+47

HORZ.DATUM: NAD83 2011 GEOID: NAVD88 2012A
GRID: NORTHING: 664400.625 EASTING: 1555115.007

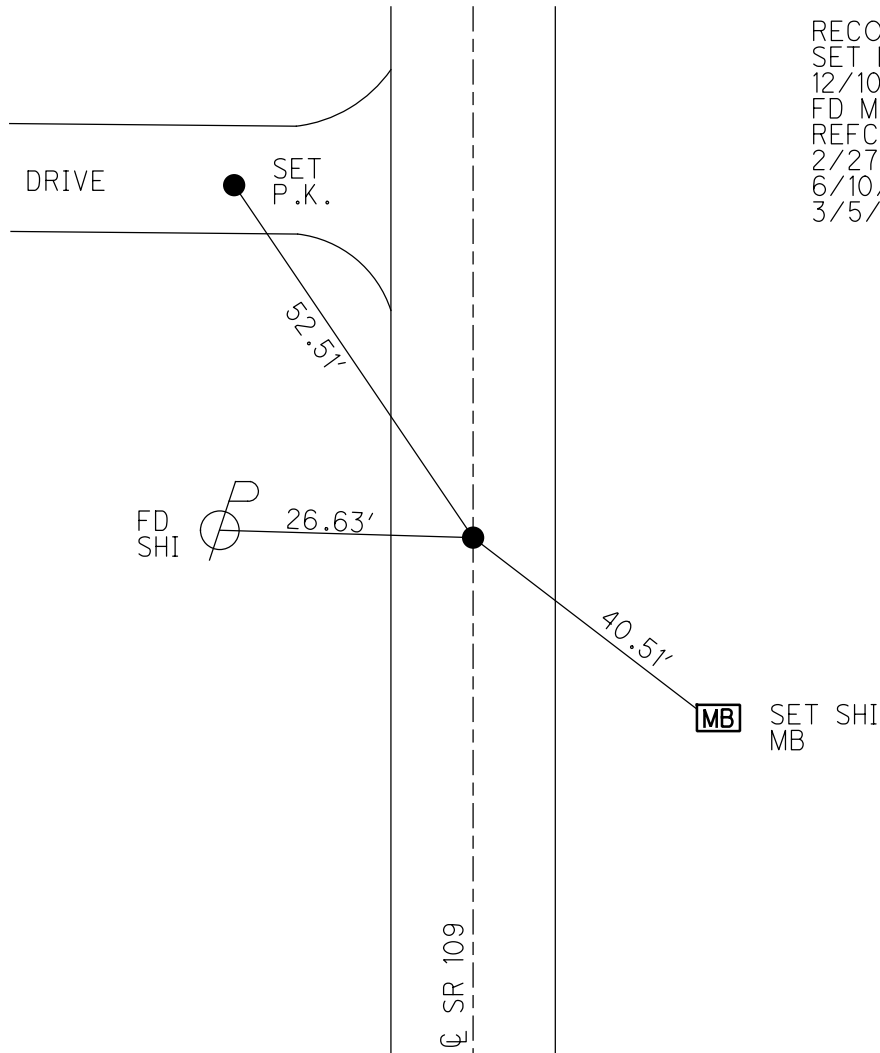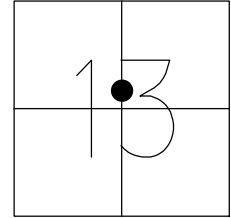

RECORD:
SET MAG/WASHER
12/10/02, DCH
FD MAG/WASHER
REFC51
2/27/19, JLL
6/10/20, JFO
3/5/21, JMR

O.D.O.T. DISTRICT 2 SURVEY OFFICE

PERSONNEL

REFERENCE NO. 51
A, B, C

SHEET 21 OF 27

NOTES HOMAN

DATE 9-9-02

ROUTE S.R. 109

H.C. HOMAN

WEATHER SUNNY

COUNTY HENRY

R.C. BROWN

TEMP. 75

TOWNSHIP LIBERTY

SECTION 13

T 6 N R 7 E


TYPE MONUMENT PK & WASHER

ON SURFACE - ~~BELOW~~ ON


~~LEFT - Q PAV'T - RIGHT~~ ON

10' TO LT EDGE PAVEMENT

S.L.M. 1237+07 PT A

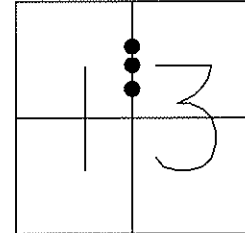

SET MAG NAIL IN Q DRIVE

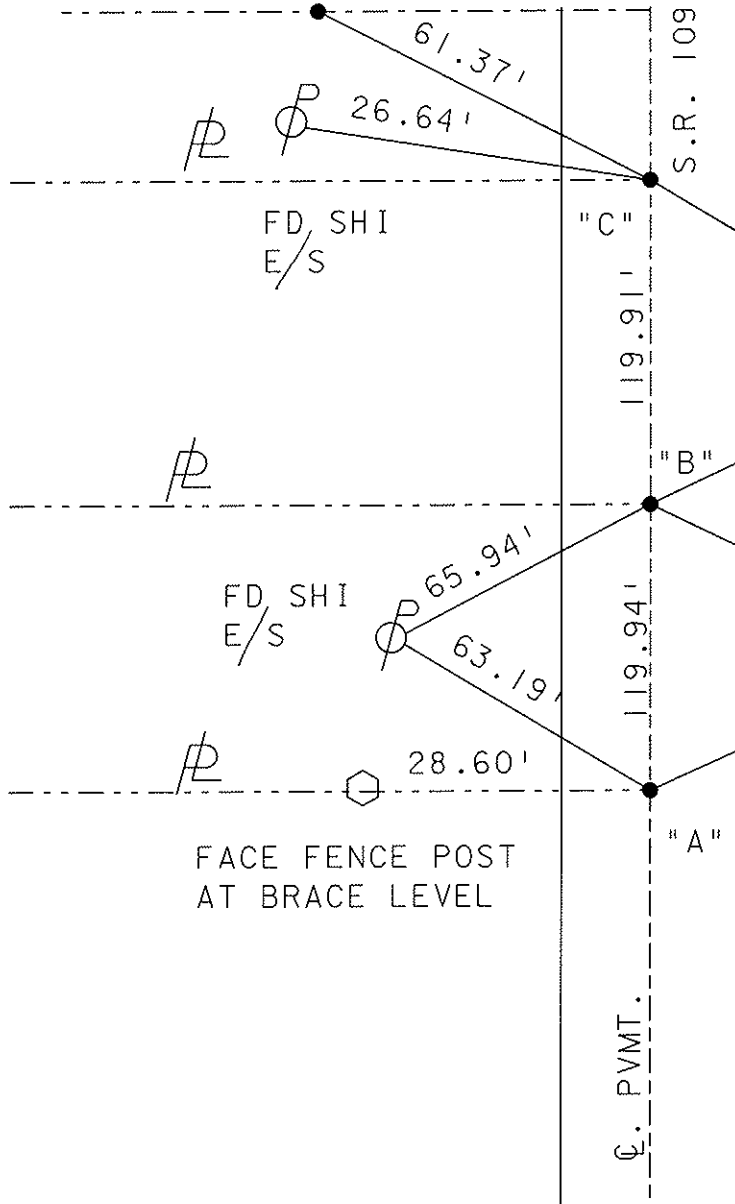

SET MAG NAIL & WASHER
12-10-02
DCH

[MB] SET TACK MB 1' UP

[MB] SET TACK MB 1' UP

Fd R.R. SPIKE 1/2" down

O.D.O.T. DISTRICT 2 SURVEY OFFICE

PERSONNEL _____

REFERENCE NO. 51
A, B, C

SHEET _____ OF _____

NOTES VAN DUSEN

H.C. BARNHISEL

R.C. KUSZ

DATE 8-12-92

WEATHER CLEAR

TEMP. + 75° F

ROUTE S.R. 109



COUNTY HENRY

TOWNSHIP LIBERTY

SECTION 13

T 6 N R 7 E

TYPE MONUMENT P.K.'S & WASHERS
ON SURFACE - BELOW YES
LEFT - & PAV'T. - RIGHT YES
10.4 TO LT. EDGE PAVEMENT
S.L.M. P.T. A 1237+07

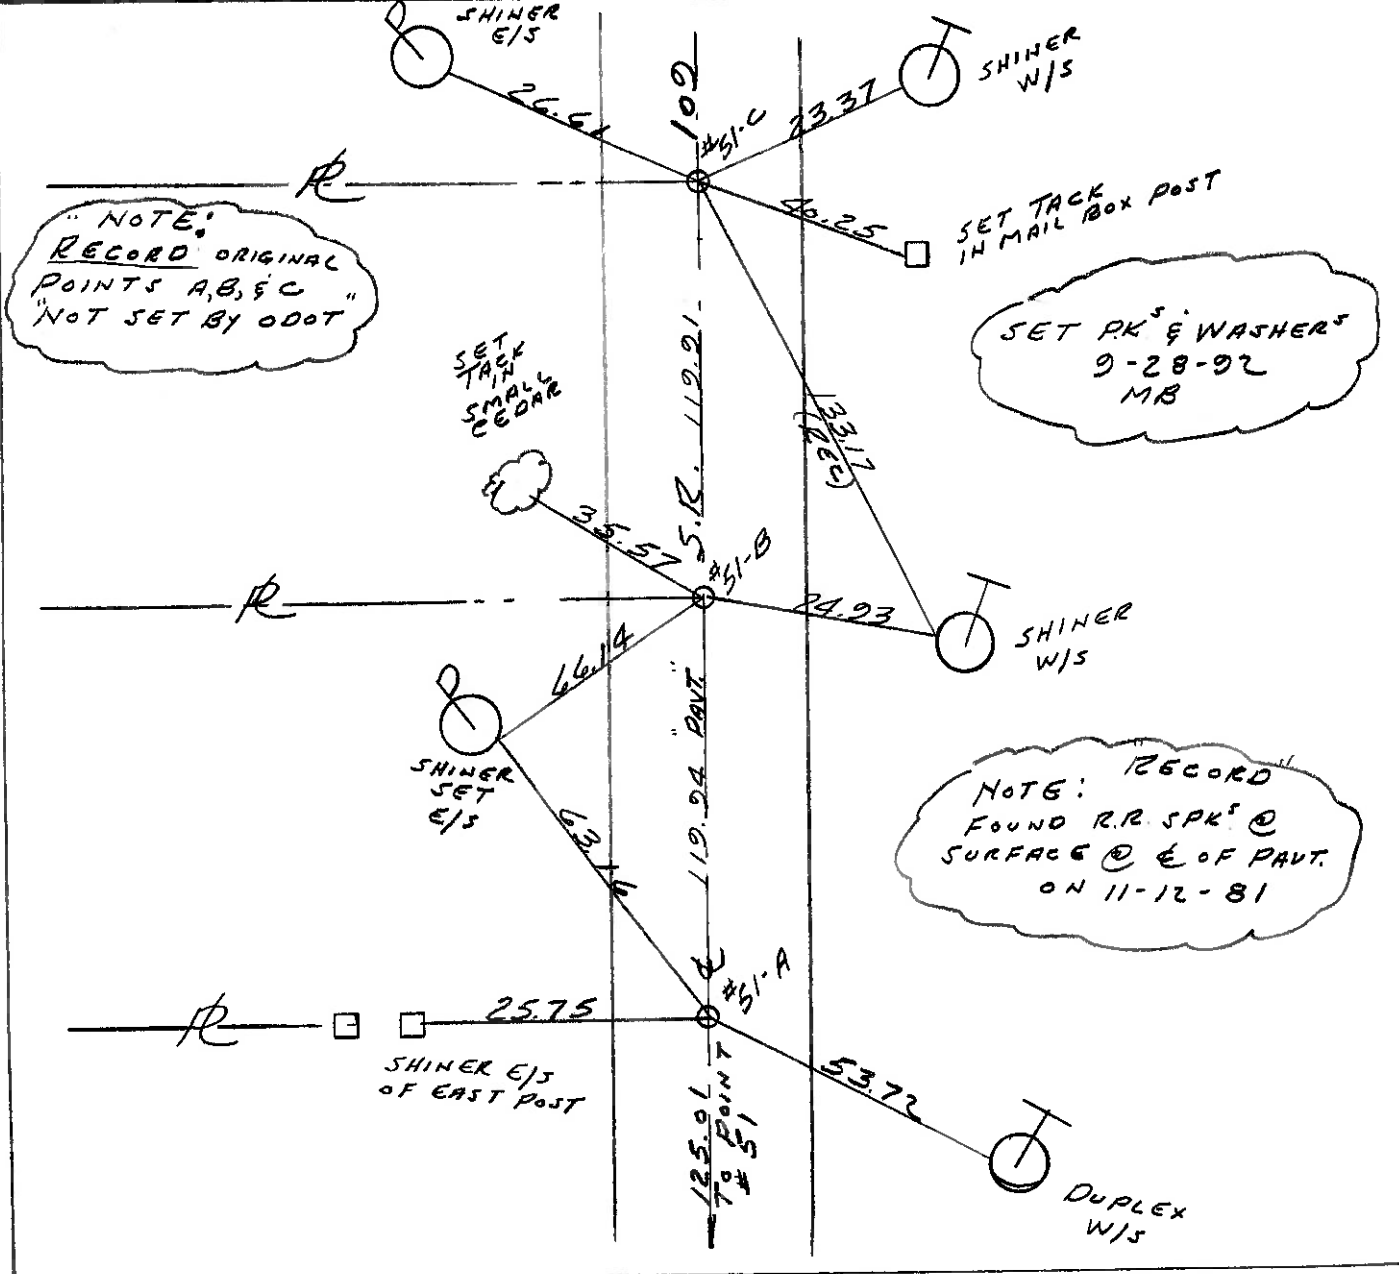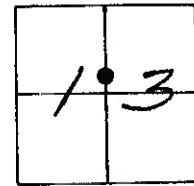

ODOT DISTRICT 2 SURVEY OFFICE

SHEET _____ OF _____

County Henry S.R. 109

Date 11-12-81

Township Liberty

Weather Clear

Section 13

Temp. +48°

T6N, R7E

Personnel Hoffman

Householder


Loehrke



#51-a, b & c Not set by ODOT

RE-SET P.K. & WASHER @ ALL PTS.

5-18-82
S.W.M.

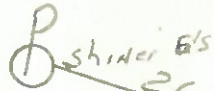

26.60



Shiner W/S

23.40

#51-C

R.R. SPK/T @ surface
@ & of PAUT.



133.17

119.91

Shiner W/S m.B. Post
#1 V-559

20.13

#51-B

Severly Bent
R.R. SPK @ surface
@ & of PAUT.



52.32

24.95

Shiner W/S



Shiner E/S

63.91

65.20

Shiner W/S of m.B. Post
Roger Carpenter

119.99

70.71

#51-A

R.R. SPK @
SURFACE @
& of PAUT.



25.64

Shiner E/S
of EAST POST

125.01
To point
#51

53.73



Duplex W/S