

O.D.O.T. DISTRICT 2 SURVEY OFFICE (USE ONLY)

PERSONNEL

REFERENCE NO. 51 D

SHEET 26 OF 31

NOTES NIESE

DATE 3/5/21

ROUTE SR 109

H.C. RHOADES

WEATHER SUNNY

COUNTY HENRY

R.C. _____

TEMP. 30°

TOWNSHIP LIBERTY

DWG BY NIESE PID PAVE TRAIN

SECTION 13

T 6 N R 7 E

TYPE MONUMENT R.R.SPIKE

~~ON SURFACE~~ - BELOW 4 1/2"

OFFSET \odot PAVEMENT ON LT : RT

10' TO LT EDGE PAVEMENT


STATION: 1243+20.9

HORZ.DATUM: NAD83 2011


GEOID: NAVD88 2012A

GRID: NORTHING: 664777.252

EASTING: 1555121.541

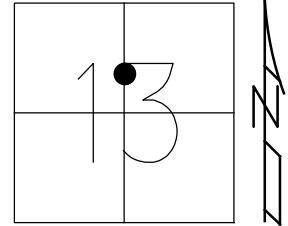


RECORD:
 FD P.K./WASHER
 9/9/02, DCH
 SET MAG/WASHER
 12/10/02, DCH
 FD SM.R.R.SPIKE
 4.5" DOWN
 2/27/19, JLL
 FD R.R.SPIKE
 4 1/2" DOWN
 REFD51
 6/10/20, JFO
 3/5/21,
 1/11/23, JMR

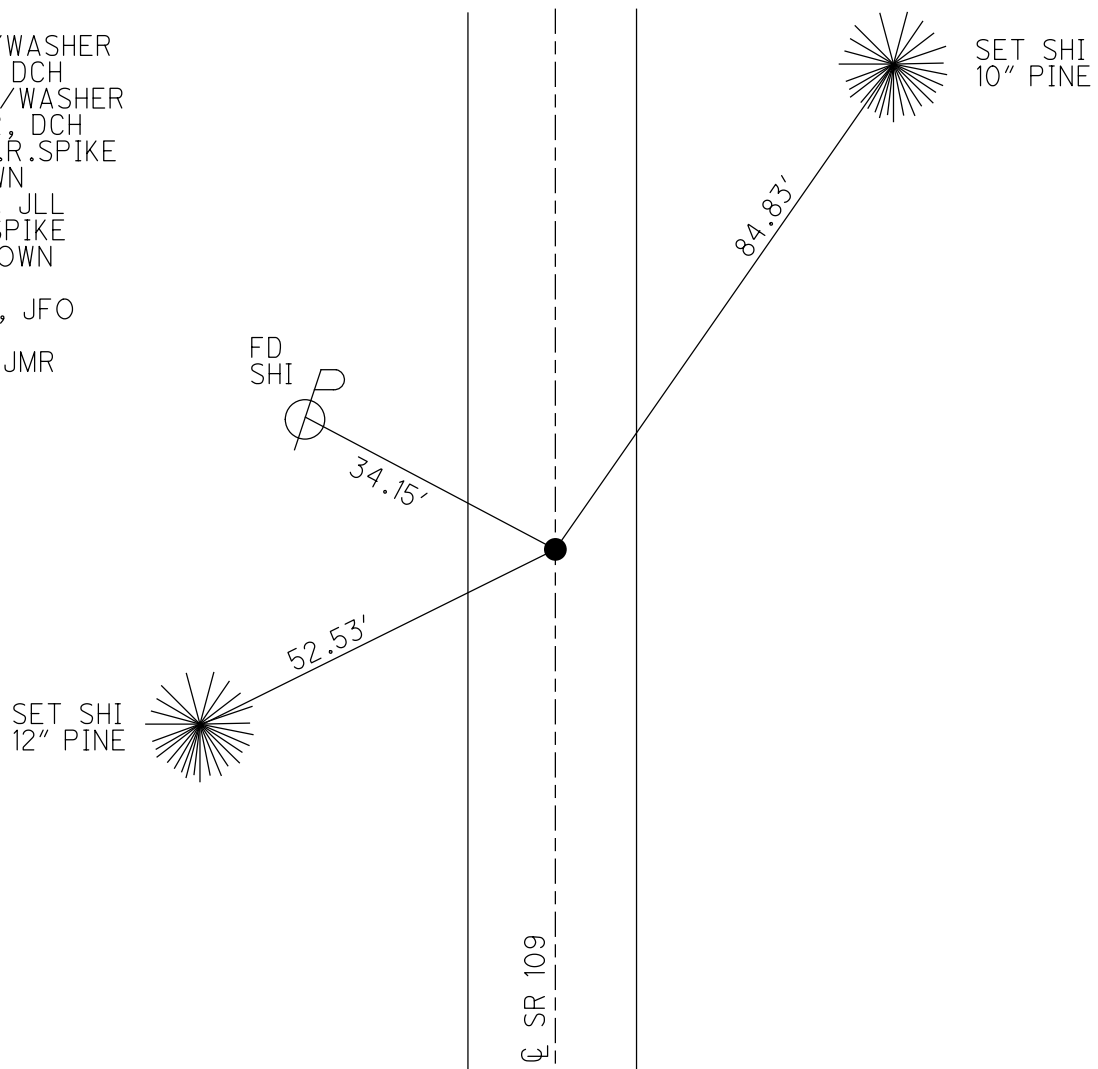

O.D.O.T. DISTRICT 2 SURVEY OFFICE (USE ONLY)


PERSONNEL _____ REFERENCE NO. 51 D SHEET 26 OF 31
 NOTES NIESE DATE 3/5/21 ROUTE SR 109
 H.C. RHOADES WEATHER SUNNY COUNTY HENRY
 R.C. _____ TEMP. 30° TOWNSHIP LIBERTY
 DWG BY NIESE PID PAVE TRAIN SECTION 13
 T 6 N R 7 E

TYPE MONUMENT R.R.SPIKE
~~ON SURFACE~~ - BELOW 4 1/2"
 OFFSET \perp PAVEMENT ON LT : RT
10' TO LT EDGE PAVEMENT
 STATION: 1243+23

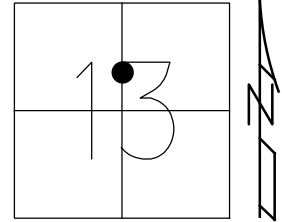

HORZ.DATUM: NAD83 2011 GEOID: NAVD88 2012A
 GRID: NORTHING: 664777.252 EASTING: 1555121.541

RECORD:
 FD P.K./WASHER
 9/9/02, DCH
 SET MAG/WASHER
 12/10/02, DCH
 FD SM.R.R.SPIKE
 4.5" DOWN
 2/27/19, JLL
 FD R.R.SPIKE
 4 1/2" DOWN
 REFD51
 6/10/20, JFO
 3/5/21, JMR

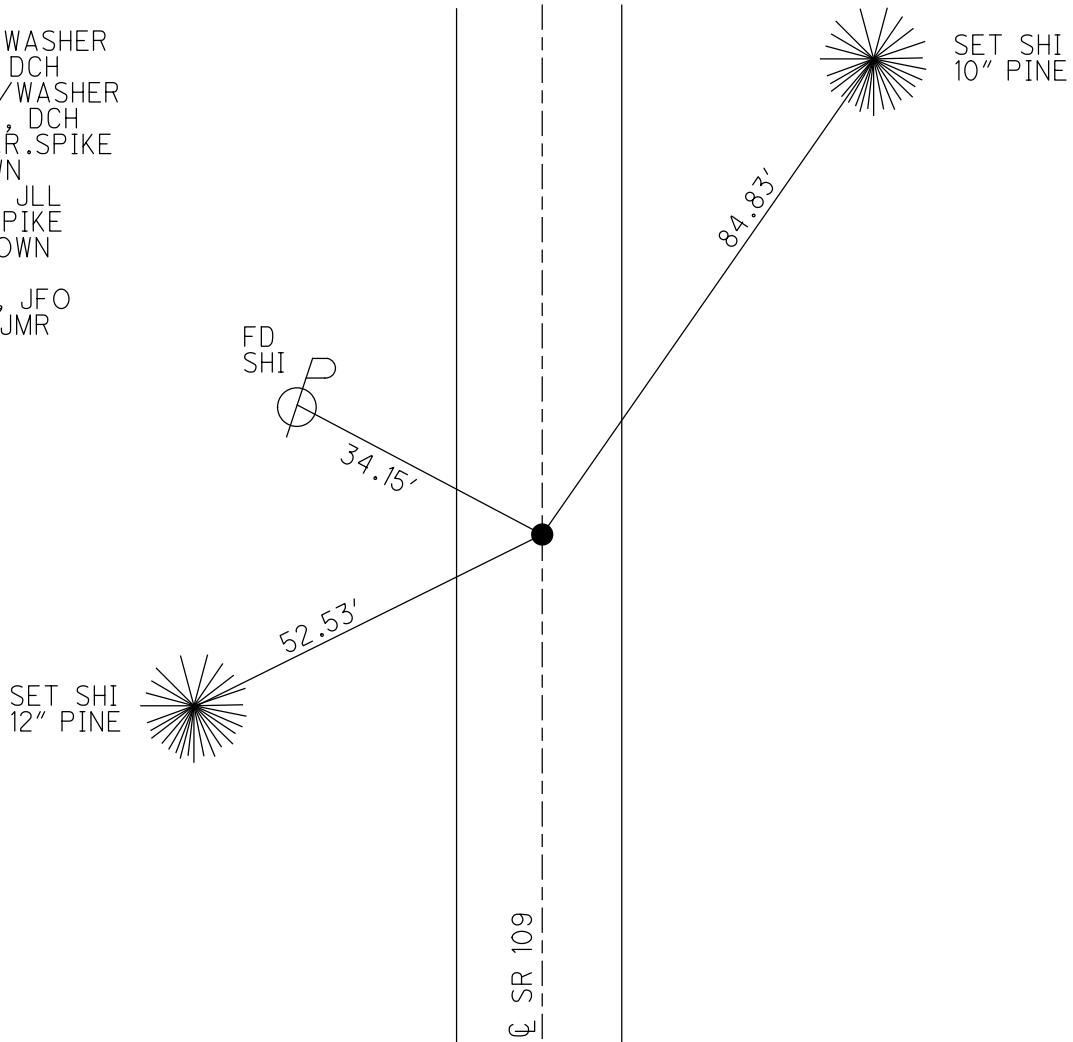

O.D.O.T. DISTRICT 2 SURVEY OFFICE

PERSONNEL

REFERENCE NO. 51D

SHEET 22 OF 27

NOTES HOMAN

DATE 9-9-02

ROUTE S.R. 109

H.C. HOMAN

WEATHER SUNNY

COUNTY HENRY

R.C. BROWN

TEMP. 75

TOWNSHIP LIBERTY

SECTION 13

T 6 N R 7 E


TYPE MONUMENT PK & WASHER

ON SURFACE - ~~BELOW~~ ON

~~LEFT - Q PAV'T - RIGHT~~ ON


10' TO LT EDGE PAVEMENT

S.L.M. 1243+23

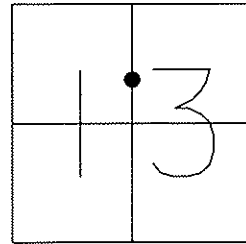

SET MAG NAIL
& WASHER
12-11-02
DCH

FD SHI
SE/S

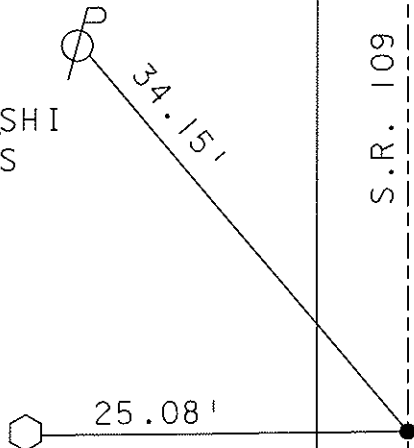

FACE OF IRON
FENCE POST
SOUTH SIDE
1' UP FROM GROUND

℄. PVMT.

O.D.O.T. DISTRICT 2 SURVEY OFFICE

PERSONNEL

REFERENCE NO. 51-D SHEET OF

NOTES VAN DUSEN

H.C. BARNHISEL

R.C. KUSZ

DATE 8-12-92

WEATHER CLEAR

TEMP. +75 F

ROUTE S.R. 109

COUNTY HENRY

TOWNSHIP LIBERT

SECTION 13

T 6 N R 7 E


TYPE MONUMENT PK & WASHER

ON SURFACE - BELOW YES

LEFT - C PAV'T. - RIGHT YES


10.4 TO LT. EDGE PAVEMENT

S.L.M. 1243+23

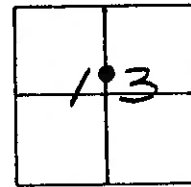

RECORD
NOTE: FOUND R.R. SPK.
@ SURFACE 11-12-81
NOT SET BY ODOT

SET PK & WASHER
9-28-92
MB

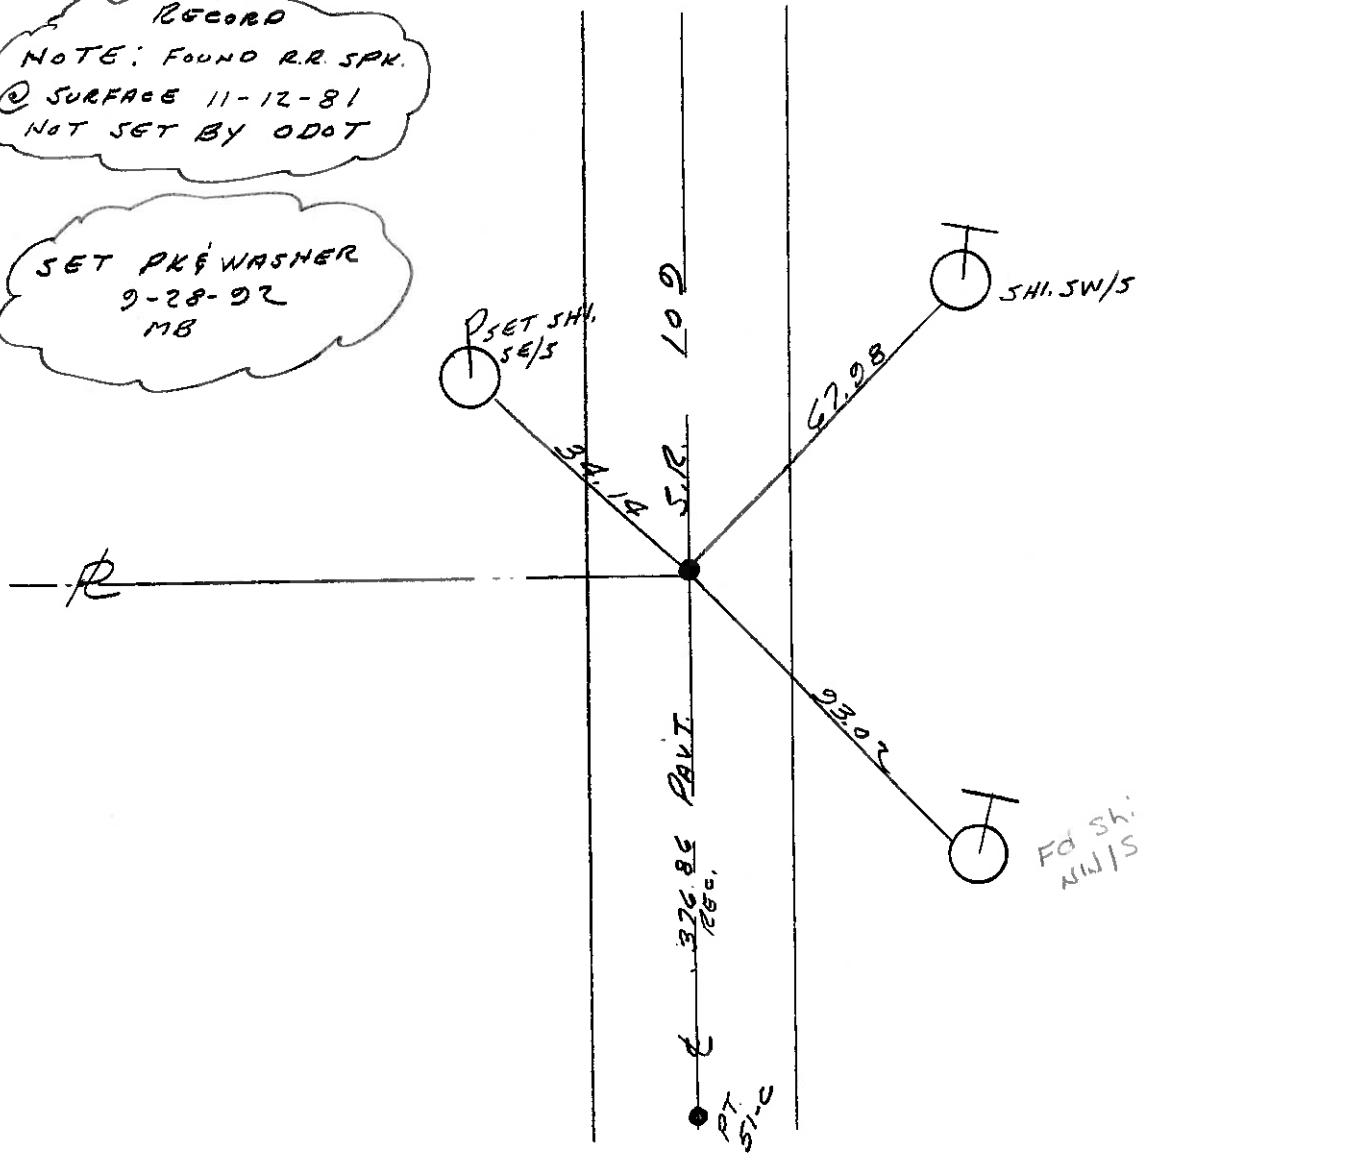

ODOT. DISTRICT 2 SURVEY OFFICE

SHEET _____ OF _____

County Henry S.R. 109

Date 11-12-81

Township Liberty

Weather clear

Section 13

Temp. +48°


T4N, R7E

Personnel HOFFMAN

Householder

Loehke

#51-D

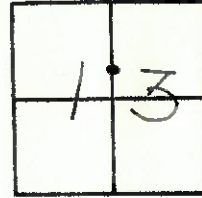

Project STA. ± 1243+46

30" Shiner s/s

104.06

109

67.95

#51-D

R. E. SPK @ SURFACE w/+

@ pmt.

Not Set by ODOT.

RE-SET RR. & WASHER

5-18-82
S.W.H.

Pmt. S.R.

376.86
to Pt #51-C

93.04

Shiner s/s

Shiner NW/s