

O.D.O.T. DISTRICT 2 SURVEY OFFICE (USE ONLY)

PERSONNEL _____

REFERENCE NO. 51 H

SHEET 30 OF 31

NOTES NIESE

DATE 3/5/21

ROUTE SR 109

H.C. RHOADES

WEATHER SUNNY

COUNTY HENRY

R.C. _____

TEMP. 30°

TOWNSHIP LIBERTY

SECTION 13

DWG BY NIESE

PID PAVE TRAIN

T 6 N R 7 E

TYPE MONUMENT MAG/WASHER

ON SURFACE - ~~BELOW~~ ON

OFFSET ☉ PAVEMENT ON LT : RT
10' TO LT EDGE PAVEMENT


STATION: 1259+80

HORIZ.DATUM: NAD83 2011


GEOID: NAVD88 2012A

GRID: NORTHING: 666432.994

EASTING: 1555150.963

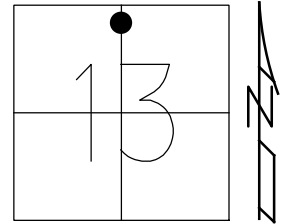

RECORD:
 FD P.K./WASHER
 9/9/02, DCH
 SET MAG/WASHER
 12/10/02, DCH
 FD MAG SHANK
 SET MAG/WASHER
 2/27/19, JLL
 FD MAG/WASHER
 6/9/20, JLL
 3/5/21, JMR

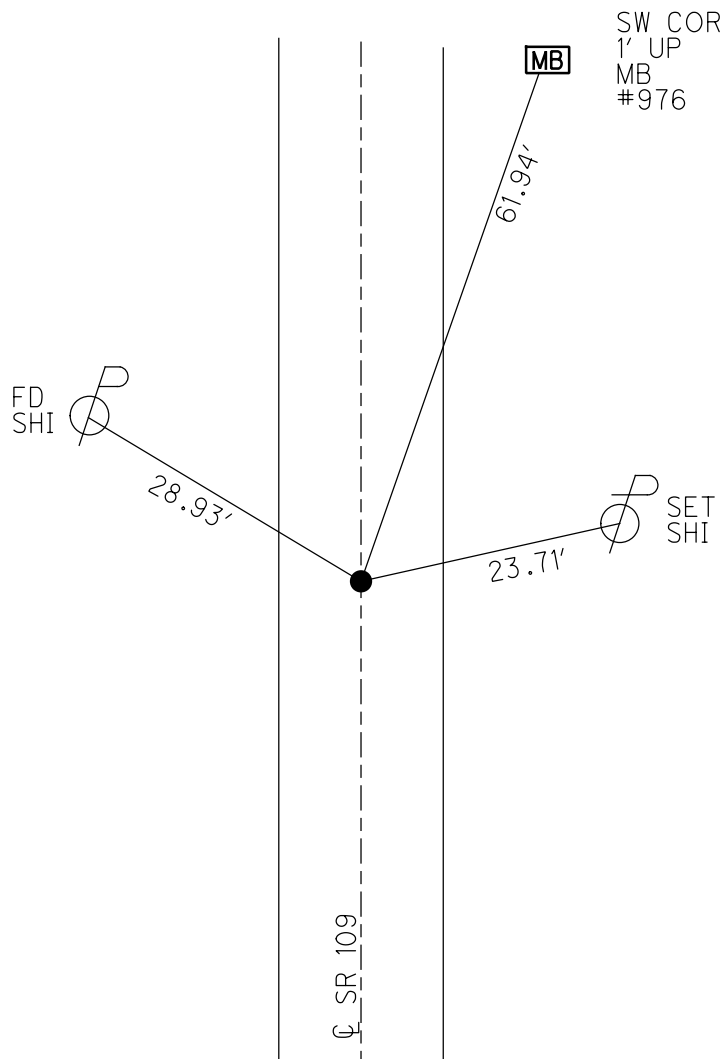

O.D.O.T. DISTRICT 2 SURVEY OFFICE

PERSONNEL

REFERENCE NO. 51H

SHEET 26 OF 27

NOTES HOMAN

DATE 9-9-02

ROUTE S.R. 109

H.C. HOMAN

WEATHER SUNNY

COUNTY HENRY

R.C. BROWN

TEMP. 81

TOWNSHIP LIBERTY

SECTION 13

T 6 N R 7 E


TYPE MONUMENT PK & WASHER

ON SURFACE - ~~BELOW~~ ON


LEFT - ~~Q PAV'T~~ - RIGHT 0.4'

10' TO LT EDGE PAVEMENT

S.L.M. 1259+80

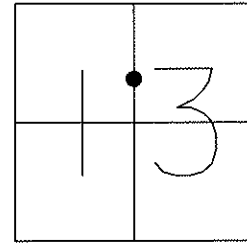

SET MAG NAIL
& WASHER
12-11-02
DCH

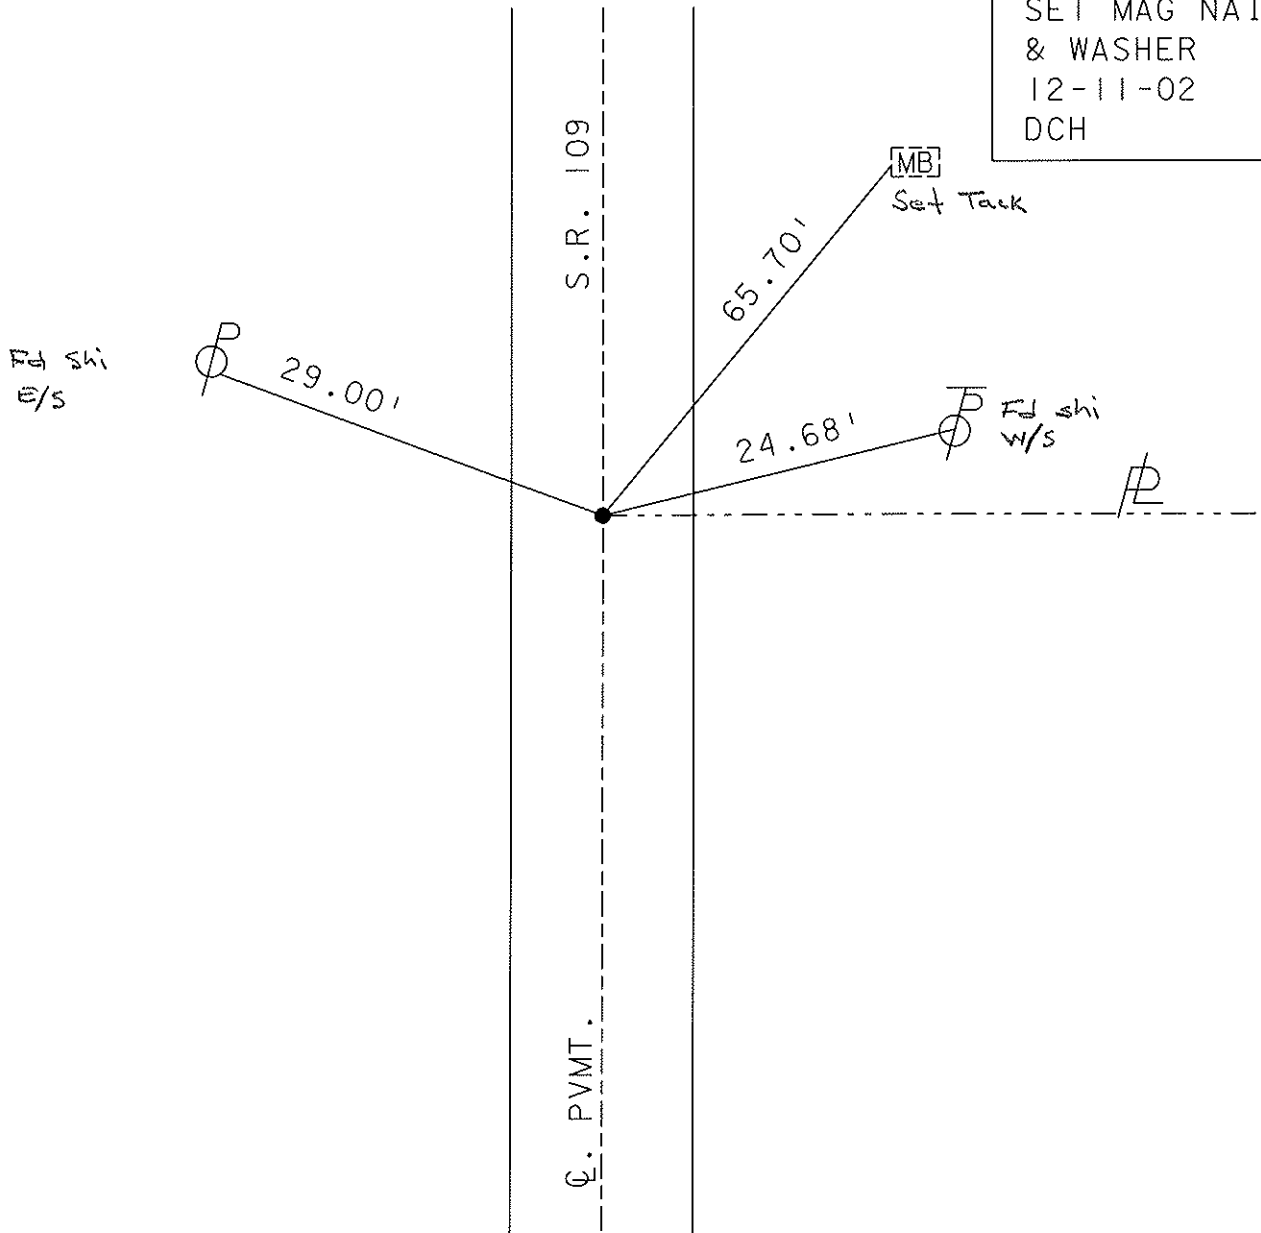

O.D.O.T. DISTRICT 2 SURVEY OFFICE

PERSONNEL _____

REFERENCE NO. 51-H SHEET _____ OF _____

NOTES VAN DUSEN

H.C. BARNHISEL

R.C. KOZL

DATE 8-12-92

WEATHER CLEAR

TEMP. +75 F

ROUTE SR 109

COUNTY HENRY

TOWNSHIP LIBERTY

SECTION 13

T 4 N R 7 E


TYPE MONUMENT PK & WASHER

ON SURFACE - ~~BELOW~~ YES

LEFT- & PAV'T. - RIGHT 0.4'


10.1 TO LT. EDGE PAVEMENT

S.L.M. 1259+80

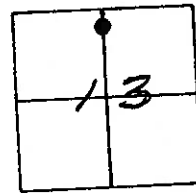

RECORD
NOTE: FOUND R.R. SPK. 1 1/2" BELOW SURFACE 0.40' WEST OF &
11-17-81 NOT SET BY ODOT

SET PK & WASHER
9-28-92
M.B

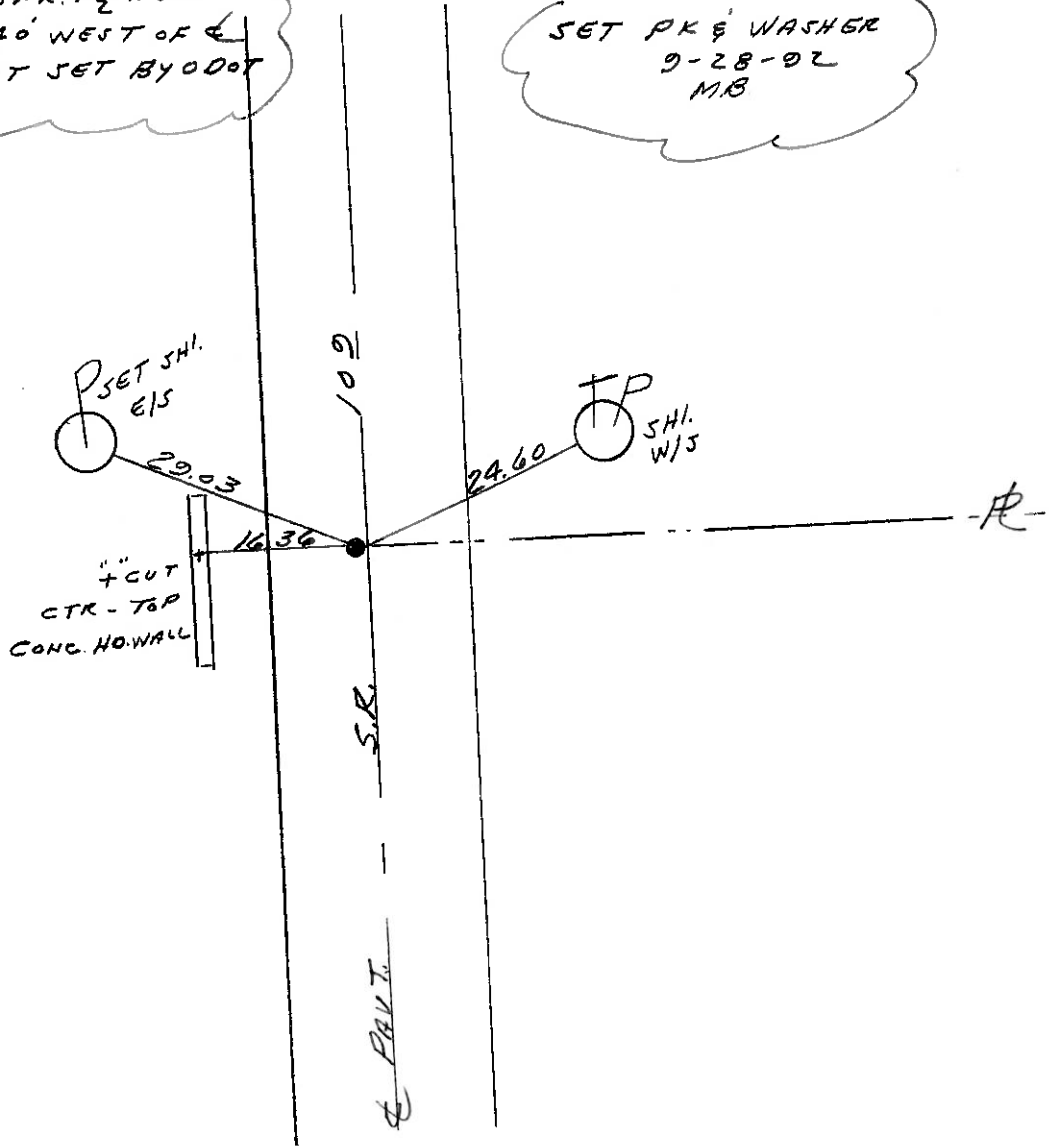

Q.D.O.T. DISTRICT 2 SURVEY OFFICE

SHEET _____ OF _____

County Henry S.R. 109

Date 11-17-81

Township Liberty

Weather OVERCAST

Section 13

Temp. +40°


T₆N, R₇E

Personnel W.F.F. mad

Householder

Loehrke

51-H

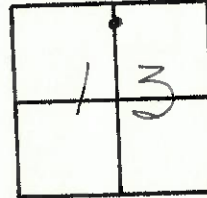

Fd. R.R. SPK 1 1/2" Below Surface

Project STA ± 1260 ± 01

0.40 west of ϕ

Not set by ODOT

RE-SET P.K./WASHER
5-18-82
S.W.H.

