


O.D.O.T. DISTRICT 2 SURVEY OFFICE (USE ONLY)


PERSONNEL	REFERENCE NO. <u>2</u>	SHEET <u>3</u> OF <u>51</u>
NOTES <u>MILLER</u>	DATE <u>12/19/23</u>	ROUTE <u>SR 110</u>
H.C. <u>AUBLE</u>	WEATHER <u>CLEAR</u>	COUNTY <u>HENRY</u>
R.C. <u>RHOADES</u>	TEMP. <u>27°</u>	TOWNSHIP <u>HARRISON</u>
<u>ASTON</u>		SECTION <u>18</u>
DWG BY <u>RHOADES</u>	PID <u>94321</u>	T <u>5</u> N R <u>7</u> E

TYPE MONUMENT MAG/WASHER
 ON SURFACE - ~~BELOW~~ ON
 OFFSET \odot PAVEMENT 0.5' ~~RT~~ : RT
13.8' TO RT EDGE PAVEMENT
 STATION: 38+48

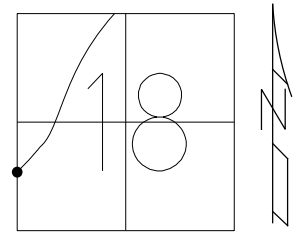

HORIZ.DATUM: NAD83 2011 GEOID: NAVD88 2018
 GRID: NORTHING: 631896.053 EASTING: 1525486.661

RECORD: P.I.
 STA.43+72.30
 $\Delta = 8^{\circ} 45' \text{ LT}$
 SET MAG/WASHER
 12-15-06, RGN
 FD MAG/WASHER
 REF2
 1-29-16, JLL
 FD MAG/WASHER
 REF2
 8/18/23, TDN
 SET MAG/WASHER
 12/9/23, DSA

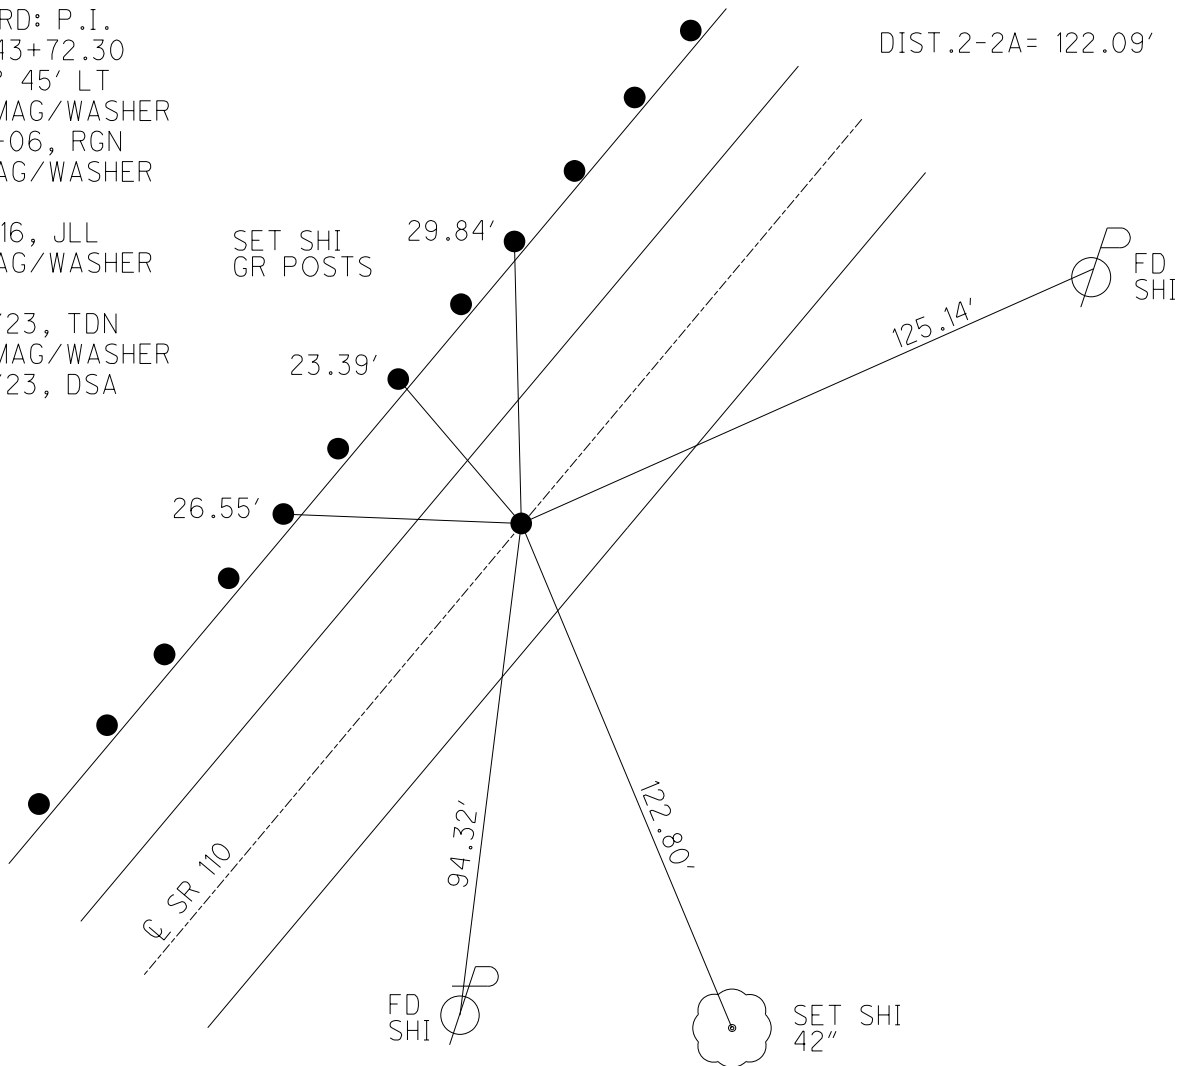

O.D.O.T. DISTRICT 2 SURVEY OFFICE (USE ONLY)

PERSONNEL

REFERENCE NO. 2

SHEET 3 OF 44

NOTES ASTON
 H.C. NIESE
 R.C. RHOADES
AUBLE

DATE 8/18/23
 WEATHER CLEAR
 TEMP. 75°

ROUTE SR 110
 COUNTY HENRY
 TOWNSHIP HARRISON
 SECTION 18

DWG BY RHOADES PID 94321

T 5 N R 7 E

TYPE MONUMENT MAG/WASHER

ON SURFACE - ~~BELOW~~ ON

OFFSET 0.5' RT : RT

13.8' TO RT EDGE PAVEMENT



STATION: 38+48

HORIZ.DATUM: NAD83 2011


GEOID: NAVD88 2018

GRID: NORTHING: 631896.106

EASTING: 1525486.743

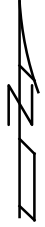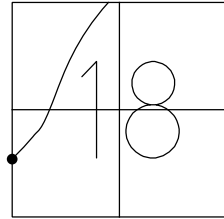


RECORD: P.I.
 43+72.30
 SET MAG/WASHER
 12-15-06, RGN
 FD MAG/WASHER
 REF2
 1-29-16, JLL
 FD MAG/WASHER
 REF2
 8/18/23, TDN

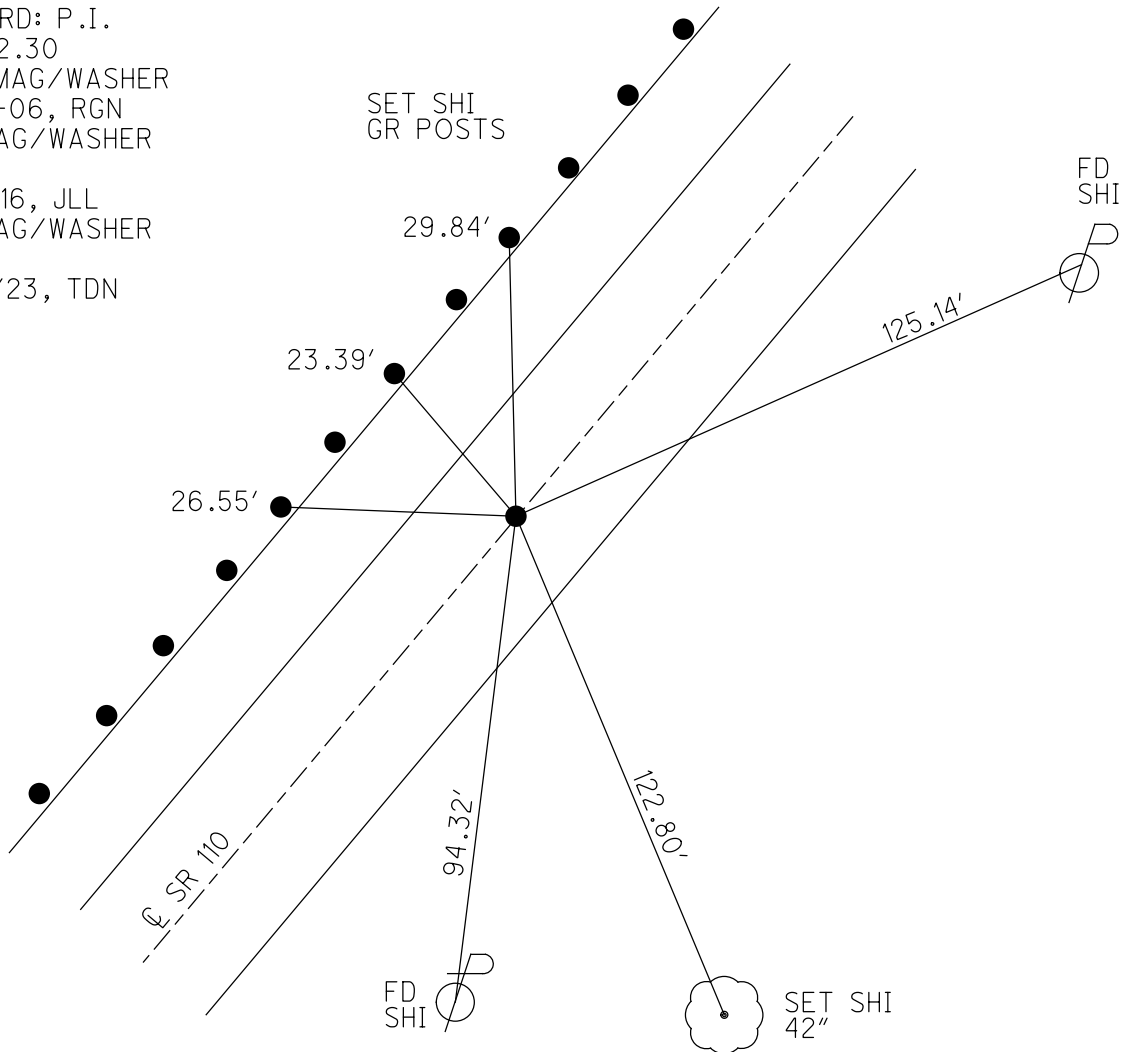

O.D.O.T. DISTRICT 2 SURVEY OFFICE

PERSONNEL _____ REFERENCE NO. 2 SHEET 2 OF 6
 NOTES LEU DATE 08/24/16 ROUTE SR 110
 H.C. HOMAN WEATHER CLEAR COUNTY HENRY
 R.C. LEU TEMP. 71° TOWNSHIP HARRISON
 _____ SECTION 18
 _____ T 5 N R 7 E

TYPE MONUMENT _____ MAG/W _____
 ON SURFACE - ~~BELOW~~ _____ ON _____
~~LEFT - C PAV'T - RIGHT~~ _____ 0.5' _____
13.8 TO RT ~~EDGE PAVEMENT~~ TO CURB _____
 S.L.M. _____ 38+48 _____
 GRID: NORTHING: 631896.053 EASTING: 1525486.661

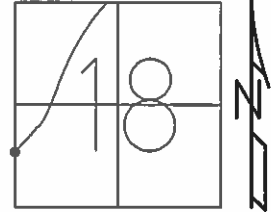


RECORD PI
43+72.30

 SET MAG/WASHER
12-15-06
RGN

 FD MAG/W
GPS, REF2
1-29-16, JLL

 GPS, NEWREF2

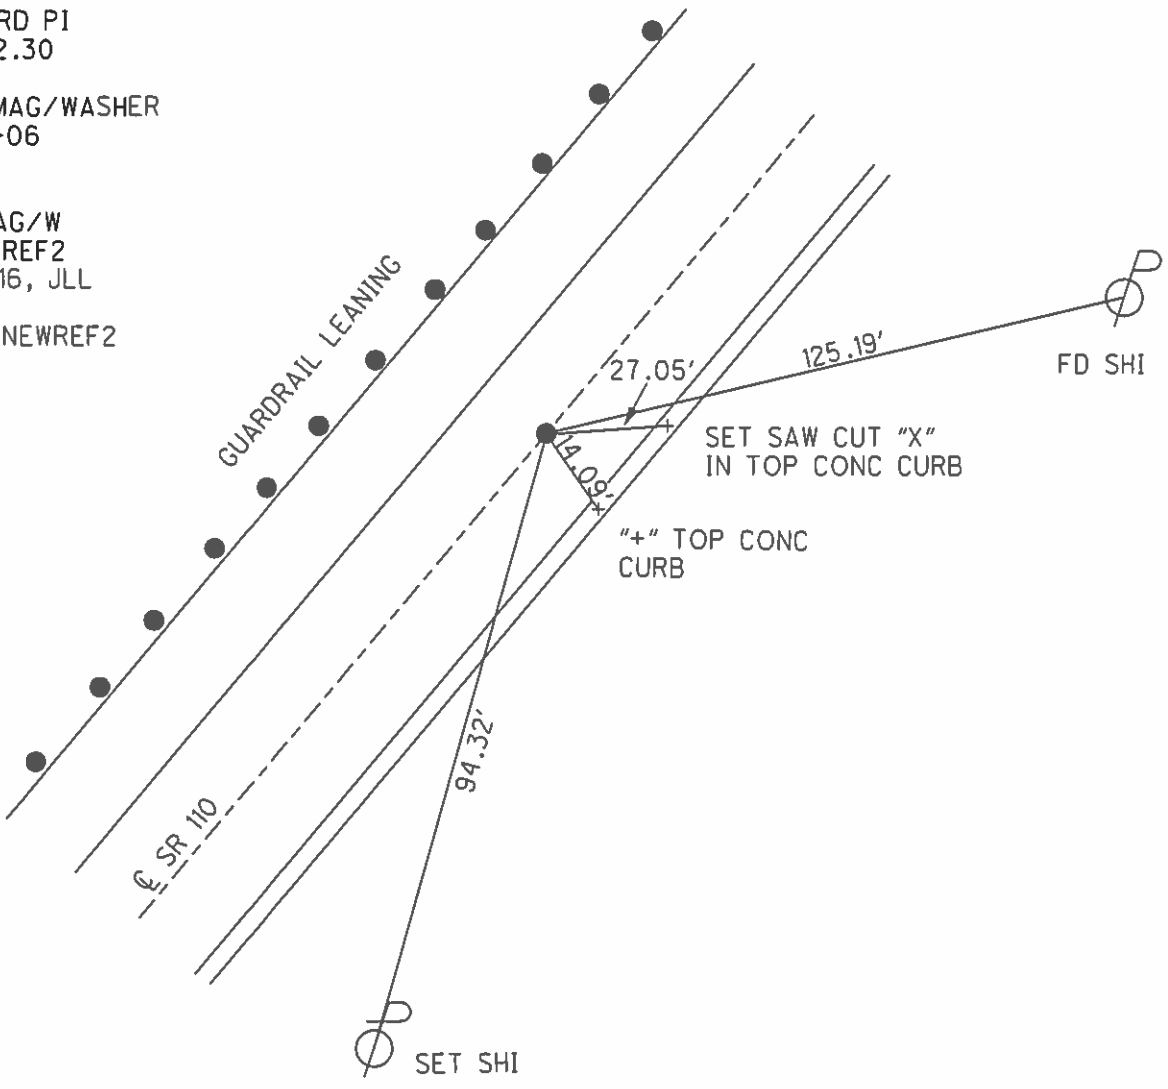

O.D.O.T. DISTRICT 2 SURVEY OFFICE

PERSONNEL

REFERENCE NO. 2

SHEET 2 OF 7

NOTES BARNHISEL

DATE 9/14/06

ROUTE S.R. 110

H.C. CANTERBURY

WEATHER CLEAR

COUNTY HENRY

R.C. BARNHISEL

TEMP. +75

TOWNSHIP HARRISON

SECTION 18

T 5 N R 7 E



TYPE MONUMENT SM RR SPIKE

ON SURFACE ~~-BELOW-~~ 1"

~~LEFT - Q~~ PAV'T ~~-RIGHT-~~ YES


13.8 TO RT ~~EDGE PAVEMENT~~ TO CURB

S.L.M. 38+48

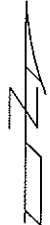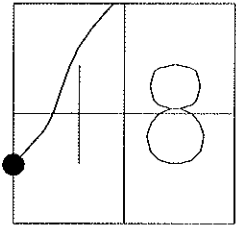

RECORD P.I.
43+72.30

SET MAG/WASHER
12-15-06
RGN

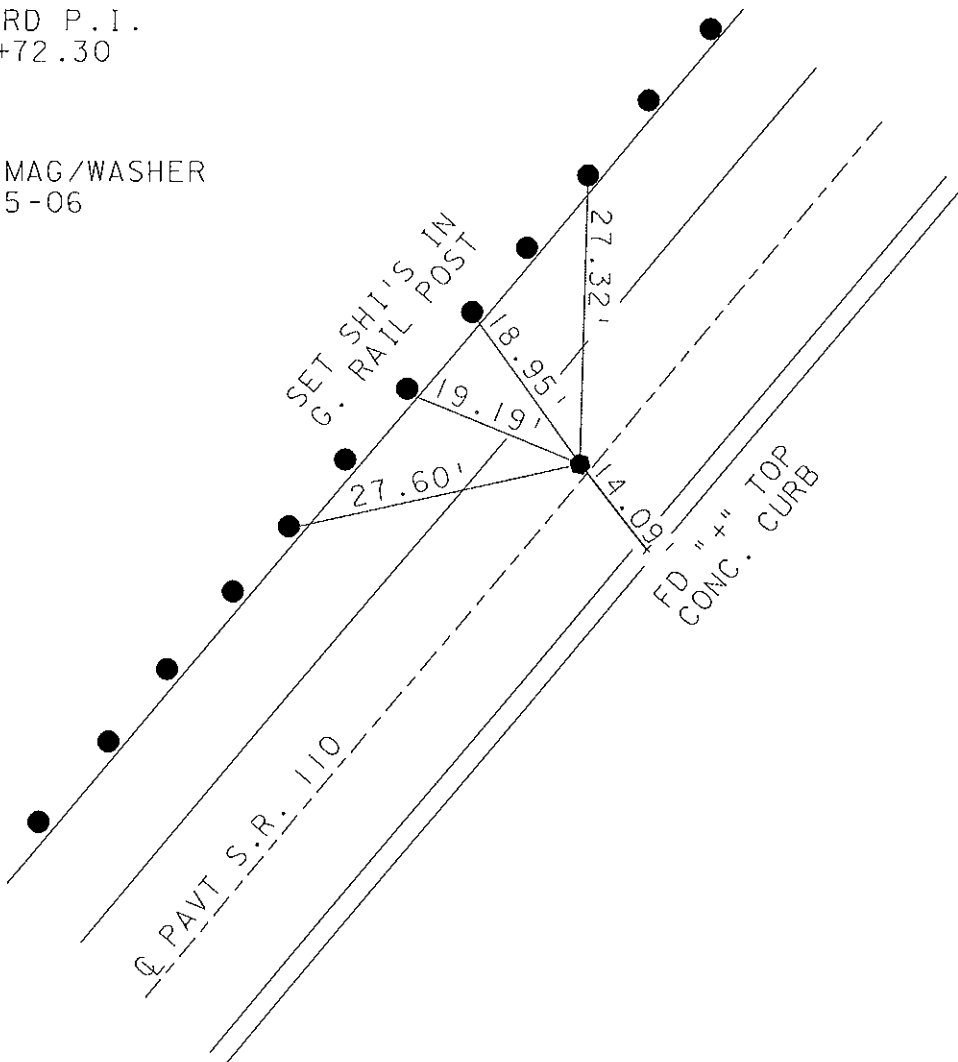

O.D.O.T. DISTRICT 2 SURVEY OFFICE

PERSONNEL

REFERENCE NO. 2

SHEET 3 OF 34

NOTES LOEHRKE MB

H.C. CURTIS MC

R.C. ROMETO MB

DATE 9/14/06

DATE 5-27-92

WEATHER CLEAR ✓

TEMP. +60 +75

ROUTE S.R. 110

COUNTY HENRY

TOWNSHIP HARRISON

SECTION 18

T5 N R 7 E

TYPE MONUMENT Sm. R.R. Spike ✓


ON SURFACE - BELOW Yes 1"

LEFT - C PAV'T. - RIGHT Yes ✓

~~13.8 TO RT~~ EDGE PAVEMENT to Curb ✓


S.L.M. 38+48 ✓

Set P.K./WASHER
10-27-92

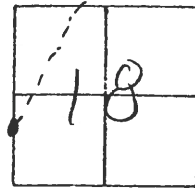

REC. P.I.
Sta. 43+72.30

Set Mag Washer
12-15-06
RGL

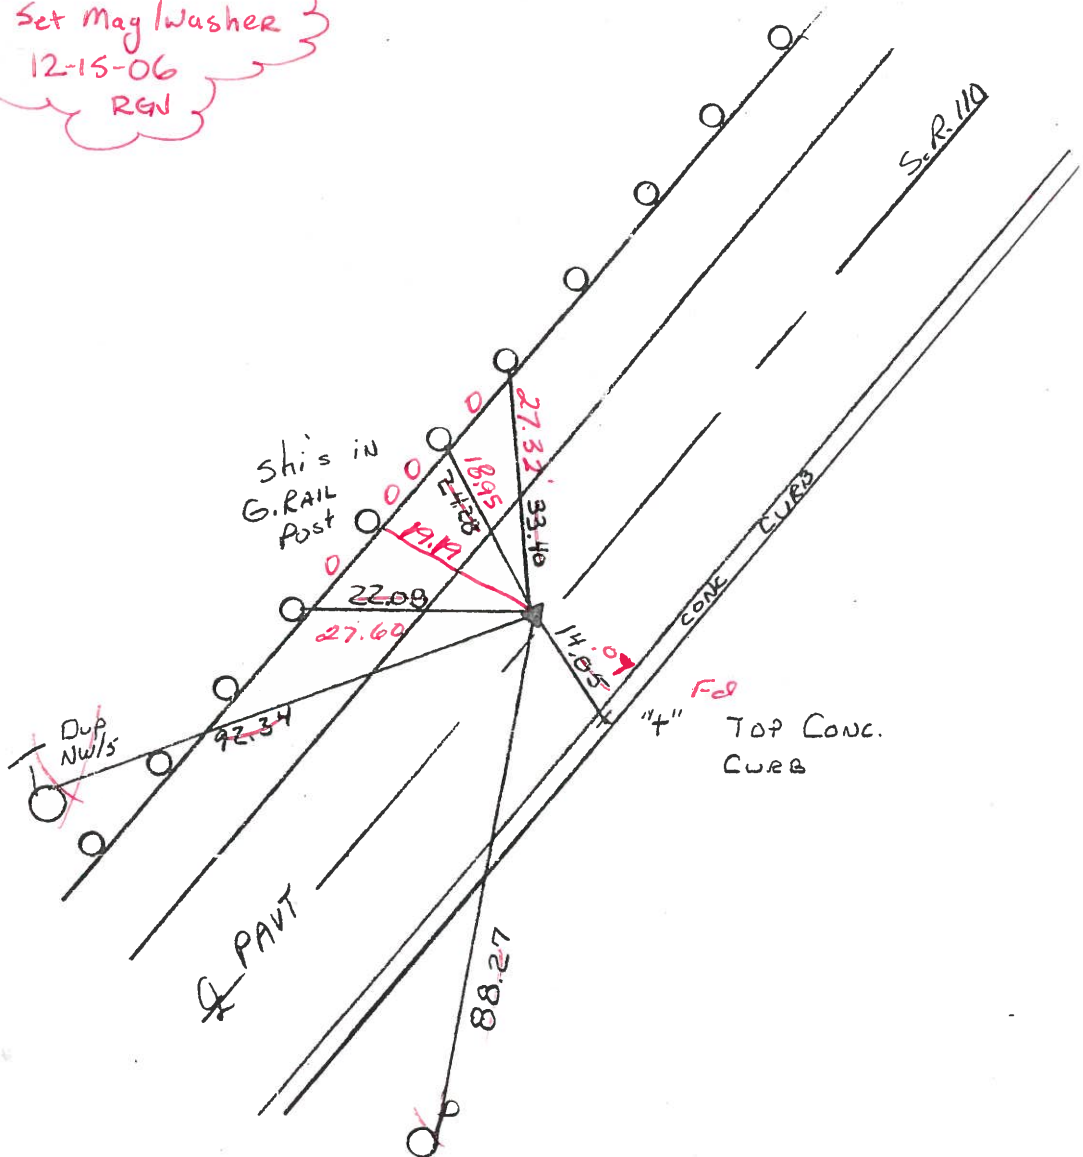

O.D.O.T. DISTRICT 2 SURVEY OFFICE

PERSONNEL

REFERENCE NO. 2

SHEET 3 OF 34

NOTES LOEHRKE

H.C. CURTIS

R.C. ROMETO

DATE 5-27-92

WEATHER CLEAR

TEMP. +60

ROUTE S.R. 110

COUNTY HENRY

TOWNSHIP HARRISON

SECTION 18

T 5 N R 7 E

Set P.K./WASHER
10-27-92


TYPE MONUMENT Sm. R.R. Spike

ON SURFACE - BELOW Yes


~~LEFT~~ - PAV'T. - RIGHT Yes

13.8 TO Rt EDGE PAVEMENT to Curb

S.L.M. 38+48

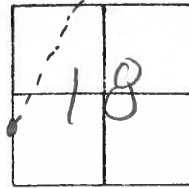

Rec. P.I.
Sta. 43+72.30

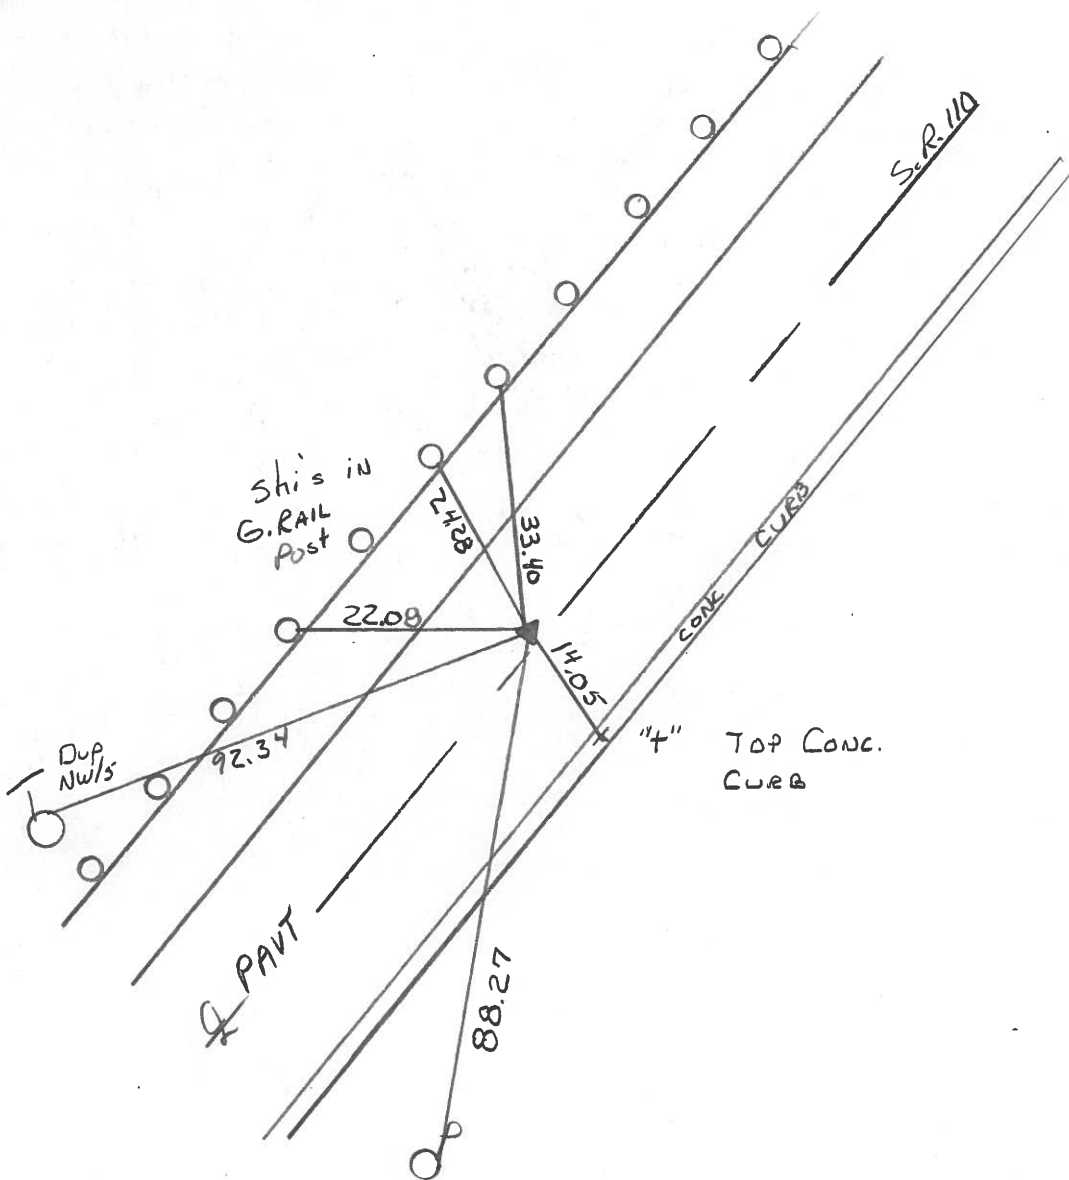

OD.O.T. DISTRICT 2 SURVEY OFFICE

SHEET _____ OF _____

County HENRY S.R. 110

Date 1-5-84

Township HARRISON

Weather CLOUDY, DAMP

Section 18

Temp. +34


T5N, R7E

Personnel BARNHISEL

HOUSEHOLDER

LOHRKE

#2

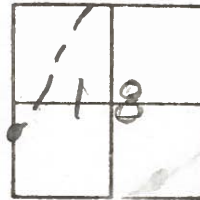

Fd $\frac{3}{4}$ " PIPE 1" Below SURFACE
13.8 to FACE OF CURB, EAST
12.4 to WEP
ON $\frac{1}{4}$ of SR110

SET SMALL P.R. SPK.
6/13/84
M.D.B.

SLM 38+56

P.I. STA. 43+72.30
& SURVEY

