

O.D.O.T. DISTRICT 2 SURVEY OFFICE (USE ONLY)

PERSONNEL

REFERENCE NO. 4 AF

SHEET 14 OF 51

NOTES AUBLE

DATE 4/27/23

ROUTE INDUSTRIAL DR.

H.C. _____

WEATHER FAIR

COUNTY HENRY

R.C. _____

TEMP. 29°

TOWNSHIP LIBERTY

DWG BY RHOADES PID 22984

SECTION 7

T 5 N R 7 E

TYPE MONUMENT MONBOX W/ 1" IPIN

ON SURFACE - ~~BELOW~~ ON

OFFSET ☉ PAVEMENT - _____ LT : RT

- _____ TO - _____ EDGE PAVEMENT

STATION: 50+77.68


HORZ.DATUM: NAD83 2011

GEOID: NAVD88 2009


GRID: NORTHING: 637770.900

EASTING: 1528285.484

NOTE: PAF=
1.0000675074

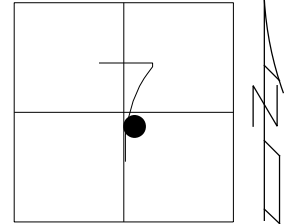

RECORD: P.C.
STA.50+77.68
FD MONBOX
W/ 1" IPIN
4/27/23, DSA

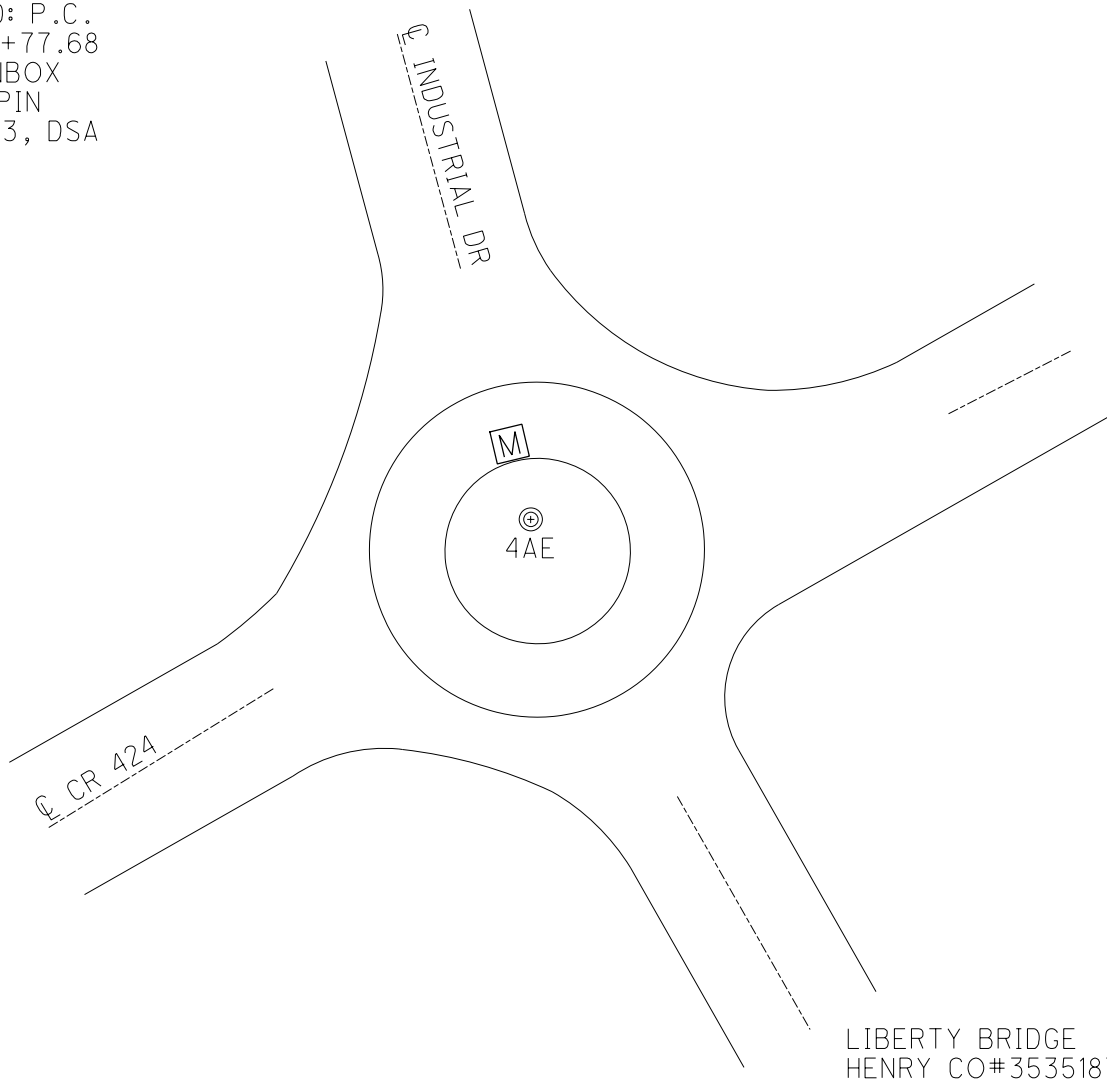

LIBERTY BRIDGE
HENRY CO#3535187