

O.D.O.T. DISTRICT 2 SURVEY OFFICE (USE ONLY)


PERSONNEL \_\_\_\_\_ REFERENCE NO. 4 AB SHEET 10 OF 51  
 NOTES NIESE DATE 3/15/24 ROUTE SR 110  
 H.C. NIESE WEATHER BREEZY COUNTY HENRY  
 R.C. ASTON TEMP. 54° TOWNSHIP HARRISON  
 DWG BY RHOADES PID 94321 SECTION 7  
 T 5 N R 7 E

TYPE MONUMENT MONBOX W/ 1" IPIN  
 ON SURFACE - ~~BELOW~~ ON  
 OFFSET  $\odot$  PAVEMENT - LT : RT  
- TO - EDGE PAVEMENT


STATION: 106+40.00, INDUSTRIAL DR. STA= 31+42.43

HORZ. DATUM: NAD83 2011 GEOID: NAVD88 2018

GRID: NORTHING: 636344.117 EASTING: 1529505.215

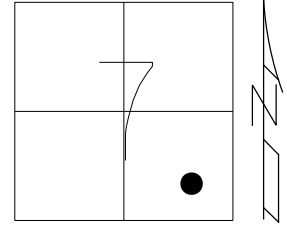

RECORD: P.I.  
 STA. 106+40  
 FD MONBOX  
 W/ 1" IPIN  
 4/27/23, DSA  
 FD MONBOX  
 W/ 1" IPIN  
 NEWREF4A  
 3/15/24, TDN

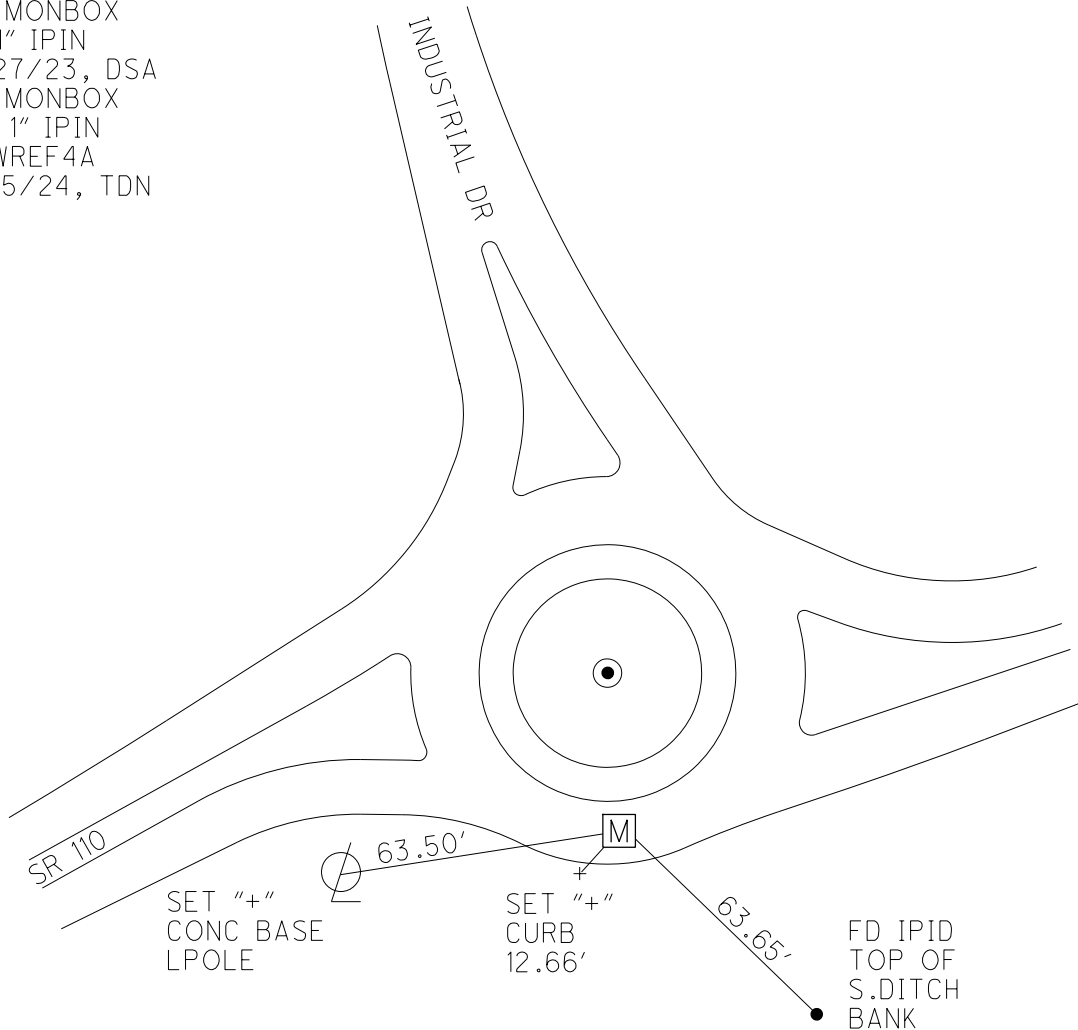

O.D.O.T. DISTRICT 2 SURVEY OFFICE (USE ONLY)

PERSONNEL

REFERENCE NO. 4 AB

SHEET 10 OF 51

NOTES AUBLE

DATE 4/27/23

ROUTE SR 110

H.C. \_\_\_\_\_

WEATHER FAIR

COUNTY HENRY

R.C. \_\_\_\_\_

TEMP. 29°

TOWNSHIP HARRISON

SECTION 7

DWG BY RHOADES

PID 22984

T 5 N R 7 E

TYPE MONUMENT MONBOX W/ 1" IPIN

ON SURFACE - ~~BELOW~~ ON

OFFSET  $\text{C}$  PAVEMENT - \_\_\_\_\_ LT : RT

- \_\_\_\_\_ TO \_\_\_\_\_ EDGE PAVEMENT


STATION: 106+40.00, INDUSTRIAL DR. STA= 31+42.43

HORIZ. DATUM: NAD83 2011

GEOID: NAVD88 2009


GRID: NORTHING: 636387.081

EASTING: 1529608.499

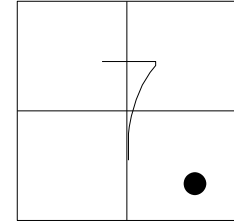


NOTE: PAF=  
1.0000675074

RECORD: P.I.  
STA.106+40  
FD MONBOX  
W/1" IPIN  
4/27/23, DSA

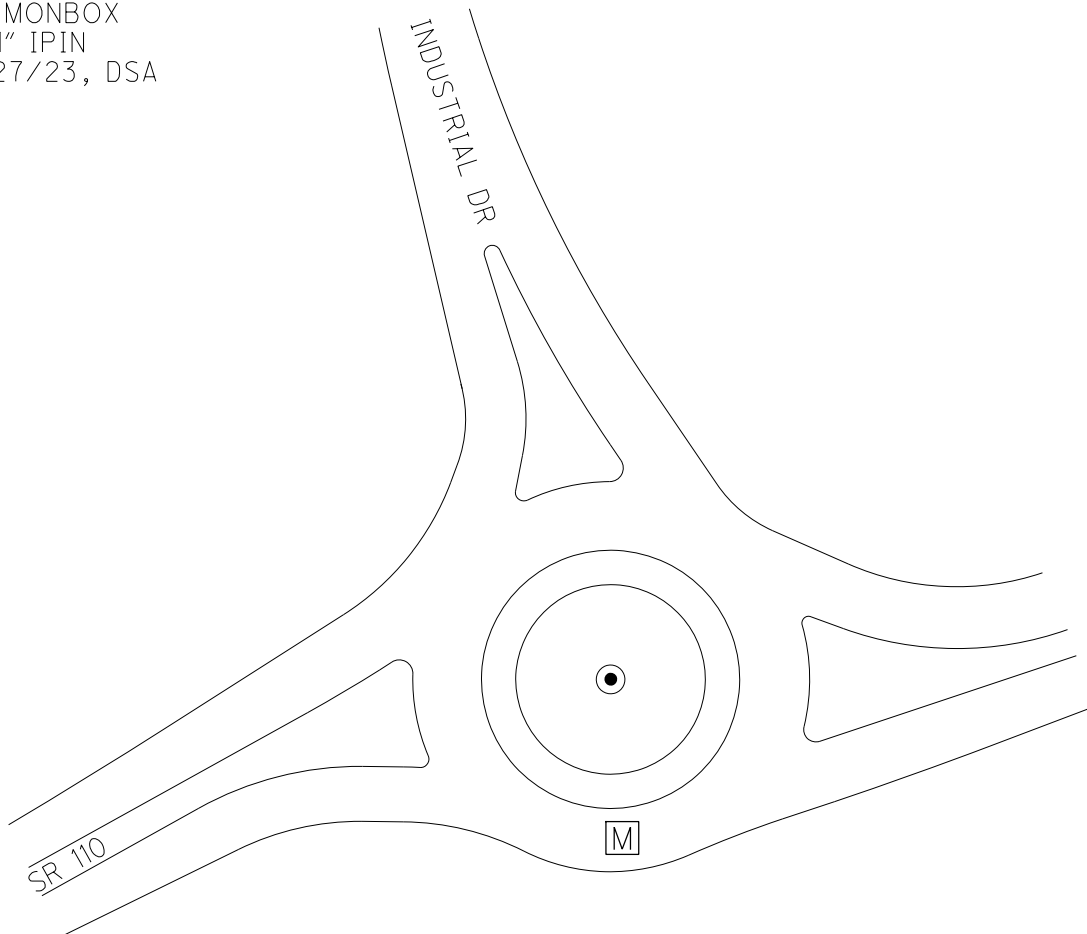

PERSONNEL Red Beach TITLE \_\_\_\_\_ PERSONNEL Newcomb TITLE \_\_\_\_\_ COUNTY He. DATE Sept. 1972  
 PERSONNEL Knape TITLE \_\_\_\_\_ S. R. 110 WEATHER \_\_\_\_\_  
 DESCRIPTION \_\_\_\_\_ SEC. 8-Harrison Twp. TEMP. \_\_\_\_\_

CONTROL POINTS

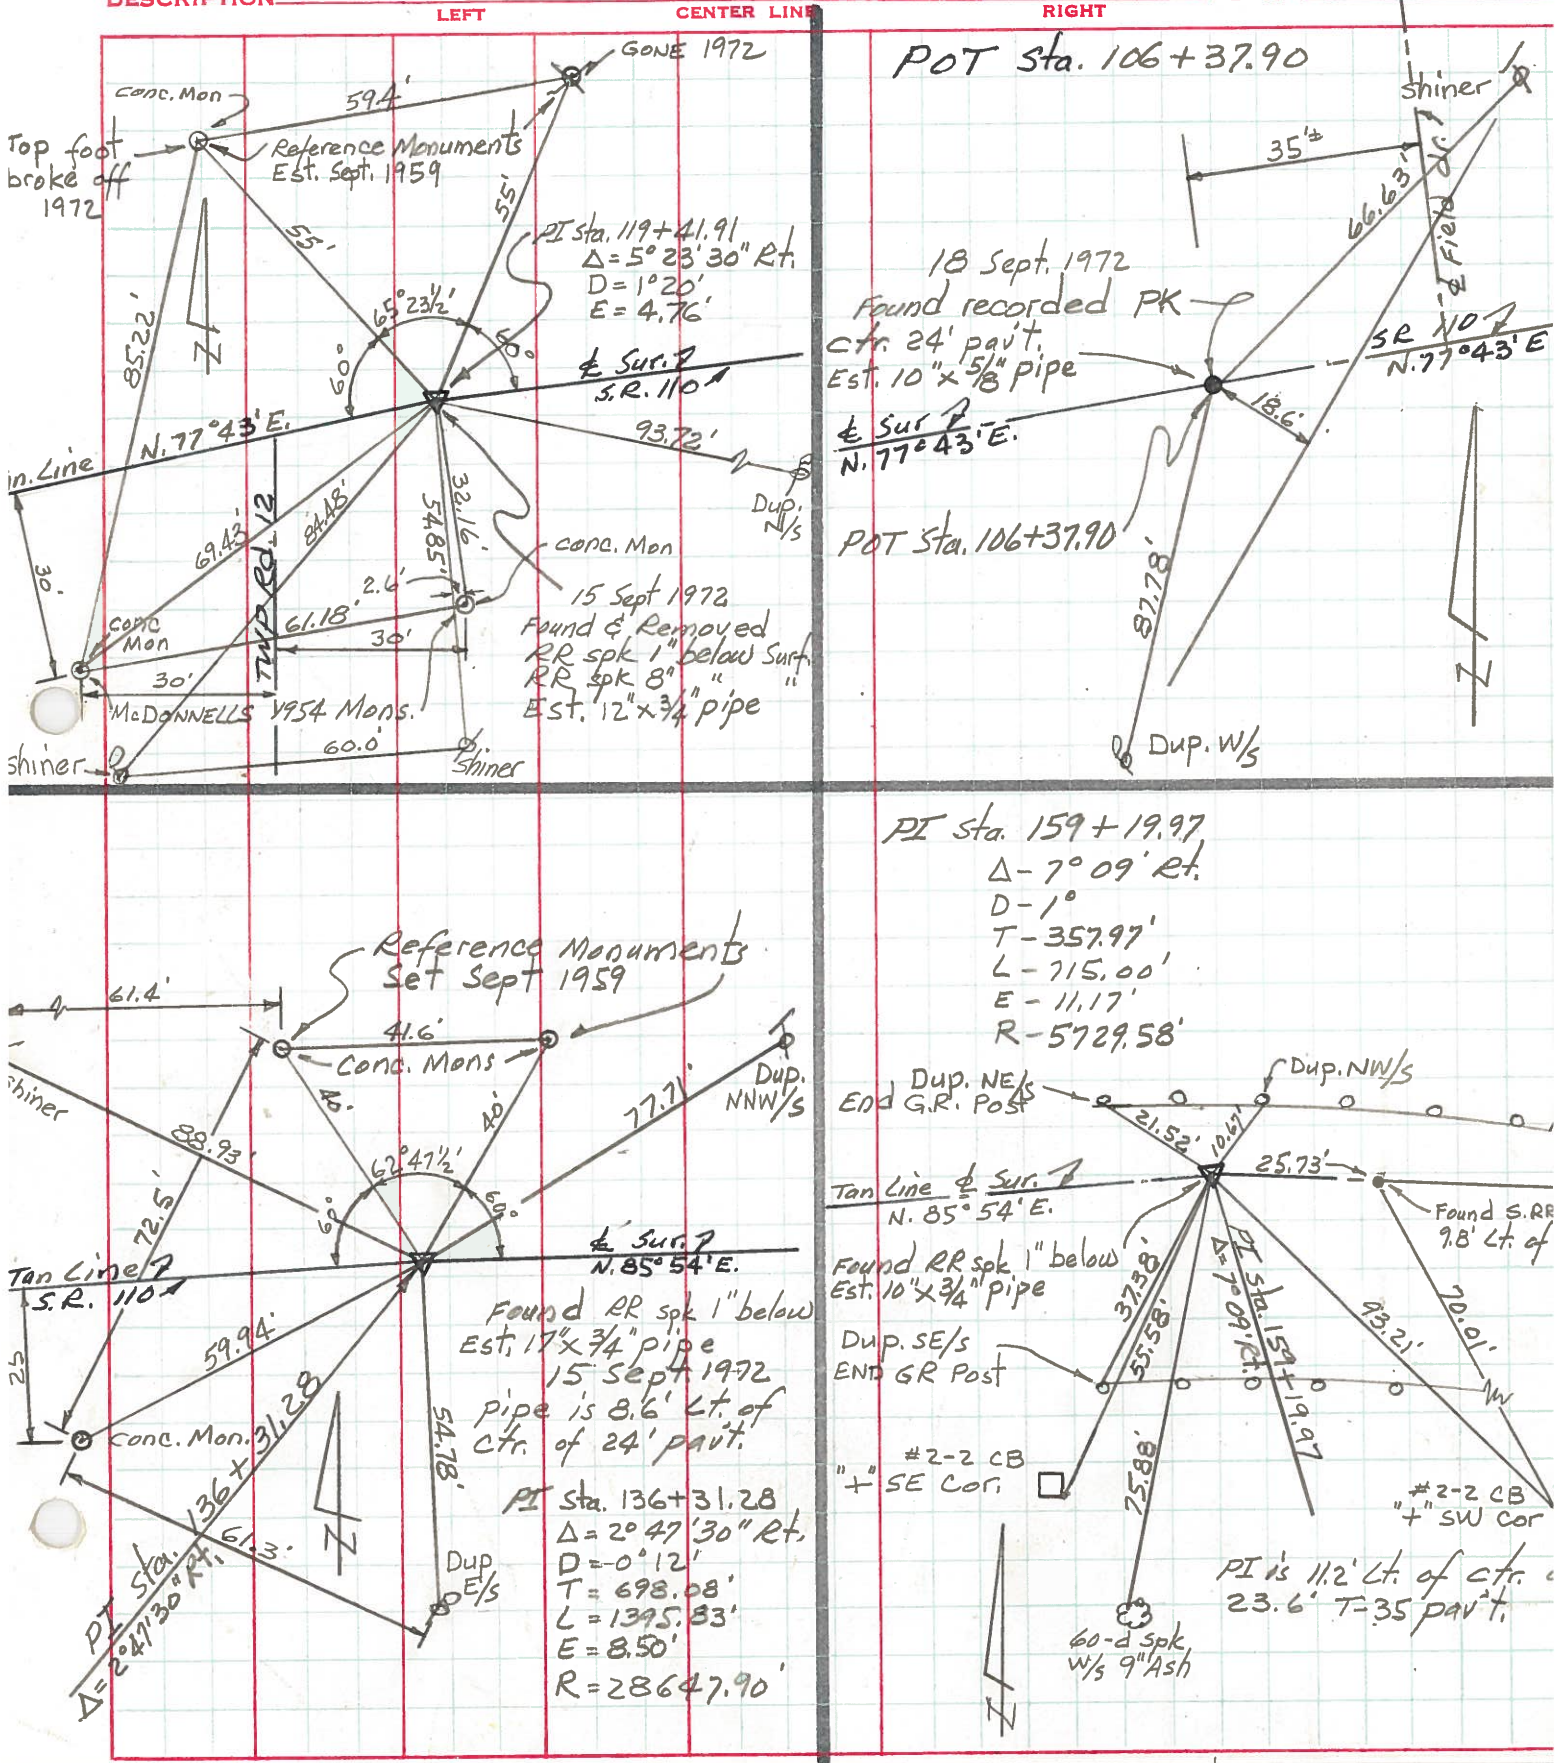

PERSONNEL	TITLE	PERSONNEL	TITLE	COUNTY	DATE
Beach		Hoff		Henry	Dec. 1957
Armbuster		Harris		S. R. 110	WEATHER
Ruffner		Ruchener		SEC. 2.22	TEMP.
Koeppe		Delvaithal			

DESCRIPTION \_\_\_\_\_ CONTROL POINTS 1 JOB NO. \_\_\_\_\_

