

O.D.O.T. DISTRICT 2 SURVEY OFFICE (USE ONLY)

PERSONNEL _____ REFERENCE NO. 8 AB SHEET 26 OF 51

NOTES ASTON DATE 3/7/24 ROUTE SR 110

H.C. NIESE WEATHER CLOUDY COUNTY HENRY

R.C. ASTON TEMP. 42° TOWNSHIP HARRISON

SECTION 8

DWG BY RHOADES PID 94321

T 5 N R 7 E

TYPE MONUMENT MAG/WASHER

ON SURFACE - ~~BELOW~~ ON _____



OFFSET \odot PAVEMENT 12.6' LT : ~~RT~~

1.4' TO LT EDGE PAVEMENT

S.L.M. 166+99.24

HORIZ.DATUM: NAD83 (2011) GEOID: NAVD88 2018

GRID: NORTHING: 637021.691 EASTING: 1536015.605

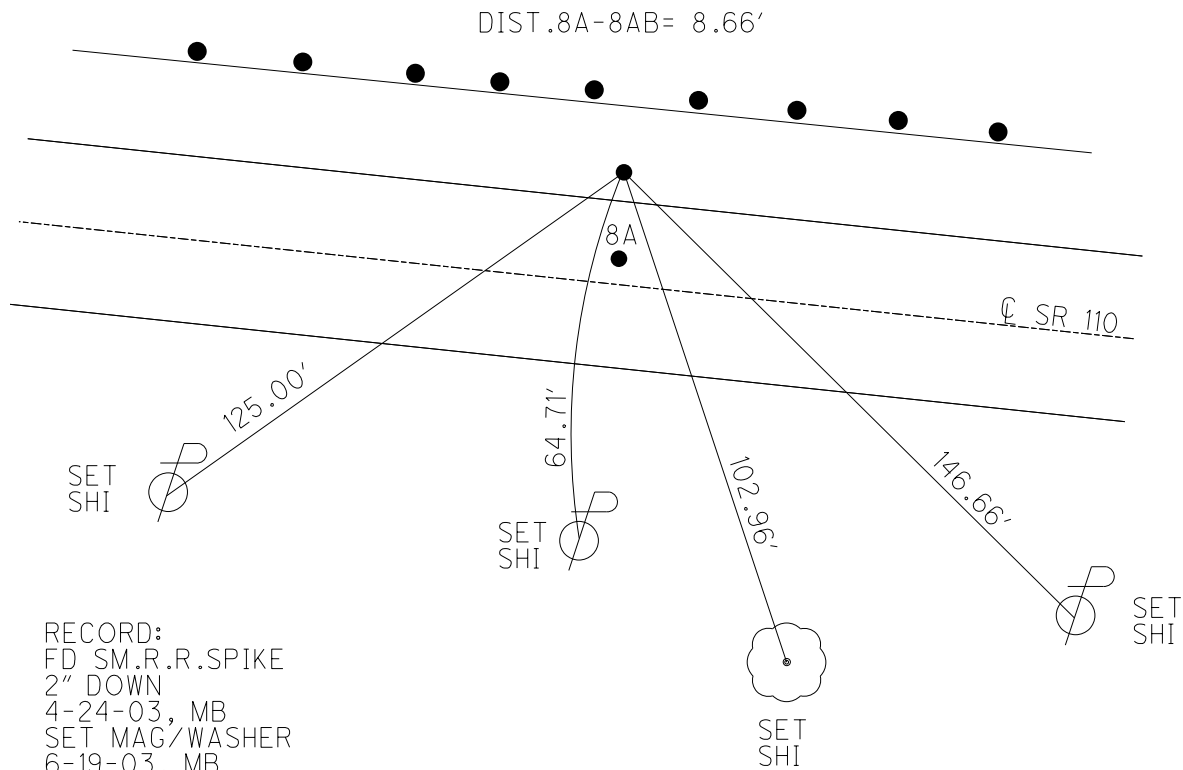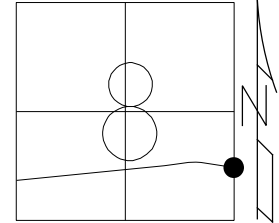

RECORD:
 FD SM.R.R.SPIKE
 2" DOWN
 4-24-03, MB
 SET MAG/WASHER
 6-19-03, MB
 FD MAG/WASHER
 REFAB8
 5-05-21, JFO
 FD MAG SHANK
 REFAB8
 8/18/23, TDN
 SET MAG/WASHER
 3/7/24, TDN

O.D.O.T. DISTRICT 2 SURVEY OFFICE (USE ONLY)

PERSONNEL _____ REFERENCE NO. 8 AB SHEET 19 OF 44

NOTES ASTON DATE 8/18/23 ROUTE SR 110
 H.C. NIESE WEATHER CLEAR COUNTY HENRY
 R.C. RHOADES TEMP. 72° TOWNSHIP HARRISON
AUBLE SECTION 8

DWG BY RHOADES PID 94321 T 5 N R 7 E

TYPE MONUMENT MAG SHANK

ON SURFACE - ~~BELOW~~ ON _____



OFFSET \odot PAVEMENT 12.6' LT : ~~RT~~

1.4' TO LT EDGE PAVEMENT

S.L.M. 166+99.24

HORIZ.DATUM: NAD83 (2011) GEOID: NAVD88 2018

GRID: NORTHING: 637021.691 EASTING: 1536015.605

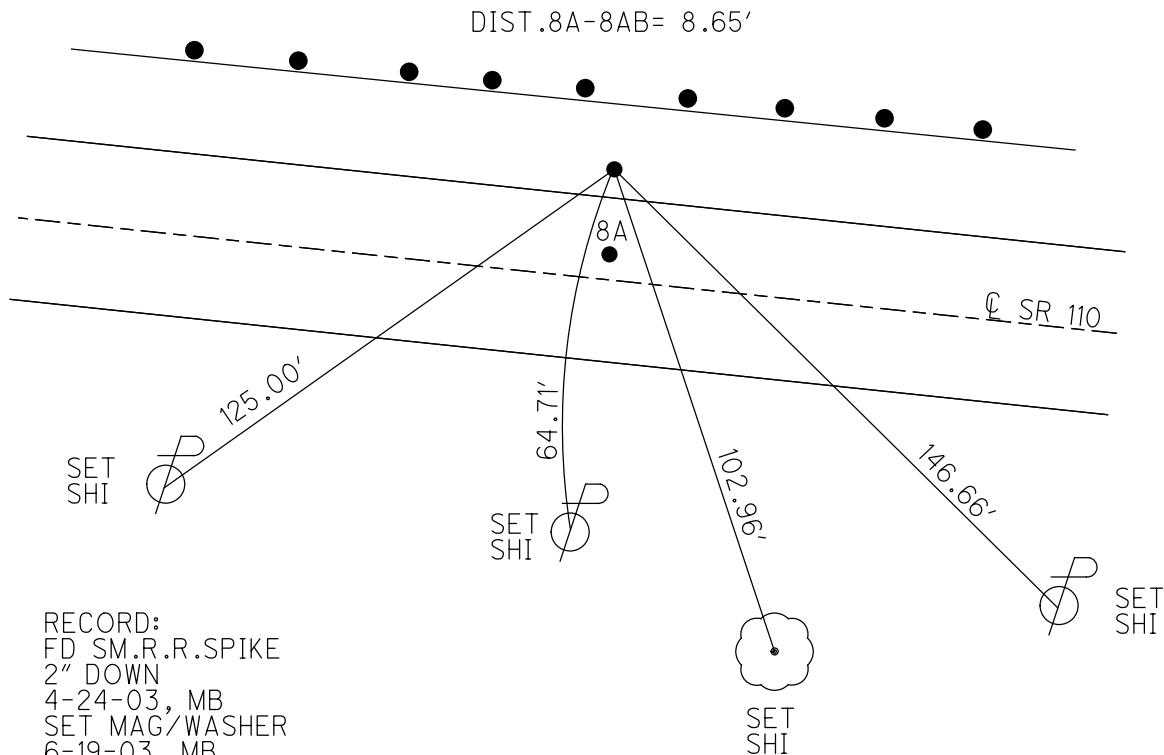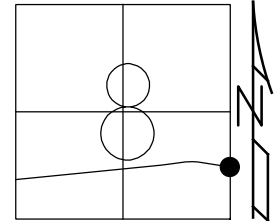

RECORD:
 FD SM.R.R.SPIKE
 2" DOWN
 4-24-03, MB
 SET MAG/WASHER
 6-19-03, MB
 FD MAG/WASHER
 REFAB8
 5-05-21, JFO
 FD MAG SHANK
 REFAB8
 8/18/23, TDN

O.D.O.T. DISTRICT 2 SURVEY OFFICE

PERSONNEL

REFERENCE NO. 8-A

SHEET 4 OF 26

NOTES BARNISEL

DATE 4-24-03

ROUTE S.R. 110

H.C. CANTERBURY

WEATHER PT. CLOUDY

COUNTY HENRY

R.C. BARNISEL

TEMP. +64°

TOWNSHIP HARRISON

GLASS

SECTION 8

T 5 N R 7 E

TYPE MONUMENT


"A" PK/WASHER
"B" SM SPK

ON SURFACE - BELOW "A" SURFACE/"B" 2" DOWN

LEFT - \odot PAV'T A=4.1 B=12.6


"A" 7.2' TO LT. EDGE PAVEMENT "B" 1.4' LT OF LT EDGE

S.L.M. "A"=166+86 "B"=166+85

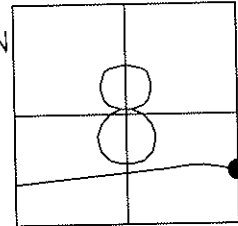

RESET MAG NAILS & WASHERS
6-19-03
MB

RECORD: BOTH POINTS ARE ON N/S 1/2 SEC. LINE

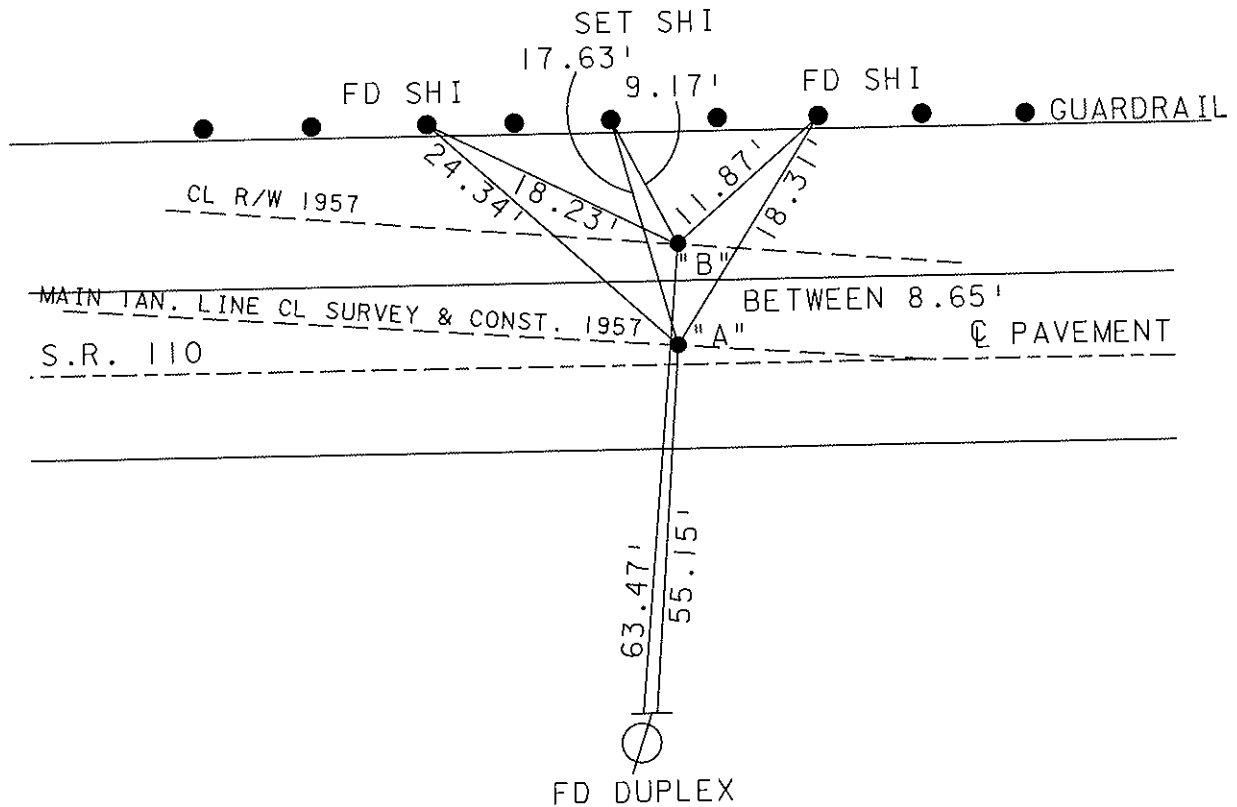

O.D.O.T. DISTRICT 2 SURVEY OFFICE

PERSONNEL

REFERENCE NO. 8A

SHEET 14 OF 34

NOTES LOHRKE

H.C. CURTIS

R.C. ROMETO

DATE 5-27-92

WEATHER Pt Cloudy

TEMP. 64

ROUTE S.R. 110

COUNTY HENRY

TOWNSHIP HARRISON

SECTION 8

Set P.K / WASHERS
10-27-92

T 5 N 7 E


TYPE MONUMENT Sm. R.R. Spikes

ON SURFACE - BELOW Yes


LEFT-OF PAV'T. - RIGHT A=3.4 B=11.8

B=0.5 TO Lt EDGE PAVEMENT

S.L.M. A=166+86 B=166+85

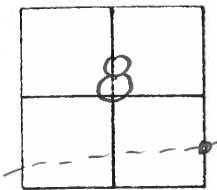

BETWEEN, 8.62

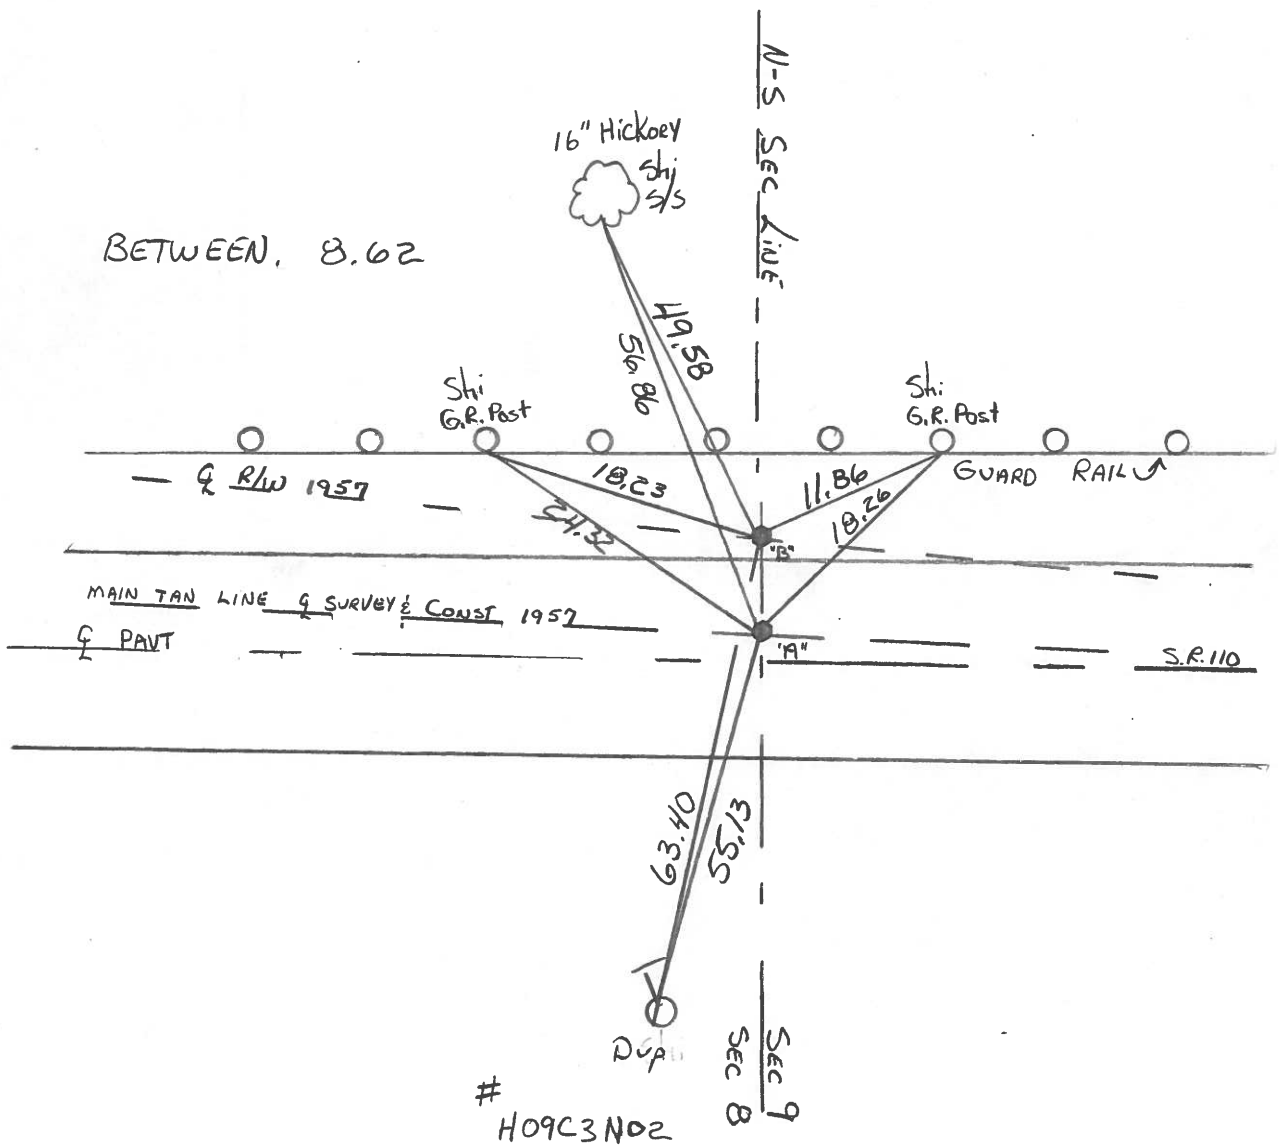

O.D.O.T. DISTRICT 2 SURVEY OFFICE

SHEET _____ OF _____

County WENRY S.R. 110

Date 2-6-84

Township HARRISON

Weather FLURRIES

Section 8

Temp. +20°

T5N, R2E


Personnel BARNHISEL

HOUSEHOLDER

HOFFMAN


LOHRKE

8A

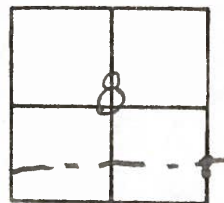

PTA SLM 166+94
 Fd 3/4 PIPE 1" BELOW SURFACE
 3.5 L.F. of PAVT
 7.6 R.F. of LEP
 PT ON MAIN TAN LINE & SURV & CONST. 1957

SET SMALL P.R. SPIKES @ BOTH PTS. 6/13/84 M.D.B.
 (8.58 BETWEEN PT. "A" & "B")
 SLM 166+95
 PTB Fd 3/4 PIPE 1" BELOW SURF
 1.0 L.F. of LEP
 12.0 L.F. of PAVT
 PT IS ON R/W 1957

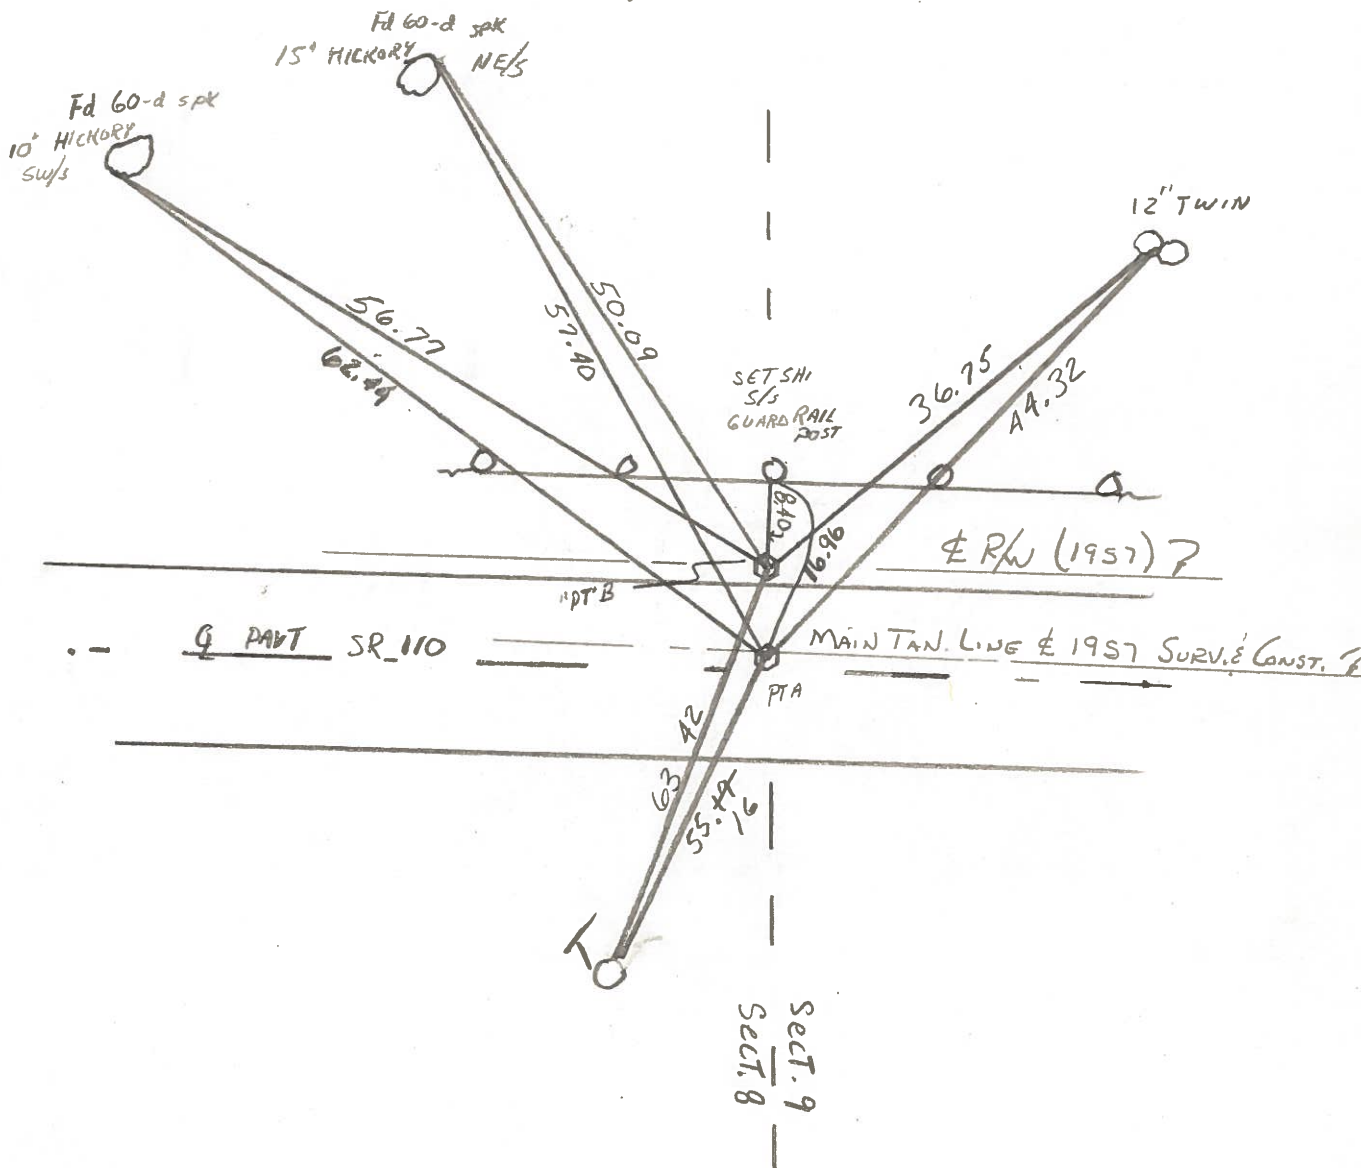

PERSONNEL	TITLE	PERSONNEL	TITLE	COUNTY	DATE
Beach		Hoff		Henry	Dec. 1957
Armbruster	π	Harris		S. R. 110	WEATHER
Rutter		Ruchener		SEC. 2.22	TEMP.
Knape		Delvanthal		ALIGNMENT sheet #3	JOB NO.

DESCRIPTION LEFT CENTER LINE RIGHT

STATION EQUATION
 S.T. STA. 191 + 30.61 BACK
 = STA. 191 + 28.44 AHEAD
 ADD 2.17'

Existing Pav't Survey
 P.I. Sta. 188 + 13.66
 $\Delta = 13^\circ 56' \text{ Lt.}$
 $D = 5^\circ$
 $T = 140.02'$
 $L = 278.67'$


Proposed & Constr.
 P.I. Sta. 187 + 51.53
 $\Delta = 13^\circ 49' 30'' \text{ Lt.}$
 $D = 3^\circ$
 $L_s = 300'$
 $T_s = 381.75'$
 $L_c = 160.83'$

Existing Pav't Survey
 P.I. Sta. 178 + 54.42
 $\Delta = 8^\circ 56' 30'' \text{ Lt.}$
 $D = 3^\circ 12'$
 $T = 140.00'$
 $L = 279.43'$

Proposed & Constr.
 P.I. Sta. 177 + 89.83
 $\Delta = 11^\circ 00' \text{ Lt.}$
 $D = 3^\circ$
 $L_s = 300'$
 $T_s = 334.06'$
 $L_c = 66.67'$

Existing Pav't Survey
 P.I. Sta. 171 + 29.31
 $\Delta = 8^\circ 03' \text{ Lt.}$
 $D = 3^\circ$
 $T = 134.39'$
 $L = 268.33'$

Proposed & Constr.
 P.I. Sta. 170 + 97.23
 $\Delta = 10^\circ 00' \text{ Lt.}$
 $D = 3^\circ$
 $L_s = 300'$
 $T_s = 317.23'$
 $L_c = 33.33'$

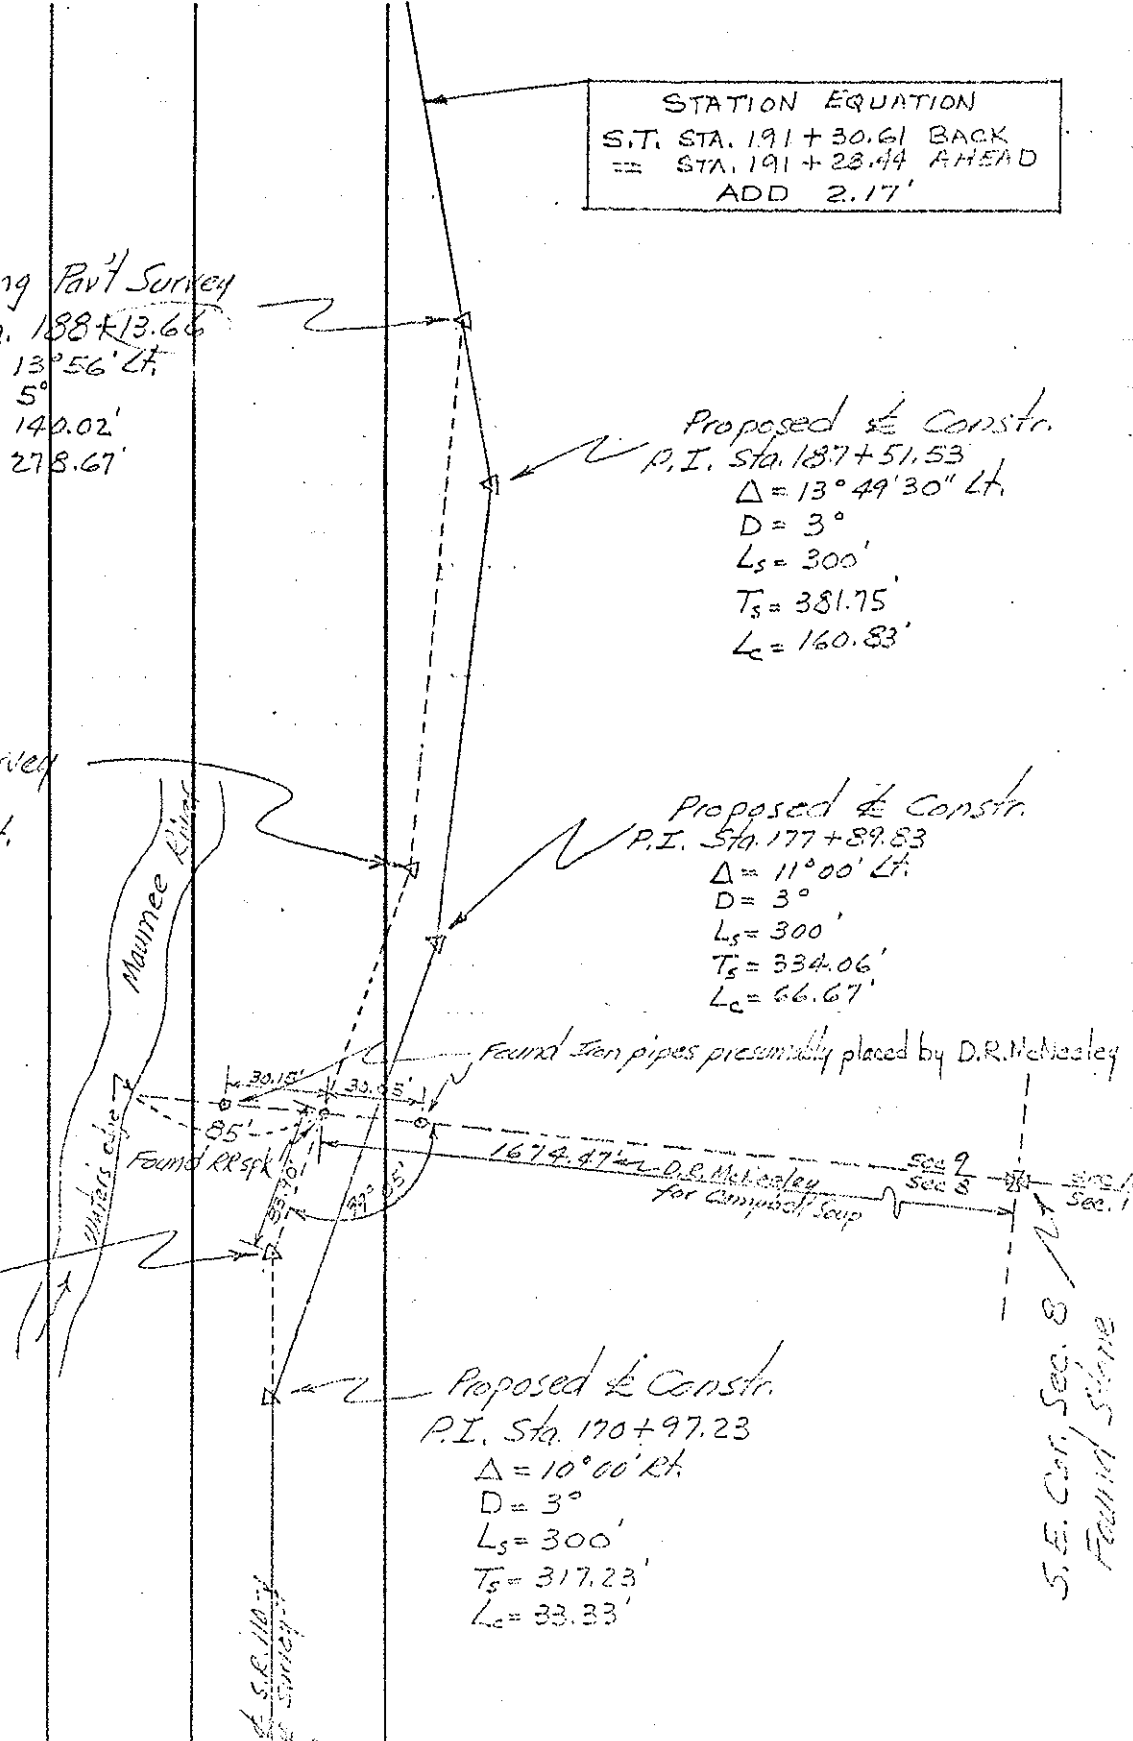

S.E. Cor. Sec. 8
 Found Stone

S.R. 110
 Survey