



O.D.O.T. DISTRICT 2 SURVEY OFFICE (USE ONLY)

PERSONNEL _____ REFERENCE NO. 8 B SHEET 27 OF 51
 NOTES ASTON DATE 3/7/24 ROUTE SR 110
 H.C. NIESE WEATHER CLOUDY COUNTY HENRY
 R.C. ASTON TEMP. 42° TOWNSHIP HARRISON
 SECTION 9
 DWG BY RHOADES PID 94321 T 5 N R 7 E

TYPE MONUMENT MAG/WASHER
 ON SURFACE - ~~BELOW~~ ON _____
 OFFSET \odot PAVEMENT 12' LT : ~~RT~~
0.10' TO RT EDGE PAVEMENT
 S.L.M. 172+76.49

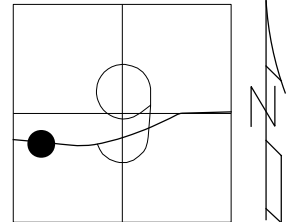

HORIZ. DATUM: NAD83 (2011) GEOID: NAVD88 2018
 GRID: NORTHING: 636892.841 EASTING: 1536579.459

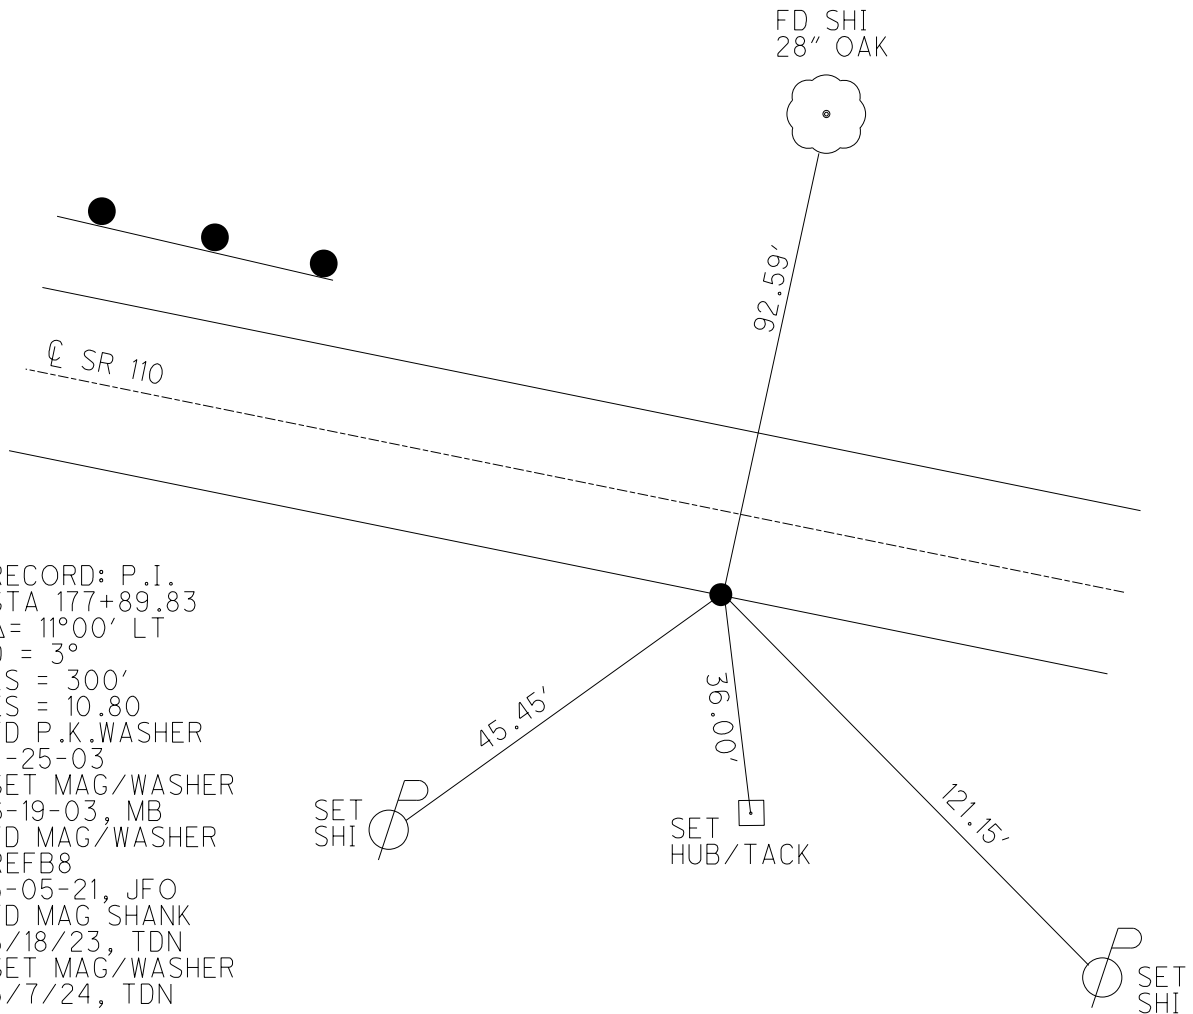


RECORD: P.I.
 STA 177+89.83
 $\Delta = 11^{\circ}00'$ LT
 $D = 3^{\circ}$
 LS = 300'
 ES = 10.80
 FD P.K. WASHER
 4-25-03
 SET MAG/WASHER
 6-19-03, MB
 FD MAG/WASHER
 REFB8
 5-05-21, JFO
 FD MAG SHANK
 8/18/23, TDN
 SET MAG/WASHER
 3/7/24, TDN


O.D.O.T. DISTRICT 2 SURVEY OFFICE (USE ONLY)

PERSONNEL _____ REFERENCE NO. 8 B SHEET 20 OF 44
 NOTES ASTON DATE 8/18/23 ROUTE SR 110
 H.C. NIESE WEATHER CLEAR COUNTY HENRY
 R.C. RHOADES TEMP. 73° TOWNSHIP HARRISON
AUBLE SECTION 9
 DWG BY RHOADES PID 94321 T 5 N R 7 E

TYPE MONUMENT MAG SHANK
 ON SURFACE - ~~BELOW~~ ON _____
 OFFSET C PAVEMENT 11.5' LT : ~~RT~~
ON TO RT EDGE PAVEMENT
 S.L.M. 172+76.49

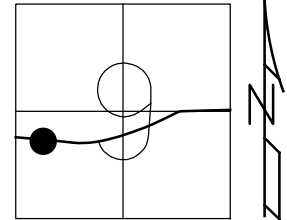

HORZ. DATUM: NAD83 (2011) GEOID: NAVD88 2018
 GRID: NORTHING: 636892.841 EASTING: 1536579.459

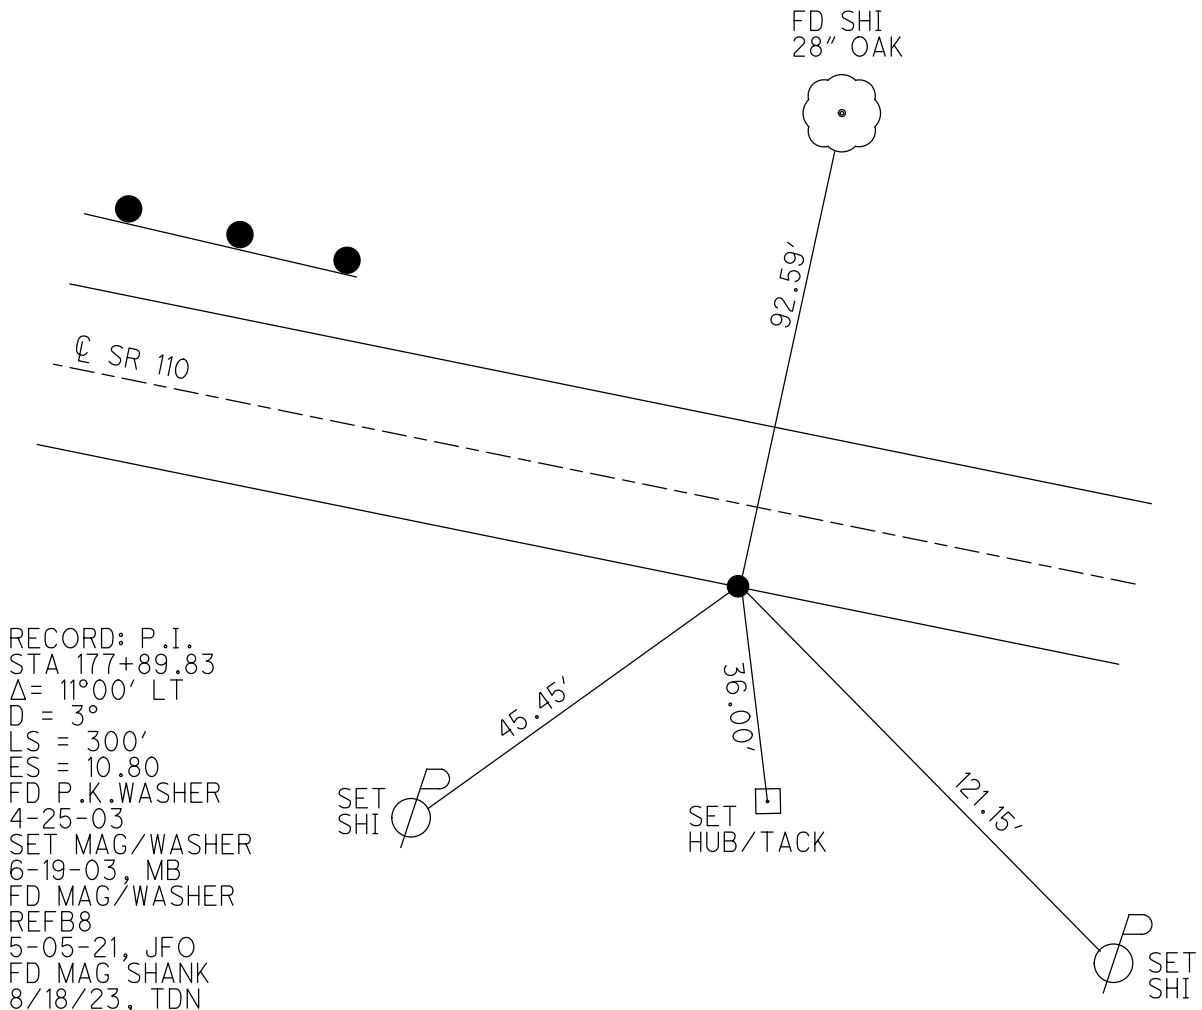

O.D.O.T. DISTRICT 2 SURVEY OFFICE

PERSONNEL

REFERENCE NO. 8-B


SHEET 7 OF 26

NOTES BRUMBAUGH
 H.C. BARNHISEL
 R.C. GLASS
RYALL

DATE 4-25-03
 WEATHER CLEAR
 TEMP. +60°


ROUTE S.R. 110
 COUNTY HENRY
 TOWNSHIP HARRISON
 SECTION 9
T 5 N R 7 E

TYPE MONUMENT P.K./WASHERS
 ON SURFACE ~~-BELOW~~ YES
 LEFT - ☉ PAV'T 11.5'
ON ~~TO~~ RT. EDGE PAVEMENT
 S.L.M. 172+61

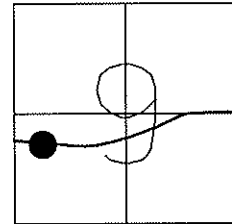

REC. P.I. STA 177+89.83
 DELTA = 11°-00' LT.
 D = 3°
 Ls = 300'
 Es = 10.80

RESET MAG NAIL & WASHER
6-19-03
 MB

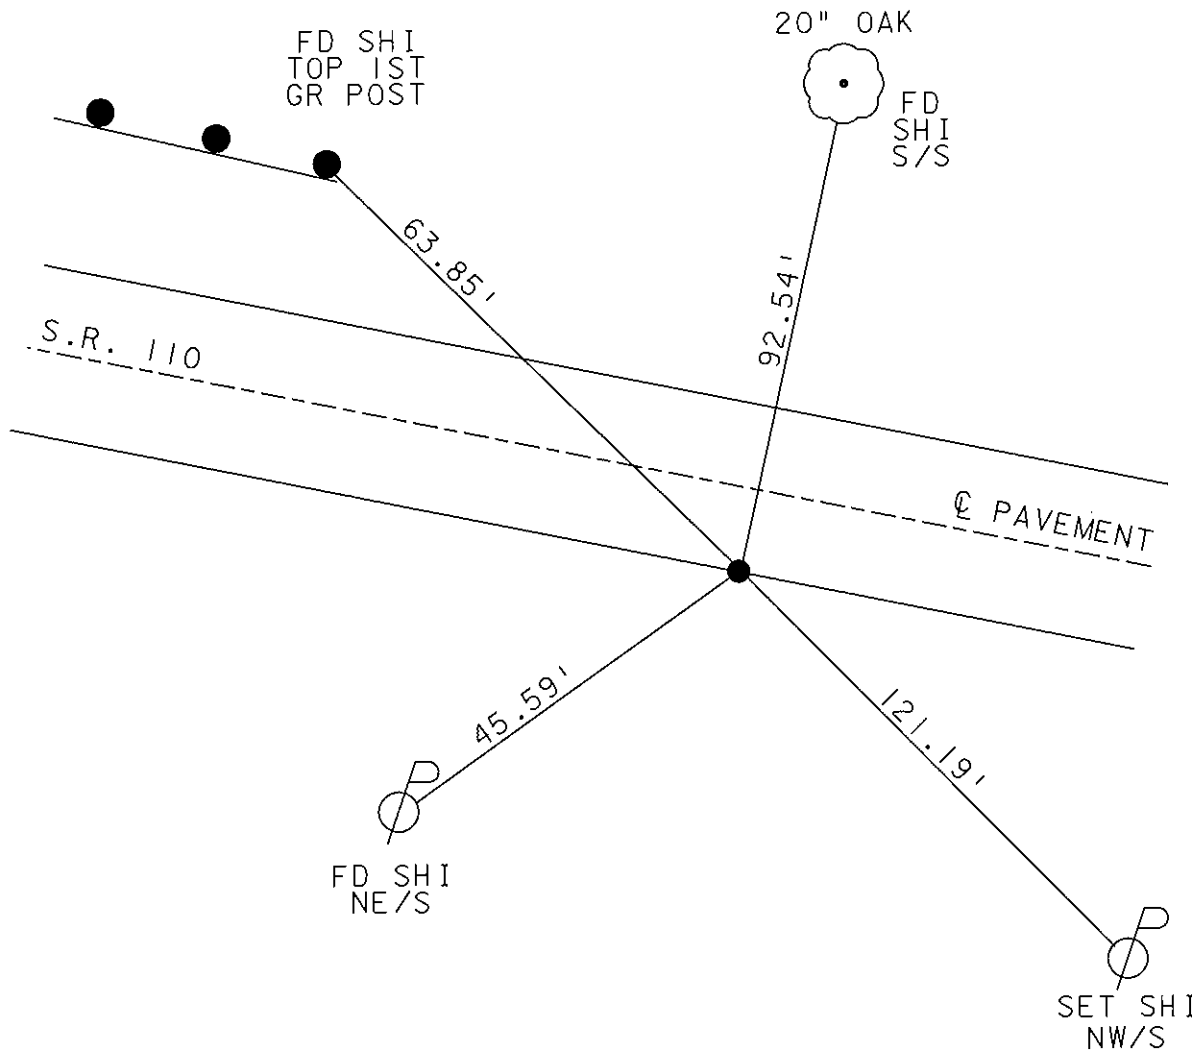

O.D.O.T. DISTRICT 2 SURVEY OFFICE

PERSONNEL

REFERENCE NO. 8B

SHEET 15 OF 34

NOTES LOEHRKE

H.C. CURTIS

R.C. ROMETO

DATE 5-28-92

WEATHER CLEAR

TEMP. +60

ROUTE S.R.110


COUNTY HENRY

TOWNSHIP HARRISON

SECTION 9

set P.K. / WASHER
10-27-92

T.S. N R 7 E

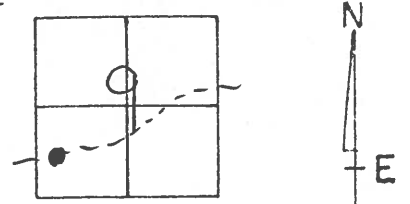

TYPE MONUMENT Sm. R.R. Spike

ON SURFACE - BELOW Yes

LEFT - <math>\text{C}</math> PAV'T. - RIGHT 10.9

L.O. TO R+ EDGE PAVEMENT

S.L.M. 172 +61


REC. P.I. Sta 177+89.83

$\Delta = 11^{\circ}00'$ Lt.

$D = 3^{\circ}$

$L_s = 300'$

$E_s = 10.80$

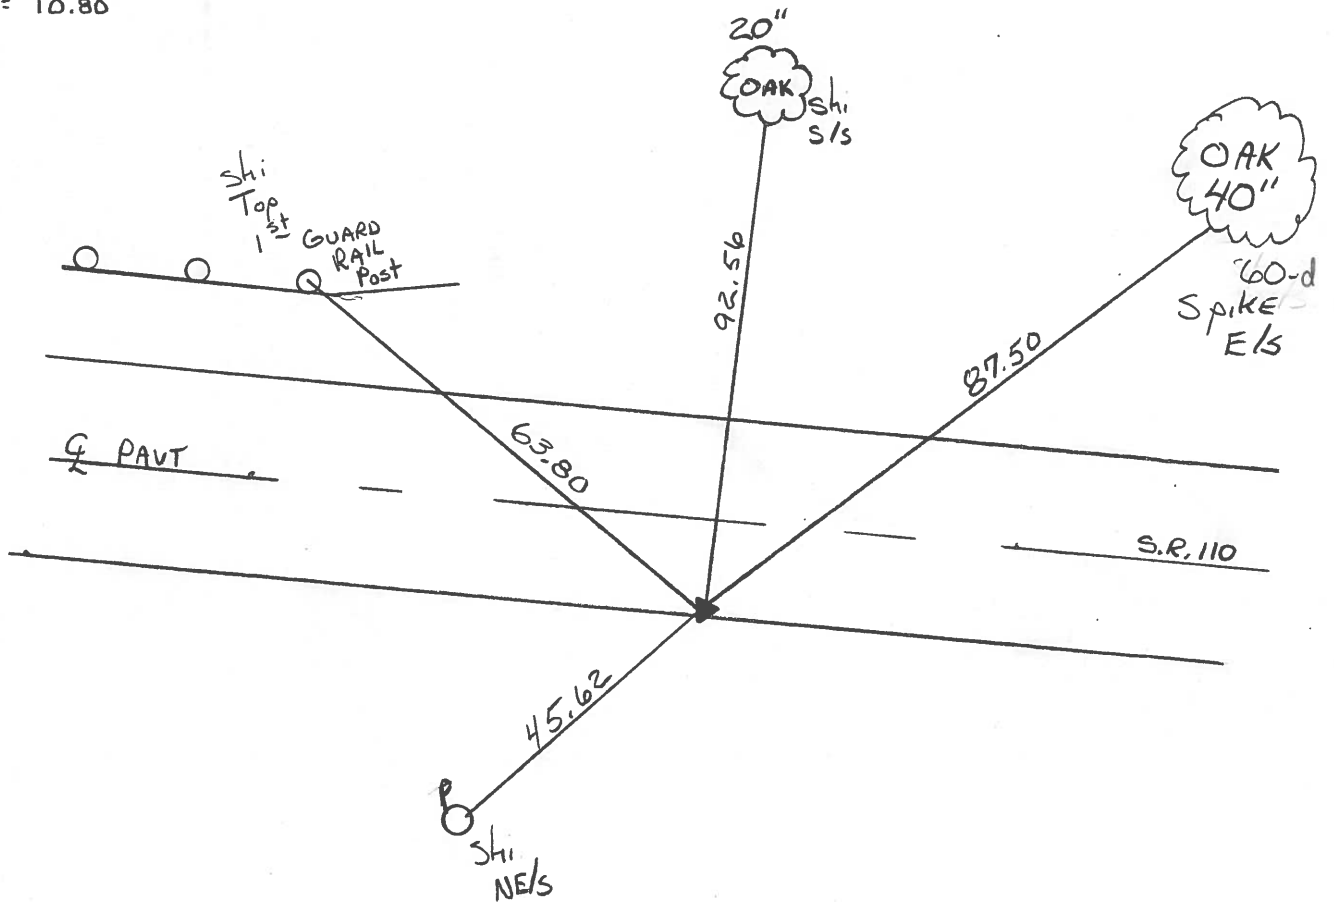

O.D.O.T. DISTRICT 2 SURVEY OFFICE

SHEET _____ OF _____

County HENRY S.R. 110

Date 2-6-84

Township HARRISON

Weather FLURRIES

Section 9

Temp. +20°

T5N, R7E


Personnel BARNHISEL HC

88

HOUSEHOLDER RC

HOFFMAN

LOEHRKE

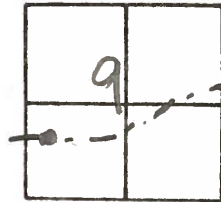

Fd 3/4" pipe 1" Below SURFACE
0.6 Lt of REP.
11.0 Rt of & PAVT


SLM = 172+73

SET SMALL R.R. SPK.
6/13/84
M.D.B.

SET SHI S/S
20" OAK


Fd 60-d spk
w/s
24" MAPLE

Fd 60-d spk
E/S
40" OAK

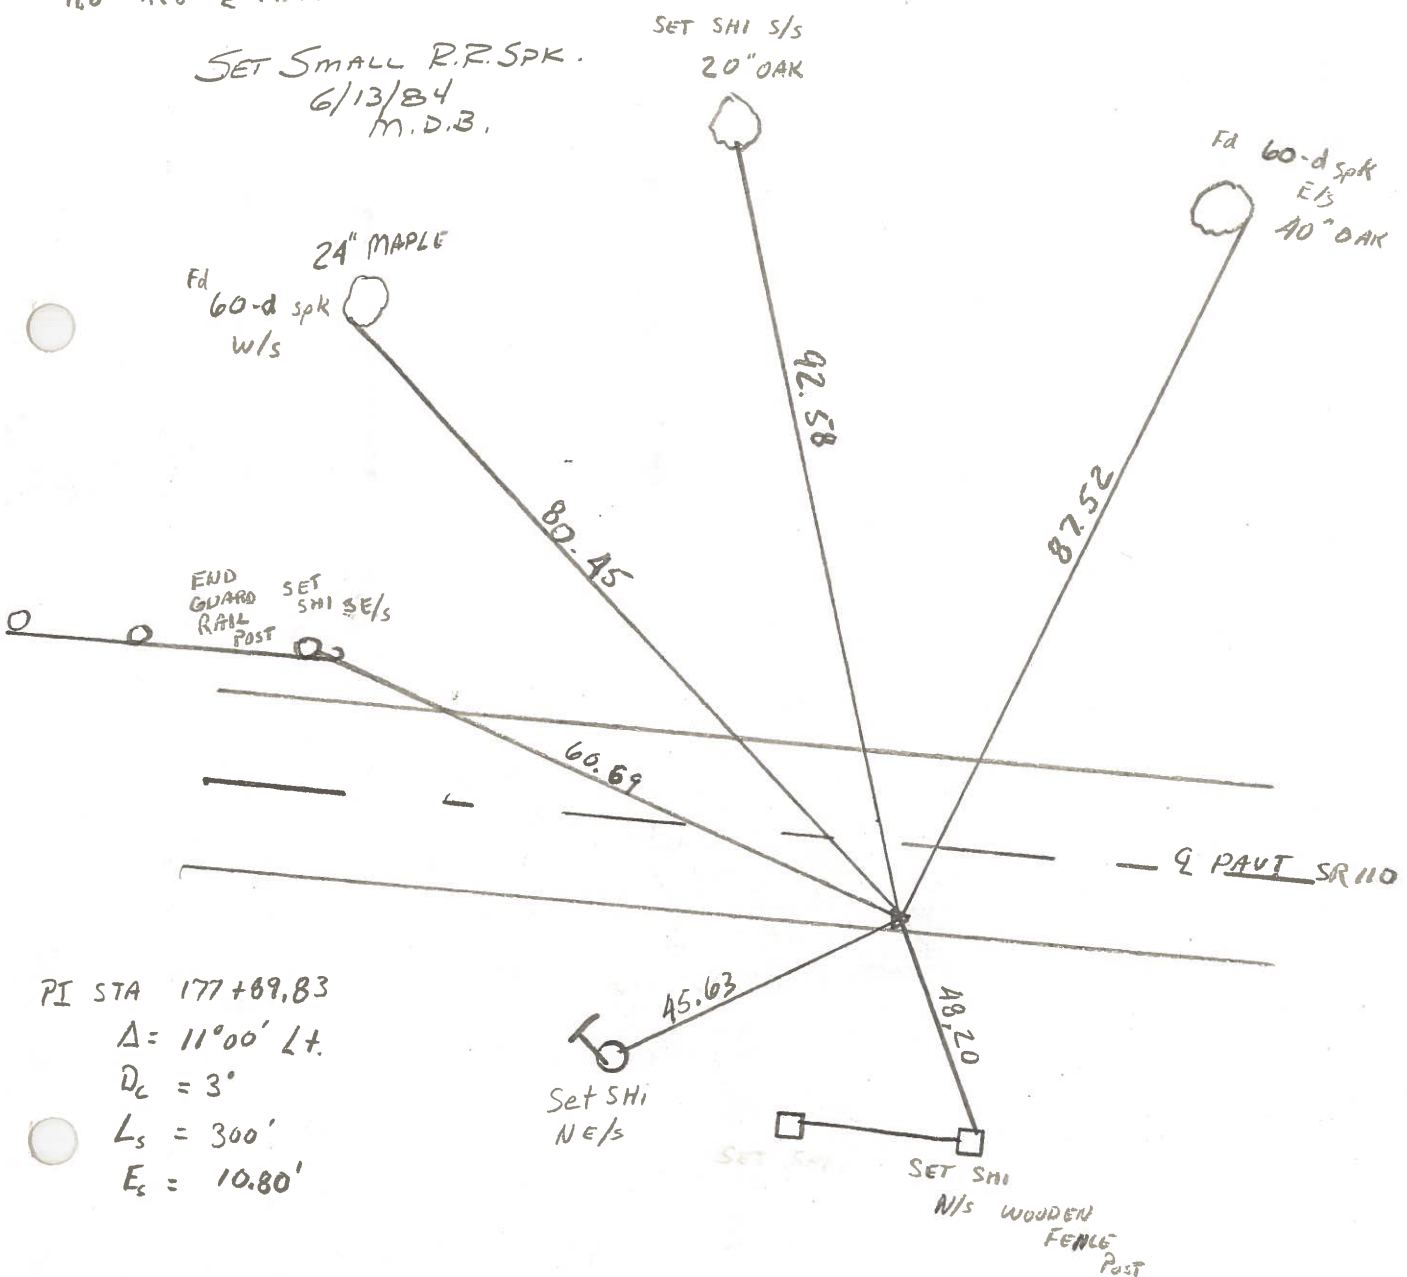


PI STA 177+89.83
Δ = 11°00' Lt.
D_c = 3'
L_s = 300'
E_s = 10.80'

PERSONNEL	TITLE	PERSONNEL	TITLE	COUNTY	DATE
<u>Beach</u>		<u>Hoff</u>		<u>Henry</u>	<u>Dec. 1957</u>
<u>Armbruster</u>	<u>π</u>	<u>Harris</u>		S. R. <u>110</u>	WEATHER
<u>Rutter</u>		<u>Ruchener</u>		SEC. <u>2.22</u>	TEMP.
<u>Knape</u>		<u>Delvanthal</u>		DESCRIPTION <u>ALIGNMENT</u>	JOB NO.
				<u>sheet #3</u>	

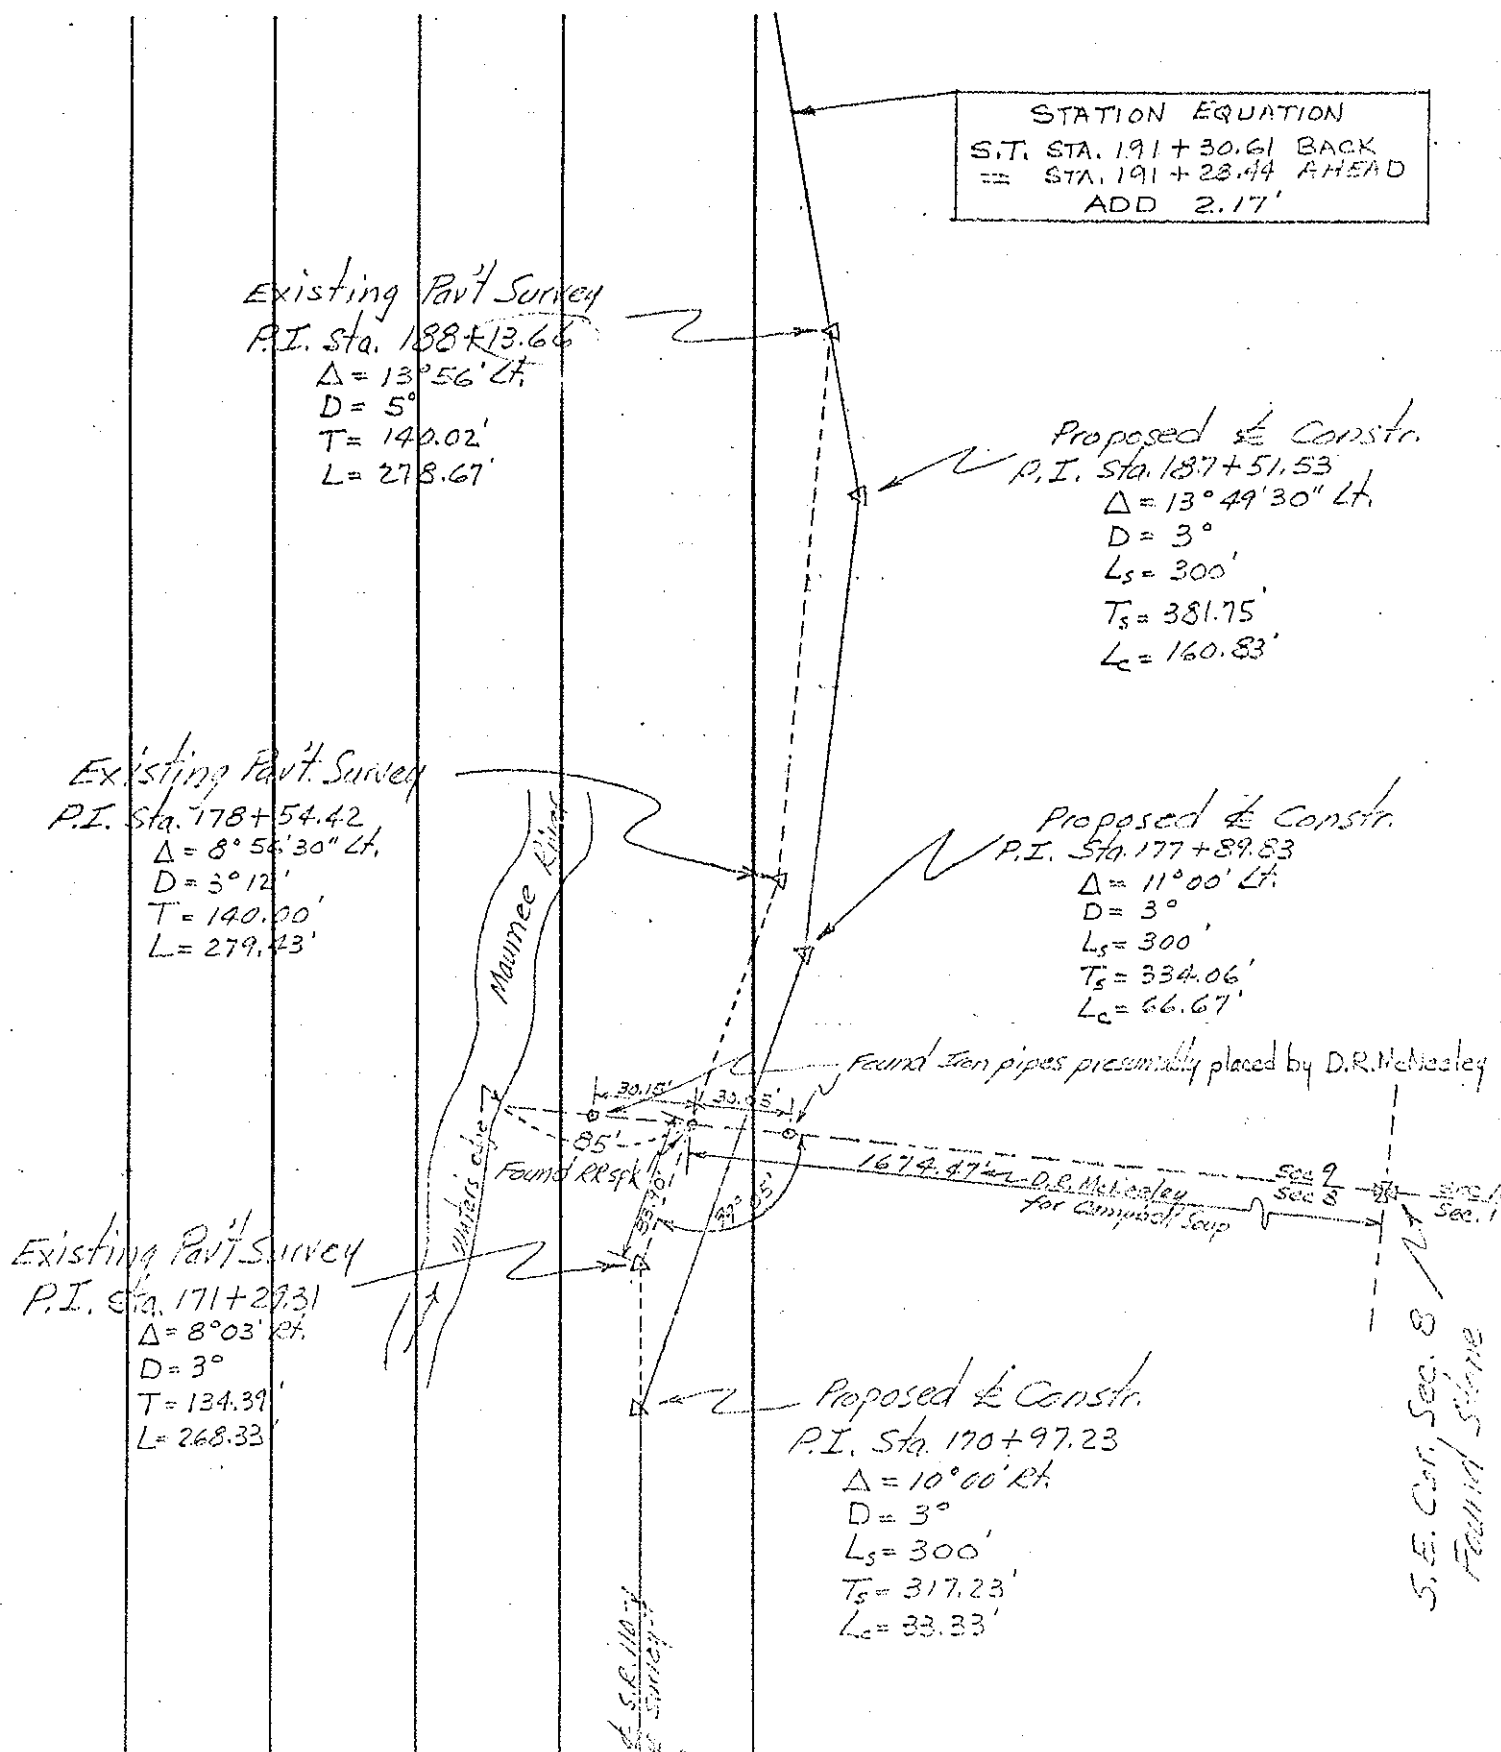

PERSONNEL	TITLE	PERSONNEL	TITLE	COUNTY	DATE
<u>Beach</u>		<u>Hoff</u>		<u>Henry</u>	<u>Dec. 1957</u>
<u>Ambruster</u>	<u>+</u>	<u>Harris</u>		S. R. <u>110</u>	WEATHER
<u>Ruffer</u>		<u>Ruchener</u>		SEC. <u>2.22</u>	TEMP
<u>Knappe</u>		<u>Delvanthal</u>		DESCRIPTION <u>CONTROL POINTS</u>	JOB NO.
				<u>2</u>	

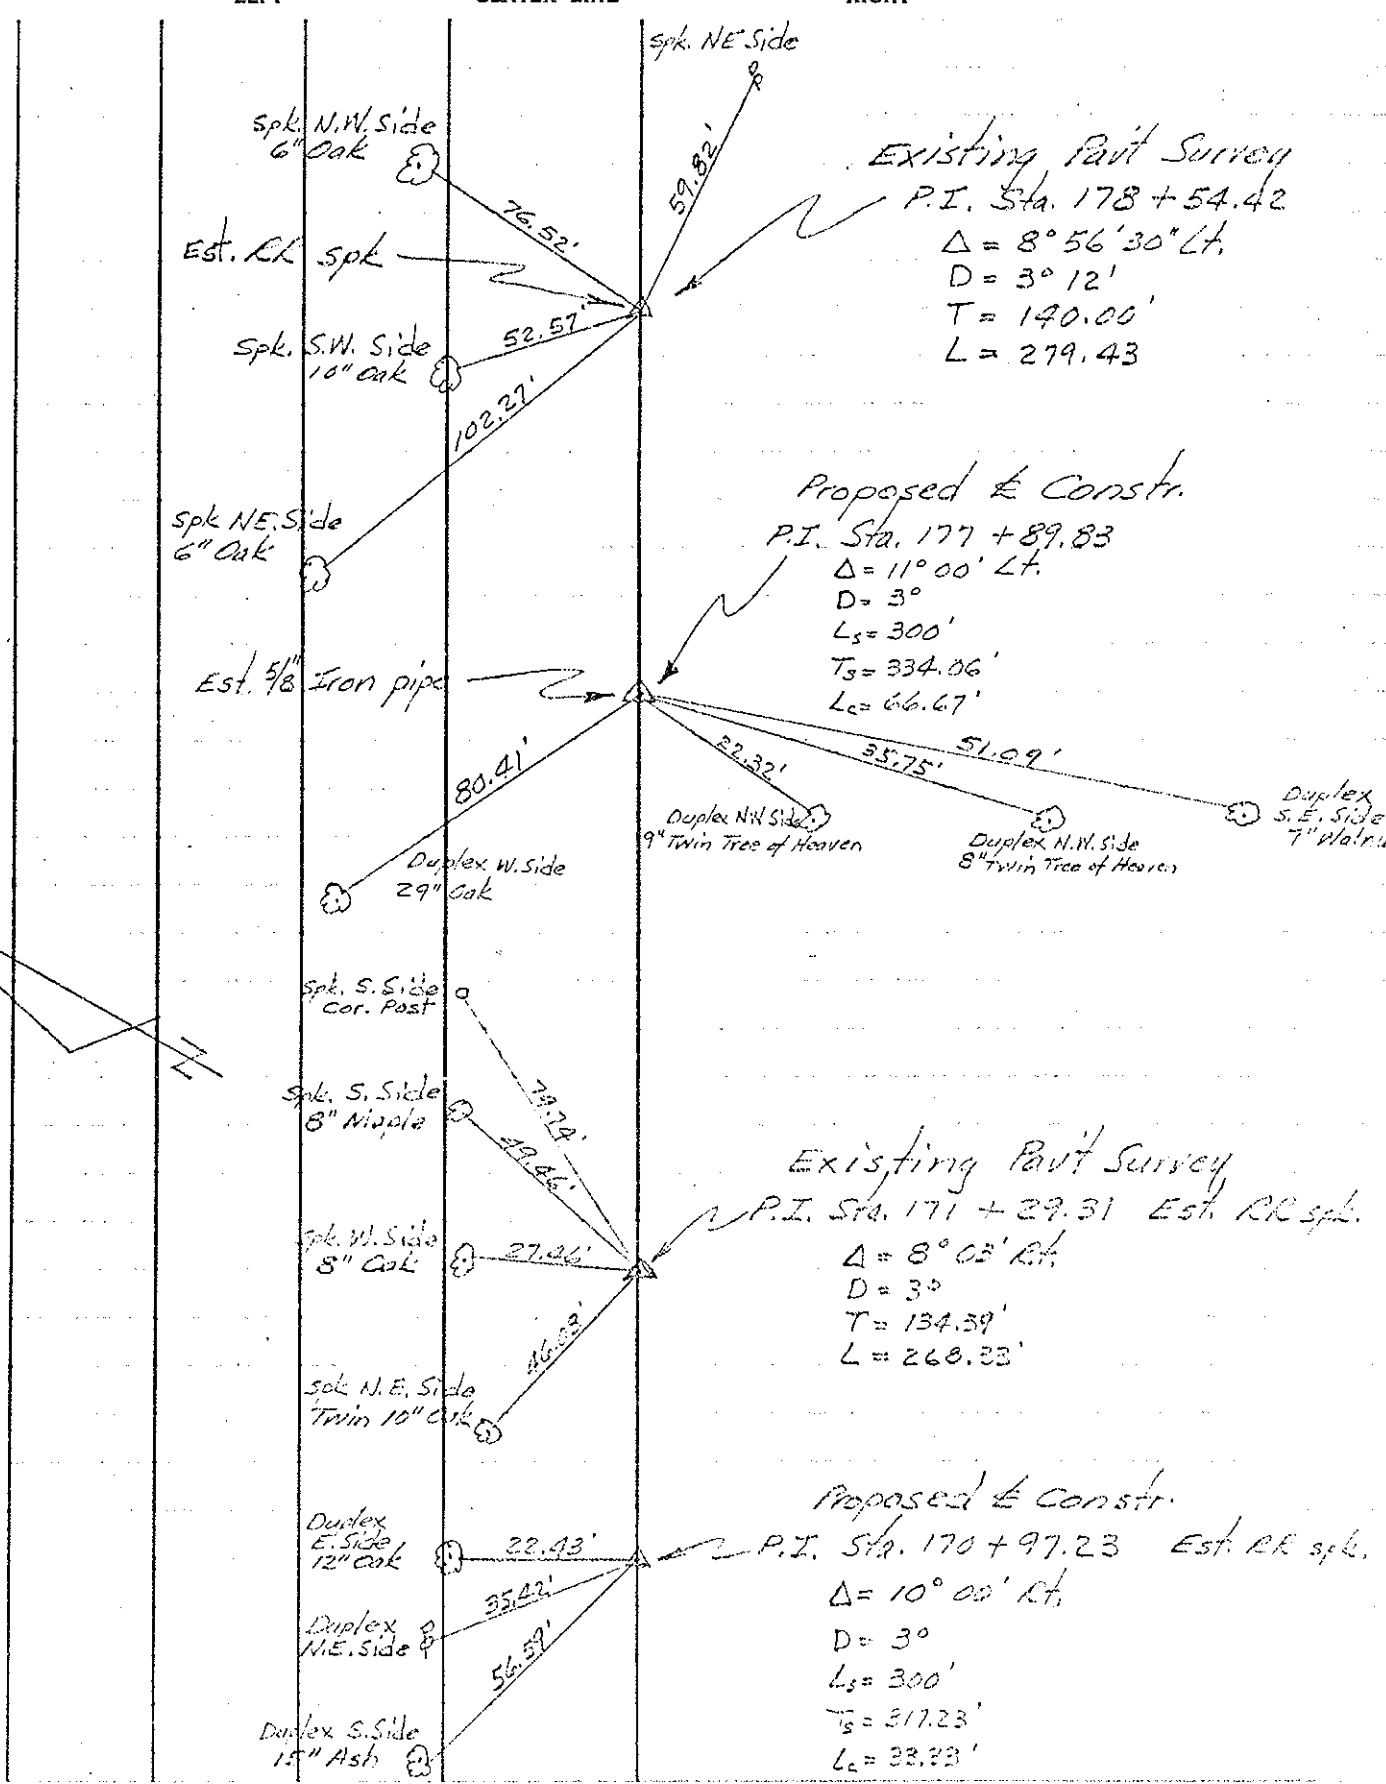

PERSONNEL	TITLE	PERSONNEL	TITLE	COUNTY	DATE
<u>Beach</u>		<u>Hoff</u>		<u>Henry</u>	<u>Dec. 1957</u>
<u>Armbruster</u>	<u>π</u>	<u>Harris</u>		S. R. <u>110</u>	WEATHER
<u>Rutter</u>		<u>Ruchener</u>		SEC. <u>2.22</u>	TEMP.
<u>Knape</u>		<u>Delvanthal</u>		DESCRIPTION <u>ALIGNMENT</u>	JOB NO.
				<u>sheet #3</u>	

