


O.D.O.T. DISTRICT 2 SURVEY OFFICE (USE ONLY)


PERSONNEL \_\_\_\_\_ REFERENCE NO. 8 C SHEET 28 OF 51  
 NOTES ASTON DATE 3/7/24 ROUTE SR 110  
 H.C. NIESE WEATHER CLOUDY COUNTY HENRY  
 R.C. ASTON TEMP. 42° TOWNSHIP HARRISON  
 SECTION 9  
 DWG BY RHOADES PID 94321 T 5 N R 7 E

TYPE MONUMENT 1" IPIPE  
~~ON SURFACE~~ - BELOW 8"  
 OFFSET  $\bar{C}$  PAVEMENT 16.1' ~~RT~~ : RT  
4.5' RT TO RT EDGE PAVEMENT  
 S.L.M. 182+37.14

HORIZ. DATUM: NAD83 (2011) GEOID: NAVD88 2018  
 GRID: NORTHING: 636875.275 EASTING: 1537542.005

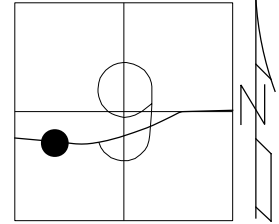

RECORD: P.I.  
 STA 187+51.53  
 $\Delta = 13^\circ 49' 30''$  LT  
 $D = 3^\circ$   
 $L = 300$   
 $E = 15.96$   
 FD 1" IPIPE  
 10-27-92, CL  
 4-25-03, MB  
 FD 1" IPIPE  
 8" DOWN  
 REFC8  
 5-05-21, JFO  
 8/18/23, TDN  
 3/7/24, TDN

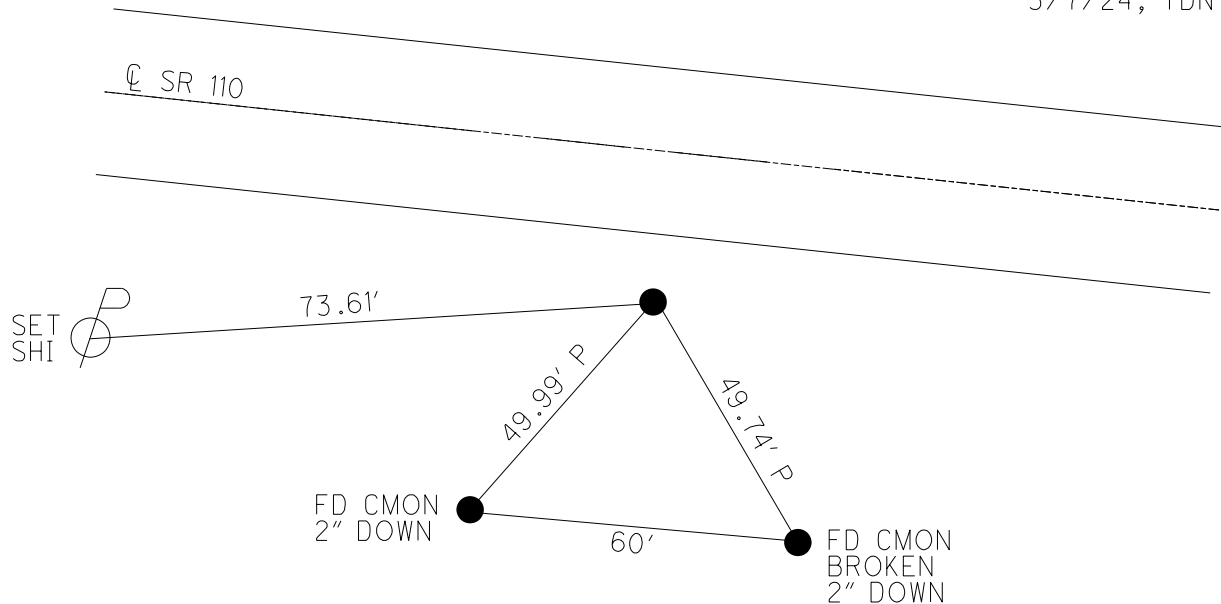

**O.D.O.T. DISTRICT 2 SURVEY OFFICE (USE ONLY)**

PERSONNEL \_\_\_\_\_ REFERENCE NO. 8 C SHEET 21 OF 44

NOTES ASTON DATE 8/18/23 ROUTE SR 110  
 H.C. NIESE WEATHER CLEAR COUNTY HENRY  
 R.C. RHOADES TEMP. 72° TOWNSHIP HARRISON  
AUBLE SECTION 9

DWG BY RHOADES PID 94321 T 5 N R 7 E

TYPE MONUMENT 1" IPIPE

~~ON SURFACE~~ - BELOW 8"


OFFSET  $\odot$  PAVEMENT 16.1' ~~RT~~ : RT

4.5' RT TO RT EDGE PAVEMENT


S.L.M. 182+37.14

HORIZ.DATUM: NAD83 (2011) GEOID: NAVD88 2018

GRID: NORTHING: 636875.275 EASTING: 1537542.005

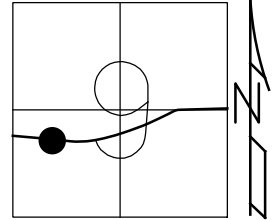

RECORD: P.I.  
 STA 187+51.53  
 $\Delta = 13^\circ 49' 30''$  LT  
 D = 3°  
 L = 300  
 E = 15.96  
 FD 1" IPIPE  
 10-27-92, CL  
 4-25-03, MB  
 FD 1" IPIPE  
 8" DOWN  
 REFC8  
 5-05-21, JFO  
 8/18/23, TDN

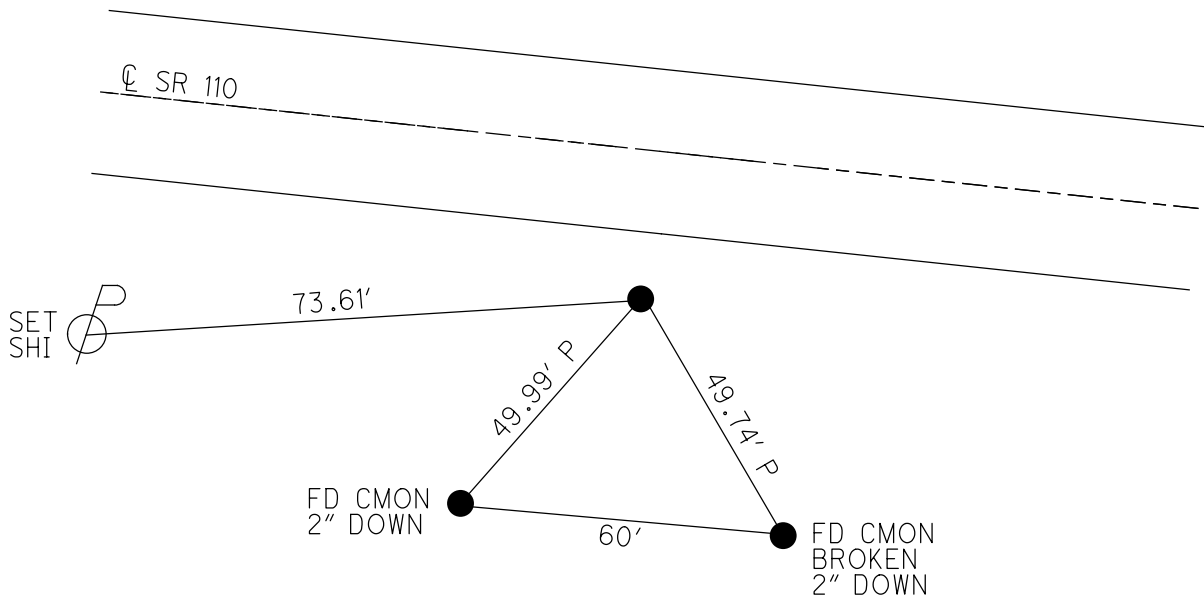

O.D.O.T. DISTRICT 2 SURVEY OFFICE

PERSONNEL

REFERENCE NO. 8-C



SHEET 8 OF 26

NOTES BRUMBAUGH  
 H.C. BARNHISEL  
 R.C. RYALL  
GLASS


DATE 4-25-03  
 WEATHER CLEAR  
 TEMP. +60°

ROUTE S.R. 110  
 COUNTY HENRY  
 TOWNSHIP HARRISON  
 SECTION 9  
T 5 N R 7 E

TYPE MONUMENT 1" PIPE  
~~ON SURFACE - BELOW~~ 6"  
Q PAV'T - RIGHT 16.1'  
4.5' RT OF RT EDGE PAVEMENT  
S.L.M. 182+23

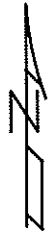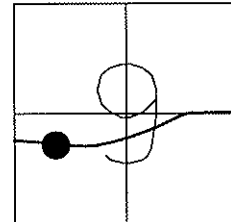

REC. P.I.  
 STA 187+51.53  
 DELTA = 13°-49'-30" LT.  
 D = 3°  
 L = 300  
 E = 15.96

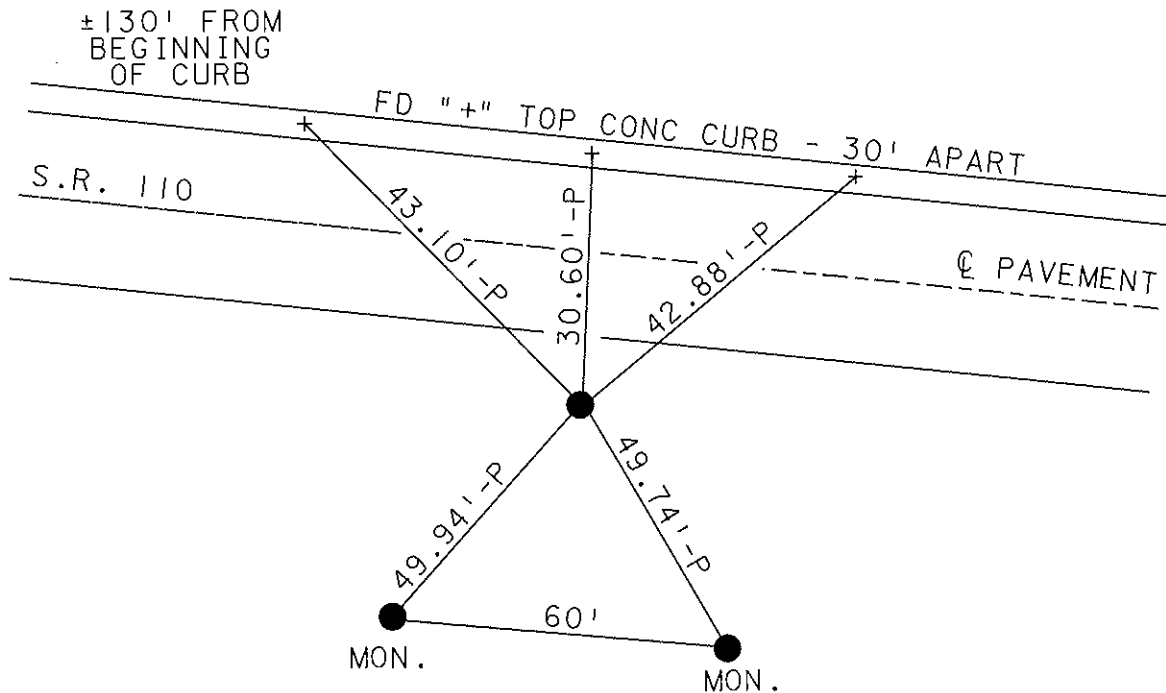

# O.D.O.T. DISTRICT 2 SURVEY OFFICE

PERSONNEL

REFERENCE NO. 8C

SHEET 16 OF 34

NOTES LOEHRKE

H.C. CURTIS

R.C. ROMETO

DATE 5-28-92

WEATHER CLEAR

TEMP. +60

ROUTE S.R. 110

COUNTY HENRY

TOWNSHIP HARRISON

SECTION 9

T S N R 1 E

TYPE MONUMENT 1" PIPE


ON ~~SURFACE~~ - BELOW 4"

LEFT - C PAV'T. - RIGHT 16.1

4.5 TO Rt. EDGE PAVEMENT

S.L.M. 182 +23

OK, 10-27-92

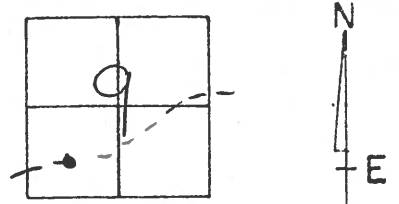

Rec P.I.


Sta 187+51.53

$\Delta = 13^{\circ} - 49' - 30''$  Lt

D =  $3^{\circ}$

L = 300

E = 15.96

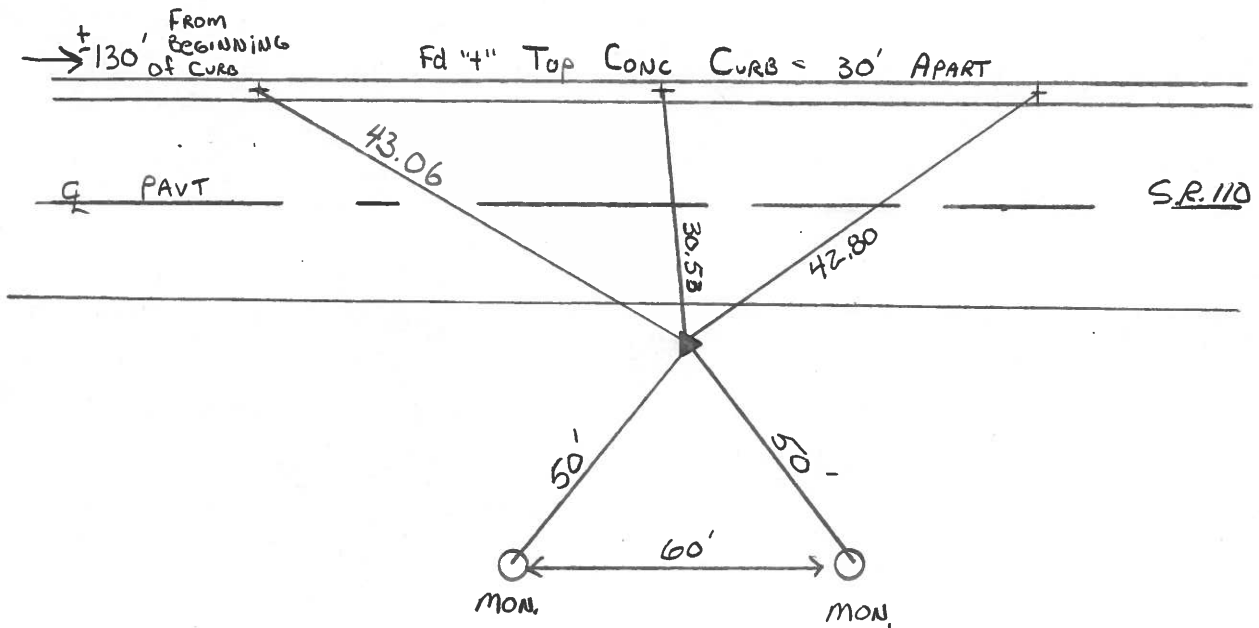

OD.O.T. DISTRICT 2 SURVEY OFFICE

SHEET \_\_\_\_\_ OF \_\_\_\_\_

County HENRY S.R. 110

Date 7-6-84

Township HARRISON

Weather CLOUDY

Section 9

Temp. +22°

T5N, R7E


Personnel BARNHISEL HC

8C

HOUSEHOLDER RC

HOFFMAN

LOEMRKE

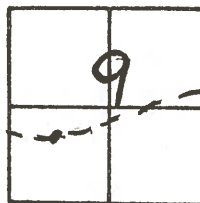

Fd: 1" Pipe 3" Below GROUND Level


SLM = 182+33

4.7 Rt of REP

15.9 Rt of G PAUT SR110

OK 6/13/84

m.d.B.

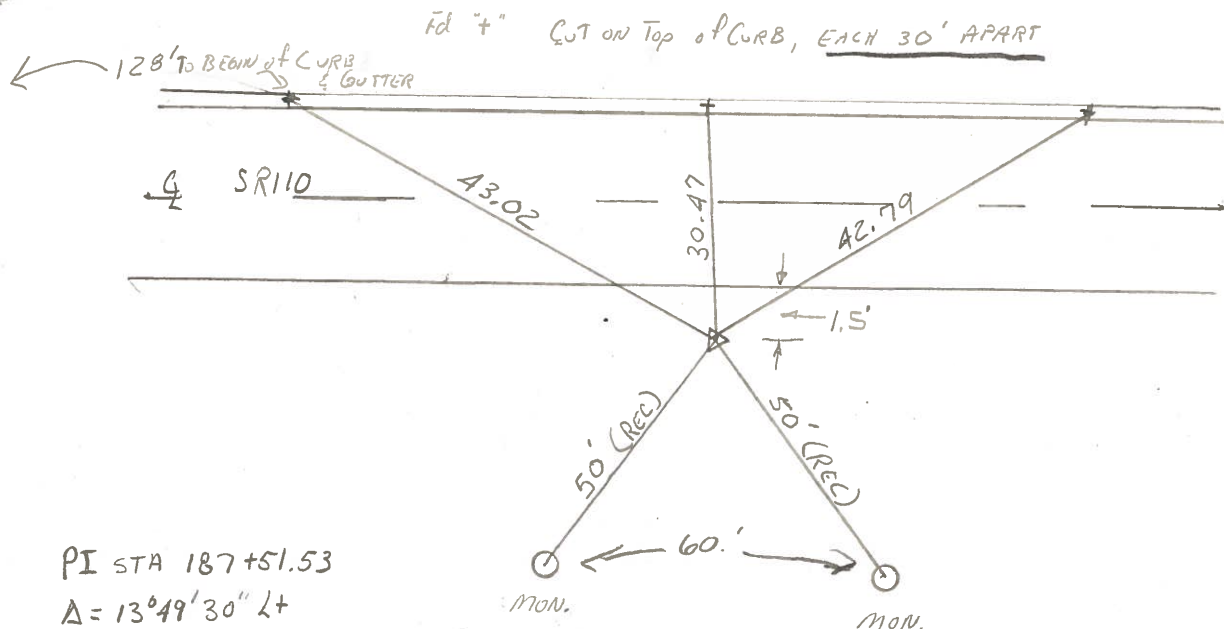

PI STA 187+51.53

$\Delta = 13^{\circ}49'30''$  Lt


$D_c = 3^{\circ}$

$L_c = 360'$

$E_s = 15.96$

G.I To

PERSONNEL	TITLE	PERSONNEL	TITLE	COUNTY	Henry	DATE	11-20-58
Ernsthausen				S. R.	110	WEATHER	Clear
Donaldson				SEC.		TEMP.	+50°
Tefft				DESCRIPTION	Ties TO R.I.'s	JOB NO.	

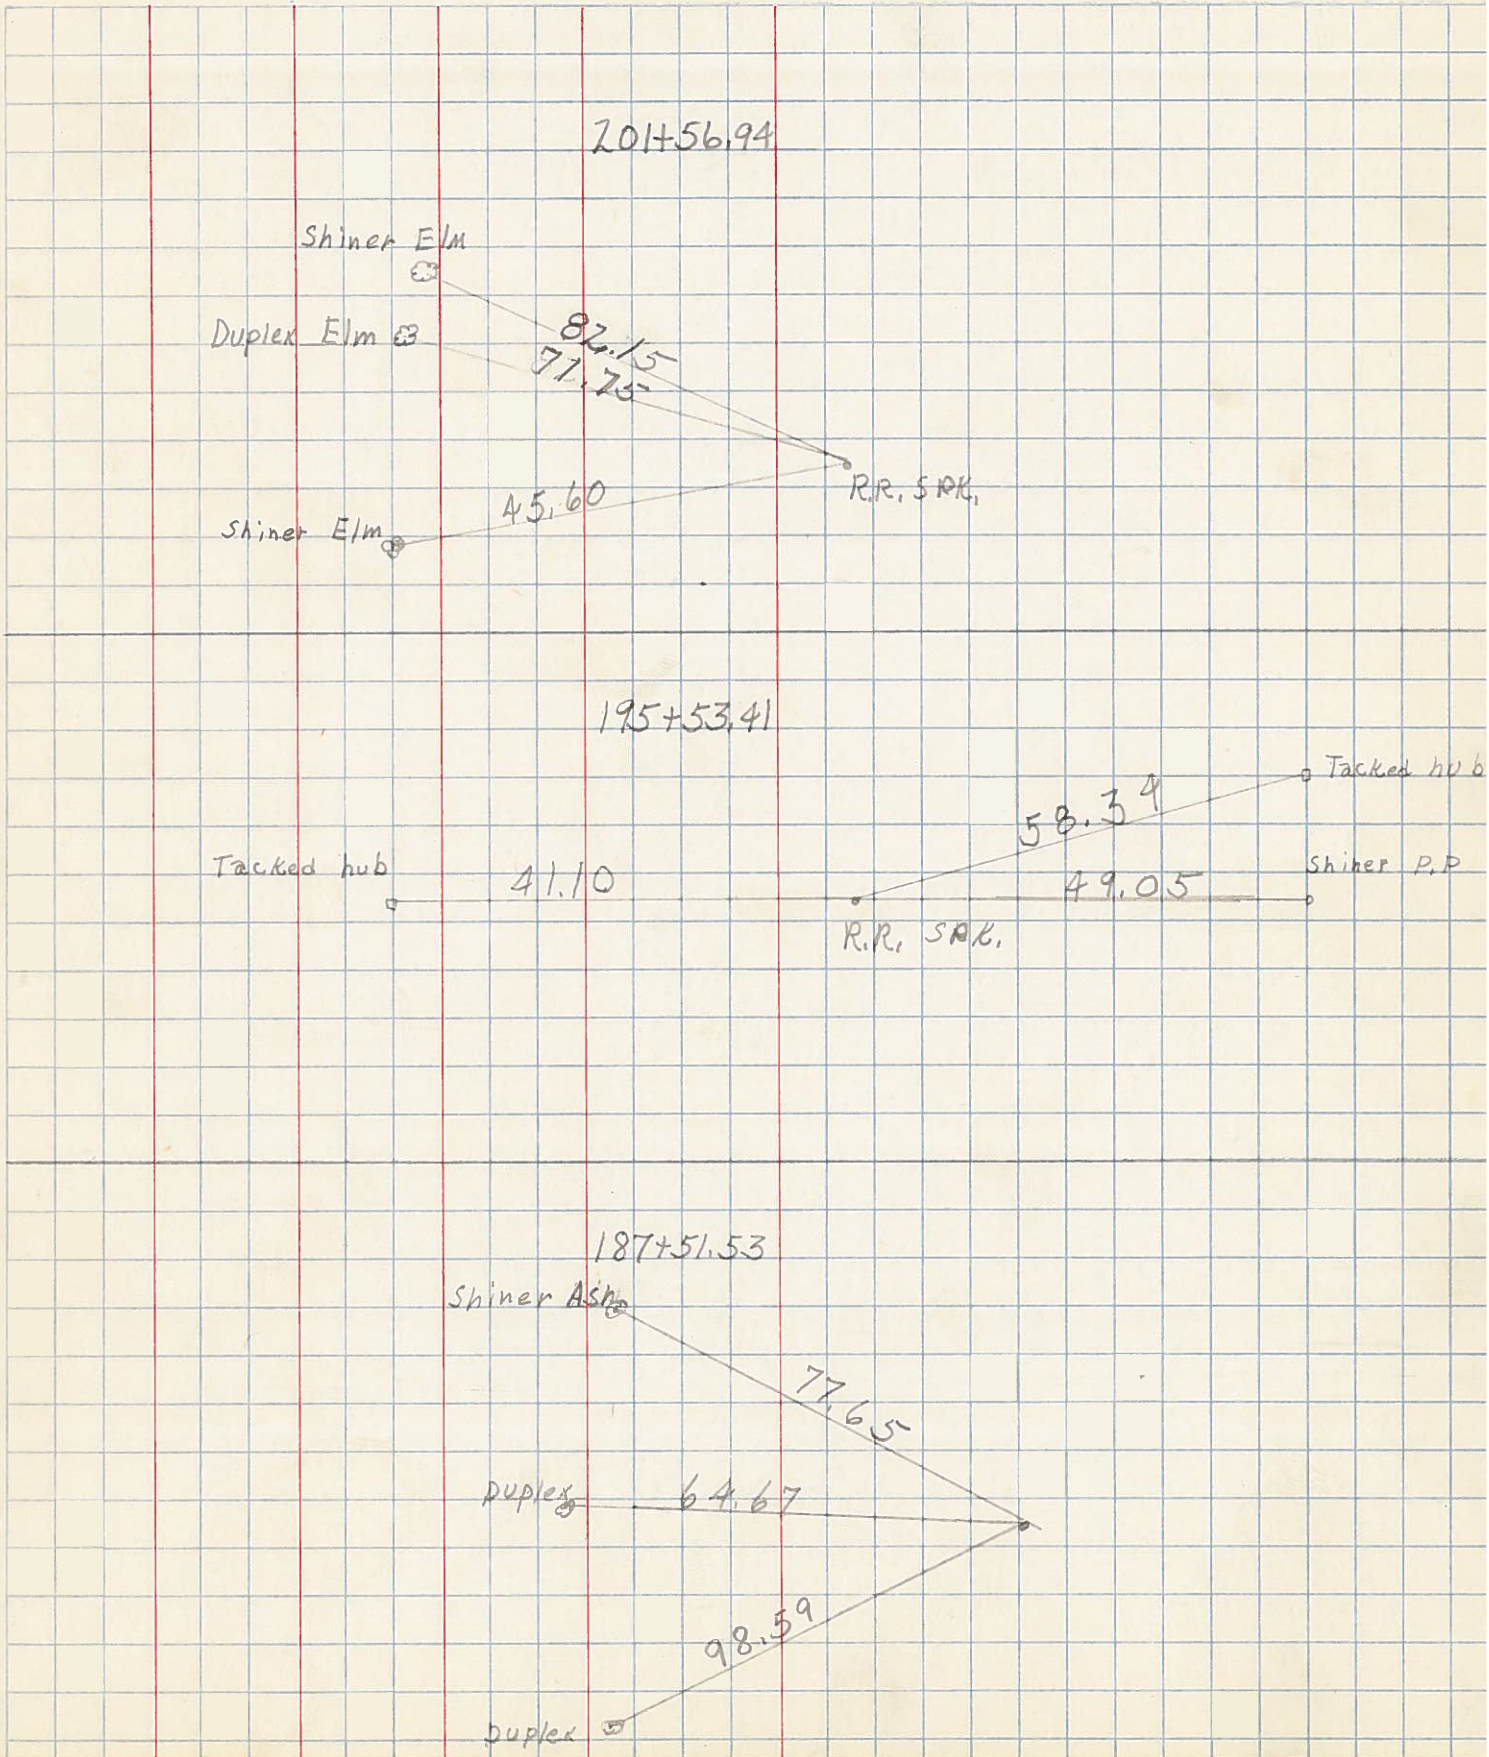

PERSONNEL	TITLE	PERSONNEL	TITLE	COUNTY	DATE
Beach		Hoff		Henry	Dec. 1957
Armbruster	π	Harris		S. R. 110	WEATHER
Rutter		Ruchener		SEC. 2.22	TEMP.
Knape		Delvanthal		ALIGNMENT sheet #3	JOB NO.

DESCRIPTION LEFT CENTER LINE RIGHT

STATION EQUATION  
 S.I. STA. 191 + 30.61 BACK  
 = STA. 191 + 23.44 AHEAD  
 ADD 2.17'

Existing Pav't Survey  
 P.I. Sta. 188 + 13.66  
 $\Delta = 13^\circ 56' \text{ Lt.}$   
 $D = 5^\circ$   
 $T = 140.02'$   
 $L = 278.67'$


Proposed & Constr.  
 P.I. Sta. 187 + 51.53  
 $\Delta = 13^\circ 49' 30'' \text{ Lt.}$   
 $D = 3^\circ$   
 $L_s = 300'$   
 $T_s = 381.75'$   
 $L_c = 160.83'$

Existing Pav't Survey  
 P.I. Sta. 178 + 54.42  
 $\Delta = 8^\circ 56' 30'' \text{ Lt.}$   
 $D = 3^\circ 12'$   
 $T = 140.00'$   
 $L = 279.43'$

Proposed & Constr.  
 P.I. Sta. 177 + 89.83  
 $\Delta = 11^\circ 00' \text{ Lt.}$   
 $D = 3^\circ$   
 $L_s = 300'$   
 $T_s = 334.06'$   
 $L_c = 66.67'$

Existing Pav't Survey  
 P.I. Sta. 171 + 29.31  
 $\Delta = 8^\circ 03' \text{ Lt.}$   
 $D = 3^\circ$   
 $T = 134.39'$   
 $L = 268.33'$

Proposed & Constr.  
 P.I. Sta. 170 + 97.23  
 $\Delta = 10^\circ 00' \text{ Lt.}$   
 $D = 3^\circ$   
 $L_s = 300'$   
 $T_s = 317.23'$   
 $L_c = 33.33'$

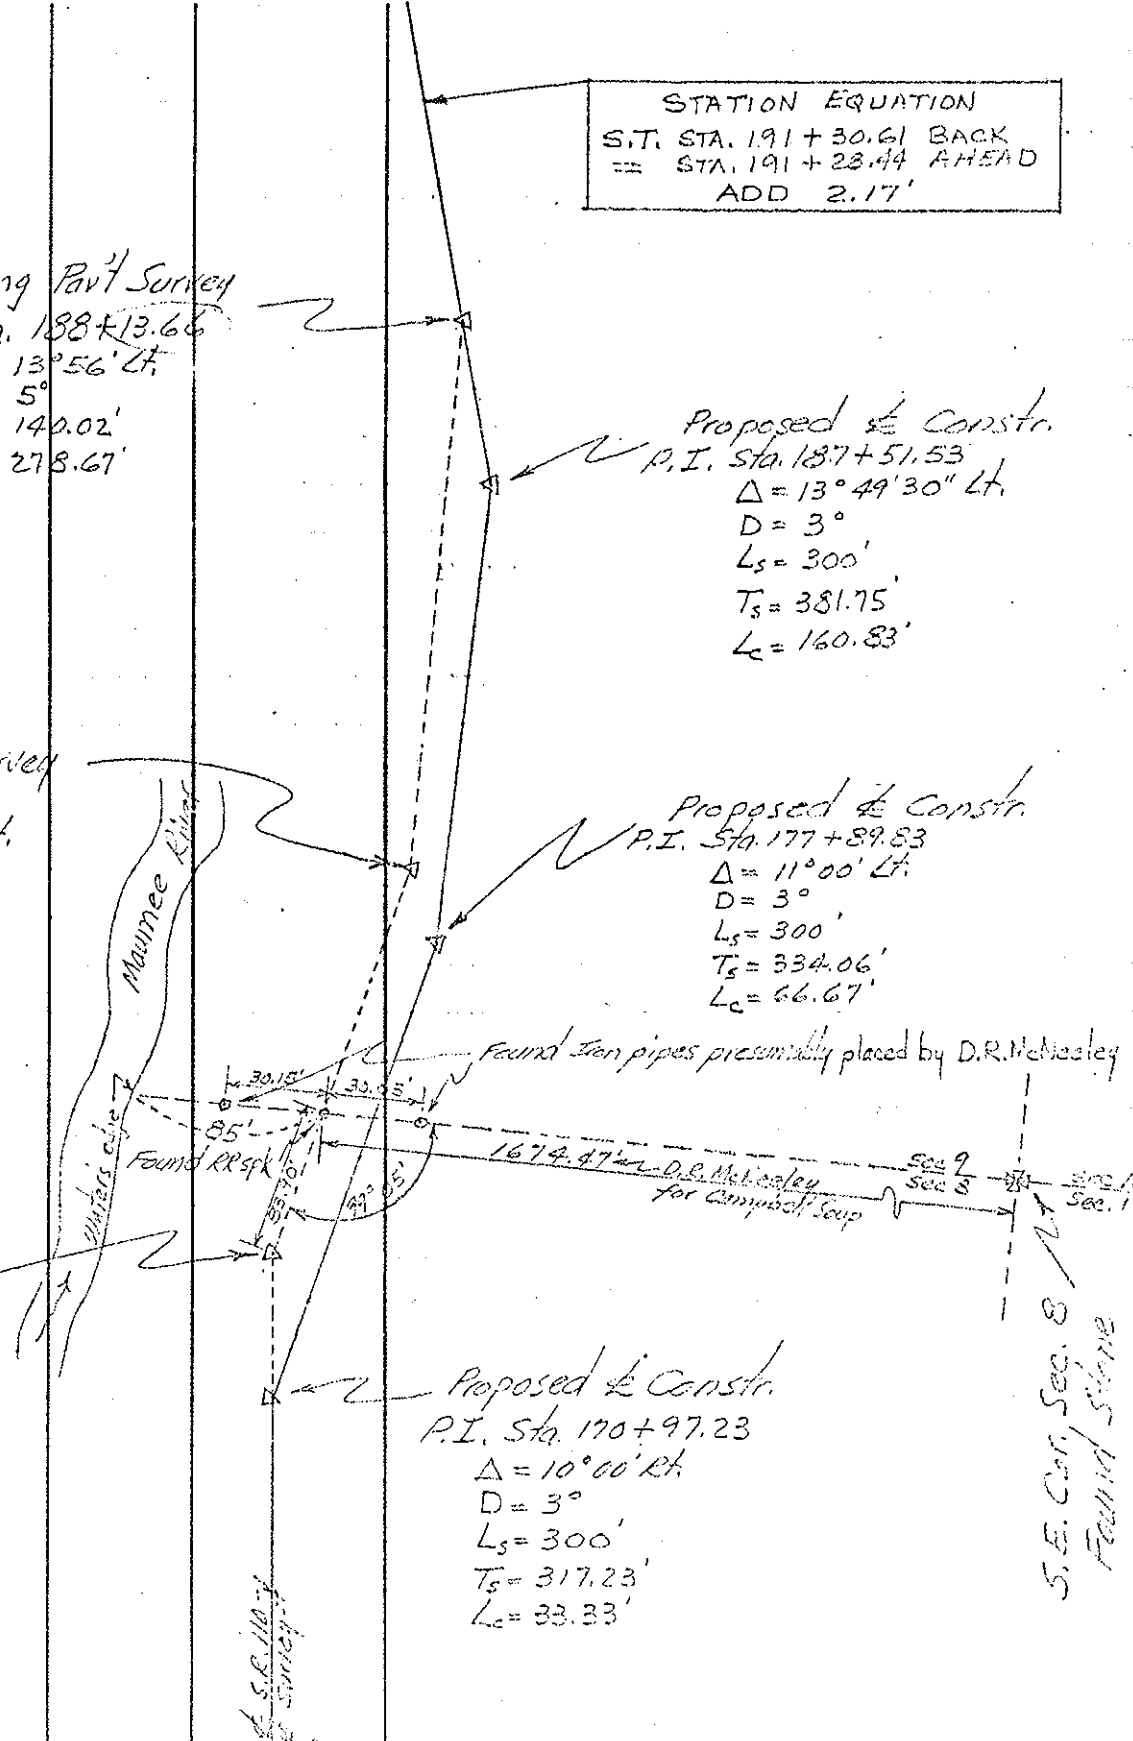

S.E. Cor. Sec. 8  
 Found Stone

S.R. 110 Survey

PERSONNEL	TITLE	PERSONNEL	TITLE
<u>Beach</u>		<u>Hoff</u>	
<u>Armbruster</u>		<u>Harris</u>	
<u>Ruffer</u>		<u>Ruchener</u>	
<u>Knape</u>		<u>Delvarthal</u>	

COUNTY Henry DATE Dec. 1957  
 S. R. 110 WEATHER \_\_\_\_\_  
 SEC. 2.22 TEMP. \_\_\_\_\_

DESCRIPTION \_\_\_\_\_ CONTROL POINTS 3 JOB NO. \_\_\_\_\_

