

O.D.O.T. DISTRICT 2 SURVEY OFFICE (USE ONLY)

PERSONNEL _____ REFERENCE NO. 9 SHEET 31 OF 51

NOTES ASTON DATE 3/7/24 ROUTE SR 110
 H.C. NIESE WEATHER CLOUDY COUNTY HENRY
 R.C. ASTON TEMP. 42° TOWNSHIP HARRISON
 SECTION 9

DWG BY RHOADES PID 94321 T 5 N R 7 E

TYPE MONUMENT MAG/WASHER

~~ON SURFACE~~ - BELOW ON


OFFSET 7.6' TO RT EDGE PAVEMENT

5.5' ~~±~~ : RT


S.L.M. 196+45.41

HORIZ.DATUM: NAD83 (2011) GEOID: NAVD88 2018

GRID: NORTHING: 637242.193 EASTING: 1538901.980

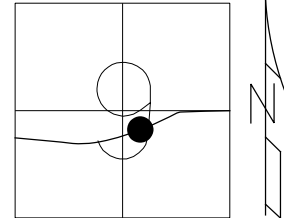


RECORD: P.I.
 STA 201+56.94
 $\Delta = 5^{\circ}46'30''$
 $D = 1^{\circ}24'$
 $T = 206.42'$
 $L = 412.50'$
 $E = 5.20'$
 $R = 4092.56'$
 FD SM.R.R.SPIKE
 4-25-03
 SET MAG/WASHER
 6-19-03, MB
 FD SM.R.R.SPIKE
 2" DOWN
 REF9
 5-06-21, JFO
 8/17/23, TDN
 SET MAG/WASHER
 NEWREF9
 3/7/24, TDN

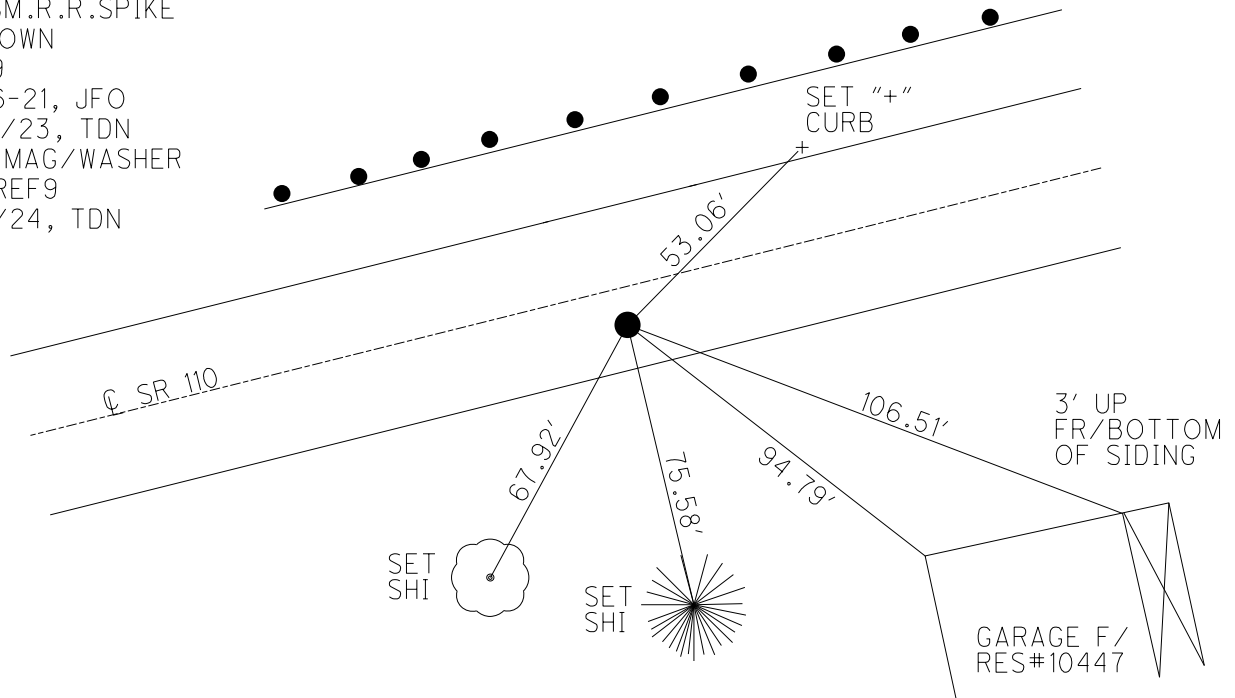

O.D.O.T. DISTRICT 2 SURVEY OFFICE (USE ONLY)


PERSONNEL _____ REFERENCE NO. 9 SHEET 24 OF 44
 NOTES ASTON DATE 8/17/23 ROUTE SR 110
 H.C. NIESE WEATHER WINDY COUNTY HENRY
 R.C. RHOADES TEMP. 75° TOWNSHIP HARRISON
AUBLE SECTION 9
 DWG BY RHOADES PID 94321 T 5 N R 7 E

TYPE MONUMENT SM.R.R.SPIKE
~~ON SURFACE~~ - BELOW 2"
 OFFSET \odot PAVEMENT 4.9' \pm : RT
5.2' TO RT EDGE PAVEMENT
 S.L.M. 196+45.41

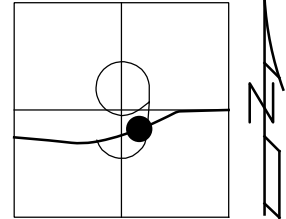

HORIZ.DATUM: NAD83 (2011) GEOID: NAVD88 2018
 GRID: NORTHING: 637242.303 EASTING: 1538901.884

RECORD: P.I.
 STA 201+56.94
 $\Delta = 5^{\circ}46'30''$
 $D = 1^{\circ}24'$
 $T = 206.42'$
 $L = 412.50'$
 $E = 5.20'$
 $R = 4092.56'$
 FD SM.R.R.SPIKE
 4-25-03
 SET MAG/WASHER
 6-19-03, MB
 FD SM.R.R.SPIKE
 2" DOWN
 REF9
 5-06-21, JFO
 8/17/23, TDN

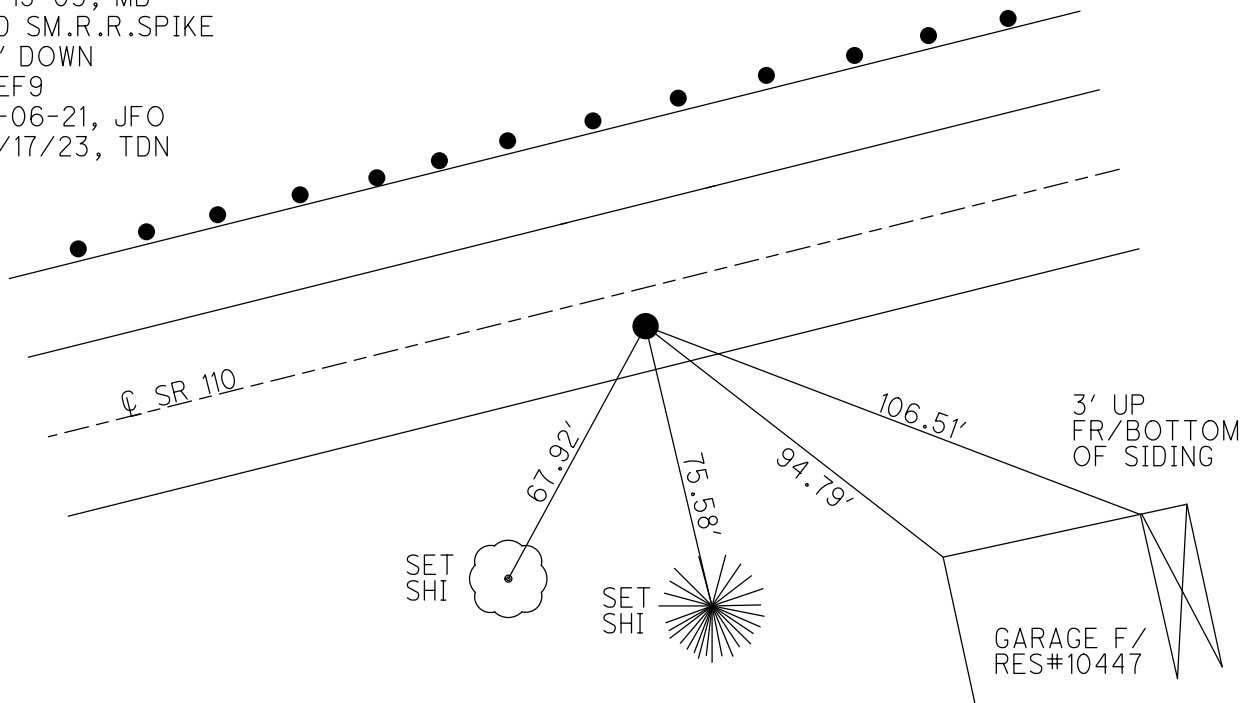

O.D.O.T. DISTRICT 2 SURVEY OFFICE

PERSONNEL

REFERENCE NO. 9


SHEET 11 OF 26

NOTES BRUMBAUGH
 H.C. BARNHISEL
 R.C. RYALL
GLASS

DATE 4-25-03
 WEATHER CLOUD
 TEMP. +60°


ROUTE S.R. 110
 COUNTY HENRY
 TOWNSHIP HARRISON
 SECTION 9
T 5 N R 7 E

TYPE MONUMENT SM. R.R. SPIKE
~~ON SURFACE - BELOW~~ 2"
Q PAV'T - RIGHT 6.5'
5.2' TO RT. EDGE PAVEMENT
 S.L.M. 196+31

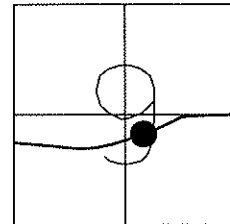

RECORD P.I. STA 201+56.94
 DELTA = 5°-46'-30"
 D = 1°-24'
 T = 206.42'
 L = 412.50'
 E = 5.20'
 R = 4092.56'

RESET MAG NAIL & WASHER
 6-19-03
 MB

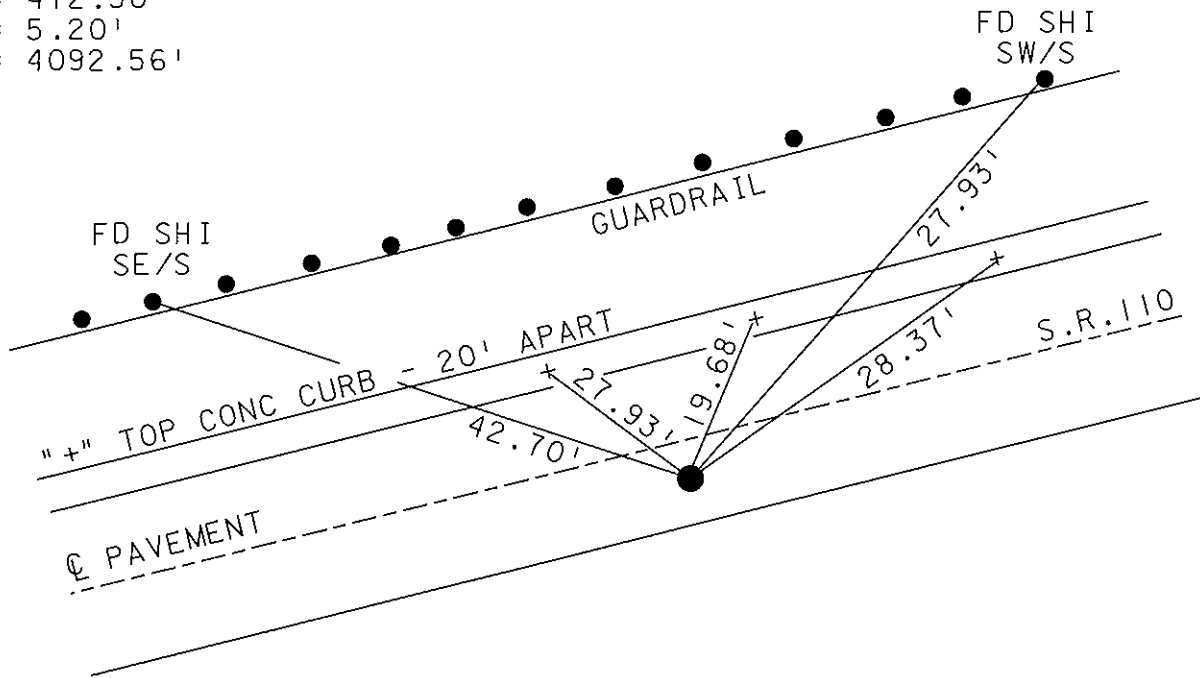

O.D.O.T. DISTRICT 2 SURVEY OFFICE

PERSONNEL

REFERENCE NO. 9

SHEET 19 OF 34

NOTES LOEHRKE

H.C. CURTIS

R.C. ROMERO

DATE 5-28-92

WEATHER CLEAR

TEMP. 602

ROUTE S.R. 110

COUNTY HENRY

TOWNSHIP HARRISON

SECTION 9

T 5 N R 7 E

Set P.K. WASHER
10-27-92


TYPE MONUMENT Sm. R.R Spike

ON SURFACE - BELOW Yes

LEFT - C PAV'T. - RIGHT 5.2

6.9 TO Rt EDGE PAVEMENT

S.L.M. 196 +31

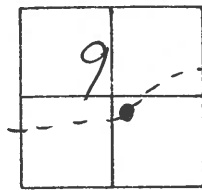

Rec P.I. Sta 201+56.94

$\Delta = 5^{\circ} - 46' - 30''$ Lt.


$D = 1^{\circ} - 24'$

$T = 206.42'$

$L = 412.50'$

$E = 5.20'$

$R = 4092.56'$

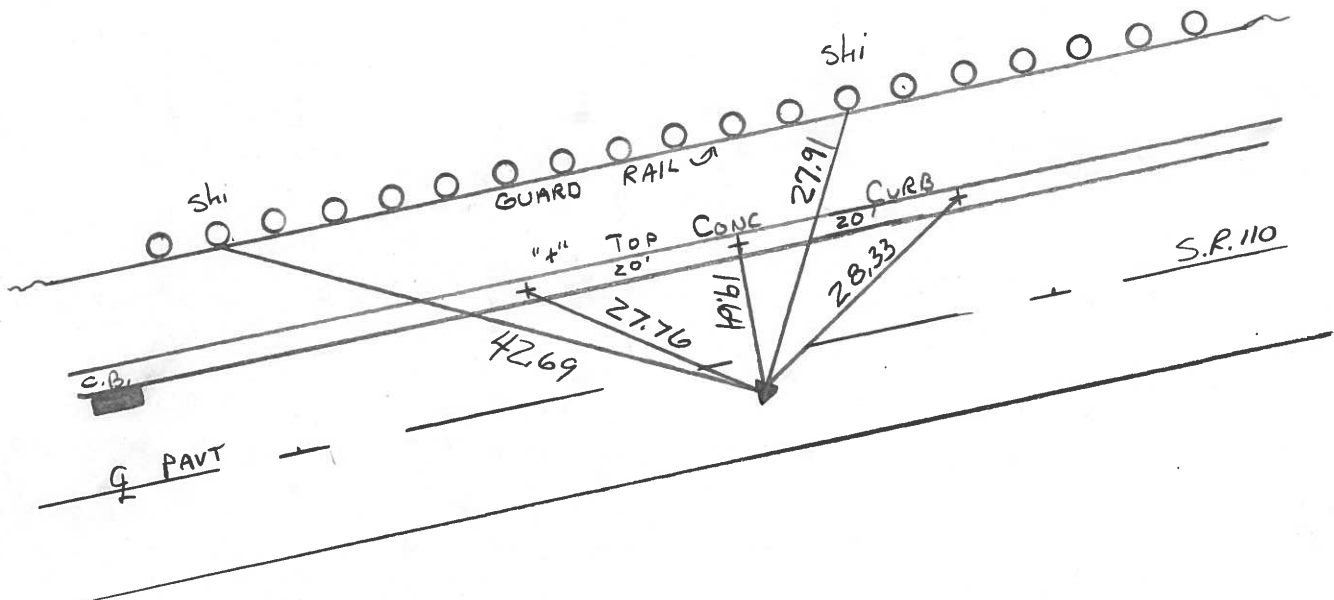

County HENRY S.R. 110

Date 2-6-84

Township HARRISON

Weather CLOUDY

Section 9

Temp. +21°

T5N, R7E


Personnel BARNHISEZ HC

HOUSEHOLDER RC

HOFFMAN

LOENRKE

9

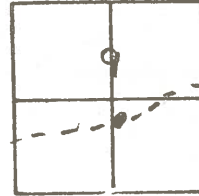

Fd 1" PIPE 1" BELOW SURFACE


SLM 196+42

6.0 TO REP

5.2 Rt of Q PAVT

SET SMALL R.R. SPK.

6/13/84 M.D.B.

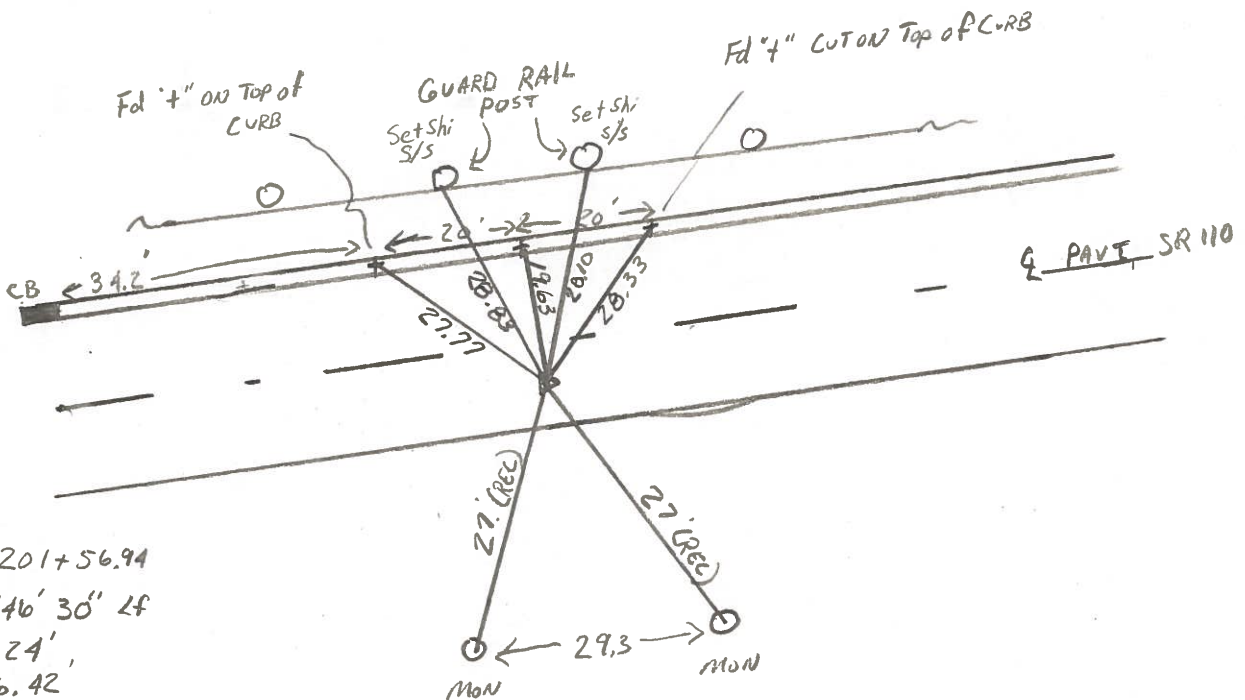

PI STA 201+56.94

$\Delta - 5^{\circ}46'30''$ LF

D - 1°24'

T - 206.42



L - 412.50

E - 520'


R - 4092.56

PERSONNEL TITLE PERSONNEL TITLE COUNTY HENRY DATE Sept 1972
 Red Beach _____
 Newcomb _____
 Knappe _____
 S. R. 110 WEATHER _____
 SEC. 9 Harrison Twp. TEMP. _____

DESCRIPTION CONTROL POINTS JOB NO.

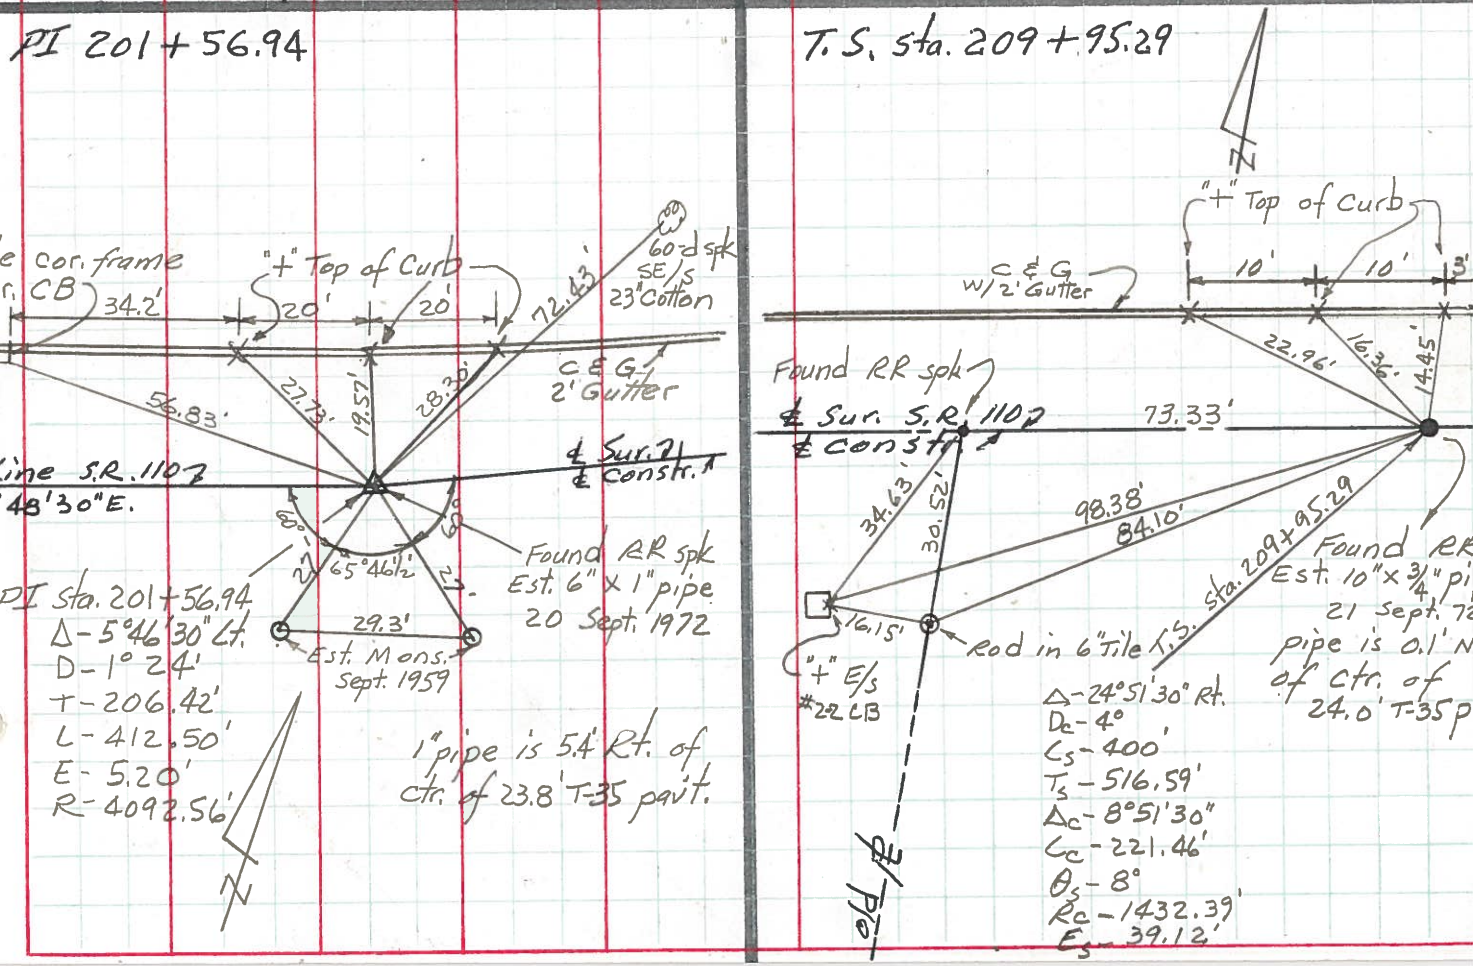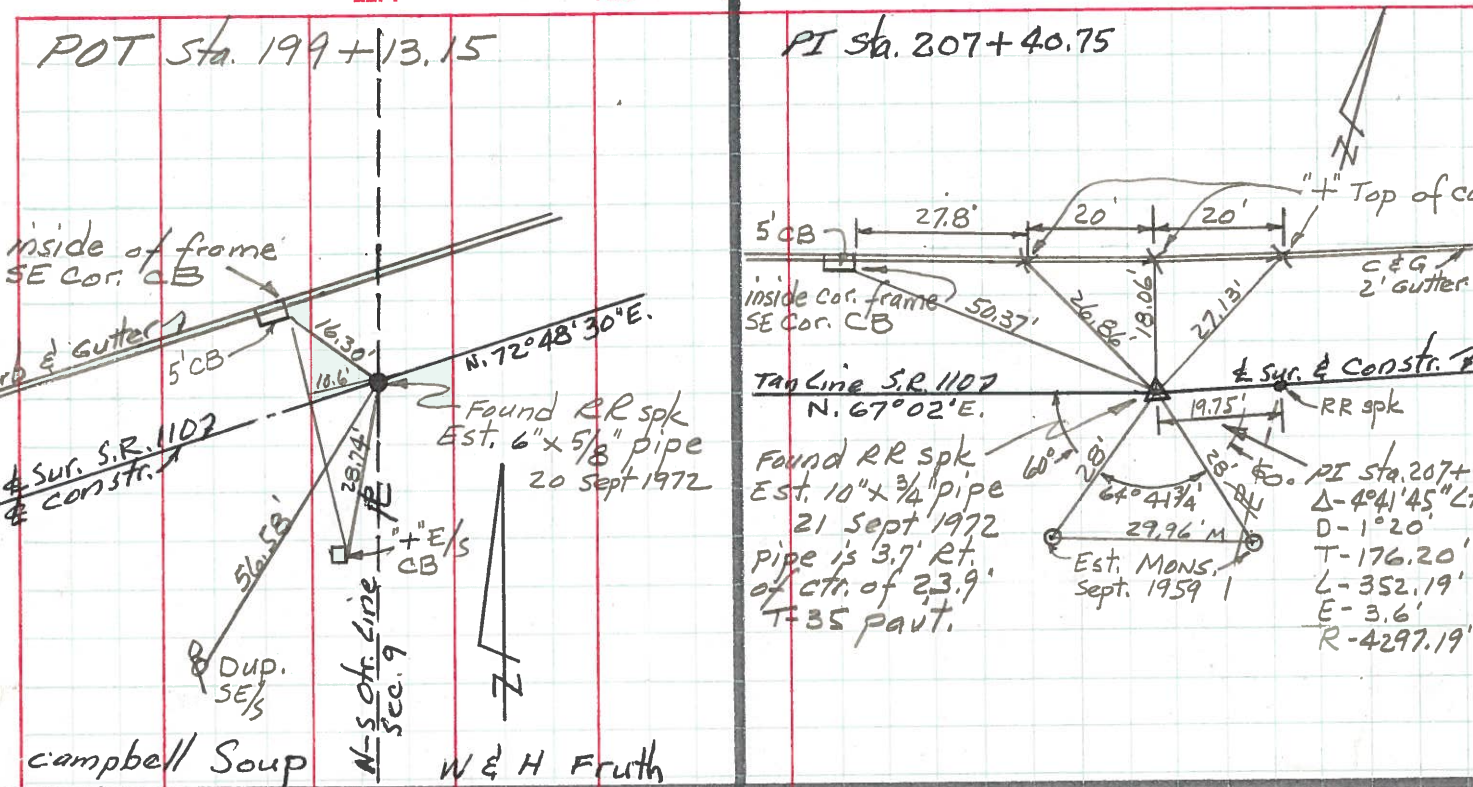

PERSONNEL	TITLE	PERSONNEL	TITLE	COUNTY	Henry	DATE	11-20-58
Ernsthausen				S. R.	110	WEATHER	Clear
Donaldson				SEC.		TEMP.	+50°
Tefft				DESCRIPTION	Ties TO R.I.'s	JOB NO.	

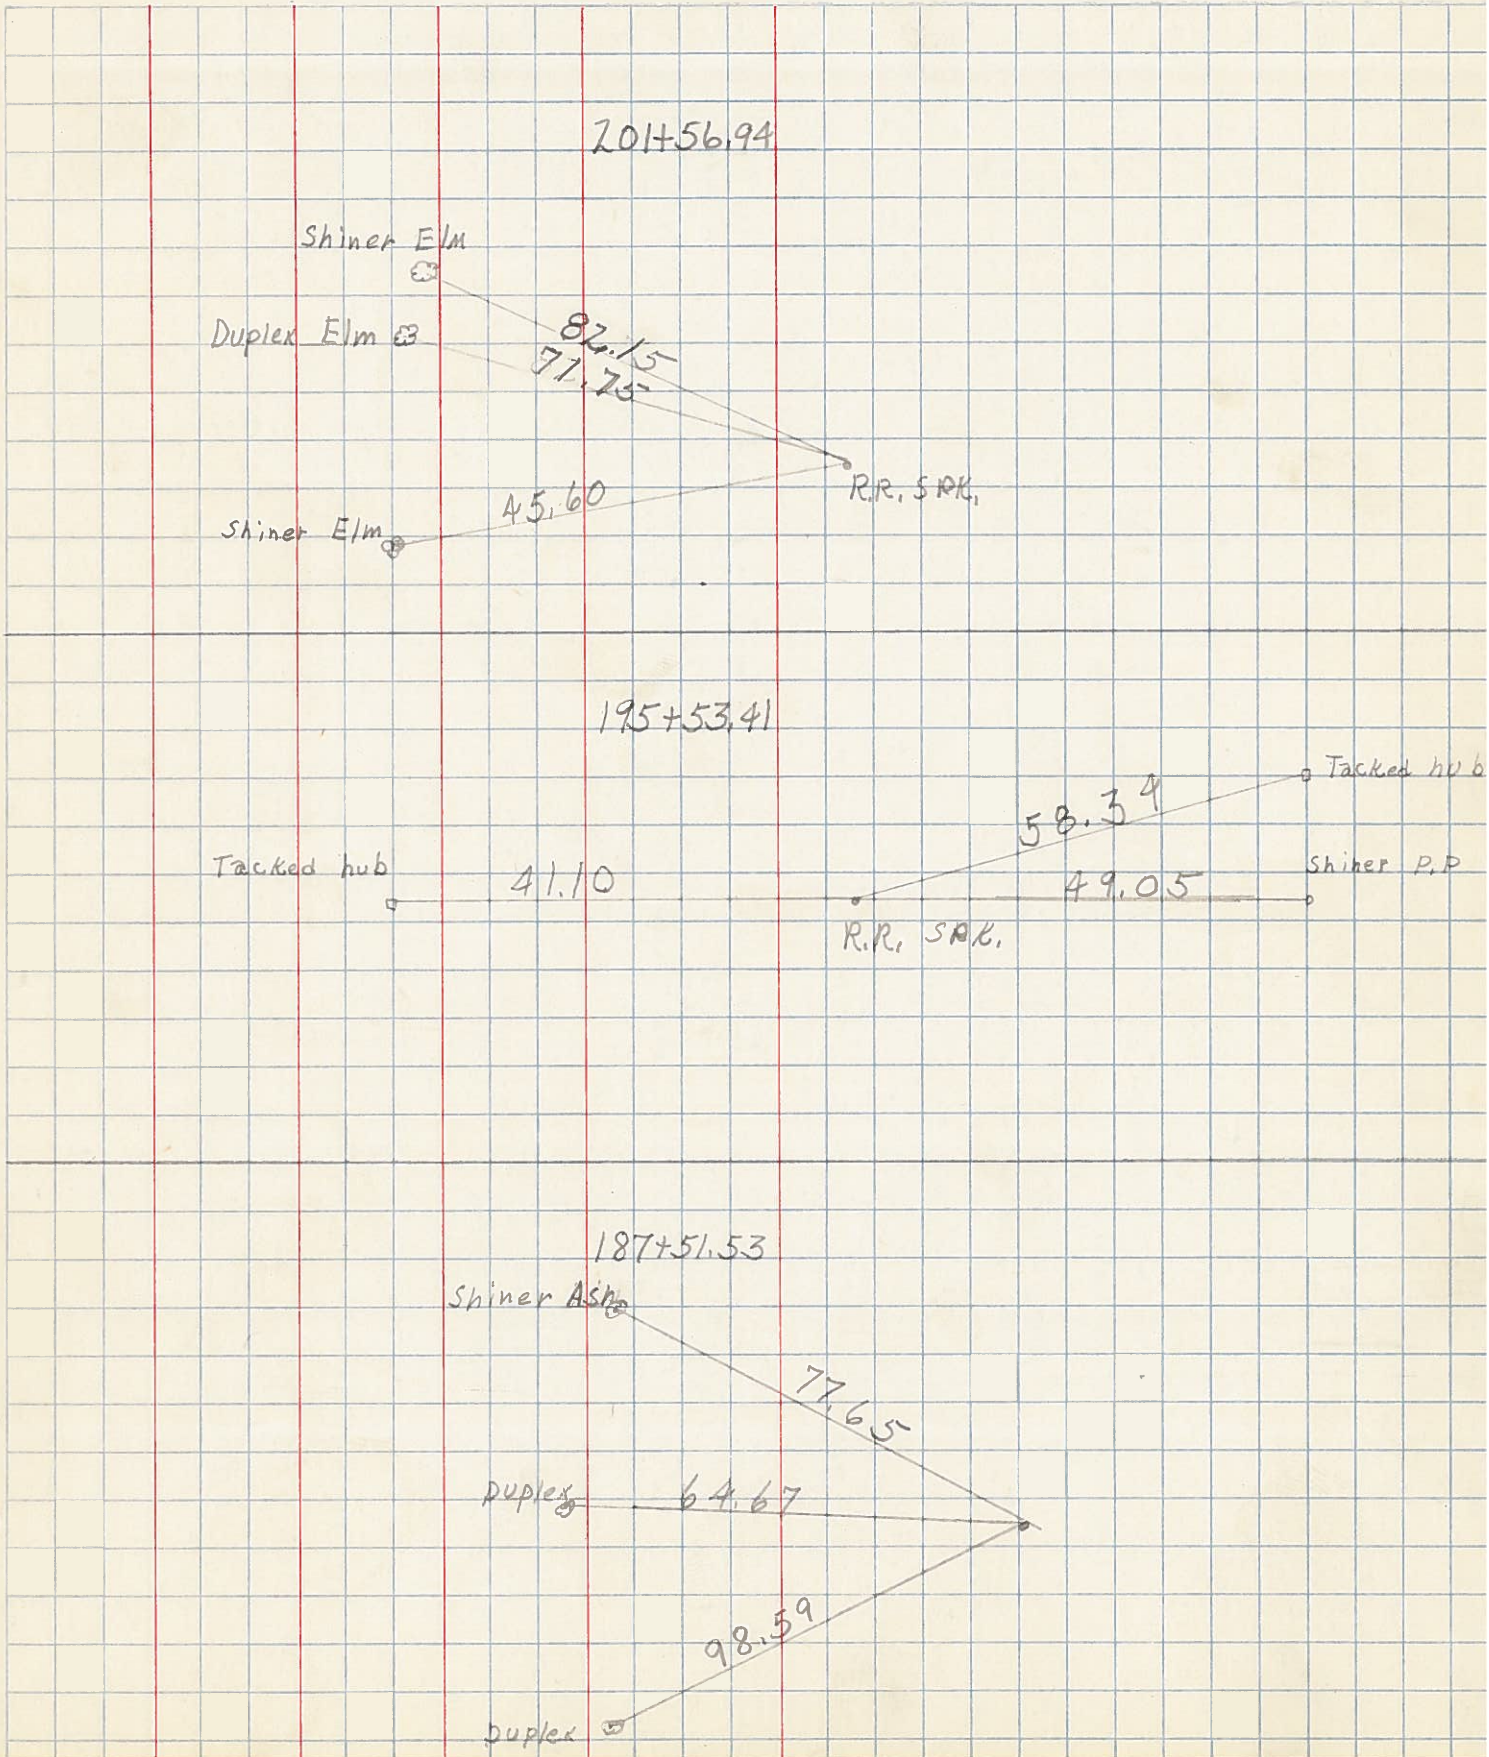

PERSONNEL	TITLE	PERSONNEL	TITLE
Beach		Hoff	
Ambrose		Harris	
Ruffer		Ruchener	
Knape		Delvarthal	

COUNTY Henry DATE Dec. 1957
 S. R. 110 WEATHER _____
 SEC. 2.22 TEMP. _____

DESCRIPTION _____ CONTROL POINTS 3 JOB NO. _____

