


O.D.O.T. DISTRICT 2 SURVEY OFFICE (USE ONLY)


PERSONNEL _____ REFERENCE NO. 9 D SHEET 36 OF 51
 NOTES MILLER DATE 3/13/24 ROUTE SR 110
 H.C. NIESE WEATHER CLEAR COUNTY HENRY
 R.C. RHOADES TEMP. 55° TOWNSHIP HARRISON
 SECTION 9
 DWG BY RHOADES PID 94321 T 5 N R 7 E

TYPE MONUMENT MONBOX W/ 1" IPIN
 ON SURFACE - ~~BELOW~~ ON
 OFFSET Q PAVEMENT ON LT : RT
12.1' TO RT EDGE PAVEMENT
 STATION: 215+04.64

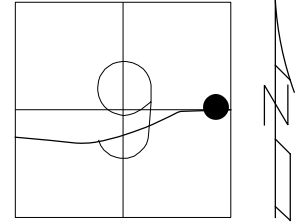

HORIZ.DATUM: NAD83 2011 GEOID: NAVD88 2018
 GRID: NORTHING: 637883.660 EASTING: 1540627.249

RECORD:
 FD MON BOX
 5-27-92, CL
 6-19-03, MD
 FD MONBOX
 W/1" IPIN
 REFD9
 5/6/21, JFO
 8/17/23, TDN
 CKREFD9
 3/13/24, TDN

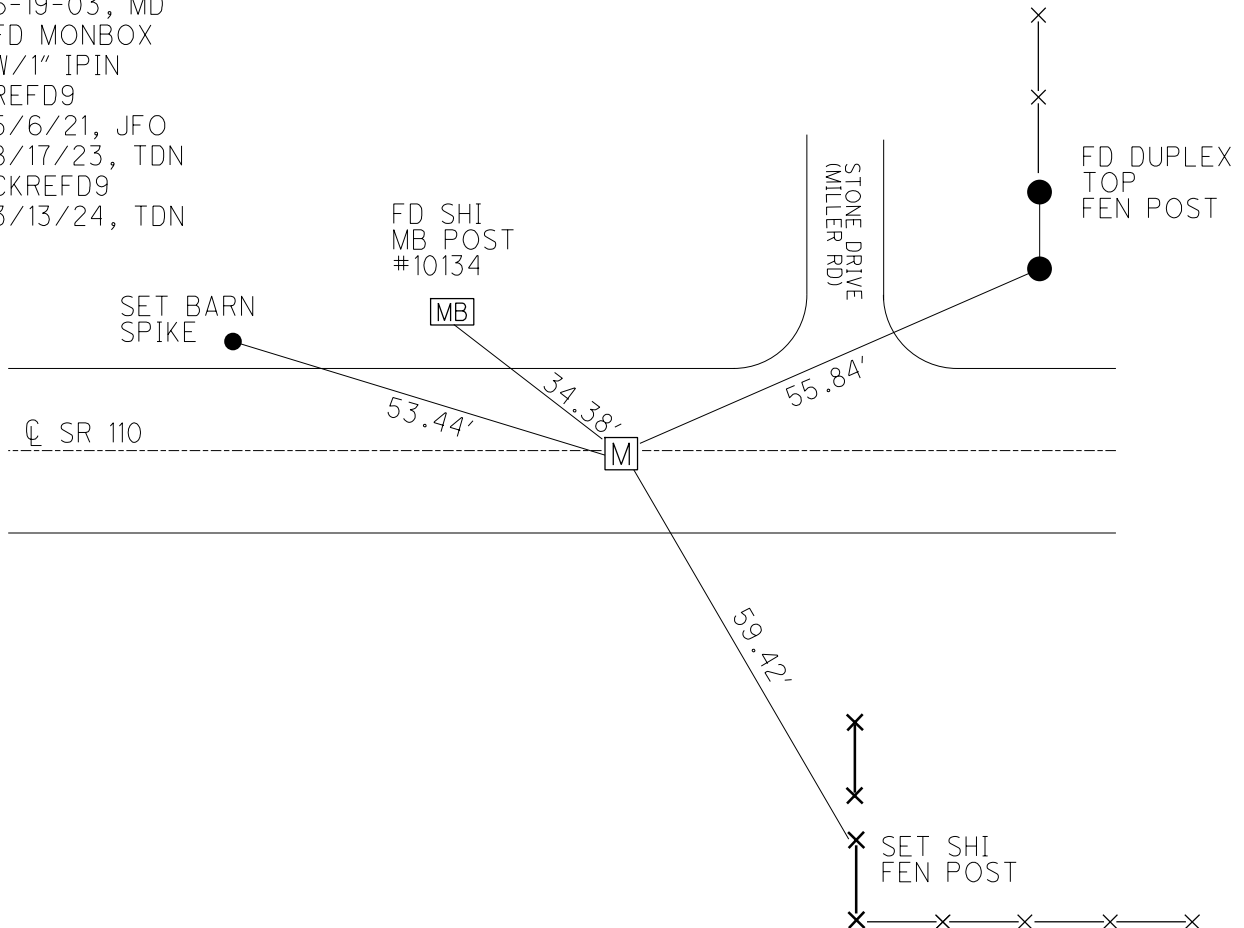


O.D.O.T. DISTRICT 2 SURVEY OFFICE (USE ONLY)


PERSONNEL _____ REFERENCE NO. 9 D SHEET 29 OF 44
 NOTES ASTON DATE 8/17/23 ROUTE SR 110
 H.C. NIESE WEATHER WINDY COUNTY HENRY
 R.C. RHOADES TEMP. 75° TOWNSHIP HARRISON
AUBLE SECTION 9
 DWG BY RHOADES PID 94321 T 5 N R 7 E

TYPE MONUMENT MONBOX W/ 1" IPIN
 ON SURFACE - ~~BELOW~~ ON
 OFFSET Q PAVEMENT ON LT : RT
12.1' TO RT EDGE PAVEMENT
 STATION: 215+04.64

HORZ. DATUM: NAD83 2011 GEOID: NAVD88 2018
 GRID: NORTHING: 637883.678 EASTING: 1540627.230

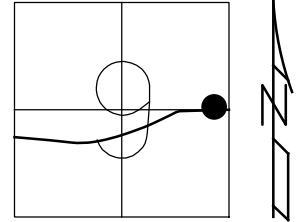

RECORD:
 FD MON BOX
 5-27-92, CL
 6-19-03, MD
 FD MONBOX
 W/1" IPIN
 REFD9
 5/6/21, JFO
 8/17/23, TDN

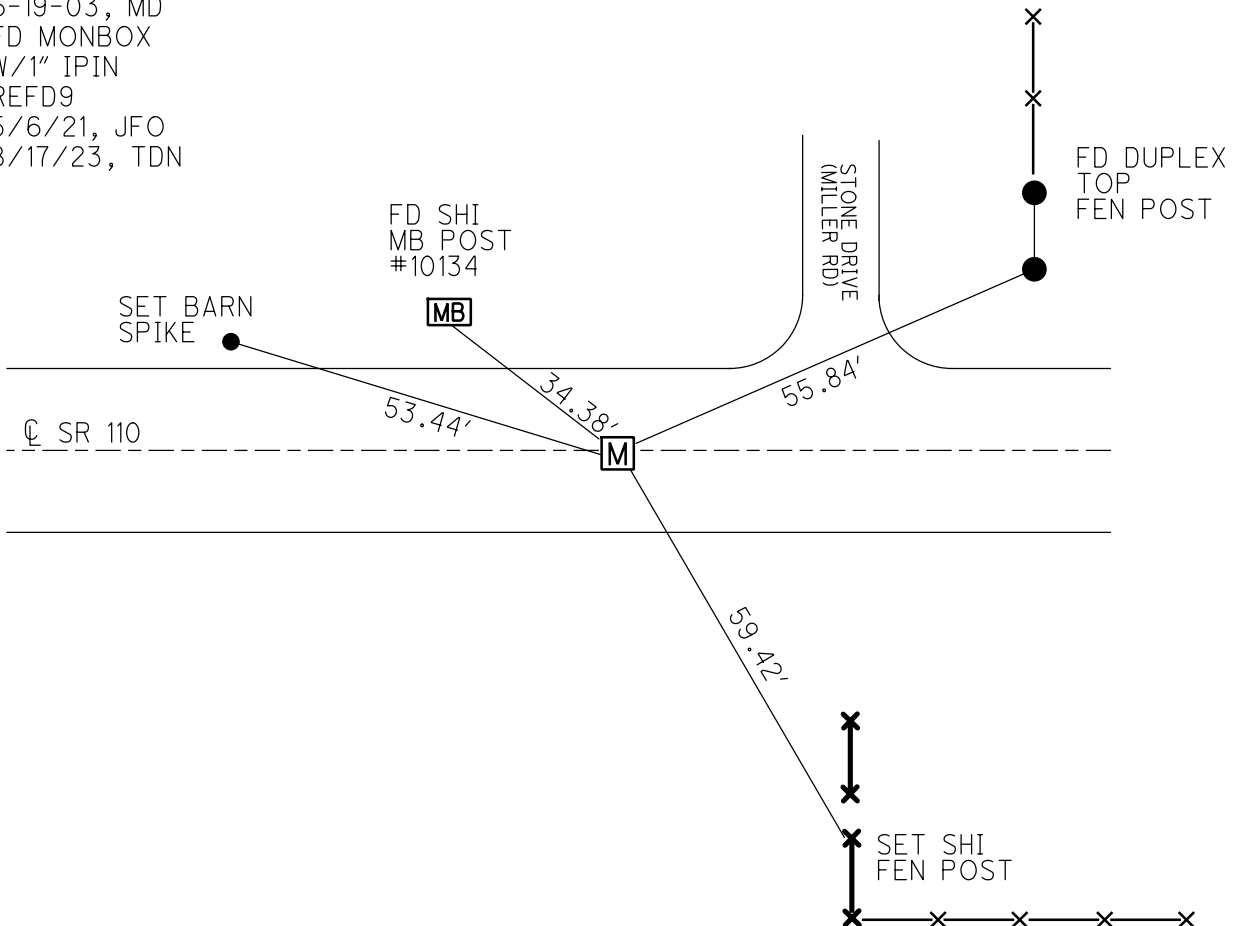

O.D.O.T. DISTRICT 2 SURVEY OFFICE

PERSONNEL

REFERENCE NO. 9-D

SHEET 15 OF 26

NOTES LOEHRKE

DATE 5-27-92

ROUTE S.R. 110

H.C. CURTIS

WEATHER CLEAR

COUNTY HENRY

R.C. ROMETO

TEMP. +60°

TOWNSHIP HARRISON

SECTION 9

T 5 N R 7 E


TYPE MONUMENT MON BOX

ON SURFACE - ~~BELOW~~ YES


~~LEFT-C~~ PAV'T - ~~RIGHT~~ YES

12.1' TO RT. EDGE PAVEMENT

S.L.M. 214+91

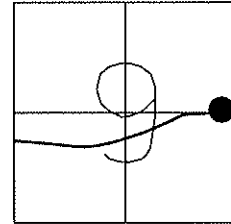

NOTE: DID NOT OPEN BOX.
06-19-03
MD

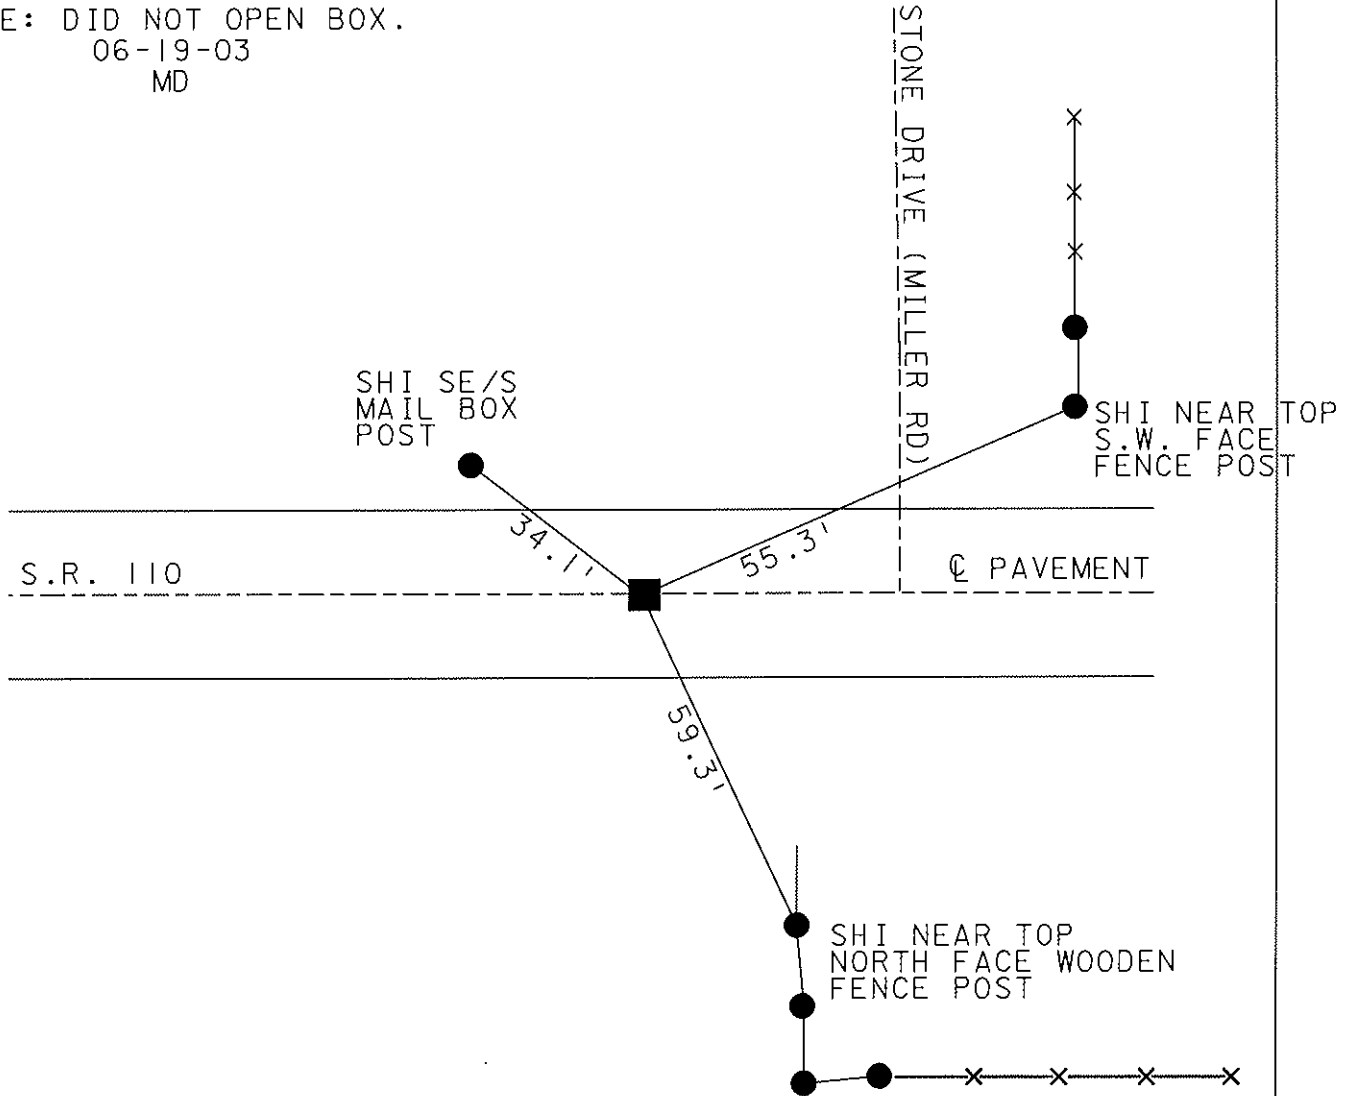

O.D.O.T. DISTRICT 2 SURVEY OFFICE

PERSONNEL _____

REFERENCE NO. 90

SHEET 23 OF 34

NOTES LGHRKE

H.C. CURTIS

R.C. ROMETO

DATE 5-28-92

WEATHER CLEAR

TEMP. +70

ROUTE S.R. 110

COUNTY HENRY

TOWNSHIP HARRISON

SECTION 9

T 5 N 7 E



TYPE MONUMENT Mon Box OK- 10-27-92

ON SURFACE - BELOW Yes

LEFT- & PAV'T. - RIGHT Yes

12.1 TO R4 EDGE PAVEMENT

S.L.M. 214+91

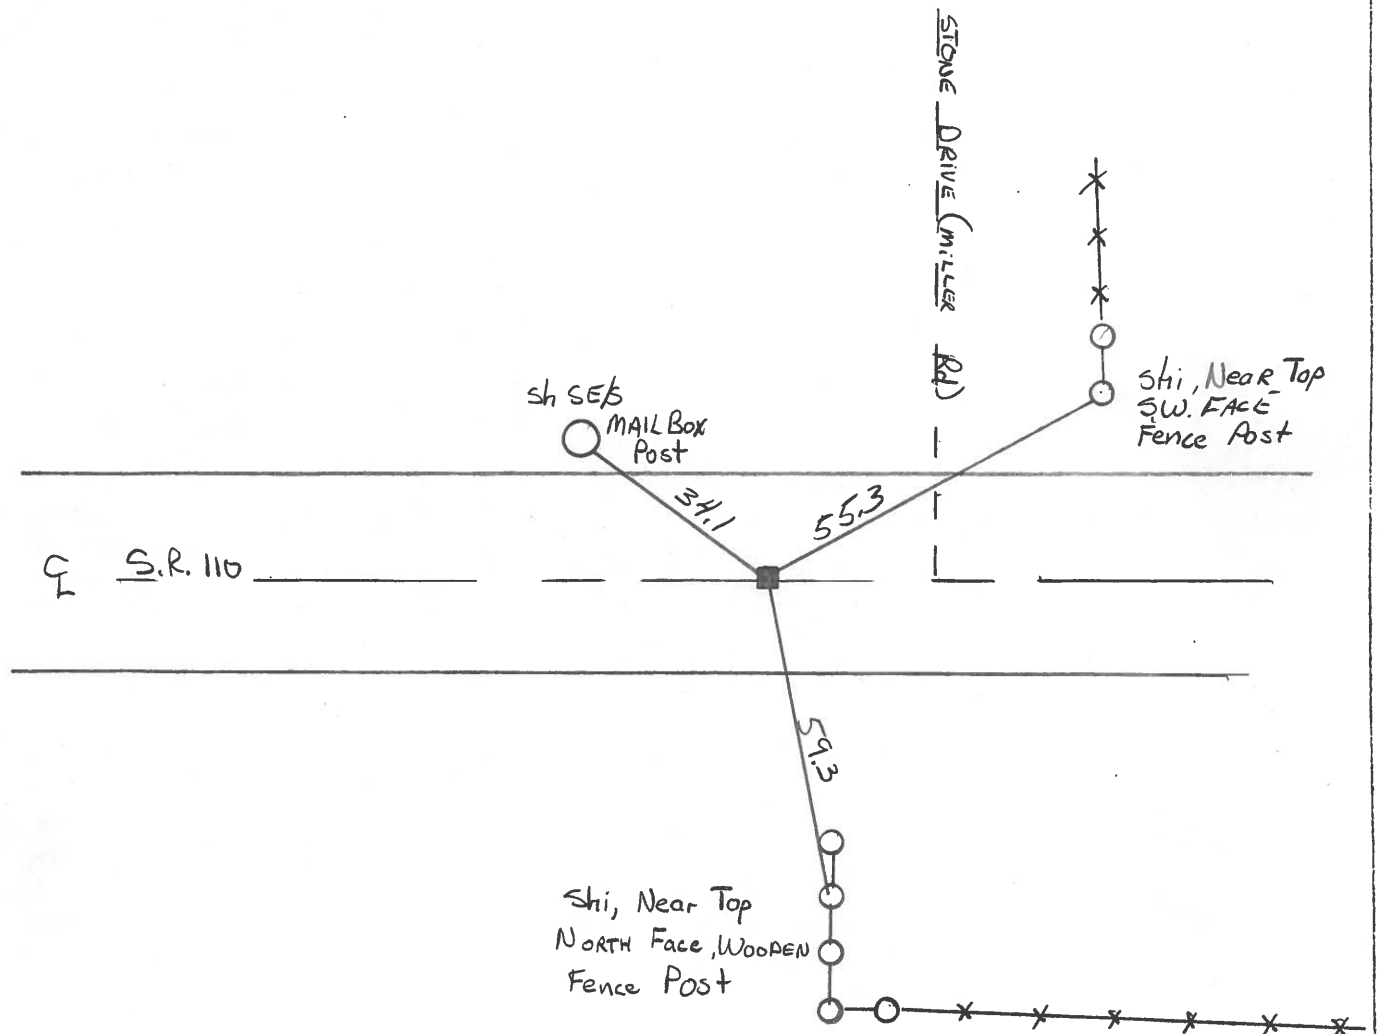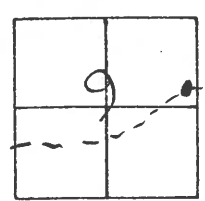

County HENRY S.R. 110

Date 2-7-84

Township HARRISON

Weather Cloudy

Section 9

Temp. +18

T5N, R7E


Personnel BARNHISE HC

HOUSEHOLDER RC

HOFFMAN

LOHRKE

90

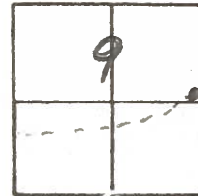

Fd Mon. Box @ SURFACE
DID NOT OPEN, USED REF TO CNTR.

SLM 215101

11.6 to REP
12.0 to LEP
ON & PAVT SR110

ADJUSTED TO GRADE

