


O.D.O.T. DISTRICT 2 SURVEY OFFICE (USE ONLY)


PERSONNEL _____ REFERENCE NO. 10 D SHEET 45 OF 51
 NOTES MILLER DATE 3/13/24 ROUTE SR 110
 H.C. NIESE WEATHER SUNNY COUNTY HENRY
 R.C. RHOADES TEMP. 60° TOWNSHIP HARRISON
 DWG BY RHOADES PID 94321 SECTION 10
 T 5 N R 7 E

TYPE MONUMENT MAG/WASHER
 ON SURFACE - ~~BELOW~~ ON
 OFFSET Q PAVEMENT 0.5' LT : ~~RT~~
12.1' TO LT EDGE PAVEMENT
 STATION: 239+62.01

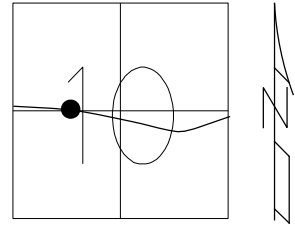

HORZ.DATUM: NAD83 2011 GEOID: NAVD88 2018
 GRID: NORTHING: 637794.396 EASTING: 1543075.533

RECORD:
 FD SM.R.R.SPIKE
 4-28-03, MC
 SET MAG/WASHER
 6-19-03, MB
 FD LG.R.R.SPIKE
 5" DOWN
 REFD10
 5/6/21, JFO
 8/17/23, TDN
 SET MAG/WASHER
 3/13/24, TDN

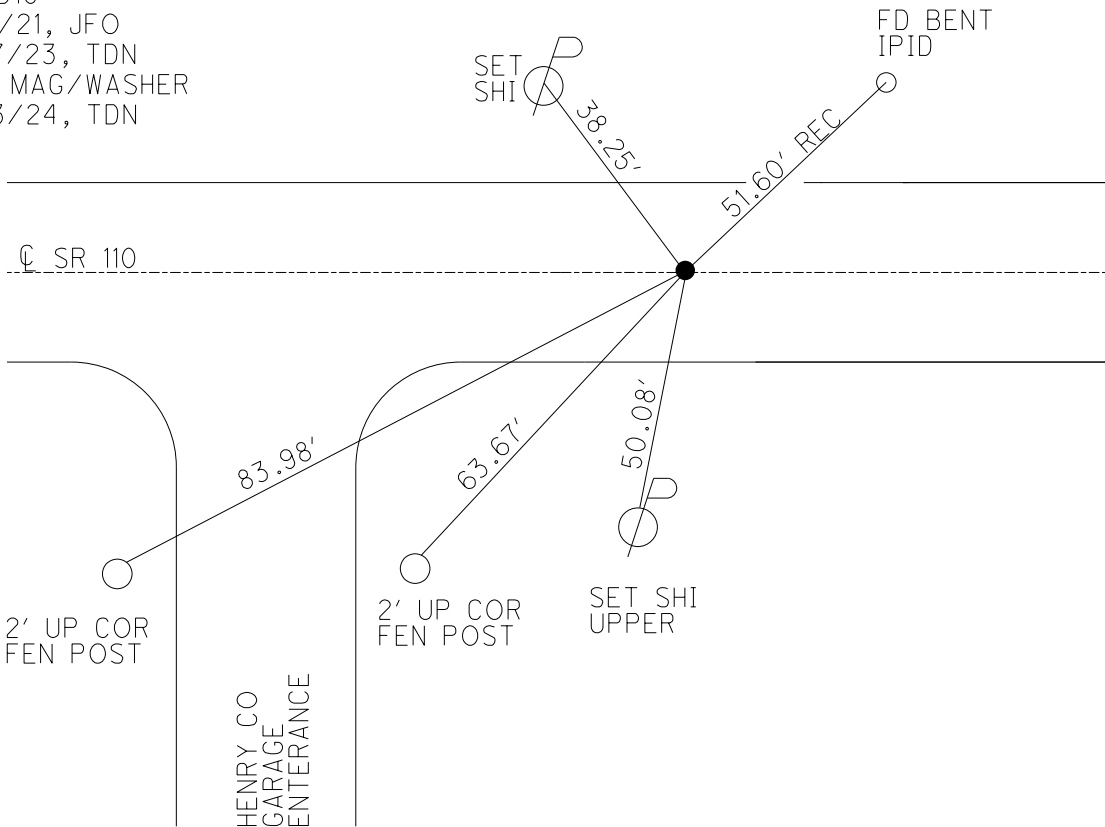

O.D.O.T. DISTRICT 2 SURVEY OFFICE (USE ONLY)

PERSONNEL

REFERENCE NO. 10 D

SHEET 38 OF 44

NOTES ASTON

DATE 8/17/23

ROUTE SR 110

H.C. NIESE

WEATHER WINDY

COUNTY HENRY

R.C. RHOADES
AUBLE

TEMP. 72°

TOWNSHIP HARRISON

SECTION 10

DWG BY RHOADES PID 94321

T 5 N R 7 E

TYPE MONUMENT SM.R.R.SPIKE

~~ON SURFACE~~ - BELOW 5"

OFFSET CL PAVEMENT ON LT : RT

11.8' TO LT EDGE PAVEMENT


STATION: 239+62.01

HORZ.DATUM: NAD83 2011


GEOID: NAVD88 2018

GRID: NORTHING: 637794.396

EASTING: 1543075.533

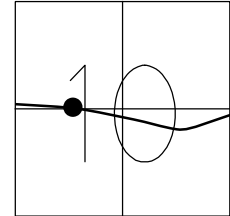

RECORD:
FD SM.R.R.SPIKE
4-28-03, MC
SET MAG/WASHER
6-19-03, MB
FD LG.R.R.SPIKE
5" DOWN
REFD10
5/6/21, JFO
8/17/23, TDN

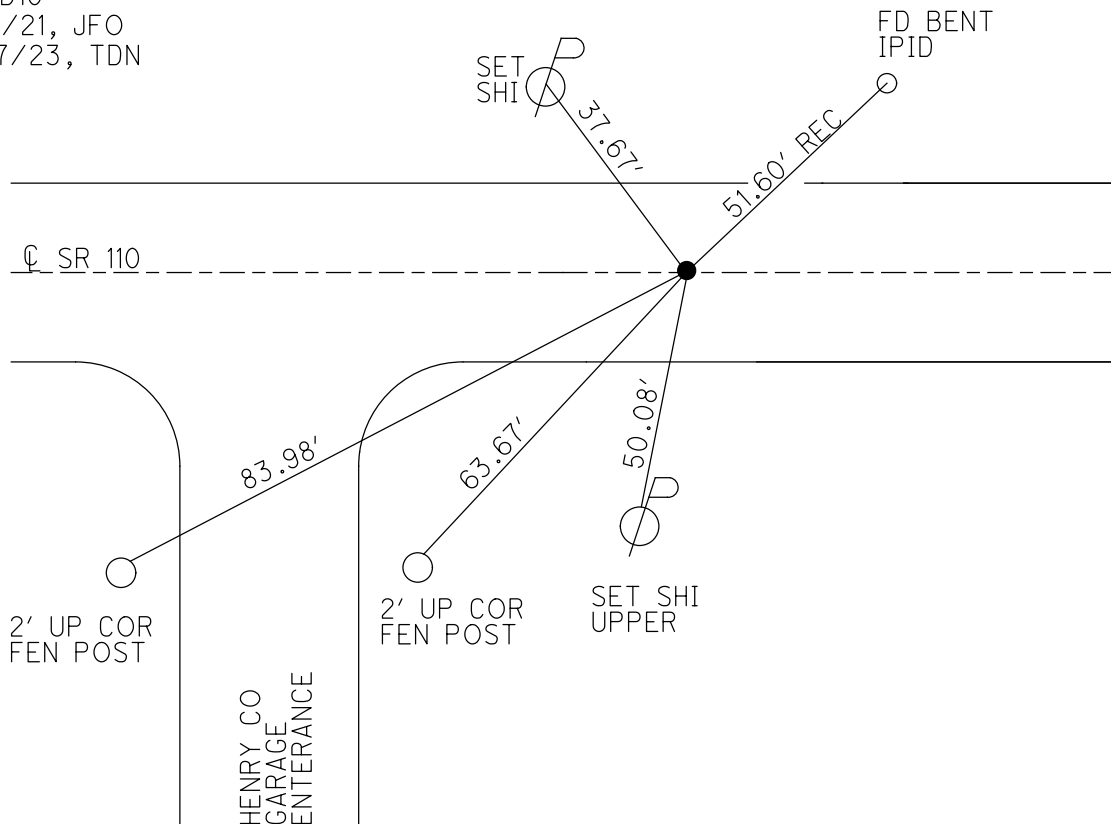

O.D.O.T. DISTRICT 2 SURVEY OFFICE

PERSONNEL _____

REFERENCE NO. 10-D

SHEET 21 OF 26

NOTES CANTERBURY

DATE 4-28-03

ROUTE S.R. 110

H.C. BROWN

WEATHER CLEAR

COUNTY HENRY

R.C. BEAMOUNT

TEMP. +60°

TOWNSHIP HARRISON

SECTION 10

T 5 N R 7 E


TYPE MONUMENT SMALL R.R. SPIKE

~~ON SURFACE~~ - BELOW 1 1/2"


~~LEFT-Ø PAV'T-RIGHT~~ YES

11.8' TO LT. EDGE PAVEMENT

S.L.M. 239+48

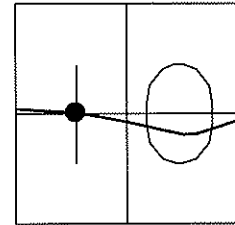

RESET MAG NAIL & WASHER
6-19-03
MB

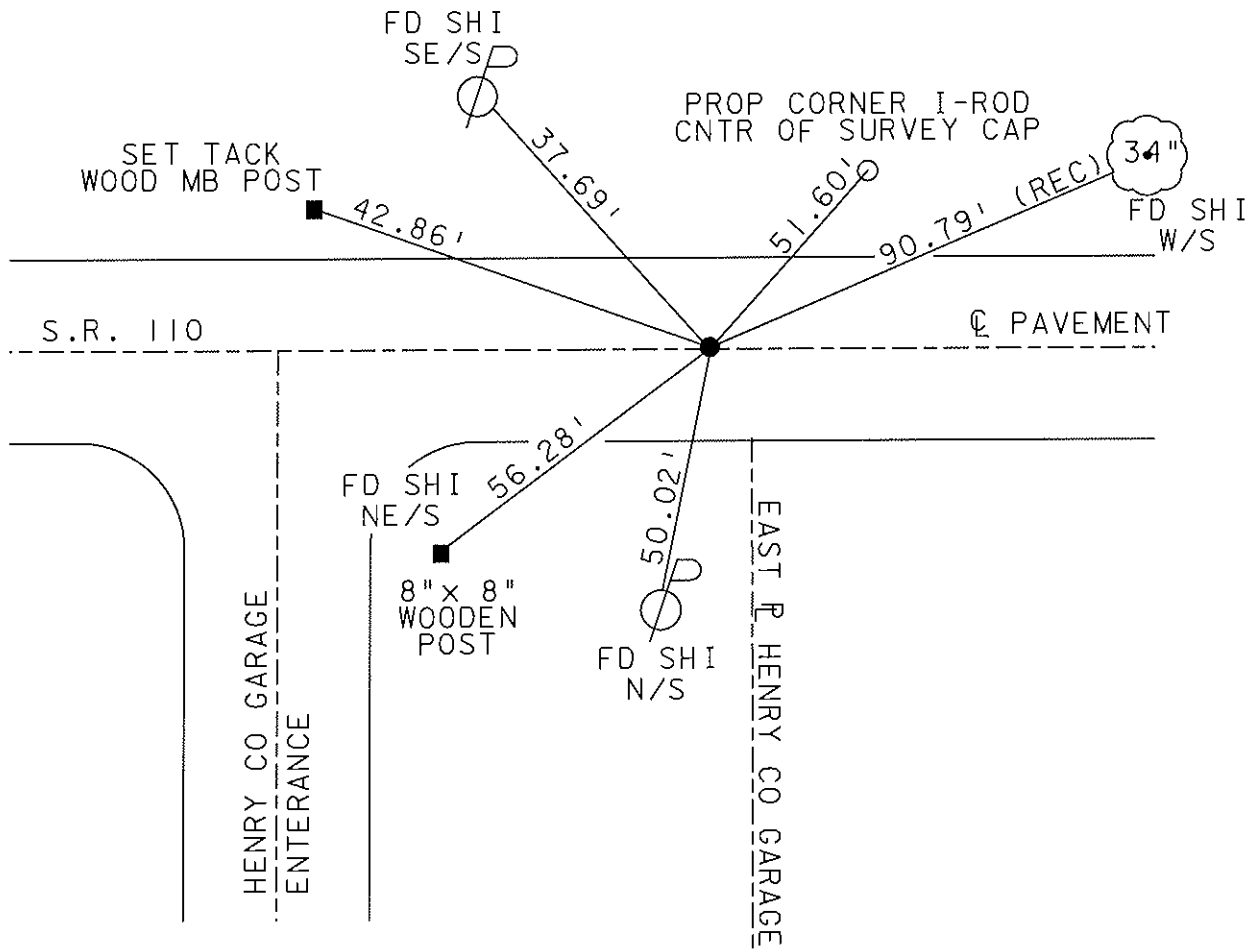

O.D.O.T. DISTRICT 2 SURVEY OFFICE

PERSONNEL

REFERENCE NO. 100

SHEET 29 OF 34

NOTES LOHRKE

H.C. CURTIS

R.C. ROMETO

DATE 5-28-92

WEATHER CLEAR

TEMP. +72

ROUTE S.R. 110

COUNTY HENRY

TOWNSHIP HARRISON

SECTION 10

T5 N R7 E

TYPE MONUMENT R.R. SPIKE



~~ON SURFACE~~ - BELOW 1 1/2 Below

LEFT - & PAV'T. - RIGHT Yes

11.8 TO R4 EDGE PAVEMENT

S.L.M. 239+48

Reset Sm.
R.R. Spike
10-27-92

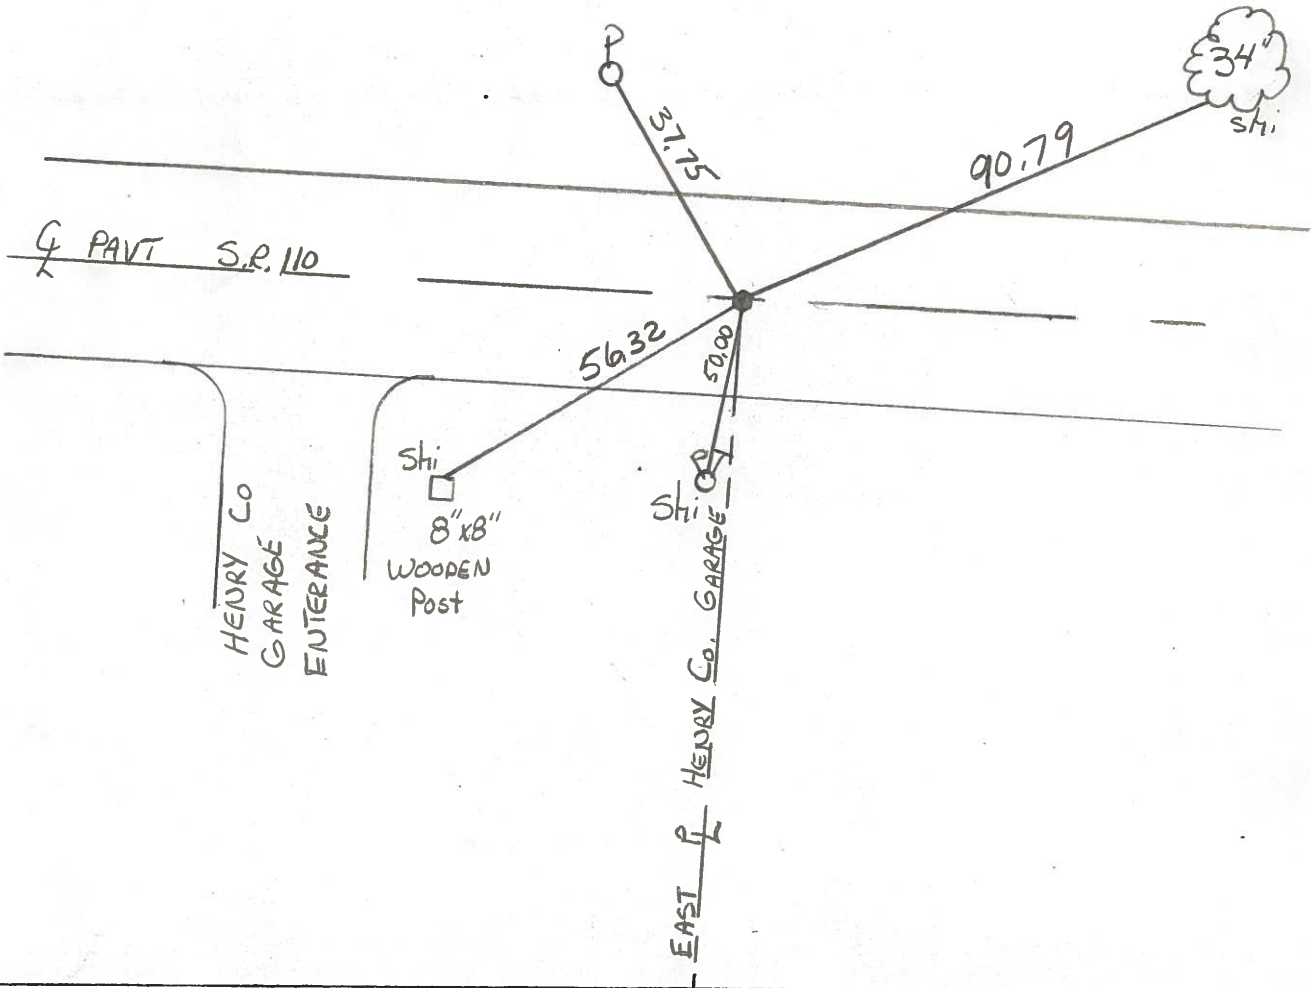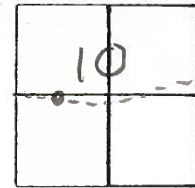

County HENRY S.R. 110

Date 2-8-84

Township HARRISON

Weather CLEAR

Section 10

Temp. +15°

T5N, R2E


Personnel BARNHISEL HC

HOUSEHOLDER RC

HOFFMAN

LOEHRKE

100

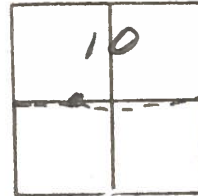

Fd. RR @ SURFACE


SLM 239 +60

0.4 R of Q PAVT SR110

11.7 to REP

11.9 to LEP

SET. P.K./WASHER
6/6/84
S.W.H.

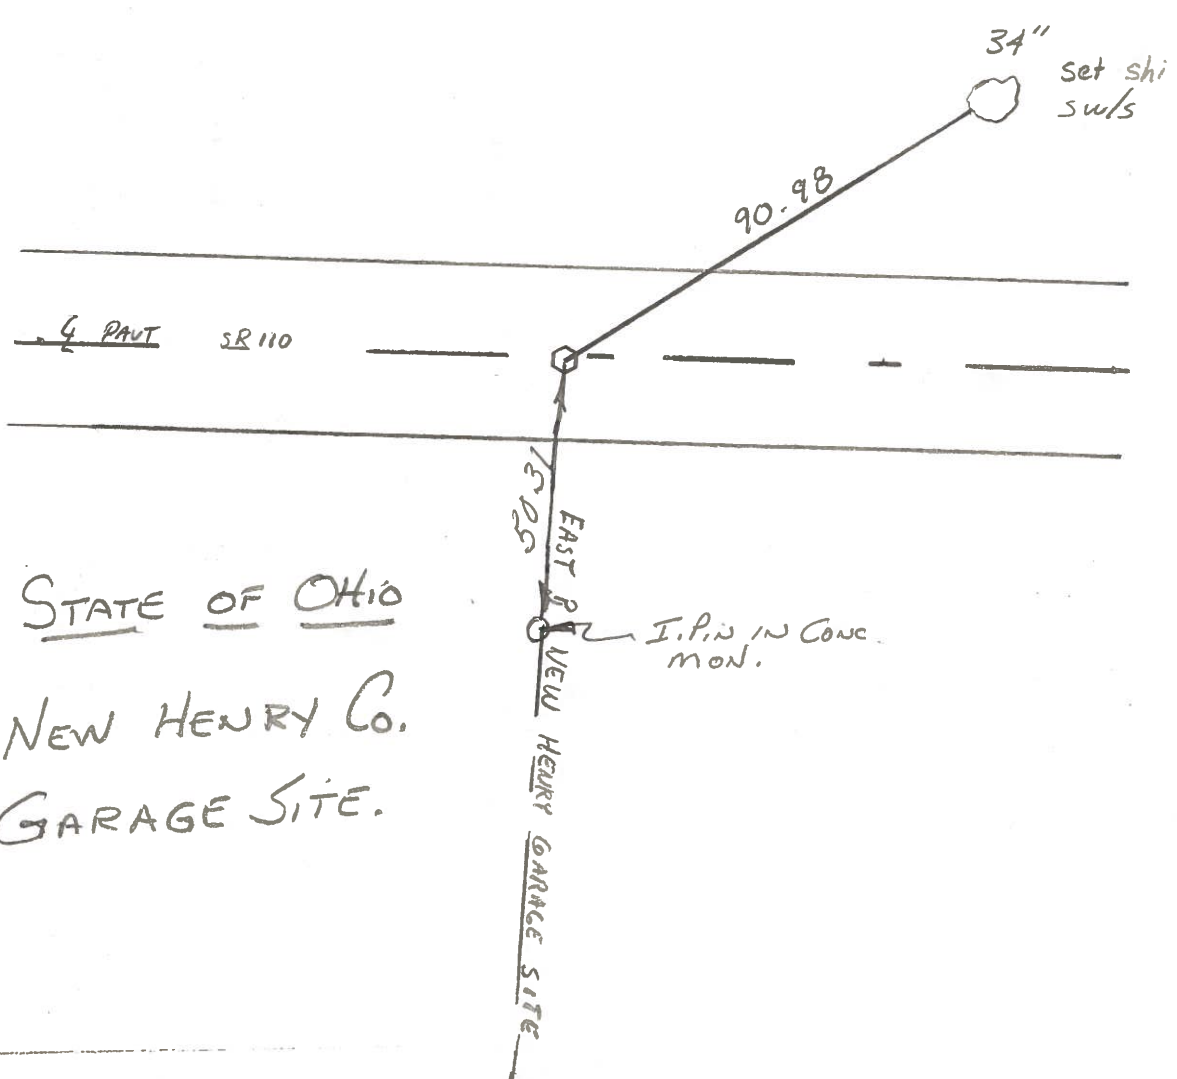

STATE OF OHIO
NEW HENRY CO.
GARAGE SITE.