

O.D.O.T. DISTRICT 2 SURVEY OFFICE (USE ONLY)

PERSONNEL _____

REFERENCE NO. 11 B

SHEET 48 OF 51

NOTES ASTON

DATE 2/9/24

ROUTE SR 110

H.C. NIESE

WEATHER WINDY

COUNTY HENRY

R.C. ASTON

TEMP. 60°

TOWNSHIP HARRISON

SECTION 10

DWG BY RHOADES

PID 94321

T 5 N R 7 E

TYPE MONUMENT MAG/WASHER

ON SURFACE - ~~BELOW~~ ON

OFFSET ☉ PAVEMENT ON _____ LT : RT

12.0' TO RT EDGE PAVEMENT


STATION: 255+29.16

HORIZ.DATUM: NAD83 2011

GEOID: NAVD88 2018


GRID: NORTHING: 637533.232

EASTING: 1544619.870

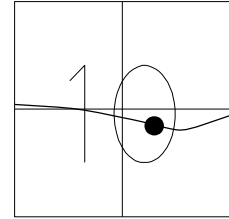

RECORD: T.S.
 STA: 260+48.22
 FD P.K.WASHER
 4-28-03, MC
 SET MAG/WASHER
 6-23-03, MB
 FD MAG/WASHER
 REFB11
 5/6/21, JFO
 8/17/23, TDN
 SET MAG/WASHER
 2/9/24, TDN


SET NOTCHES
 1ST BR RAIL
 POSTS

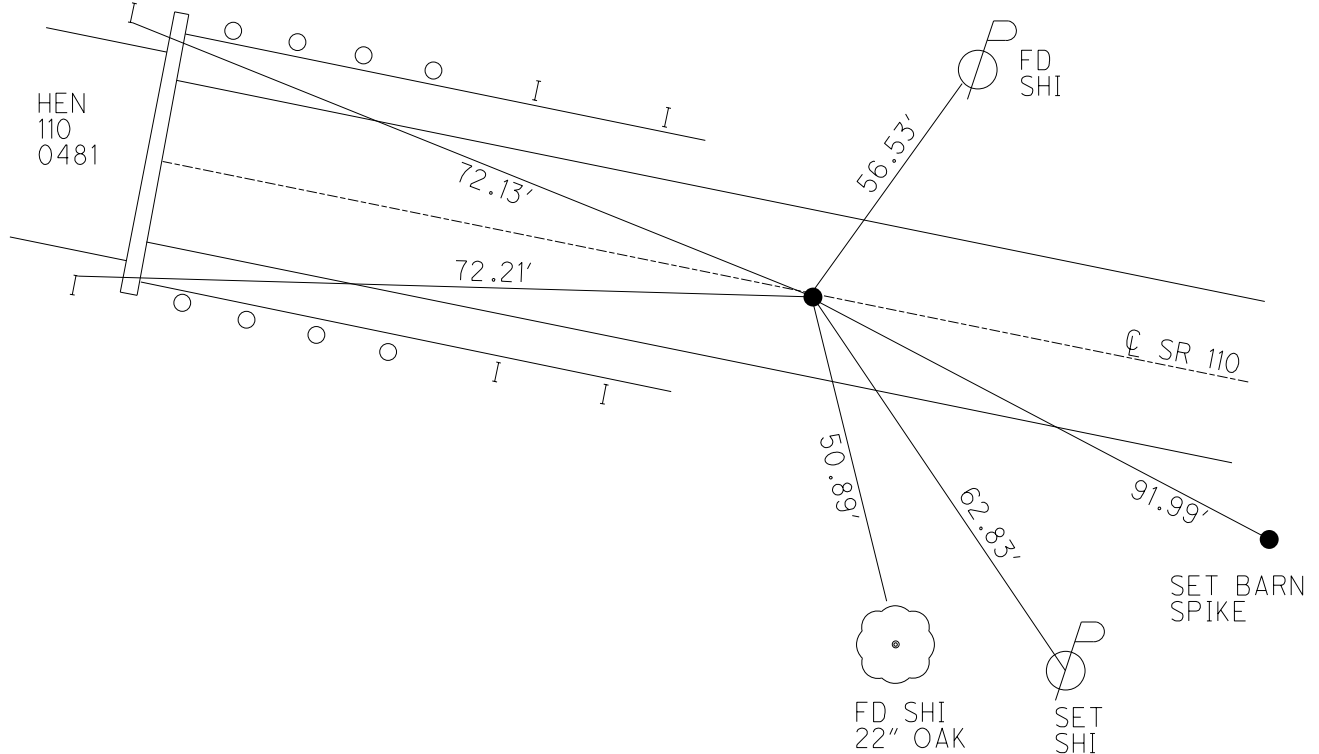

O.D.O.T. DISTRICT 2 SURVEY OFFICE (USE ONLY)


PERSONNEL _____ REFERENCE NO. 11 B SHEET 41 OF 44
 NOTES ASTON DATE 8/17/23 ROUTE SR 110
 H.C. NIESE WEATHER BREEZY COUNTY HENRY
 R.C. RHOADES TEMP. 72° TOWNSHIP HARRISON
AUBLE SECTION 10
 DWG BY RHOADES PID 94321 T 5 N R 7 E

TYPE MONUMENT MAG/WASHER
 ON SURFACE - ~~BELOW~~ ON
 OFFSET \varnothing PAVEMENT ON LT : RT
12.0' TO RT EDGE PAVEMENT
 STATION: 255+29.16

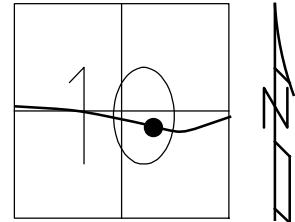

HORZ.DATUM: NAD83 2011 GEOID: NAVD88 2018
 GRID: NORTHING: 637533.232 EASTING: 1544619.870

RECORD: T.S.
 STA: 260+48.22
 FD P.K.WASHER
 4-28-03, MC
 SET MAG/WASHER
 6-23-03, MB
 FD MAG/WASHER
 REFB11
 5/6/21, JFO
 8/17/23, TDN

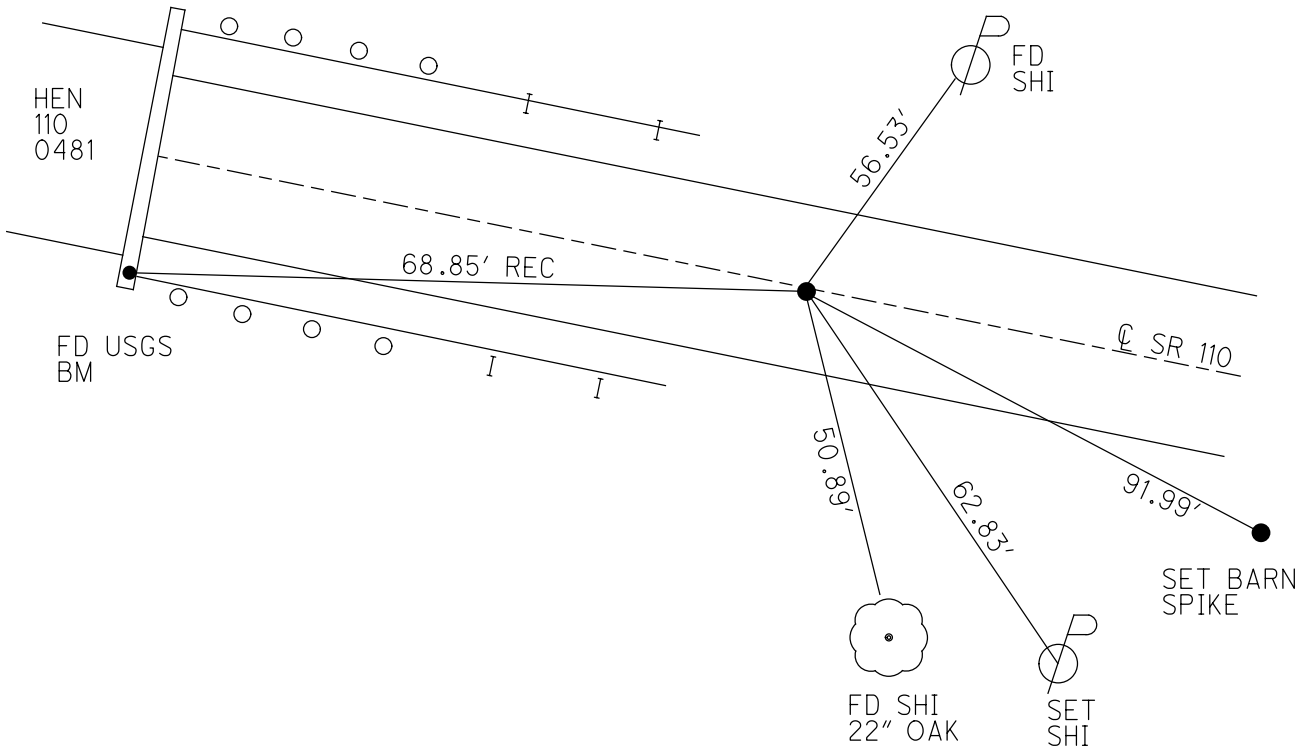

O.D.O.T. DISTRICT 2 SURVEY OFFICE

PERSONNEL

REFERENCE NO. 11-B

SHEET 24 OF 26

NOTES CANTERBURY

DATE 4-28-03

ROUTE S.R. 110

H.C. BROWN

WEATHER FAIR

COUNTY HENRY

R.C. BEAMOUNT

TEMP. +60°

TOWNSHIP HARRISON

SECTION 10

T 5 N R 7 E


TYPE MONUMENT P.K. / WASHER

ON SURFACE - ~~BELOW~~ YES

~~LEFT-C~~ PAV'T - ~~RIGHT~~ YES


12.0' TO RT. EDGE PAVEMENT

S.L.M. 255+15

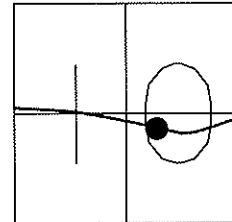

RECORD = T.S.
STA: 260+48.22

RESET MAG NAIL & WASHER
6-23-03
MB

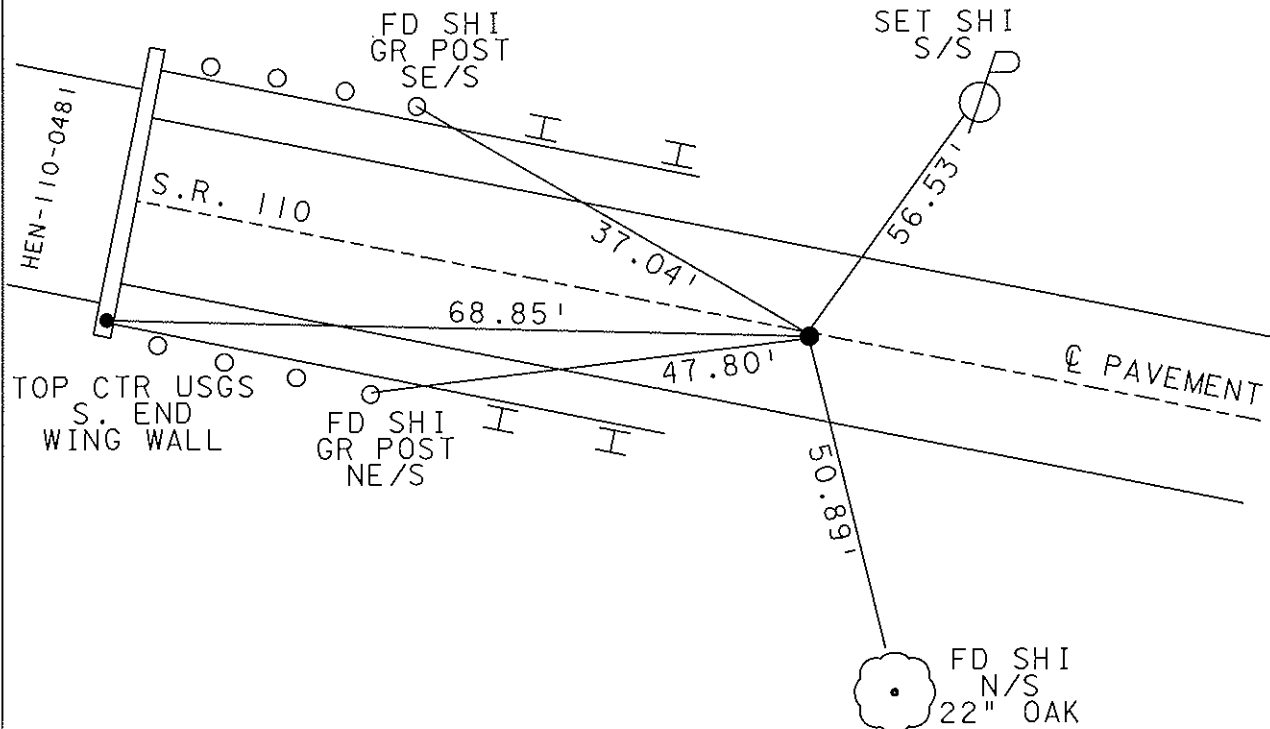


O.D.O.T. DISTRICT 2 SURVEY OFFICE

PERSONNEL _____ REFERENCE NO. 11B SHEET 32 OF 34
 NOTES Loehrke
 H.C. CURTIS DATE 9-28-92 ROUTE S.R. 110
 R.C. ROMETO WEATHER Cloudy COUNTY HENRY
 _____ TEMP. +65 TOWNSHIP HARRISON
 _____ SECTION 10


T 5 N R 7 E

TYPE MONUMENT Sm. R.R. Spike
 ON SURFACE - BELOW Yes
~~LEFT - & PAV'T. - RIGHT~~ Yes
12.10 TO Rt EDGE PAVEMENT
 S.L.M. 255 +15

Set P.K./WASHER
 10-27-92

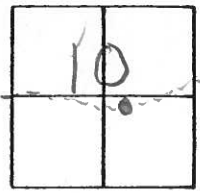

REC. T.S.
 Sta 260+48.22

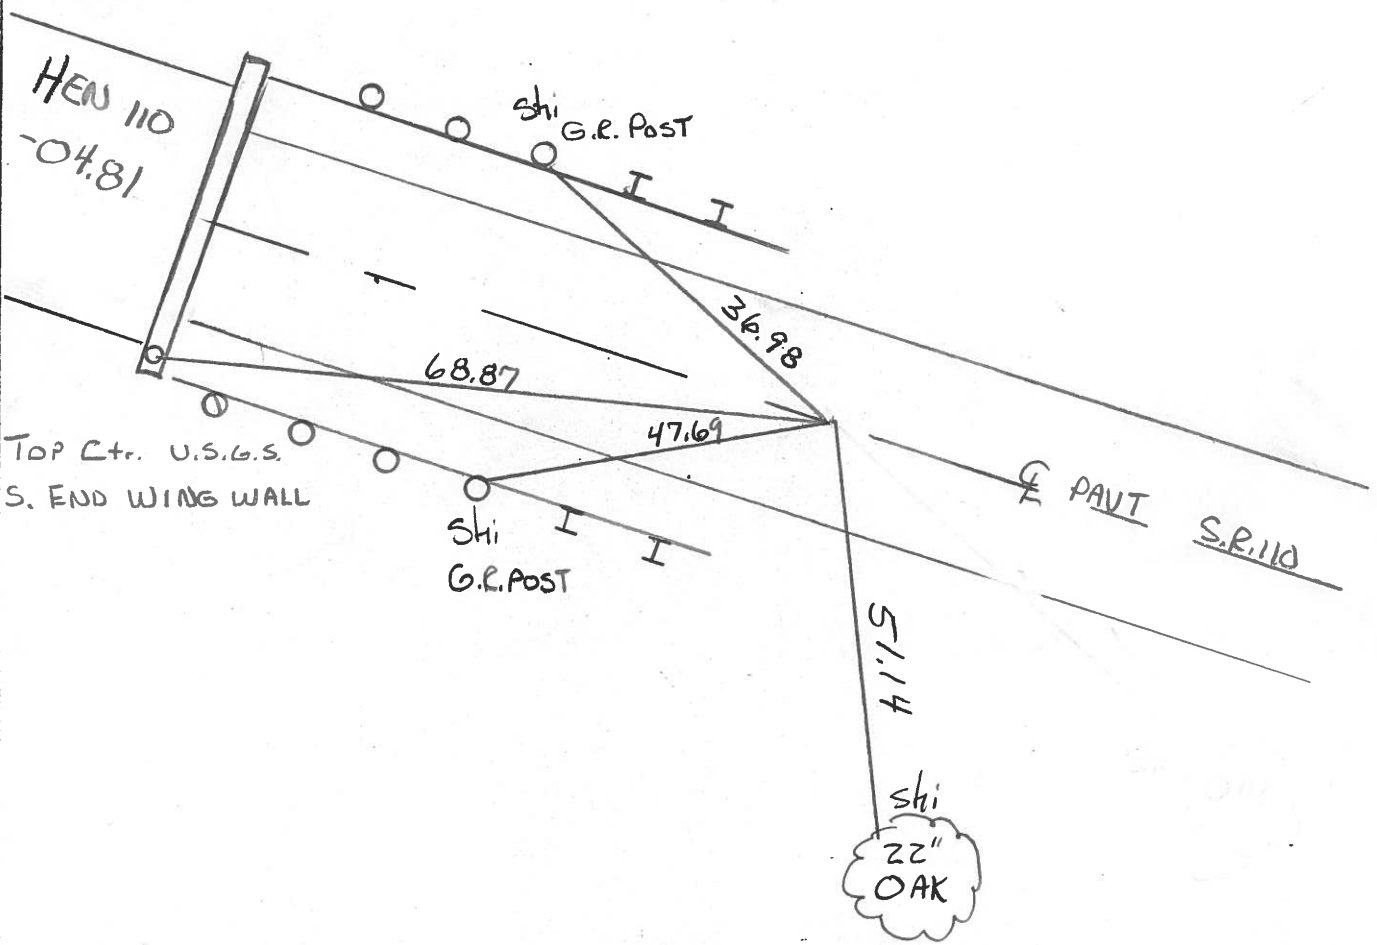

PERSONNEL TITLE PERSONNEL TITLE

Red Beach
Newcomb
Knape

COUNTY HENRY DATE Oct 1972

S. R. 110 WEATHER

SEC. Harrison Twp TEMP.

DESCRIPTION CONTROL POINTS JOB NO.

