

O.D.O.T. DISTRICT 2 SURVEY OFFICE (USE ONLY)

PERSONNEL

REFERENCE NO. 13 E

SHEET 7 OF 6

NOTES ASTON DATE 5/25/23
 H.C. AUBLE WEATHER CLOUDY
 R.C. MILLER TEMP. 54°

ROUTE SR 110
 COUNTY HENRY
 TOWNSHIP HARRISON
 SECTION 11
 T 5 N R 7 E

DWG BY RHOADES PID PAVETRAIN

TYPE MONUMENT MAG NAIL


ON SURFACE - ~~BELOW~~ ON

OFFSET \odot PAVEMENT 1.7' ~~±~~ : RT
9' TO RT EDGE PAVEMENT

STATION: 314+53.82


HORIZ.DATUM: NAD83 2011 GEOID: NAVD88 2018

GRID: NORTHING: 637429.609 EASTING: 1550572.496

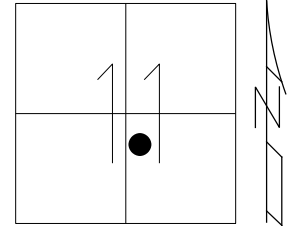

NOTE: REF 37 SR 109


RECORD: P.I.
 STA. 914+09
 $\Delta = 5^\circ 45' \text{ LT}$
 FD SM.R.R.SPIKE
 2" DOWN
 3/23/84, SWH
 SET P.K./WASHER
 8/24/84, SWH
 FD P.K./WASHER
 8/13/02, DCH
 SET MAG/WASHER
 12/2/02, DCH
 FD HOLE
 REFE13
 8/31/15, JFO
 SET MAG NAIL
 REF13E
 5/25/23, DSA

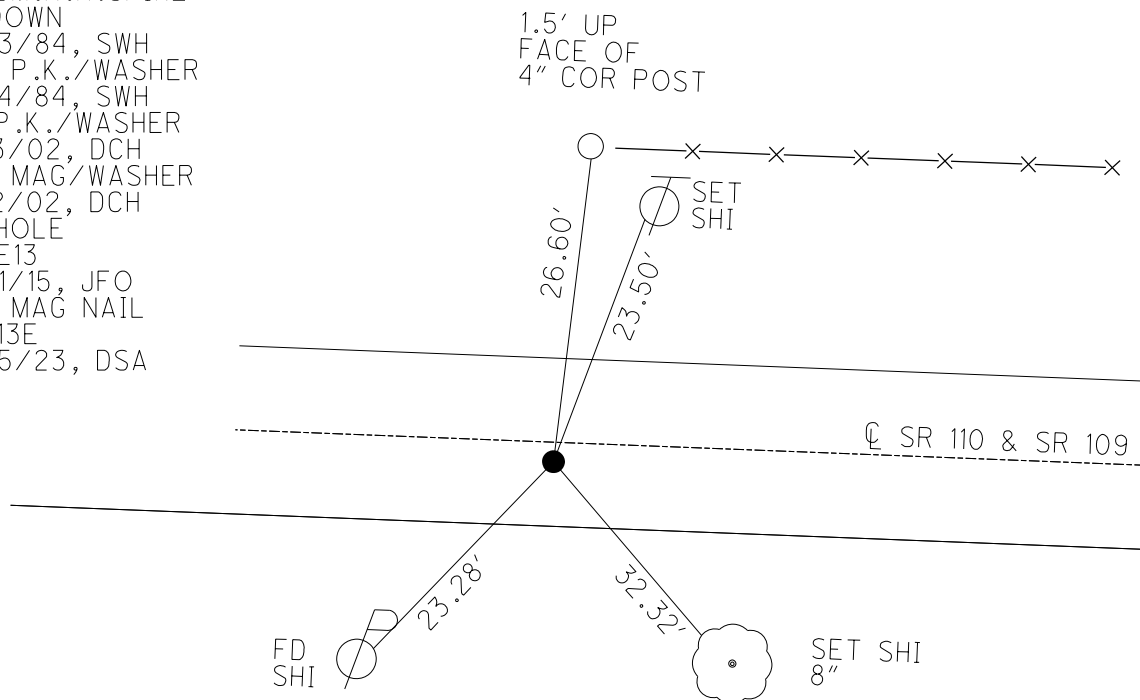


O.D.O.T. DISTRICT 2 SURVEY OFFICE (USE ONLY)

PERSONNEL _____ REFERENCE NO. 13 E SHEET 8 OF 58
 NOTES HOMAN DATE 08/13/02 ROUTE SR 110
 H.C. ROUSOS WEATHER CLOUDY COUNTY HENRY
 R.C. BEAUMONT TEMP. 80° TOWNSHIP HARRISON
 _____ SECTION 11
 _____ T 5 N R 7 E

TYPE MONUMENT _____ PK/WASHER _____
 ON SURFACE - ~~BELOW~~ _____ ON _____
~~LEFT - C PAV'T~~ - RIGHT 1.7'
9' TO RT EDGE PAVEMENT
 S.L.M. 331+34
 Grid: Northing: _____ Easting: _____

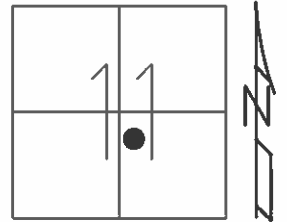

RECORD: P.I.
 $\Delta=5^{\circ}45'00''$ LT
 SET MAG/WASHER
 12/02/02, DCH

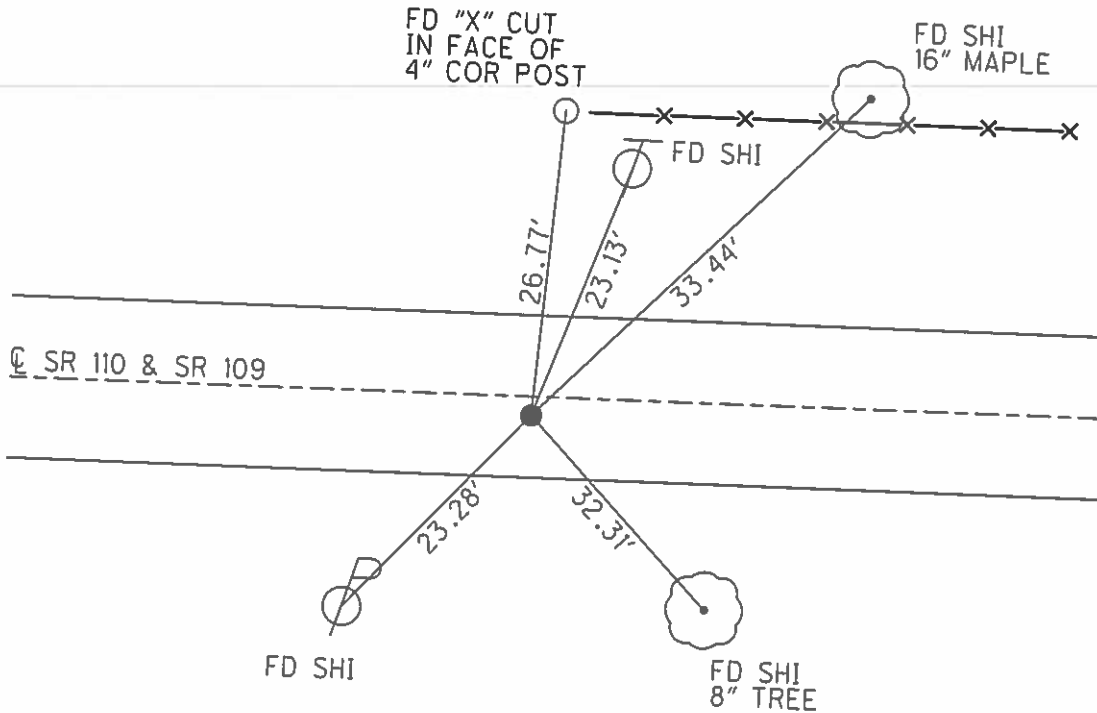

OD.O.T. DISTRICT 2 SURVEY OFFICE

SHEET _____ OF _____

County HENRY S.R. 109 & SR 110

Date 3-23-84

Township HARRISON

Weather CLEAR

Section 11

Temp. +25°


T5N, R2E

Personnel HOFFMAN

LOHRKE

HOUSEHOLDER

BARXNISEL

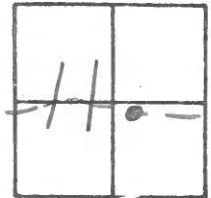

Fd. small R.R. spike 2" below surface

SLM 914+09

1.7' RT. of & Post

7.2' TO RT. EP.

11.1' TO LT. EP.

Record: P.I.
 $\Delta = 5^\circ - 45' \text{ Lt.}$

SET PK/WASHER
8-24-84
SWH.

