

O.D.O.T. DISTRICT 2 SURVEY OFFICE (USE ONLY)

PERSONNEL

REFERENCE NO. 14 AC

SHEET 10 OF 56

NOTES ASTON

DATE 525/23

ROUTE SR 110

H.C. AUBLE

WEATHER CLOUDY

COUNTY HENRY

R.C. MILLER

TEMP. 55°

TOWNSHIP HARRISON

DWG BY RHOADES

PID PAVTRAIN

SECTION 12

T 5 N R 7 E

TYPE MONUMENT MAG SHANK

~~ON SURFACE~~ - BELOW 1 1/2"

OFFSET Q PAVEMENT 0.9' LT : ~~RT~~

8.0' TO LT EDGE PAVEMENT


STATION: 345+42.77

HORZ.DATUM: NAD83 2011

GEOID: NAVD88 2018


GRID: NORTHING: 637102.896

EASTING: 1553638.160

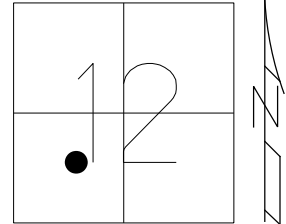

NOTE: REF 38B SR 109


RECORD: P.O.T.  
 FD P.K./WASHER  
 8/13/02, DCH  
 SET MAG/WASHER  
 11-29-02, DCH  
 SHOT HOLE  
 REFB38  
 6/17/21, JMR  
 FD MAG SHANK  
 REF14AC  
 4/10/23, DSA

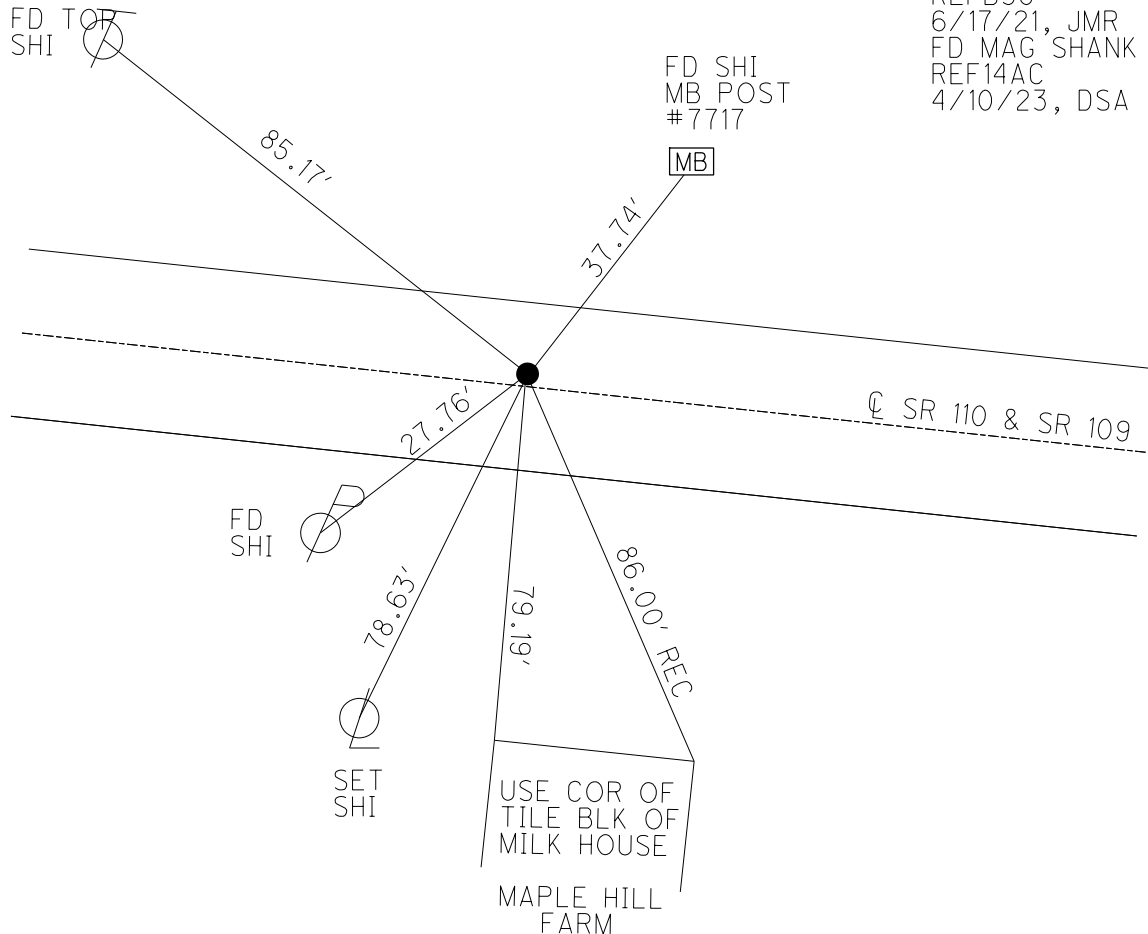

O.D.O.T. DISTRICT 2 SURVEY OFFICE (USE ONLY)


PERSONNEL \_\_\_\_\_ REFERENCE NO. 14 AC SHEET 11 OF 58  
 NOTES HOMAN DATE 08/13/02 ROUTE SR 110  
 H.C. ROUSOS WEATHER CLOUDY COUNTY HENRY  
 R.C. BEAUMONT TEMP. 80° TOWNSHIP HARRISON  
 \_\_\_\_\_ SECTION 12  
 \_\_\_\_\_ T 5 N R 7 E

TYPE MONUMENT \_\_\_\_\_ PK/WASHER \_\_\_\_\_  
 ON SURFACE - ~~BELOW~~ \_\_\_\_\_ ON \_\_\_\_\_  
 LEFT - ☉ PAV'T - RIGHT 0.9' \_\_\_\_\_  
8.0' TO LT EDGE PAVEMENT  
 S.L.M. 352+21

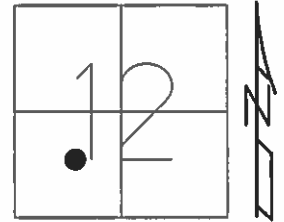

Grid: Northing: \_\_\_\_\_ Easting: \_\_\_\_\_

RECORD: P.O.T.  
 SET PK/WASHER  
 SET MAG/WASHER  
 11/29/02,DCH

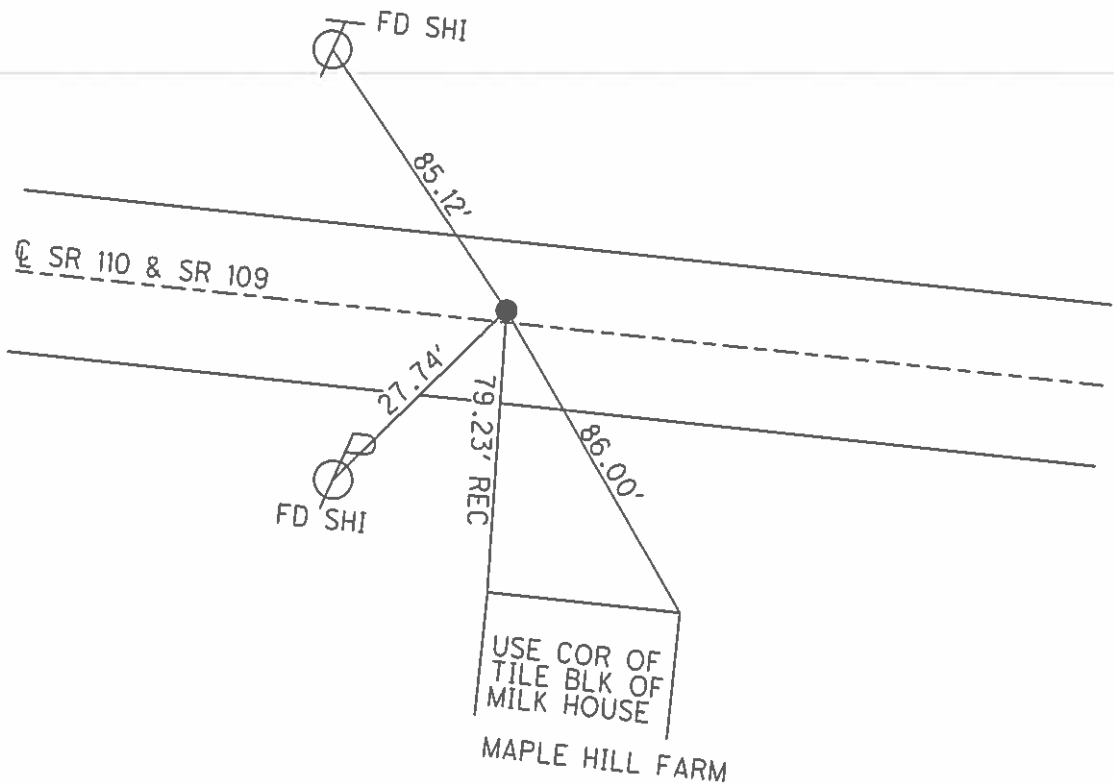

O.D.O.T. DISTRICT 2 SURVEY OFFICE

SHEET \_\_\_\_\_ OF \_\_\_\_\_

County HENRY S. R. 109 & SR 110

Date 3-23-84

Township HARRISON

Weather Clear

Section 12

Temp. +25°


T5N, R2E

Personnel HOFFMAN

LOEHRKE

HOUSEHOLDER R.C.

BARNHISEL H.C.

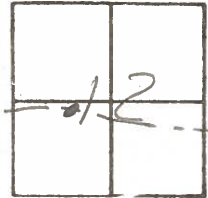

Record: P.O.T.  
Set P.K. Nail

DID NOT FIND POINT

SLM 944+99

SET PR/WASHER  
8-24-84  
S.W.H.  
1.0 Lt & PAUT  
11.0 Lt E.P  
13.0 Rt EP

