


O.D.O.T. DISTRICT 2 SURVEY OFFICE (USE ONLY)

PERSONNEL _____ REFERENCE NO. 15 SHEET 12 OF 56
 NOTES ASTON DATE 5/25/23 ROUTE SR 110
 H.C. AUBLE WEATHER WINDY COUNTY HENRY
 R.C. MILLER TEMP. 56° TOWNSHIP HARRISON
 SECTION 12
 DWG BY RHOADES PID PAVETRAIN T 5 N R 7 E


TYPE MONUMENT MONBOX W/1" IPIN
 ON SURFACE - ~~BELOW~~ ON
 OFFSET $\text{\textcircled{C}}$ PAVEMENT ON LT : RT
8.4' TO RT EDGE PAVEMENT
 STATION: 353+44.16

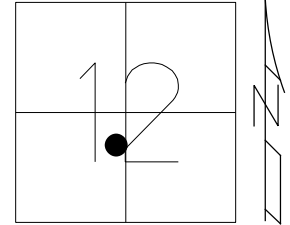

HORZ.DATUM: NAD83 2011 GEOID: NAVD88 2012A
 GRID: NORTHING: 636928.960 EASTING: 1554419.216

RECORD:
 SET PK/WASHER
 10-11-90, MB
 FD PK/WASHER
 REF 15
 8-31-15
 8-3-16, JFO
 FD MONBOX
 W/1" IPIN
 NEWMON3
 11-17-17, JFO
 REF 15
 12/20/23, DSA


NOTE: REF 39 SR 109

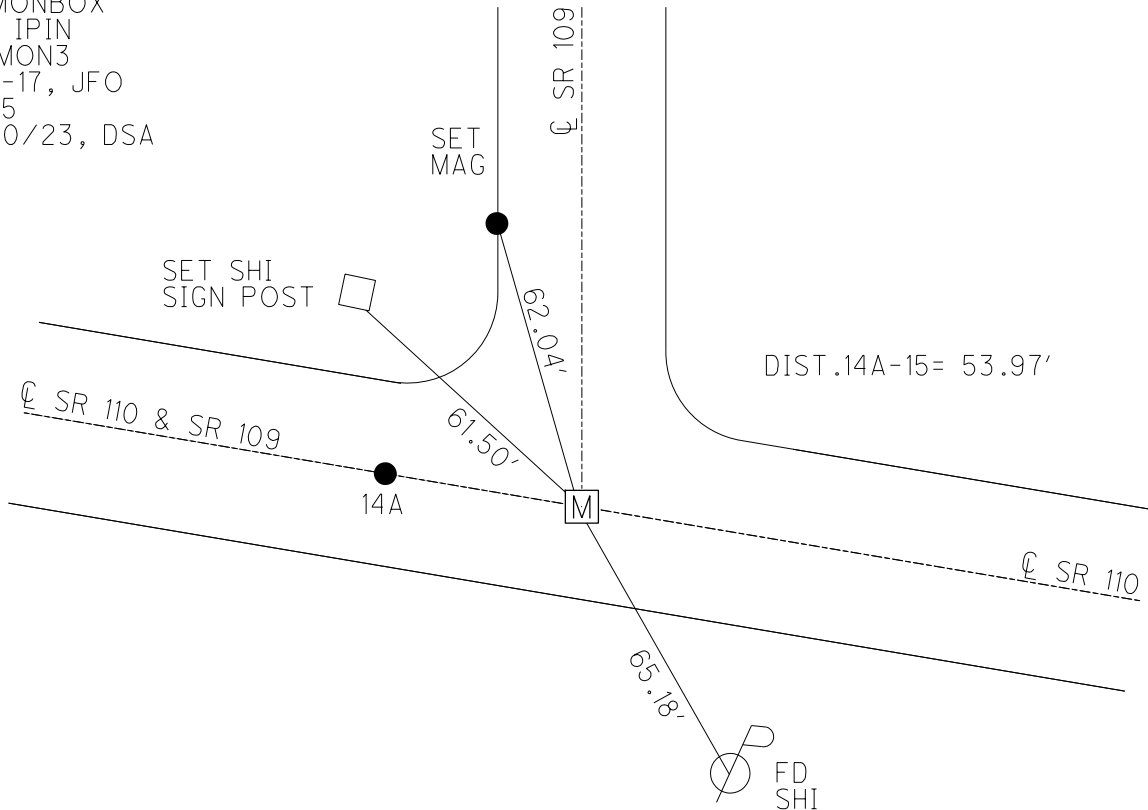

O.D.O.T. DISTRICT 2 SURVEY OFFICE (USE ONLY)


PERSONNEL _____ REFERENCE NO. 15 SHEET 13 OF 58
 NOTES RHOADES DATE 08/31/15 ROUTE SR 110
 H.C. O'DONNELL WEATHER FAIR COUNTY HENRY
 R.C. RHOADES TEMP. 85° TOWNSHIP HARRISON
 _____ SECTION 12
 _____ T 5 N R 7 E

TYPE MONUMENT _____ MAG/WASHER _____
 ON SURFACE - ~~BELOW~~ _____ ON _____
~~LEFT~~ - Q PAV'T - ~~RIGHT~~ _____ ON _____
8.4' TO RT EDGE PAVEMENT
 S.L.M. _____ 362+22

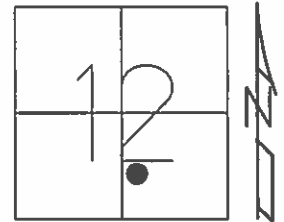

Grid: Northing: 636928.950 Easting: 1554419.220

RECORD:
 SET PK/WASHER
 10/11/90, MB
 FD PK/WASHER
 GPS, REF15
 08/31/15
 UNCOVERED
 08/03/16, JFO
 DIST 38C-39=53.98'

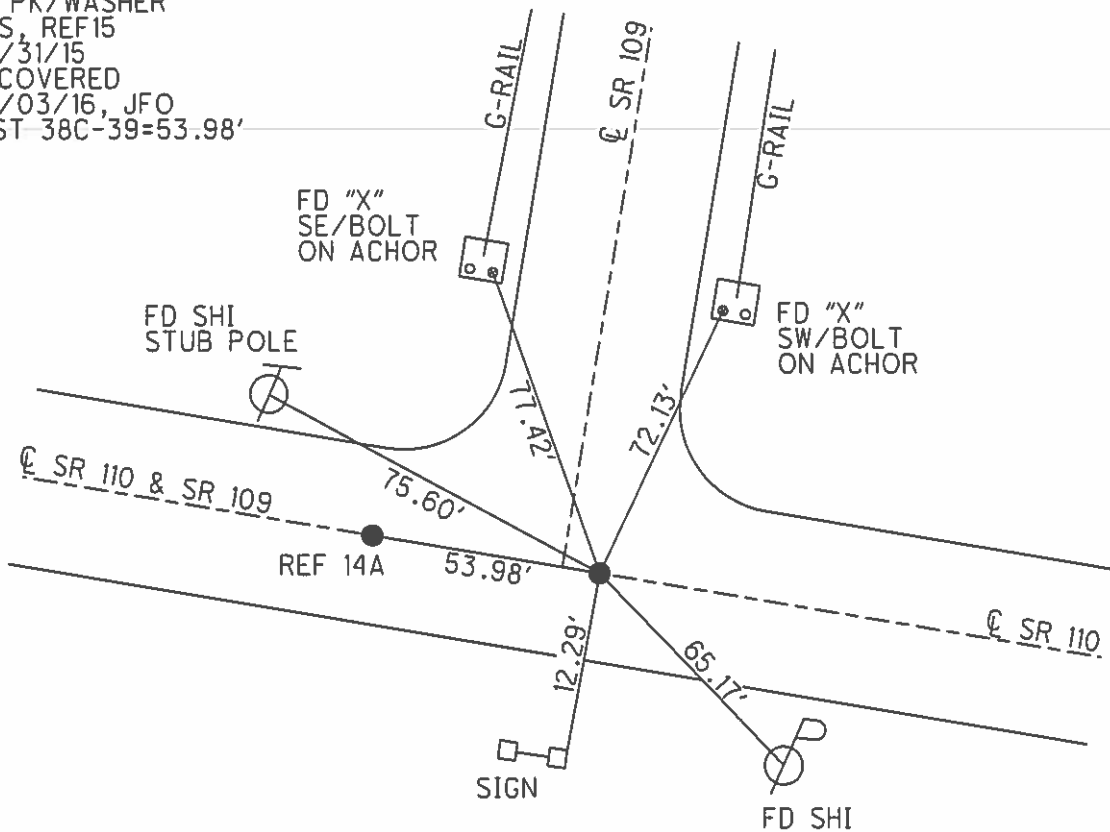

O.D.O.T. DISTRICT 2 SURVEY OFFICE

PERSONNEL

REFERENCE NO. # 15 SE 110 SHEET 33 OF SR 109

NOTES BARNHISEL

H.C. _____

DATE 9-28-90

ROUTE 109 & 110

R.G. HOFFMAN

WEATHER Clear

COUNTY HENRY

TEMP. +65°

TOWNSHIP HARRISON

SECTION 12

T5 N R 7 E

TYPE MONUMENT PK NAILS & Washers


ON SURFACE - BELOW YES YES

LEFT - & PAV'T. - RIGHT YES YES

8.6
8.4 TO FT EDGE PAVEMENT


S.L.M. "A" 952+25 "B" 952+79

361+68/6.85

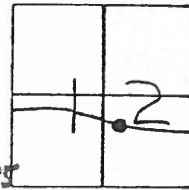

Record: P.I.
A = 0°-08' Rt
STA: 359+87.00

Set P.K.'s & Washers
10-11-90
mB

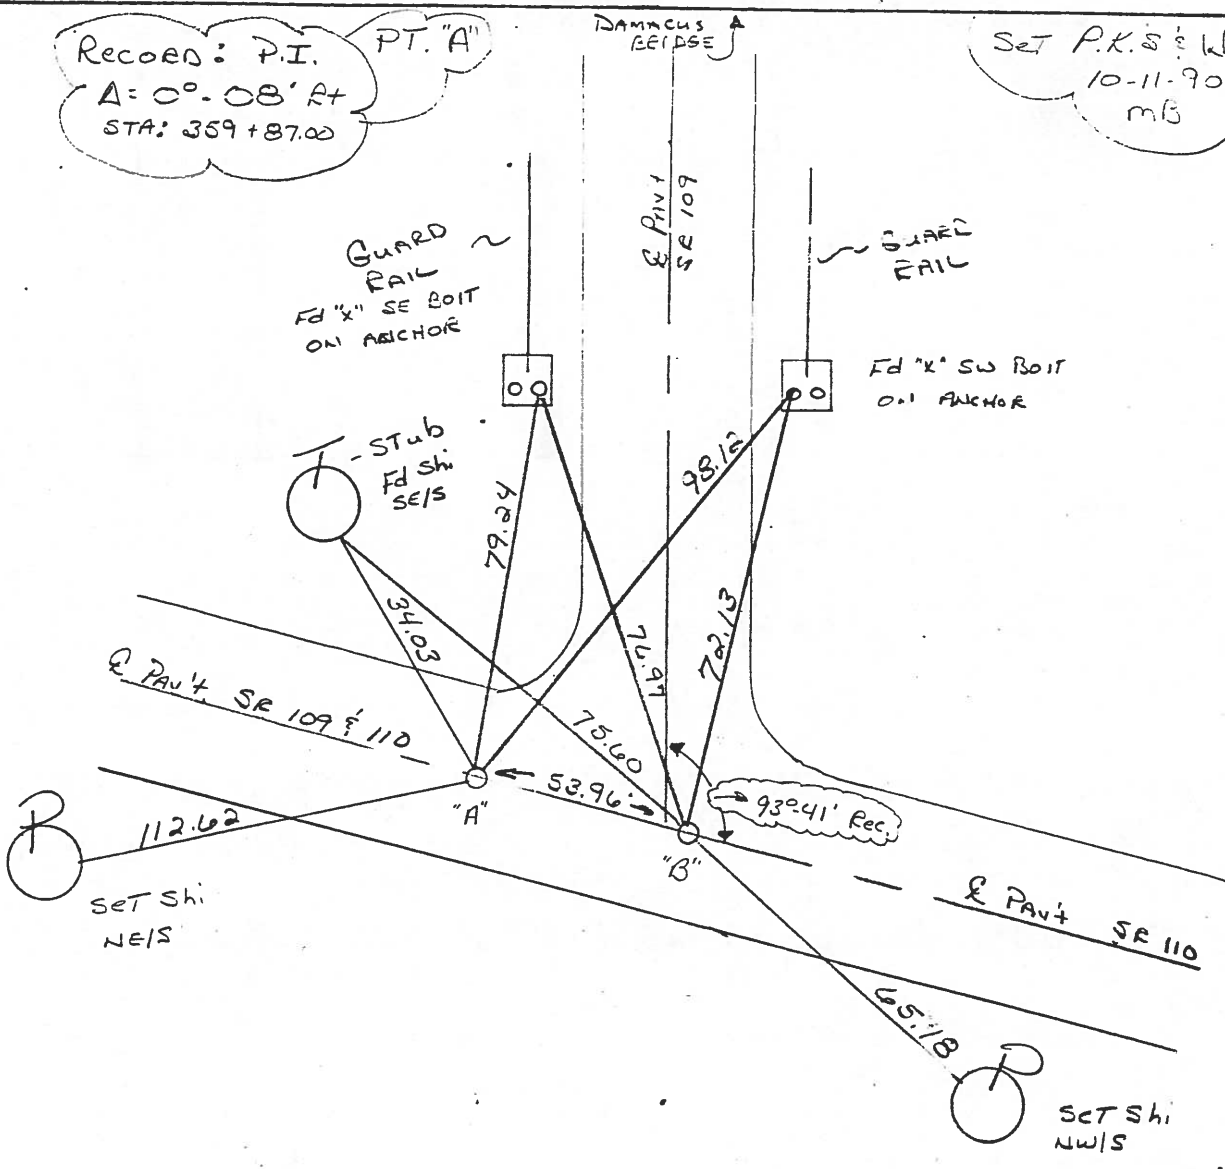

OD.O.T. DISTRICT 2 SURVEY OFFICE

SHEET _____ OF _____

County HENRY S.R. 109 & SR 110

Date 3-23-84

Township HARRISON


Weather Clear

Section 12

Temp. +25°

T5N, R2E

Personnel HOFFMAN

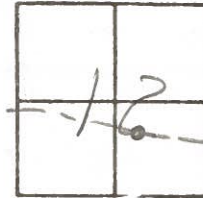

- #15 SR 110 LOENRKE
- #39 SR 109 HOUSEHOLDER
- BARNHISEL


PT. "A" Fd small R.R. SPK 2" Below Surface
ON E SR 109 & SR 110 PAUT
11.0' TO RT EP
15.5' TO LT EP

SLM 952 + 42

SET PK/WASHER
@ Both POINTS
8-24-84
SWH

Record: P.I.
 $\Delta = 00.08' RT$
STA. 359+87.00

DAMASCUS BRIDGE

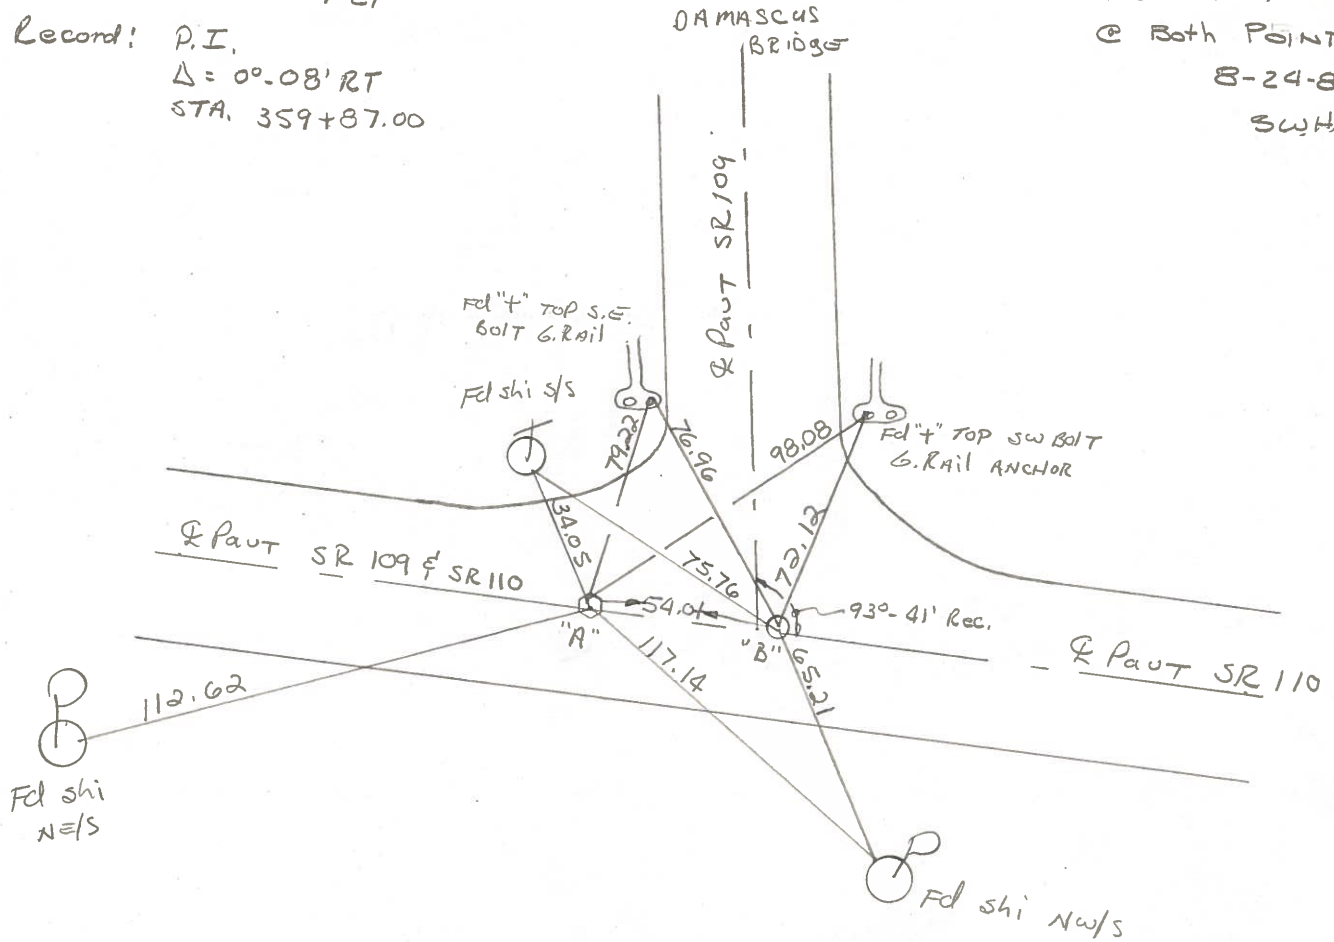

PT. "B" Fd P.K. NAIL ON SURFACE
& SURVEY SR 110 & ON
& CONST SR 109 NORTH
STA. 366+41.01 SR 110 =
STA. 954+22.52 SR 109

SLM = 952 + 96
ON & PAUT SR 110 EAST
1.0' E. of & PAUT SR 109 NORTH

Q.D.O.T. DISTRICT 2 SURVEY OFFICE

SHEET 1 OF

County HENRY S.R. 110

Date 4-26-82

Township HARRISON

Weather

Section 12


Temp. +65°

T5N, R7E


Personnel HOFFMAN

LOEHIZKE

HOUSEHOLDER

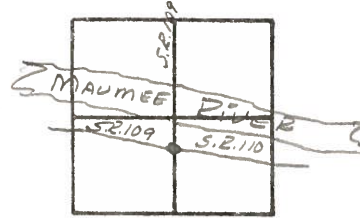


#15

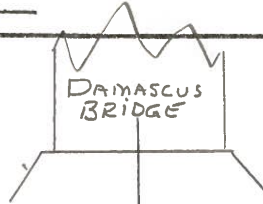

STA. 360+41.01 & S.R. 110:
954+22.52 S.R. 109


P.K. NAIL ON &
SURVEY S.R. 110 &
& CONST. S.R. 109

SET SMALL R.R. SPIK.
5-19-82
S.W.H.

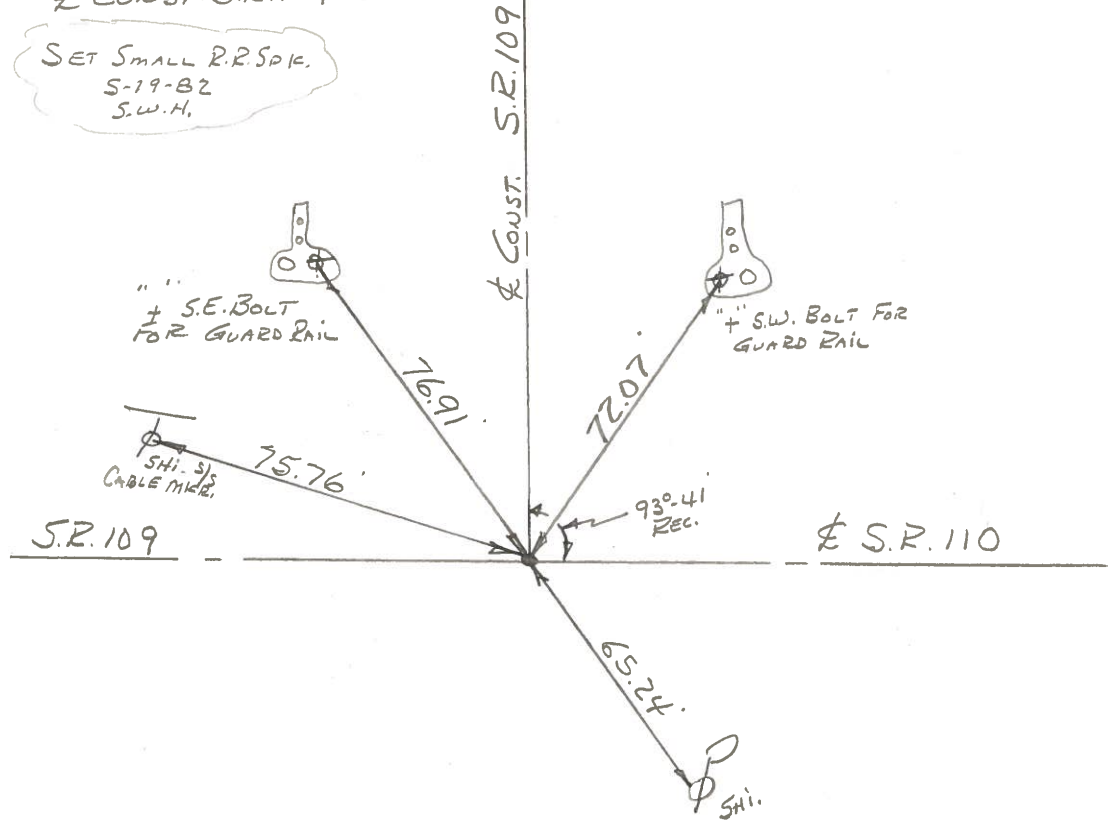

PERSONNEL	TITLE	PERSONNEL	TITLE	COUNTY	DATE
BURNSIDE				HENRY	4-2-73
SMITH				S. R. 110	WEATHER SHOWERS
BOWERS					TEMP. +45°
MEAD				SEC.	

DESCRIPTION ± SURVEY CONTROL TIES JOB NO. _____

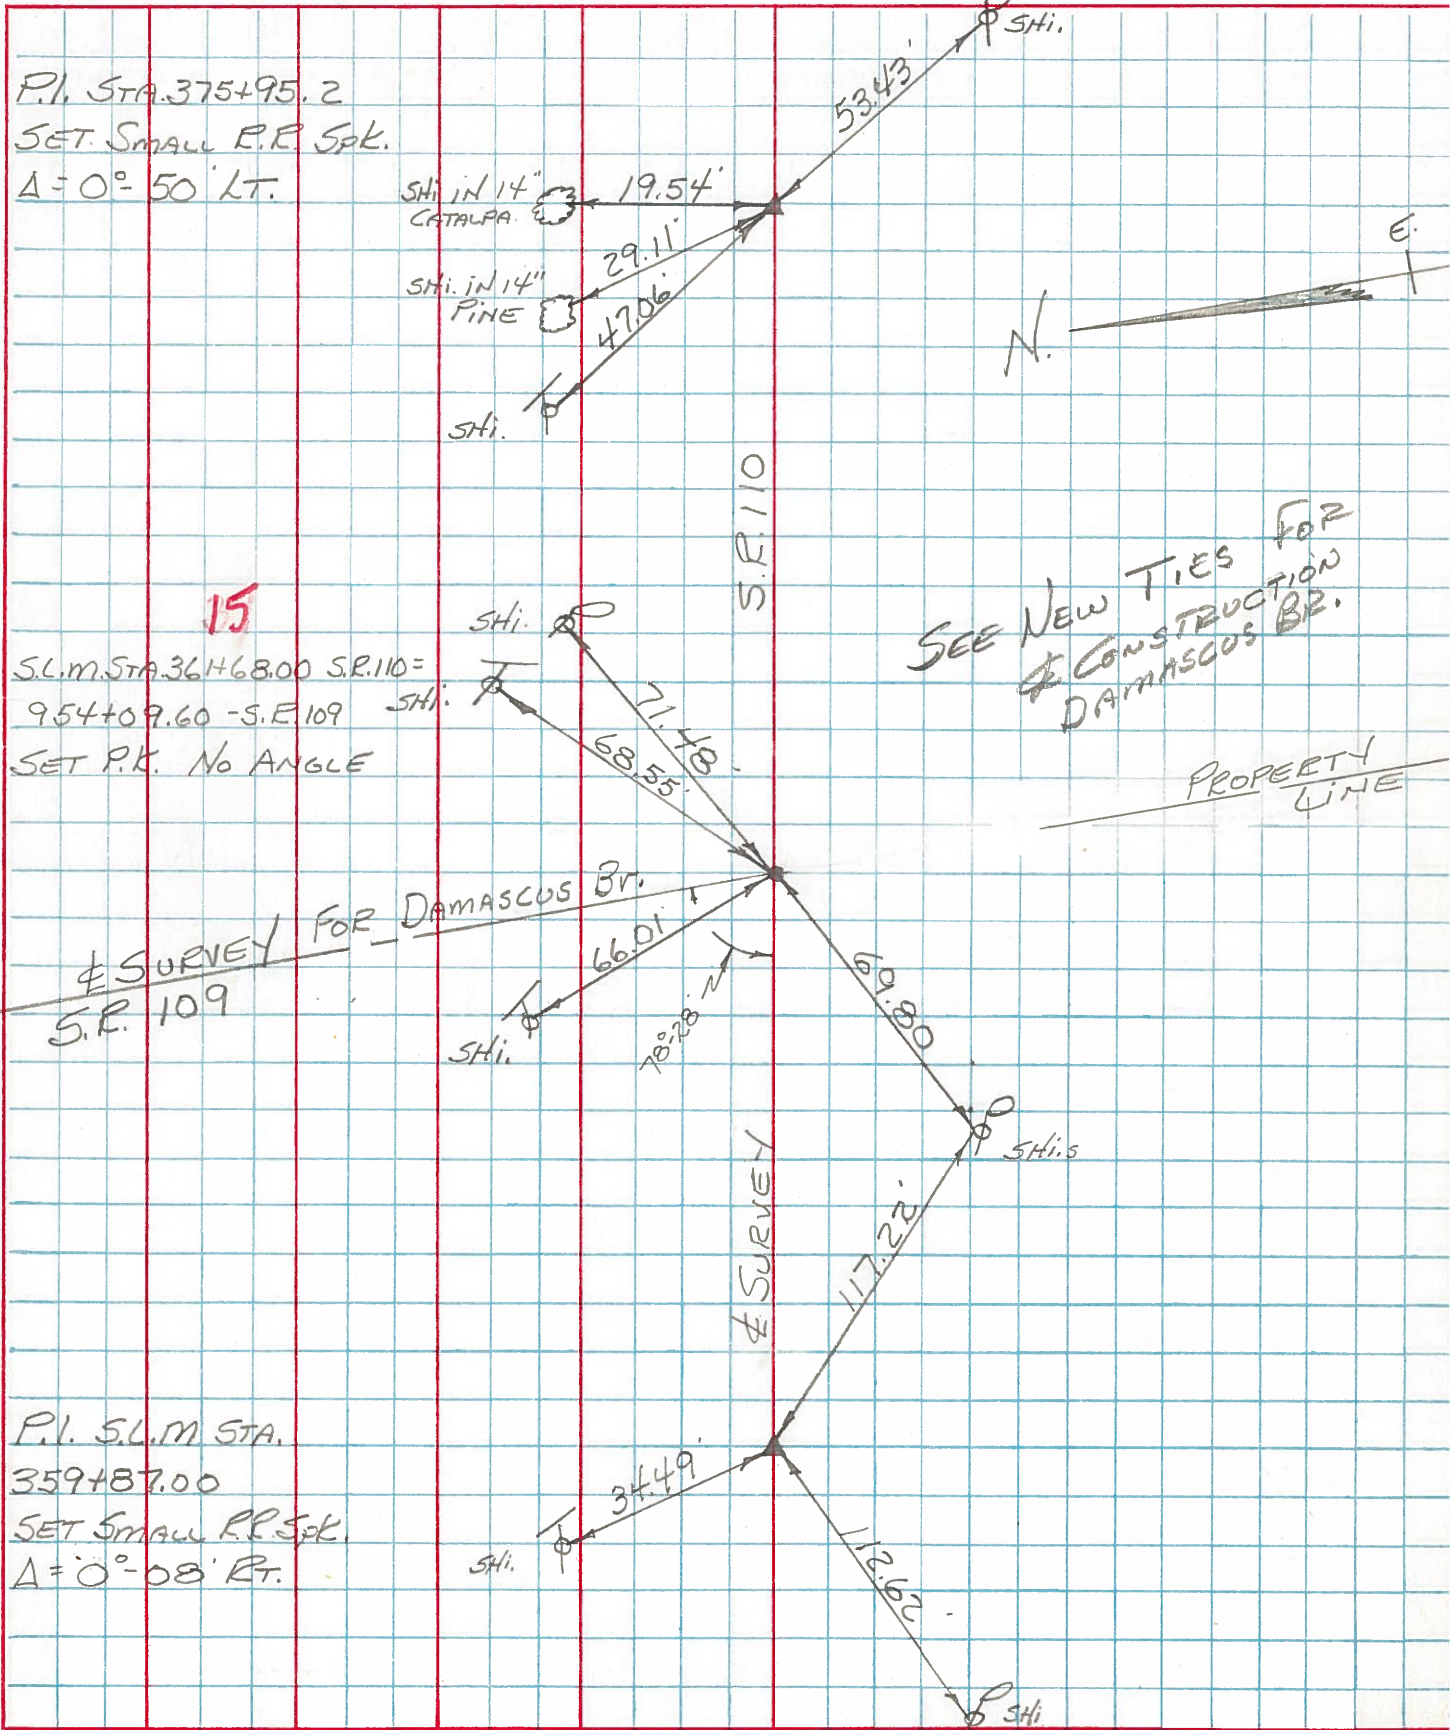

P.I. STA. 375+95.2
 SET SMALL R.F. SPK.
 $\Delta = 0^\circ 50' \text{ LT.}$

SHI. IN 14" CATALPA 19.54'
 SHI. IN 14" PINE 29.11'
 47.06'



15

S.L.M. STA. 36+68.00 S.R. 110 =
 954+09.60 - S.E. 109
 SET P.K. NO ANGLE

SHI. 71.48'
 68.55'

SEE NEW TIES FOR
 ± CONSTRUCTION
 DAMASCUS BR.

PROPERTY LINE

± SURVEY FOR DAMASCUS BR.
 S.R. 109

SHI. 66.01'
 78° 28' 2"
 69.80'

P.I. S.L.M. STA.
 359+87.00
 SET SMALL R.F. SPK.
 $\Delta = 0^\circ 08' \text{ RT.}$

SHI. 34.49'
 117.22'
 112.62'