


O.D.O.T. DISTRICT 2 SURVEY OFFICE (USE ONLY)

PERSONNEL _____ REFERENCE NO. 15 B SHEET 14 OF 61
 NOTES NIESE DATE 3/25/24 ROUTE SR 110
 H.C. MILLER WEATHER CLOUDY COUNTY HENRY
 R.C. RHOADES TEMP. 44° TOWNSHIP HARRISON
 SECTION 12
 DWG BY RHOADES PID 114846 T 5 N R 7 E


TYPE MONUMENT MONBOX W/ 1" IPIN
 ON SURFACE - ~~BELOW~~ ON
 OFFSET \odot PAVEMENT 1.0' LT : ~~RT~~
11.2' TO LT EDGE PAVEMENT
 STATION: 378+71.83

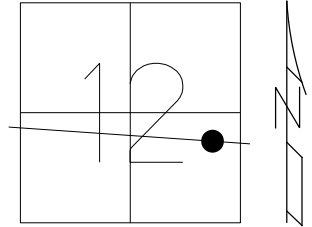

HORIZ. DATUM: NAD83 2011 GEOID: NAVD88 2018
 GRID: NORTHING: 636388.228 EASTING: 1556887.568

RECORD: P.C.
 STA. 385+68.71
 MONREFB15
 9/01/15, JFO
 FD MONBOX
 W/1" IPIN
 REFB15
 12/21/21, DSA
 CKREFB15
 3/25/24, TDN


HEN LPD
 N: 493224.130
 E: 191339.596

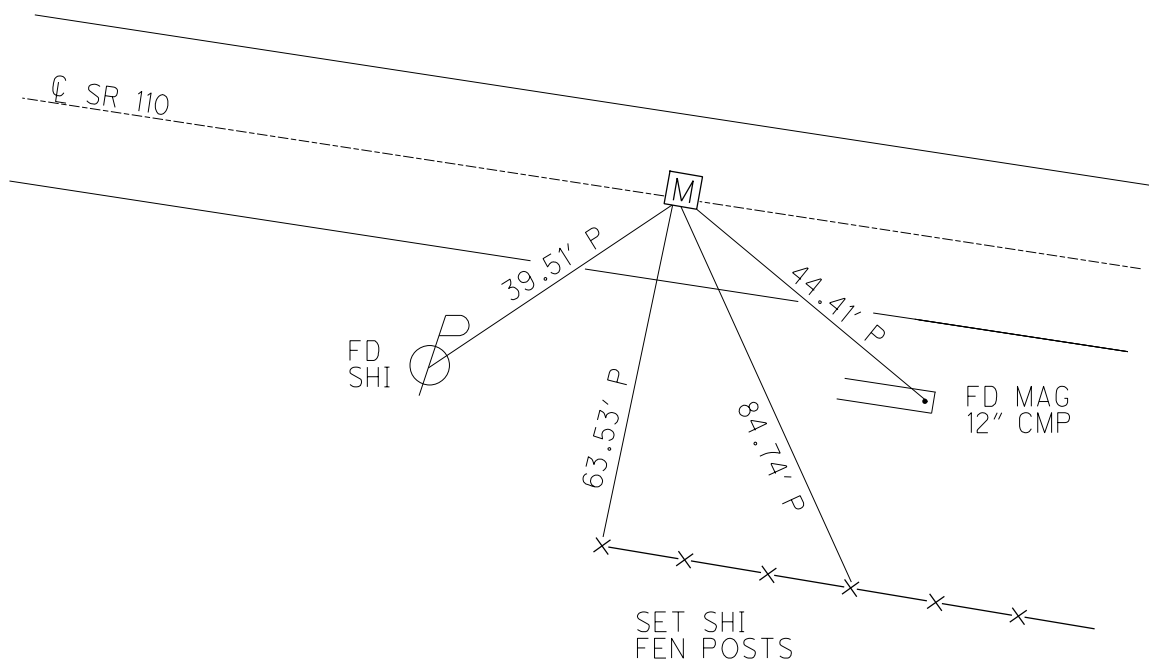


O.D.O.T. DISTRICT 2 SURVEY OFFICE (USE ONLY)

PERSONNEL _____ REFERENCE NO. 15-B SHEET 15 OF 58
 NOTES BARNHISEL DATE 04/13/04 ROUTE SR 110
 H.C. CANTERBURY WEATHER CLEAR COUNTY HENRY
 R.C. HOOVER TEMP. 75° TOWNSHIP HARRISON
 _____ SECTION 12
 _____ T 5 N R 7 E

TYPE MONUMENT MON. BOX W/IRON PIN
 ON SURFACE - ~~BELOW~~ _____ ON _____
~~LEFT~~ - ☉ PAV'T - ~~RIGHT~~ _____ ON _____
11.2' TO LT EDGE PAVEMENT
 S.L.M. 386+92
 Grid: Northing: 636388.183 Easting: 1556887.604

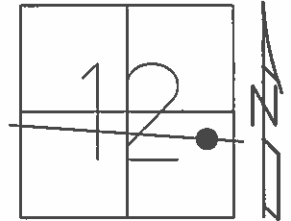

RECORD: PC PLAN
 STA: 385+68.71
 GPS, MONREFB15
 09/01/15, JFO
 FD BOX COVERED
 08/03/16 W/ASPH
 CANNOT OPEN
 NOTE: THIS MON. BOX
 SET DURING NEW CONST.
 IN 1988

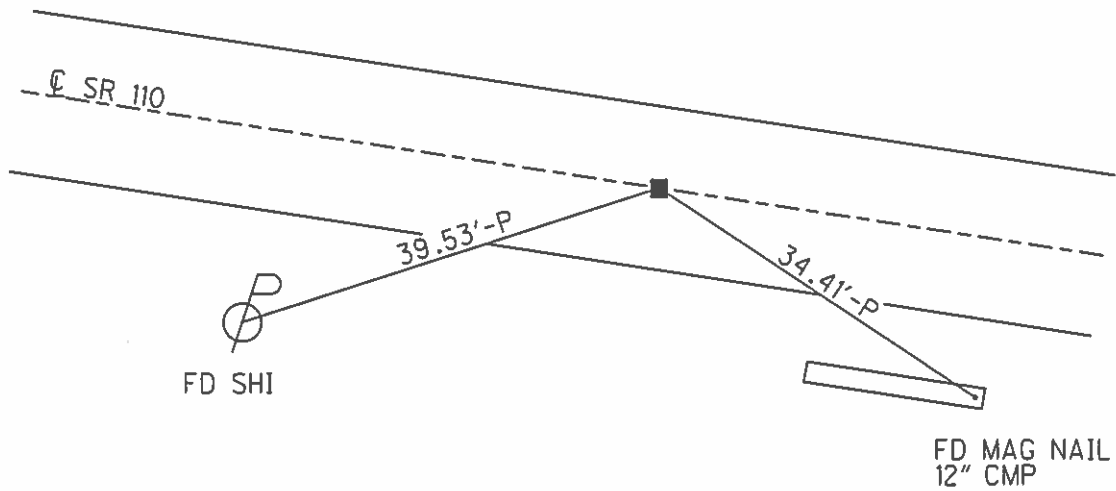

O.D.O.T. DISTRICT 2 SURVEY OFFICE

PERSONNEL _____

REFERENCE NO. ¹⁹⁸⁸ 153

SHEET 2 OF 37

NOTES BARNHISEL

DATE 04/13/04

ROUTE 110

H.C. CANTERBURY

WEATHER CLEAR

COUNTY HENRY

R.C. HOOKER

TEMP. +75°

TOWNSHIP HARRISON

SECTION 12

T 5 N R 7 E


TYPE MONUMENT MON. BOX W/IRON PIN

ON SURFACE ~~-BELOW~~ YES

~~LEFT - Q~~ PAV'T ~~-RIGHT~~ YES


11.2' TO LT EDGE PAVEMENT

S.L.M. 386+92

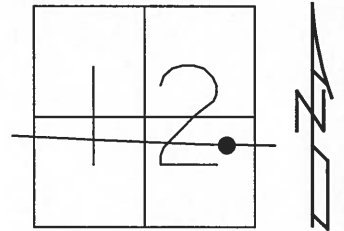

RECORD: PC
PLAN STA: 385+68.71

NOTE: THIS MON. BOX SET DURING
NEW CONST. IN 1988.

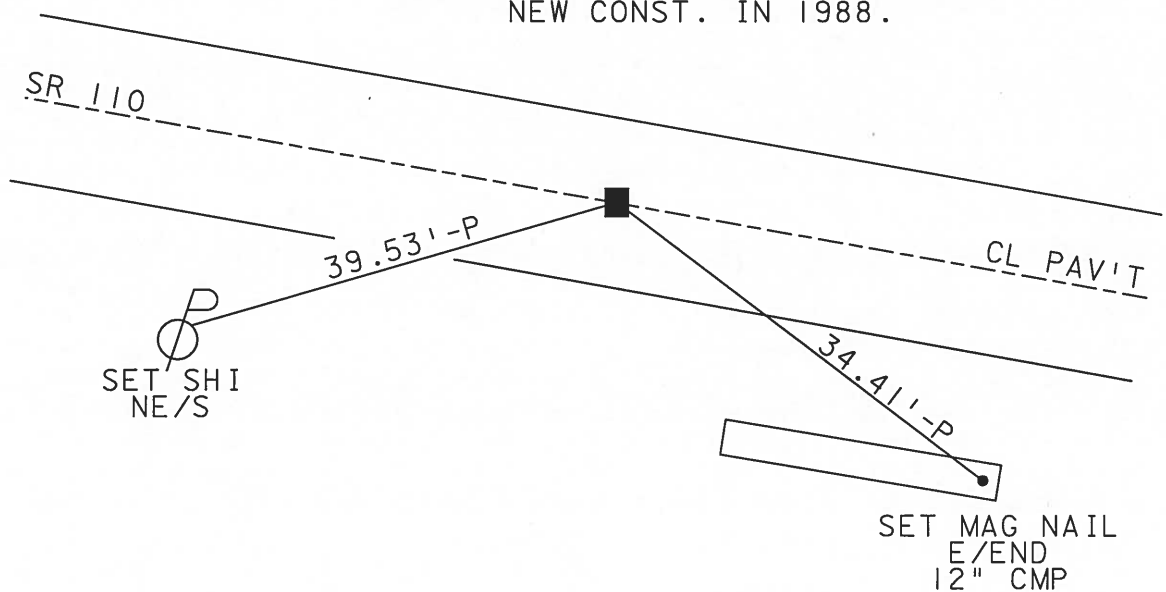

County HENRY S.R. 110

Date 4-26-82

Township HARRISON

Weather _____

Section 12


Temp. +70°

T5N, R7E

Personnel HOFFMAN

15B

LOEHRKE
HOUSEHOLDER

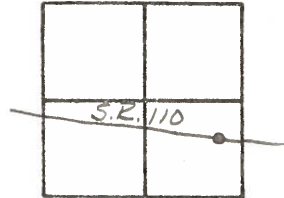

P.I. STA. 387+90.55

P.C. = 386+71.45

P.T. = 389+09.47

$\Delta = 5^{\circ} 21' 20''$ Rt.

R = 2546.48

T = 119.10'

D = 2°-15'

L = 238.02

PROJ. STA. 389+18±

FD. SMALL R.R. SPIK.


4.4' LT. OF $\&$

4.9' TO N.E.P.

13.4' TO S.E.P.

OLD ALIGNME.


SET P.K. & WASHER
5-19-82
S.W.H.

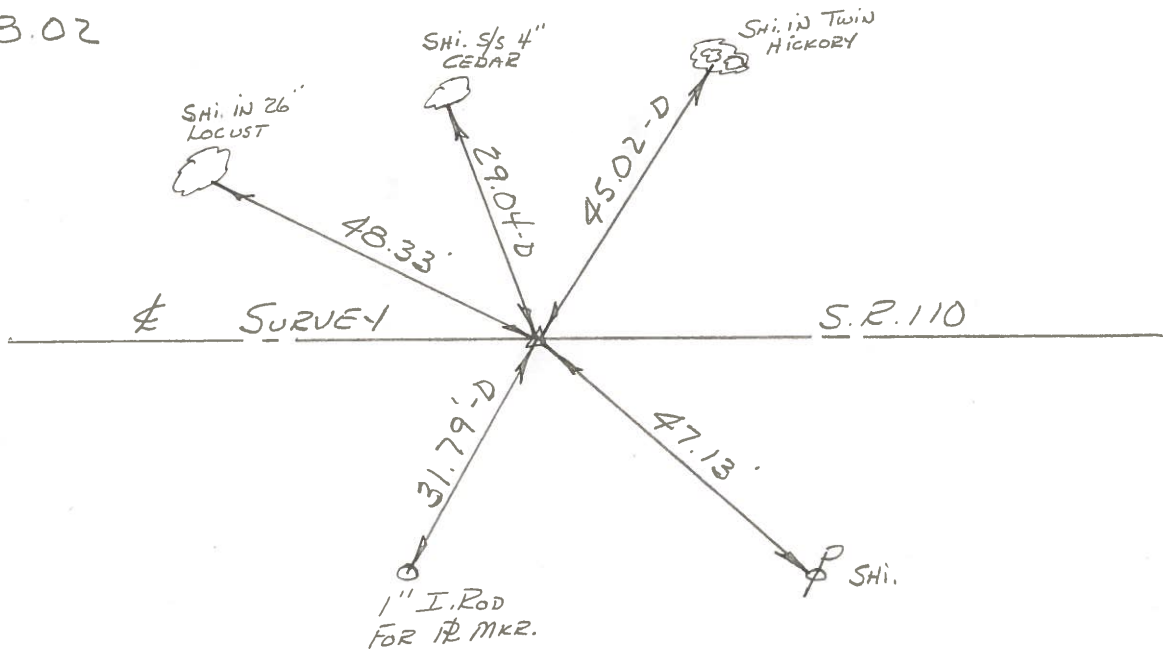

PERSONNEL TITLE PERSONNEL TITLE
 BURNSIDE
 SMITH
 BOWERS
 MEAD

COUNTY HENRY DATE 4-2-73
 S. R. 110 WEATHER SHOWERS
 SEC. TEMP. +43°

DESCRIPTION £ SURVEY CONTROL TIES. JOB NO.

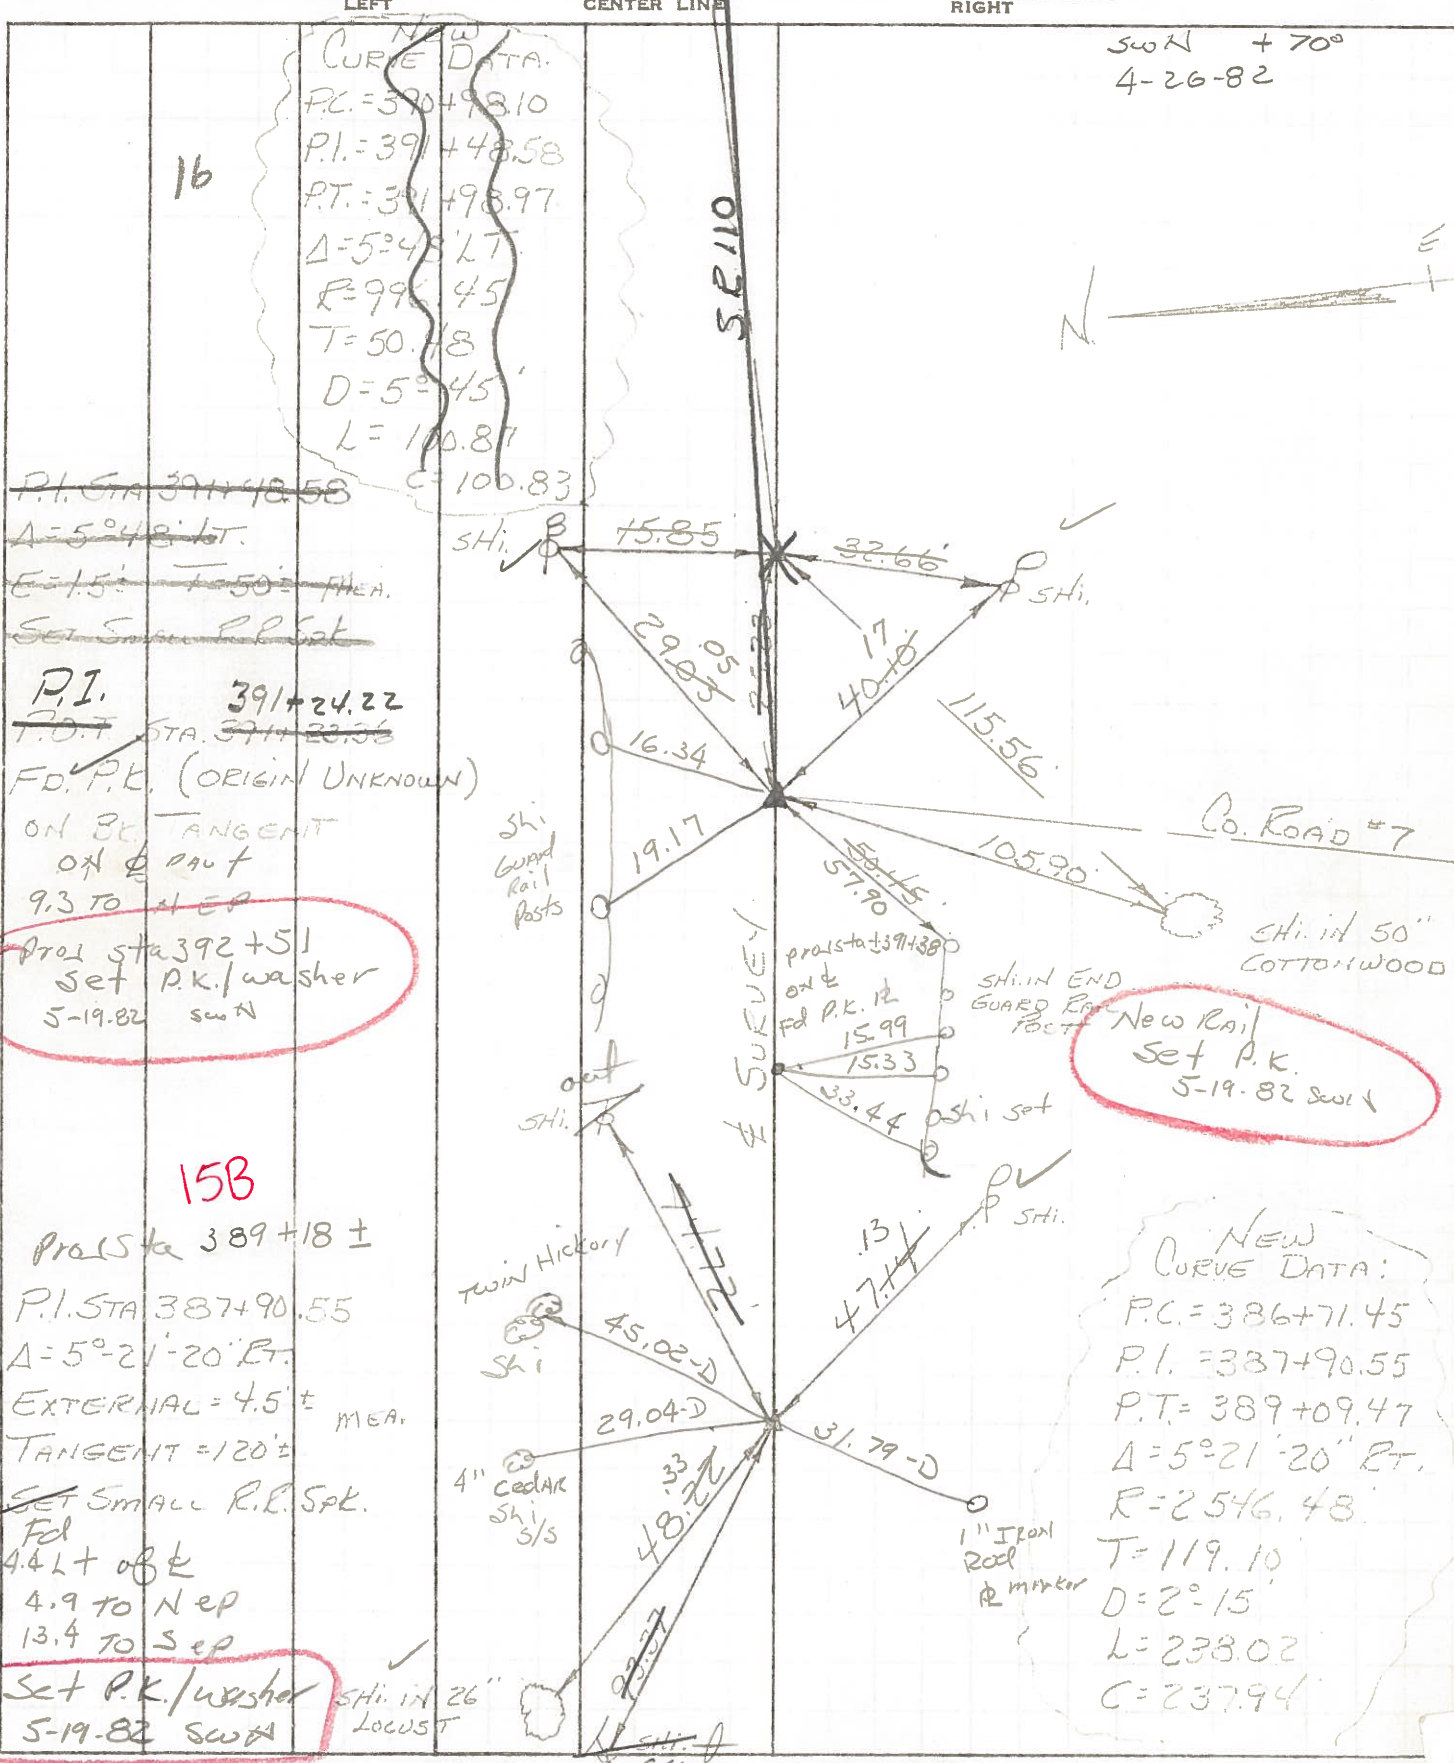

16
 NEW CURVE DATA:
 P.C.=390+98.10
 P.I.=391+48.58
 P.T.=391+98.97
 Δ=5°48' LT
 R=99.45
 T=50.18
 D=5°45'
 L=100.87
 C=100.83
~~P.I. STA 391+48.58~~
~~Δ=5°48' LT~~
~~E=15' T=50' MEAS.~~
~~Set Small R.P. Spk~~

P.I. 391+24.22
 T.O.T. STA. 391+23.58
 F.D. P.K. (ORIGIN UNKNOWN)
 ON BE TANGENT
 ON & PAUT
 9.3 TO 4 EP
 PROJ STA 392+51
 Set P.K. washer
 5-19-82 SWN

15B
 PROJ STA 389+18 ±
 P.I. STA 387+90.55
 Δ=5°21'20" RT
 EXTERNAL=4.5' MEAS.
 TANGENT=120'
 SET SMALL R.P. SPK.
 Fd
 4.4 LT of &
 4.9 TO NEP
 13.4 TO SEP
 Set P.K. washer
 5-19-82 SWN

SHI. in 50" COTTONWOOD
 New Rail
 Set P.K.
 5-19-82 SWN

NEW CURVE DATA:
 P.C.=386+71.45
 P.I.=387+90.55
 P.T.=389+09.47
 Δ=5°21'20" RT
 R=2546.48
 T=119.10
 D=2°15'
 L=238.02
 C=237.94