

O.D.O.T. DISTRICT 2 SURVEY OFFICE (USE ONLY)

PERSONNEL

REFERENCE NO. 15 C

SHEET 15 OF 61

NOTES NIESE DATE 3/25/24

ROUTE SR 110

H.C. MILLER WEATHER CLOUDY

COUNTY HENRY

R.C. RHOADES TEMP. 45°

TOWNSHIP HARRISON

SECTION 12

DWG BY RHOADES PID 114846

T 5 N R 7 E

TYPE MONUMENT MONBOX W/ 1" IPIN

ON SURFACE - ~~BELOW~~ ON

OFFSET \varnothing PAVEMENT ON _____ LT : RT

10.7' TO LT EDGE PAVEMENT



STATION: 383+61.74

HORZ. DATUM: NAD83 2011

GEOID: NAVD88 2018

GRID: NORTHING: 636208.520



EASTING: 1557341.118

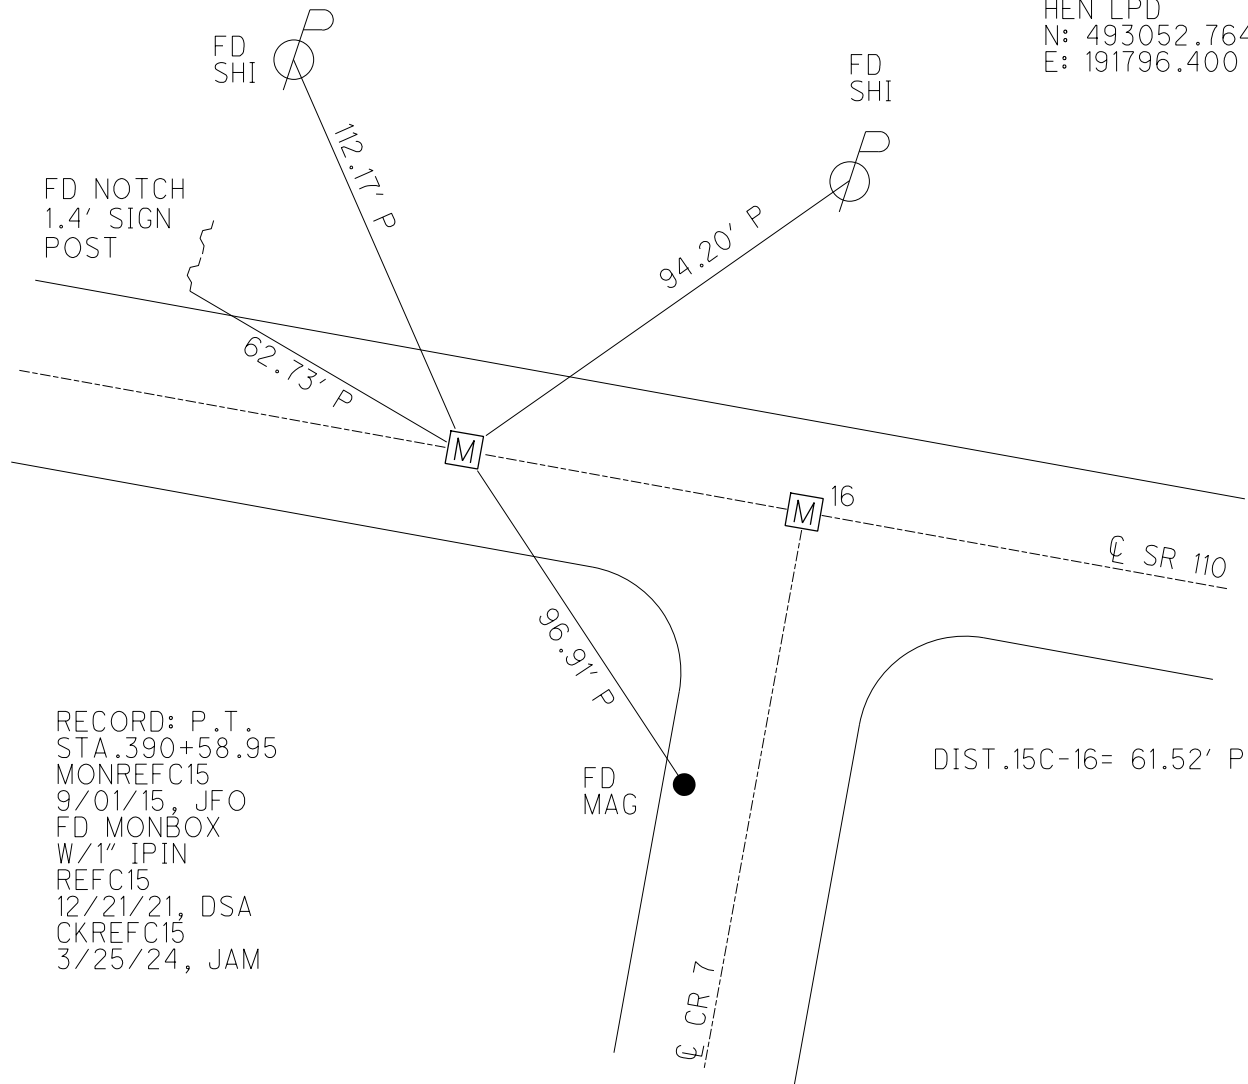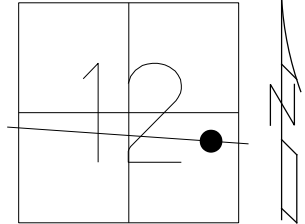

O.D.O.T. DISTRICT 2 SURVEY OFFICE (USE ONLY)

PERSONNEL	REFERENCE NO.	15-C	SHEET	16	OF	58
NOTES	BARNHISEL	DATE	09/14/04	ROUTE	SR 110	
H.C.	CANTERBURY	WEATHER	CLEAR	COUNTY	HENRY	
R.C.	HOOVER	TEMP.	75°	TOWNSHIP	HARRISON	
				SECTION	12	
				T	5	N
				R	7	E

TYPE MONUMENT MON. BOX W/IRON PIN
 ON SURFACE - ~~BELOW~~ ON
~~LEFT~~ - ☉ PAV'T - ~~RIGHT~~ ON
10.7' TO LT EDGE PAVEMENT
 S.L.M. 391+82
 Grid: Northing: 636208.465 Easting: 1557341.159

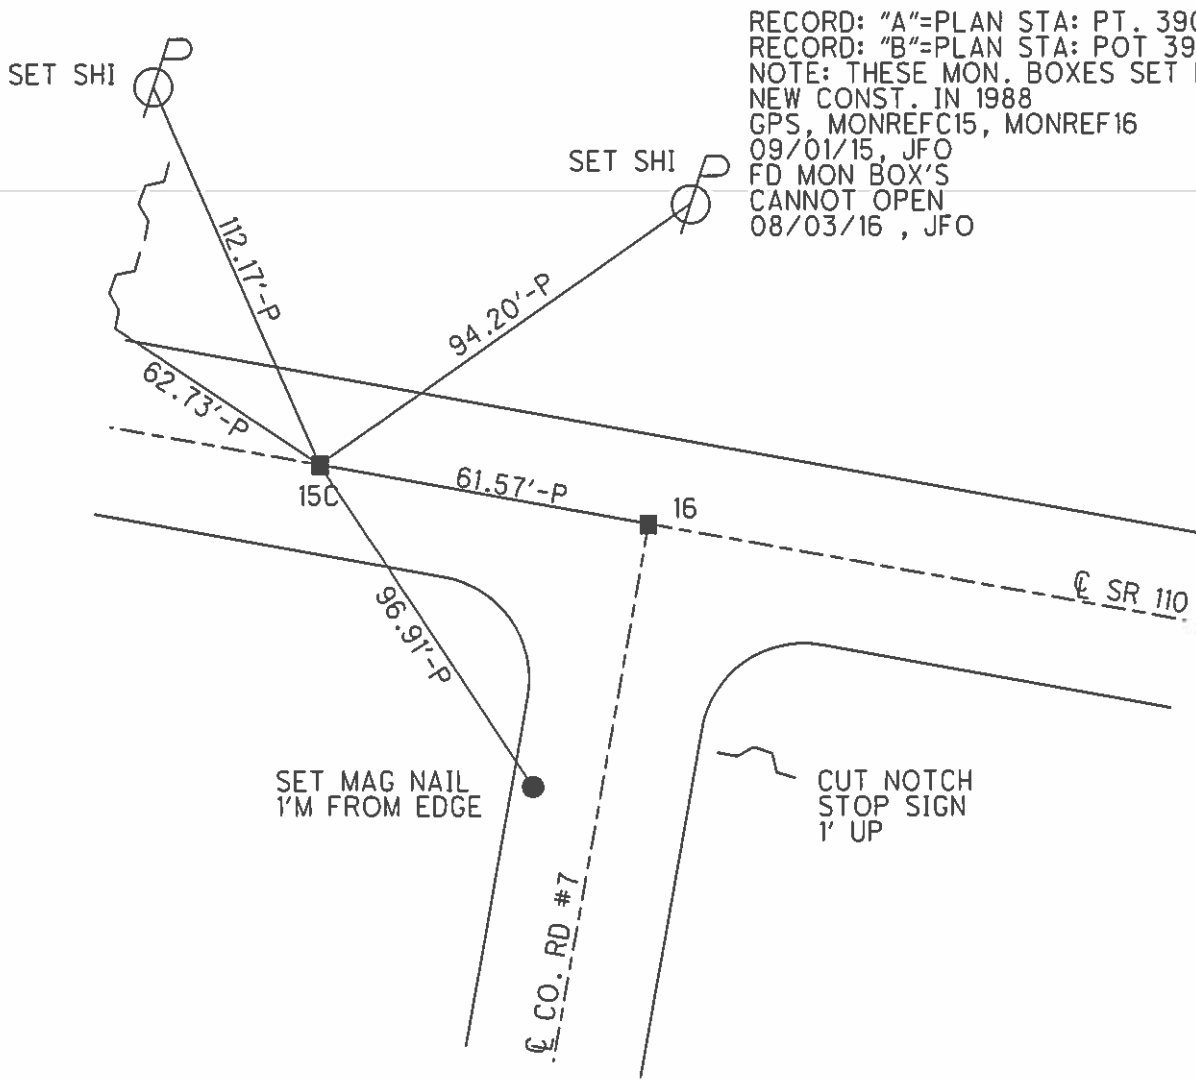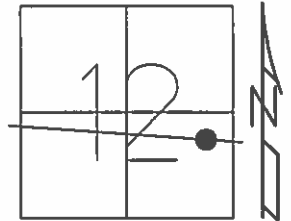

RECORD: "A"-PLAN STA: PT. 390+58.95
 RECORD: "B"-PLAN STA: POT 391+20.41
 NOTE: THESE MON. BOXES SET DURING
 NEW CONST. IN 1988
 GPS, MONREFC15, MONREF16
 09/01/15, JFO
 FD MON BOX'S
 CANNOT OPEN
 08/03/16, JFO

O.D.O.T. DISTRICT 2 SURVEY OFFICE

PERSONNEL

REFERENCE NO. ¹⁹⁸⁸ 16



SHEET 3 OF 37

NOTES BARNHISEL
 H.C. CANTERBURY
 R.C. HOOKER

DATE 09/14/04
 WEATHER CLEAR
 TEMP. +75°

ROUTE 110
 COUNTY HENRY
 TOWNSHIP HARRISON
 SECTION 12
 T5 N R7 E

TYPE MONUMENT MON. BOX W/IRON PIN
 ON SURFACE - ~~BELOW~~ YES
~~LEFT - C~~ PAV'T - ~~RIGHT~~ YES (BOTH)
10.7' TO LT. EDGE PAVEMENT (BOTH)
 S.L.M. 391+82 392+43

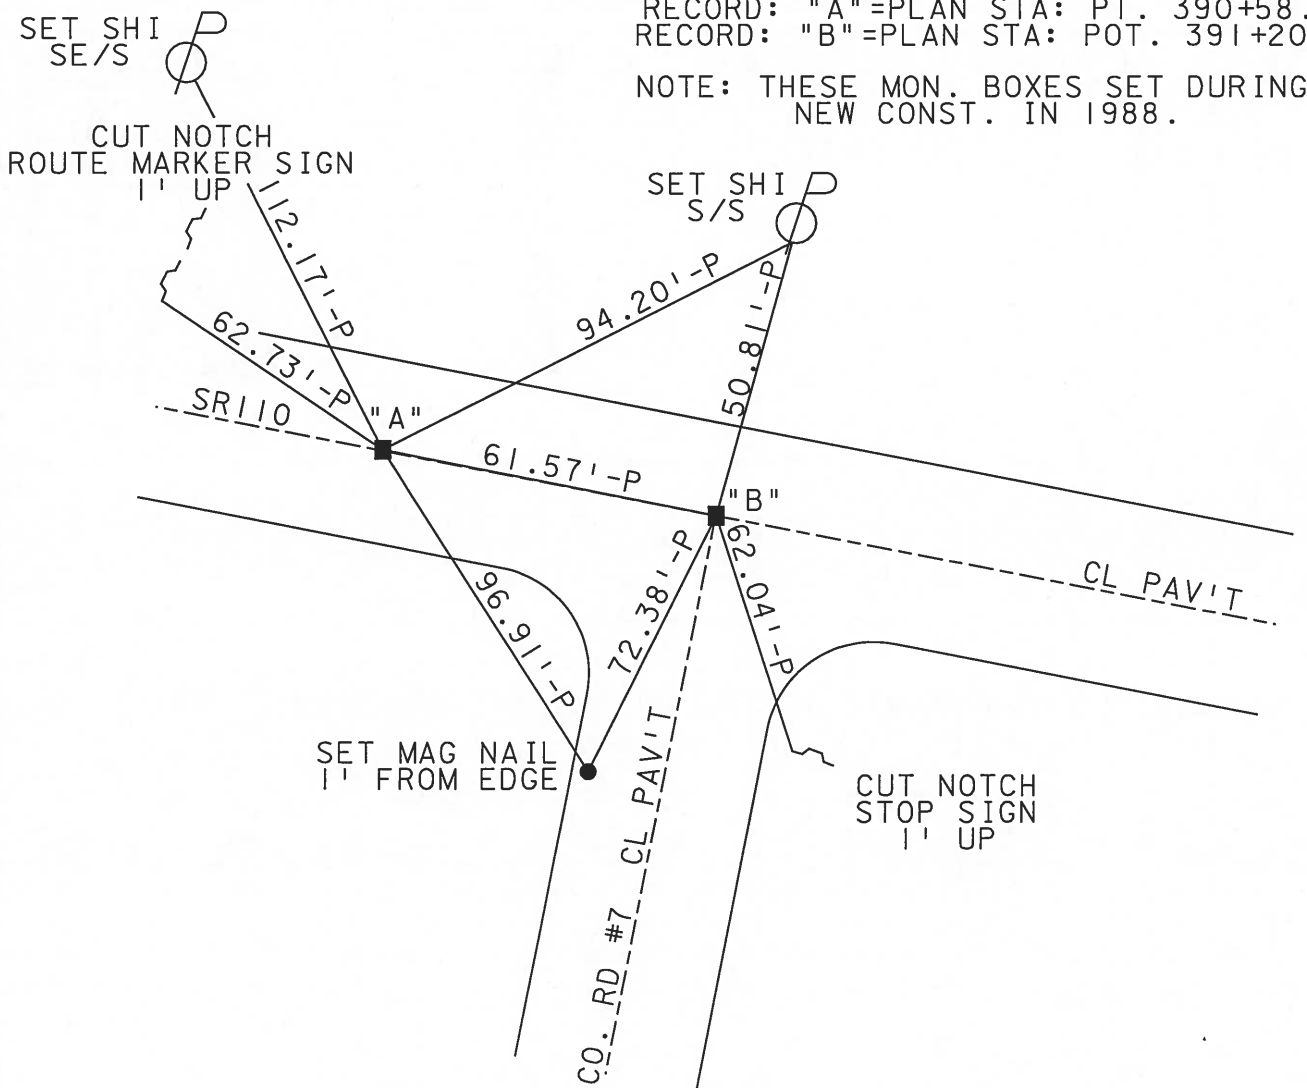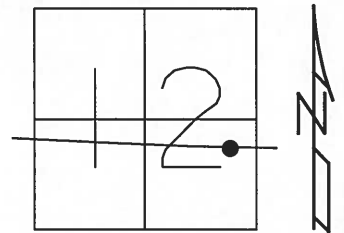

RECORD: "A" = PLAN STA: PT. 390+58.95
 RECORD: "B" = PLAN STA: POT. 391+20.41

NOTE: THESE MON. BOXES SET DURING
 NEW CONST. IN 1988.

Q.D.O.T. DISTRICT 2 SURVEY OFFICE

SHEET 4 OF

County HENRY S.R. 110

Date 4-26-82

Township HARRISON

Weather _____

Section _____

Temp. +70°


T5N, R7E

Personnel HOFFMAN

LOEHRKE

HOUSEHOLDER

#16

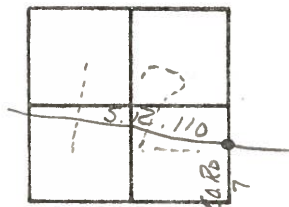

P.I. STA. 391+24.22
 FD. P.K. (ORIGIN UNKNOWN)
 ON BK. TANGENT. $\frac{1}{2}$ PAVE.
 9.3' TO N.E.R.
 $\Delta = 4^{\circ}23'LT$


Proj. STA. 392+51

OLD ALIGNMENT

SET P.K./WASHER
 5-19-82
 S.W.H.

SET P.K.
 5-19-82
 S.W.H.

FD. P.K. ON $\frac{1}{2}$

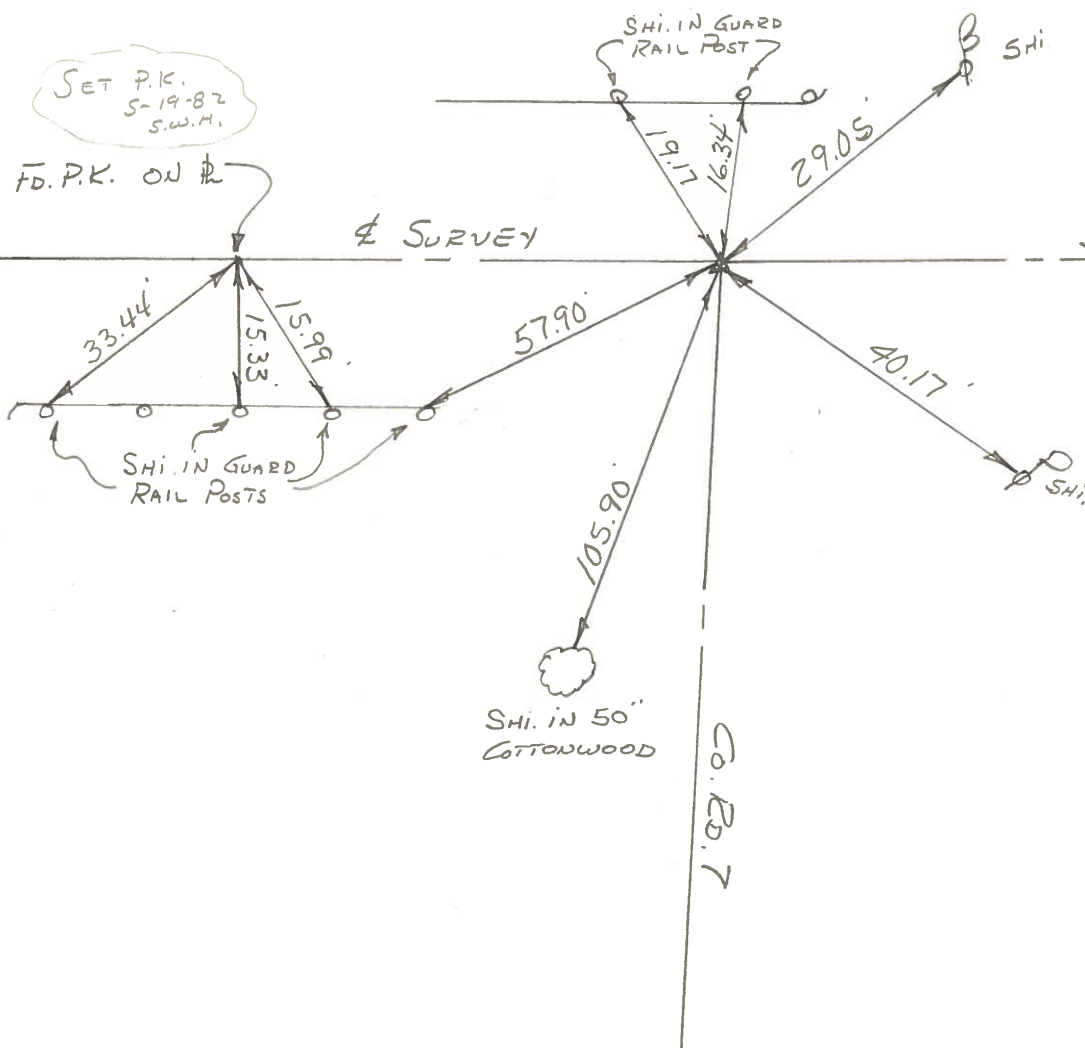


PERSONNEL TITLE PERSONNEL TITLE
 BURNSIDE _____
 SMITH _____
 POWERS _____
 MEAD _____

COUNTY HENRY DATE 4-2-73
 S. R. 110 WEATHER SHOWERS
 SEC. _____ TEMP +43°

DESCRIPTION ± SURVEY CONTROL TIES

JOB NO. _____

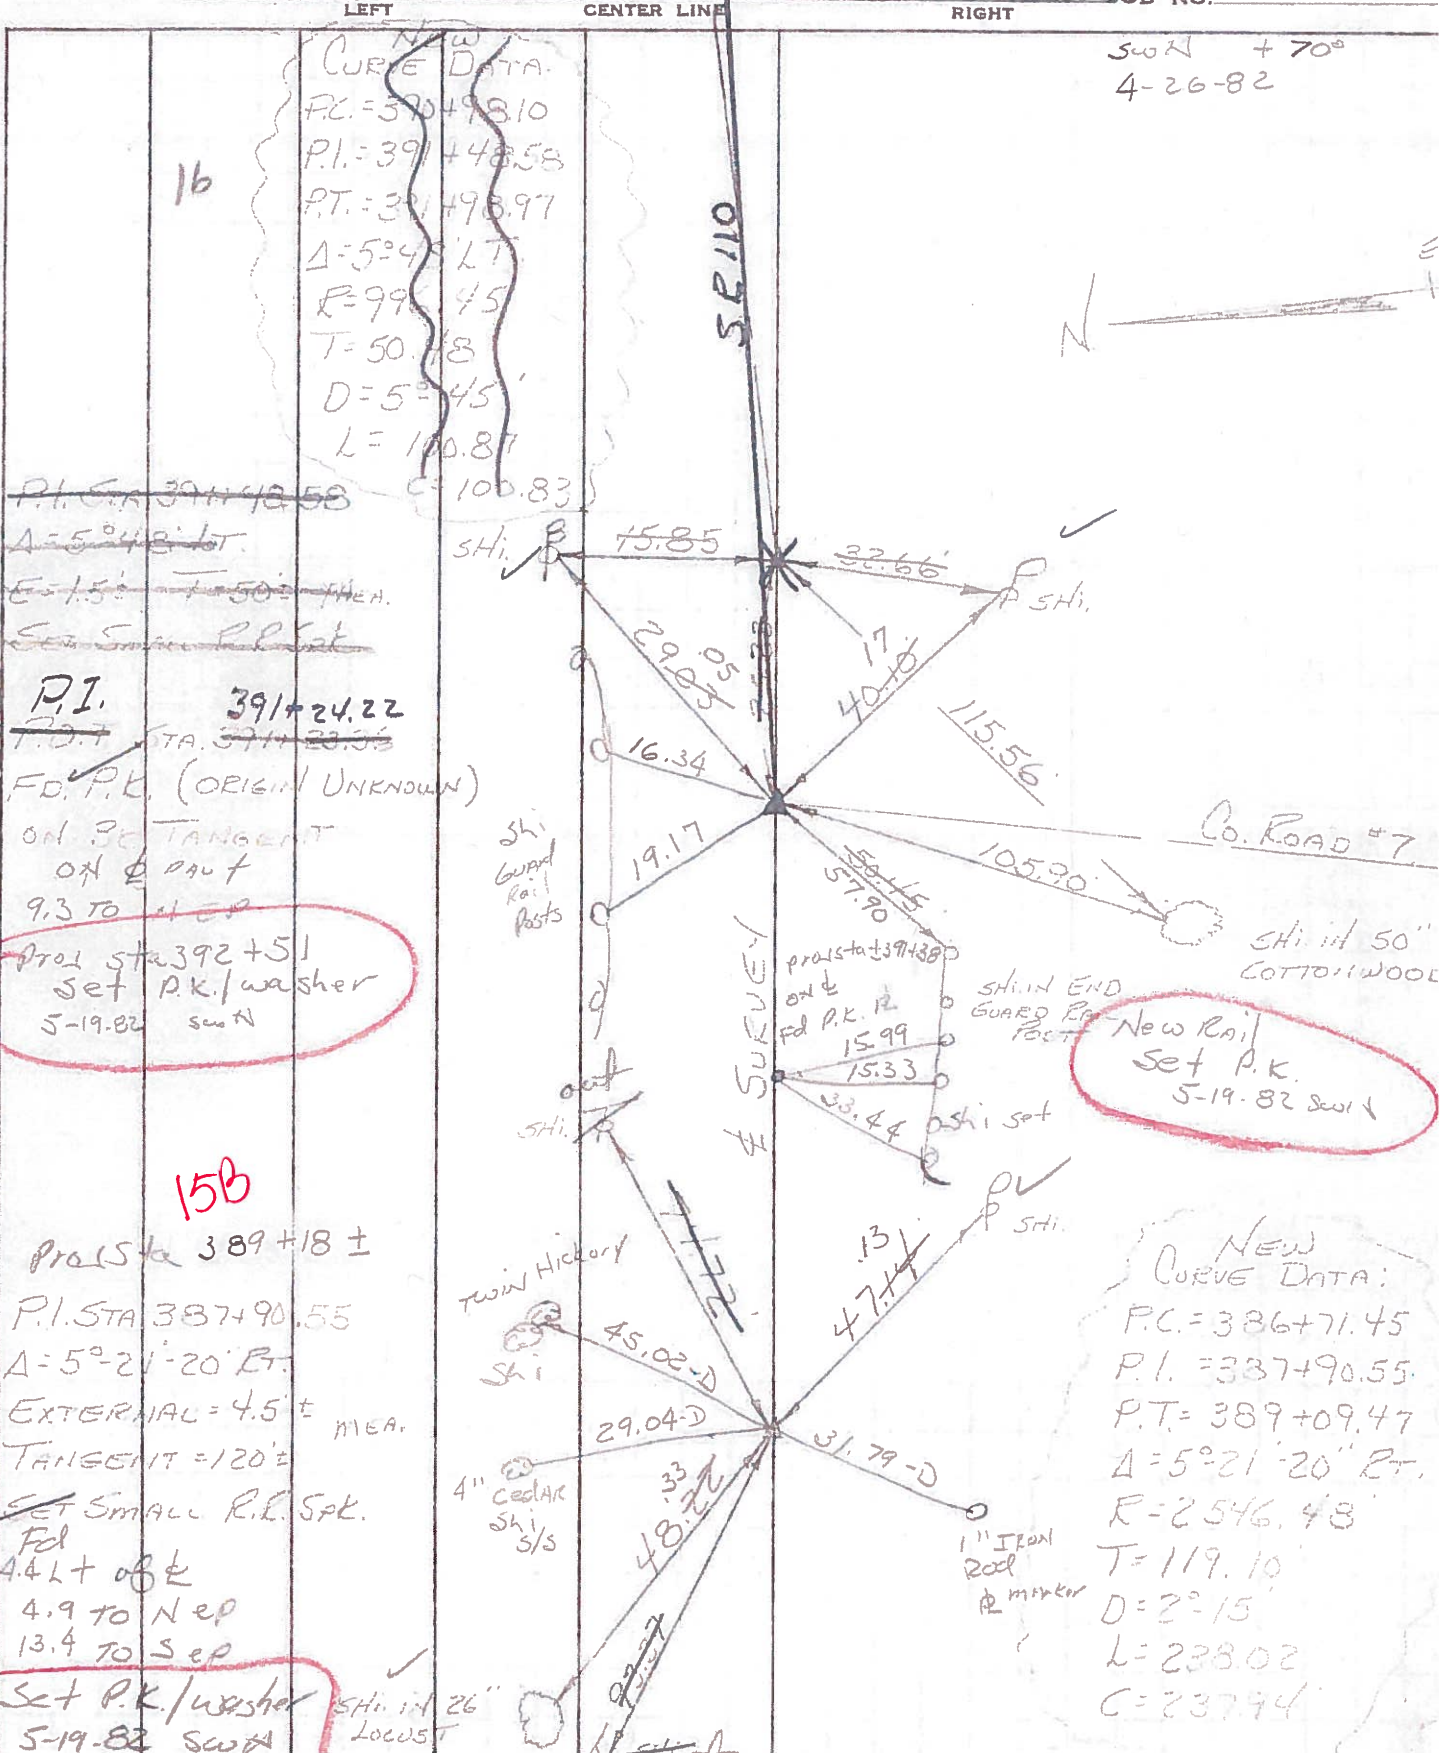

NEW CURVE DATA:
 P.C. = 390+48.10
 P.I. = 391+48.58
 P.T. = 391+48.97
 $\Delta = 5^\circ 45' LT$
 $R = 99.45$
 $T = 50.78$
 $D = 5^\circ 45'$
 $L = 100.87$

SWN +70°
 4-26-82

~~P.I. STA. 391+48.58~~
 ~~$\Delta = 5^\circ 45' LT$~~
 ~~$E = 1.5'$ $T = 50'$ MEAS.~~
~~Set Small R.R. Spk.~~

P.I. 391+24.22
~~P.O.T. STA. 391+23.53~~
 F.D. P.K. (ORIGIN UNKNOWN)
 ON 30' TANGENT
 ON $\frac{1}{2}$ OF
 9.3 TO ~~11.5'~~
 Proj Sta 392+51
 Set P.K./washer
 5-19-82 SWN

Co. Road #7
 SHI in 50' COTTONWOOD
 SHI in END GUARD RAIL POST
 New Rail Set P.K. 5-19-82 SWN

15B
 Proj Sta 389+18 ±
 P.I. STA 387+90.55
 $\Delta = 5^\circ 21' 20" RT$
 EXTERNAL = 4.5' MEAS.
 TANGENT = 120'
 Set Small R.R. Spk.
 Fed
 4.4 L + of k
 4.9 to N ep
 13.4 to S ep
 Set P.K./washer
 5-19-82 SWN

NEW CURVE DATA:
 P.C. = 386+71.45
 P.I. = 387+90.55
 P.T. = 389+09.47
 $\Delta = 5^\circ 21' 20" RT$
 $R = 2546.48$
 $T = 119.10$
 $D = 2^\circ 15'$
 $L = 238.02$
 $C = 237.94$

SHI Guard Rail Posts
 Proj Sta 391+380
 on $\frac{1}{2}$ Fed P.K. R
 15.99
 15.33
 33.44 SHI set
 1" Iron Road marker
 4" CEDAR SHI S/S
 22' TIE
 26" LOCUST