

O.D.O.T. DISTRICT 2 SURVEY OFFICE (USE ONLY)

PERSONNEL

REFERENCE NO. 16

SHEET 16 OF 61

NOTES NIESE

DATE 3/25/24

ROUTE SR 110

H.C. MILLER

WEATHER CLOUDY

COUNTY HENRY

R.C. RHOADES

TEMP. 45°

TOWNSHIP HARRISON

DWG BY RHOADES

PID 114846

SECTION 12

T 5 N R 7 E

TYPE MONUMENT MONBOX W/1" IPIN

ON SURFACE - ~~BELOW~~ ON

OFFSET \odot PAVEMENT ON LT : RT

10.7' TO LT EDGE PAVEMENT


STATION: 384+22.88

HORZ.DATUM: NAD83 2011

GEOID: NAVD88 2018


GRID: NORTHING: 636176.489

EASTING: 1557393.652

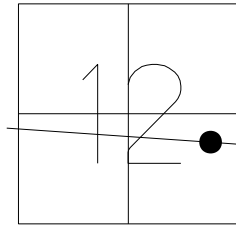

RECORD:
 FD MONBOX
 MONREF16
 9/01/15, JFO
 FD MONBOX
 W/1" IPIN
 REF16
 12/21/21, DSA
 CKREF16
 3/25/24, JAM



HEN LPD
 N: 493021.699
 E: 191849.517

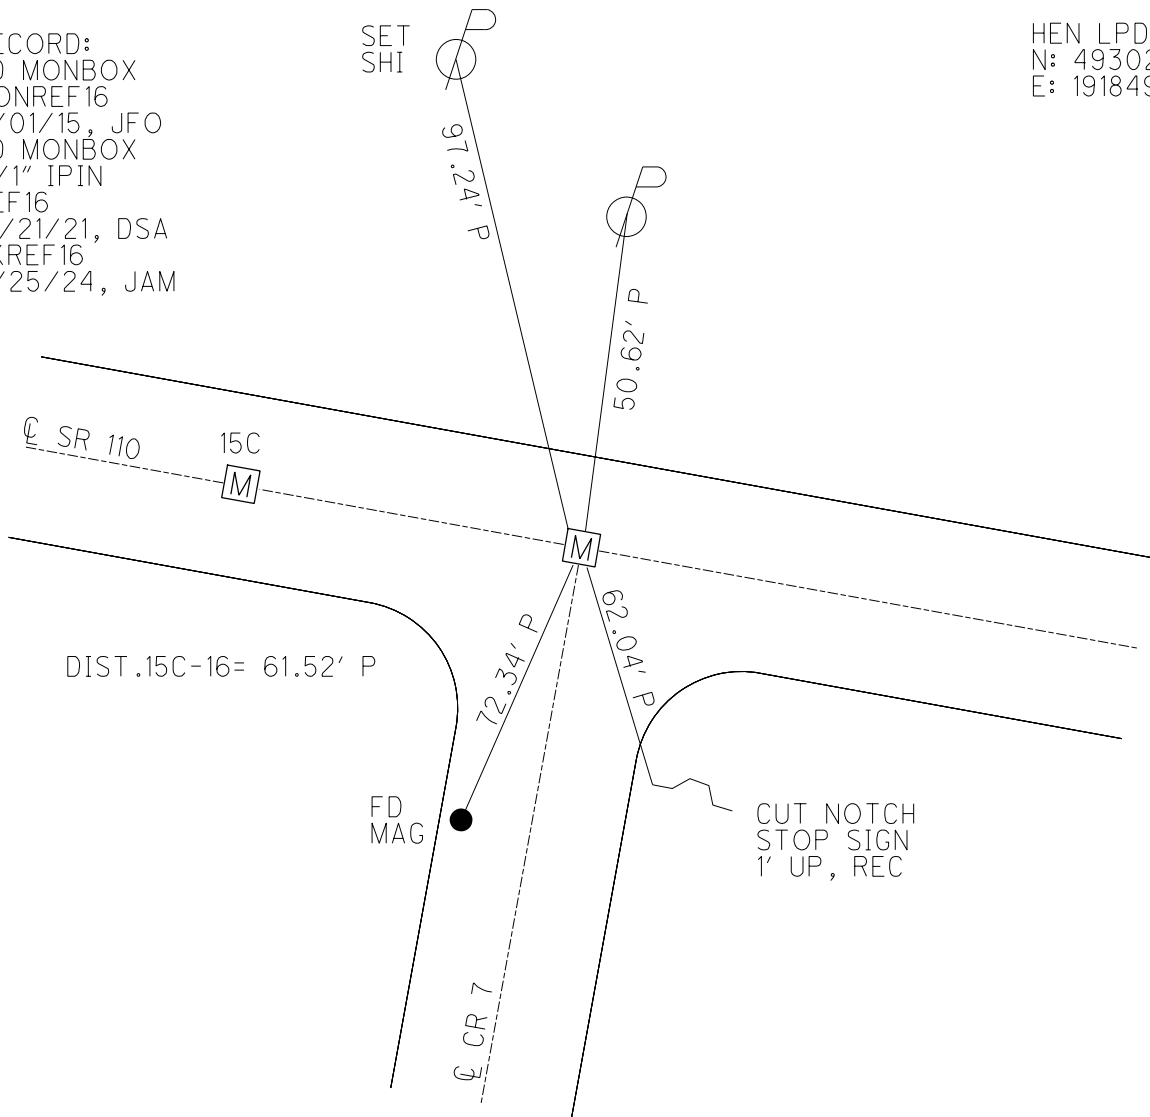

O.D.O.T. DISTRICT 2 SURVEY OFFICE (USE ONLY)

PERSONNEL	REFERENCE NO.	<u>16</u>	SHEET	<u>17</u>	OF	<u>58</u>
NOTES	<u>BARNHISEL</u>	DATE	<u>09/14/04</u>	ROUTE	<u>SR 110</u>	
H.C.	<u>CANTERBURY</u>	WEATHER	<u>CLEAR</u>	COUNTY	<u>HENRY</u>	
R.C.	<u>HOOKER</u>	TEMP.	<u>75°</u>	TOWNSHIP	<u>HARRISON</u>	
				SECTION	<u>12</u>	
				T	<u>5</u>	R
					<u>N</u>	<u>7</u>
					<u>E</u>	

TYPE MONUMENT MON. BOX W/IRON PIN
 ON SURFACE - ~~BELOW~~ ON
~~LEFT~~ - ☉ PAV'T - ~~RIGHT~~ ON
10.7' TO LT EDGE PAVEMENT
 S.L.M. 392+43
 Grid: Northing: 636176.369 Easting: 1557393.560

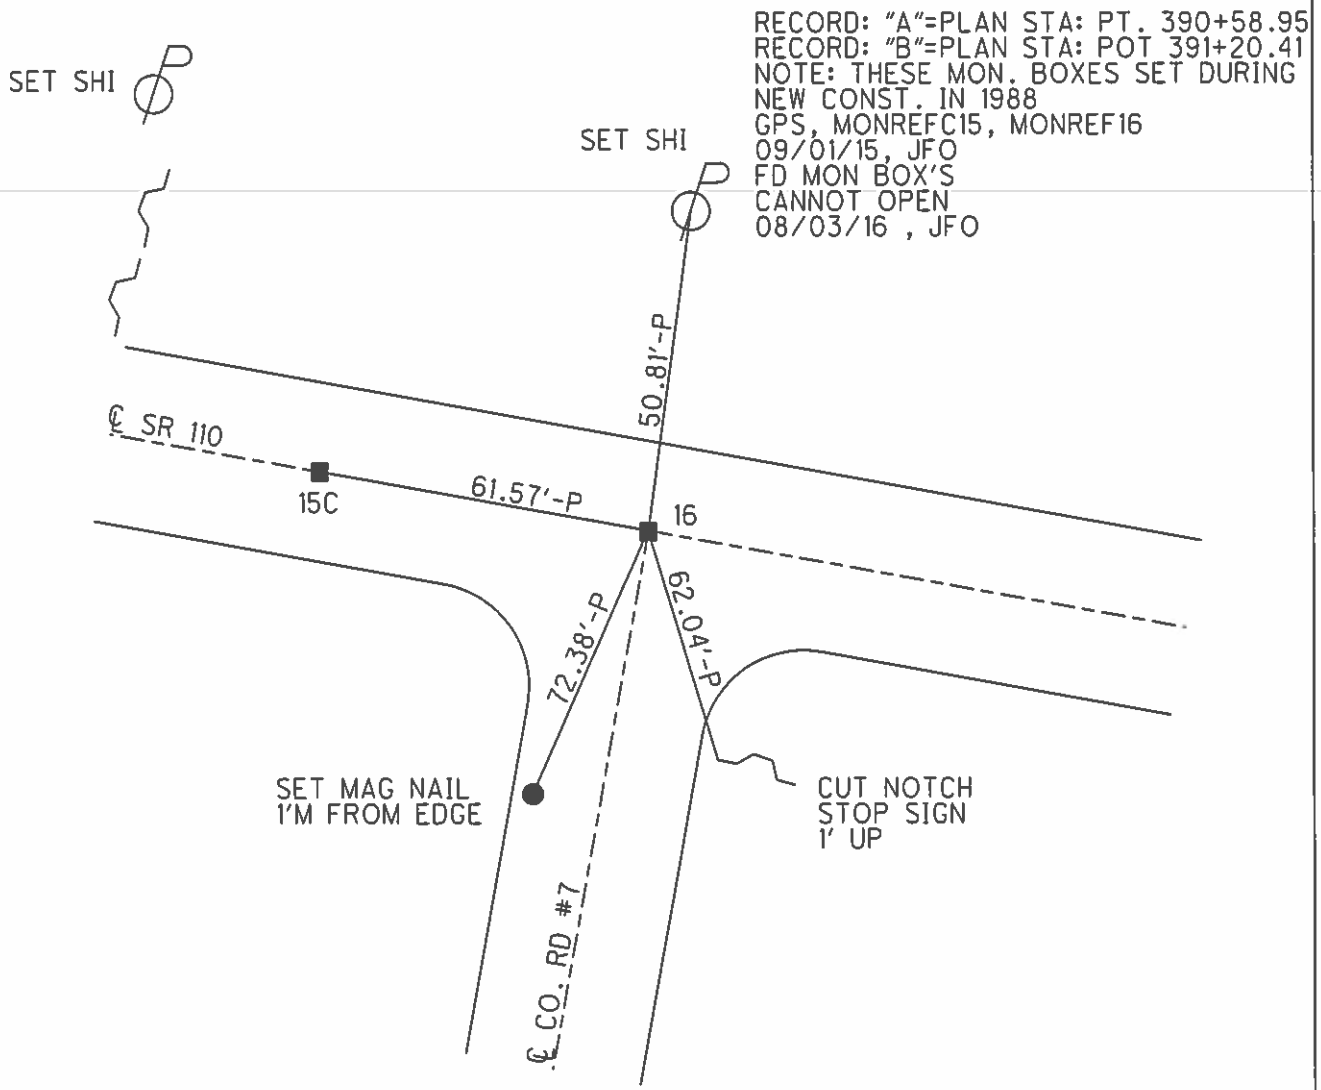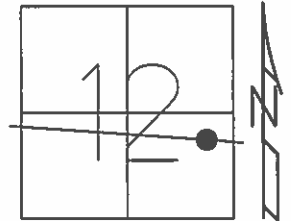

O.D.O.T. DISTRICT 2 SURVEY OFFICE

PERSONNEL

REFERENCE NO. ¹⁹⁸⁸ 16

SHEET 3 OF 37

NOTES BARNHISEL
 H.C. CANTERBURY
 R.C. HOOKER

DATE 09/14/04
 WEATHER CLEAR
 TEMP. +75°

ROUTE 110
 COUNTY HENRY
 TOWNSHIP HARRISON
 SECTION 12
T 5 N R 7 E



TYPE MONUMENT MON. BOX W/IRON PIN

ON SURFACE - ~~BELOW~~ YES

~~LEFT~~ - Q PAV'T - ~~RIGHT~~ YES (BOTH)

10.7' TO LT. EDGE PAVEMENT (BOTH)

S.L.M. 391+82 392+43

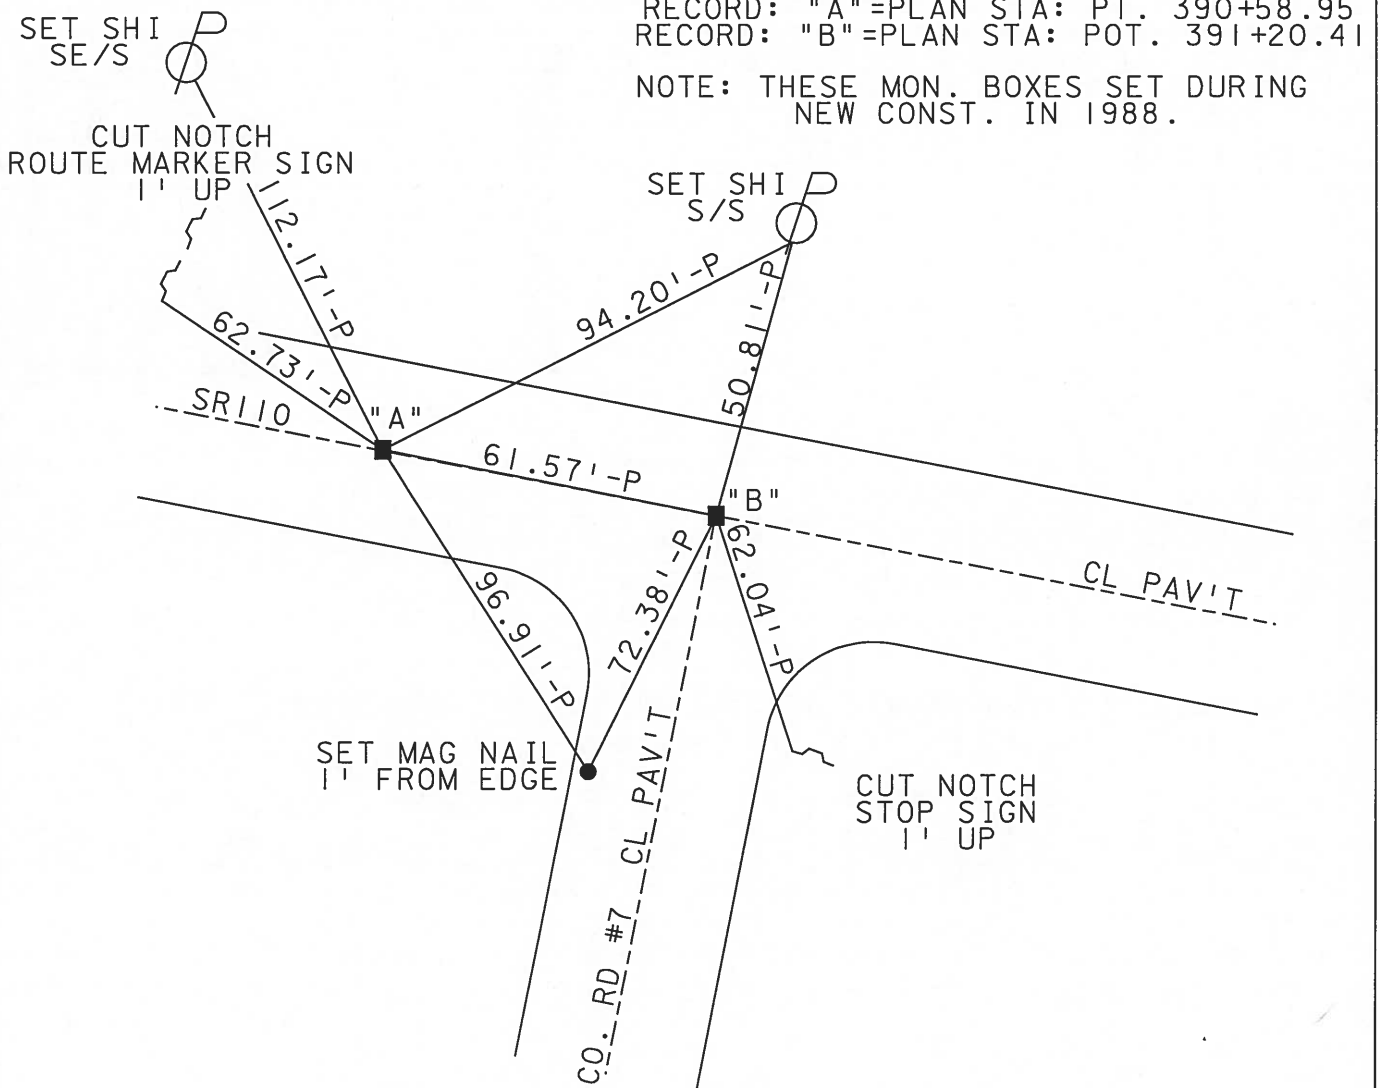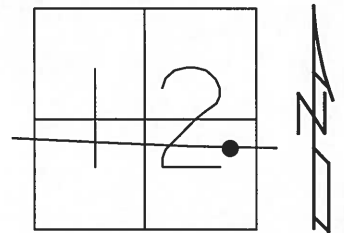

RECORD: "A" = PLAN STA: PT. 390+58.95
 RECORD: "B" = PLAN STA: POT. 391+20.41

NOTE: THESE MON. BOXES SET DURING
 NEW CONST. IN 1988.

Q.D.O.T. DISTRICT 2 SURVEY OFFICE

SHEET 4 OF

County HENRY S.R. 110

Date 4-26-82

Township HARRISON


Weather _____

Section _____

Temp. +70°

T5N, R7E

Personnel HOFFMAN

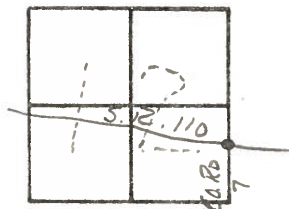

LOEHRKE

HOUSEHOLDER

#16

Proj. STA. 392+51


OLD ALIGNMENT

P.I. STA. 391+24.22
 F.D. P.K. (ORIGIN UNKNOWN)
 ON BK. TANGENT. $\frac{1}{2}$ PAVE.
 9.3' TO N.E.R.
 $\Delta = 4^{\circ}23'LT$

SET P.K./WASHER
 5-19-82
 S.W.H.

SET P.K.
 5-19-82
 S.W.H.

F.D. P.K. ON $\frac{1}{2}$

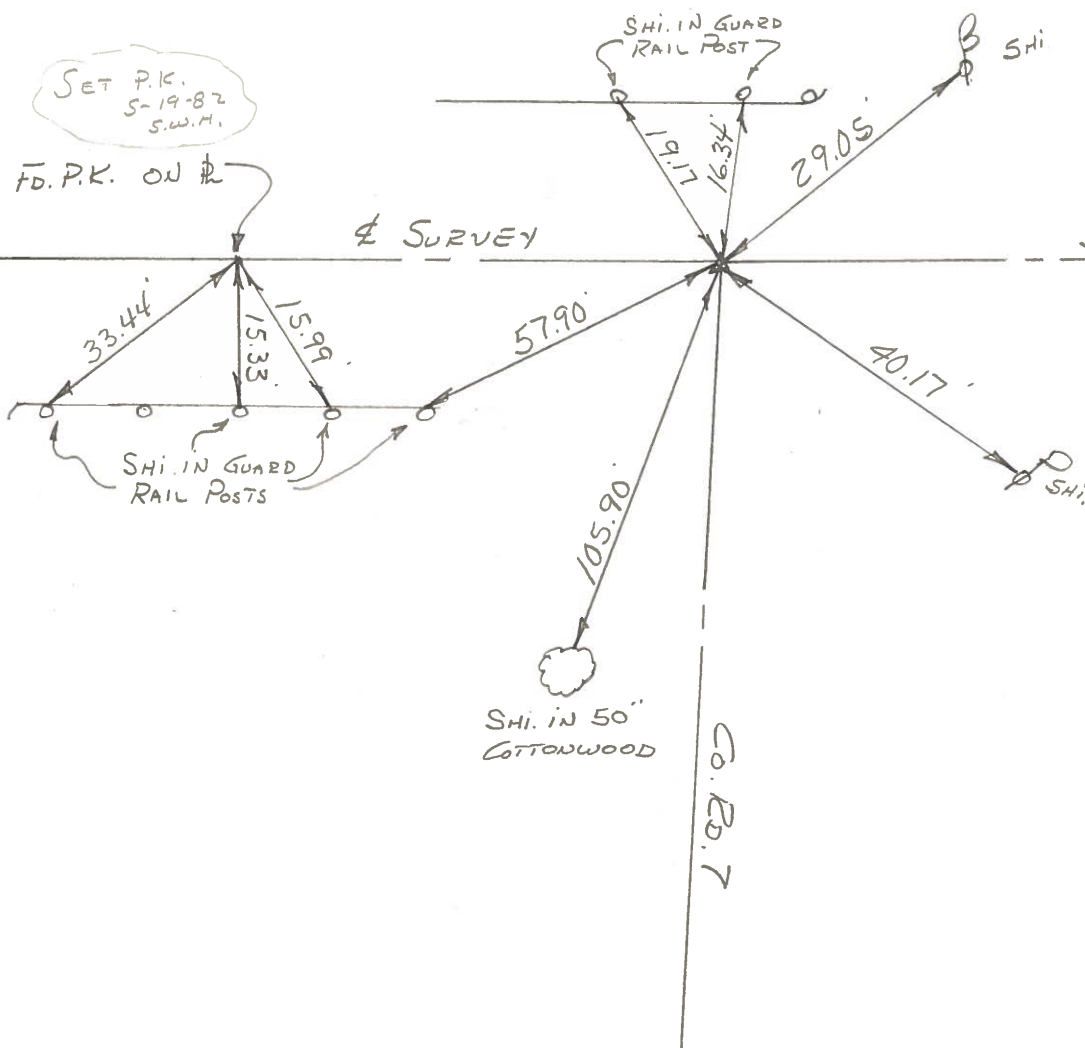


PERSONNEL TITLE PERSONNEL TITLE
 BURNSIDE _____
 SMITH _____
 POWERS _____
 MEAD _____

COUNTY HENRY DATE 4-2-73
 S. R. 110 WEATHER SHOWERS
 SEC. _____ TEMP +43°

DESCRIPTION ± SURVEY CONTROL TIES

JOB NO. _____
 SWN +70°
 4-26-82

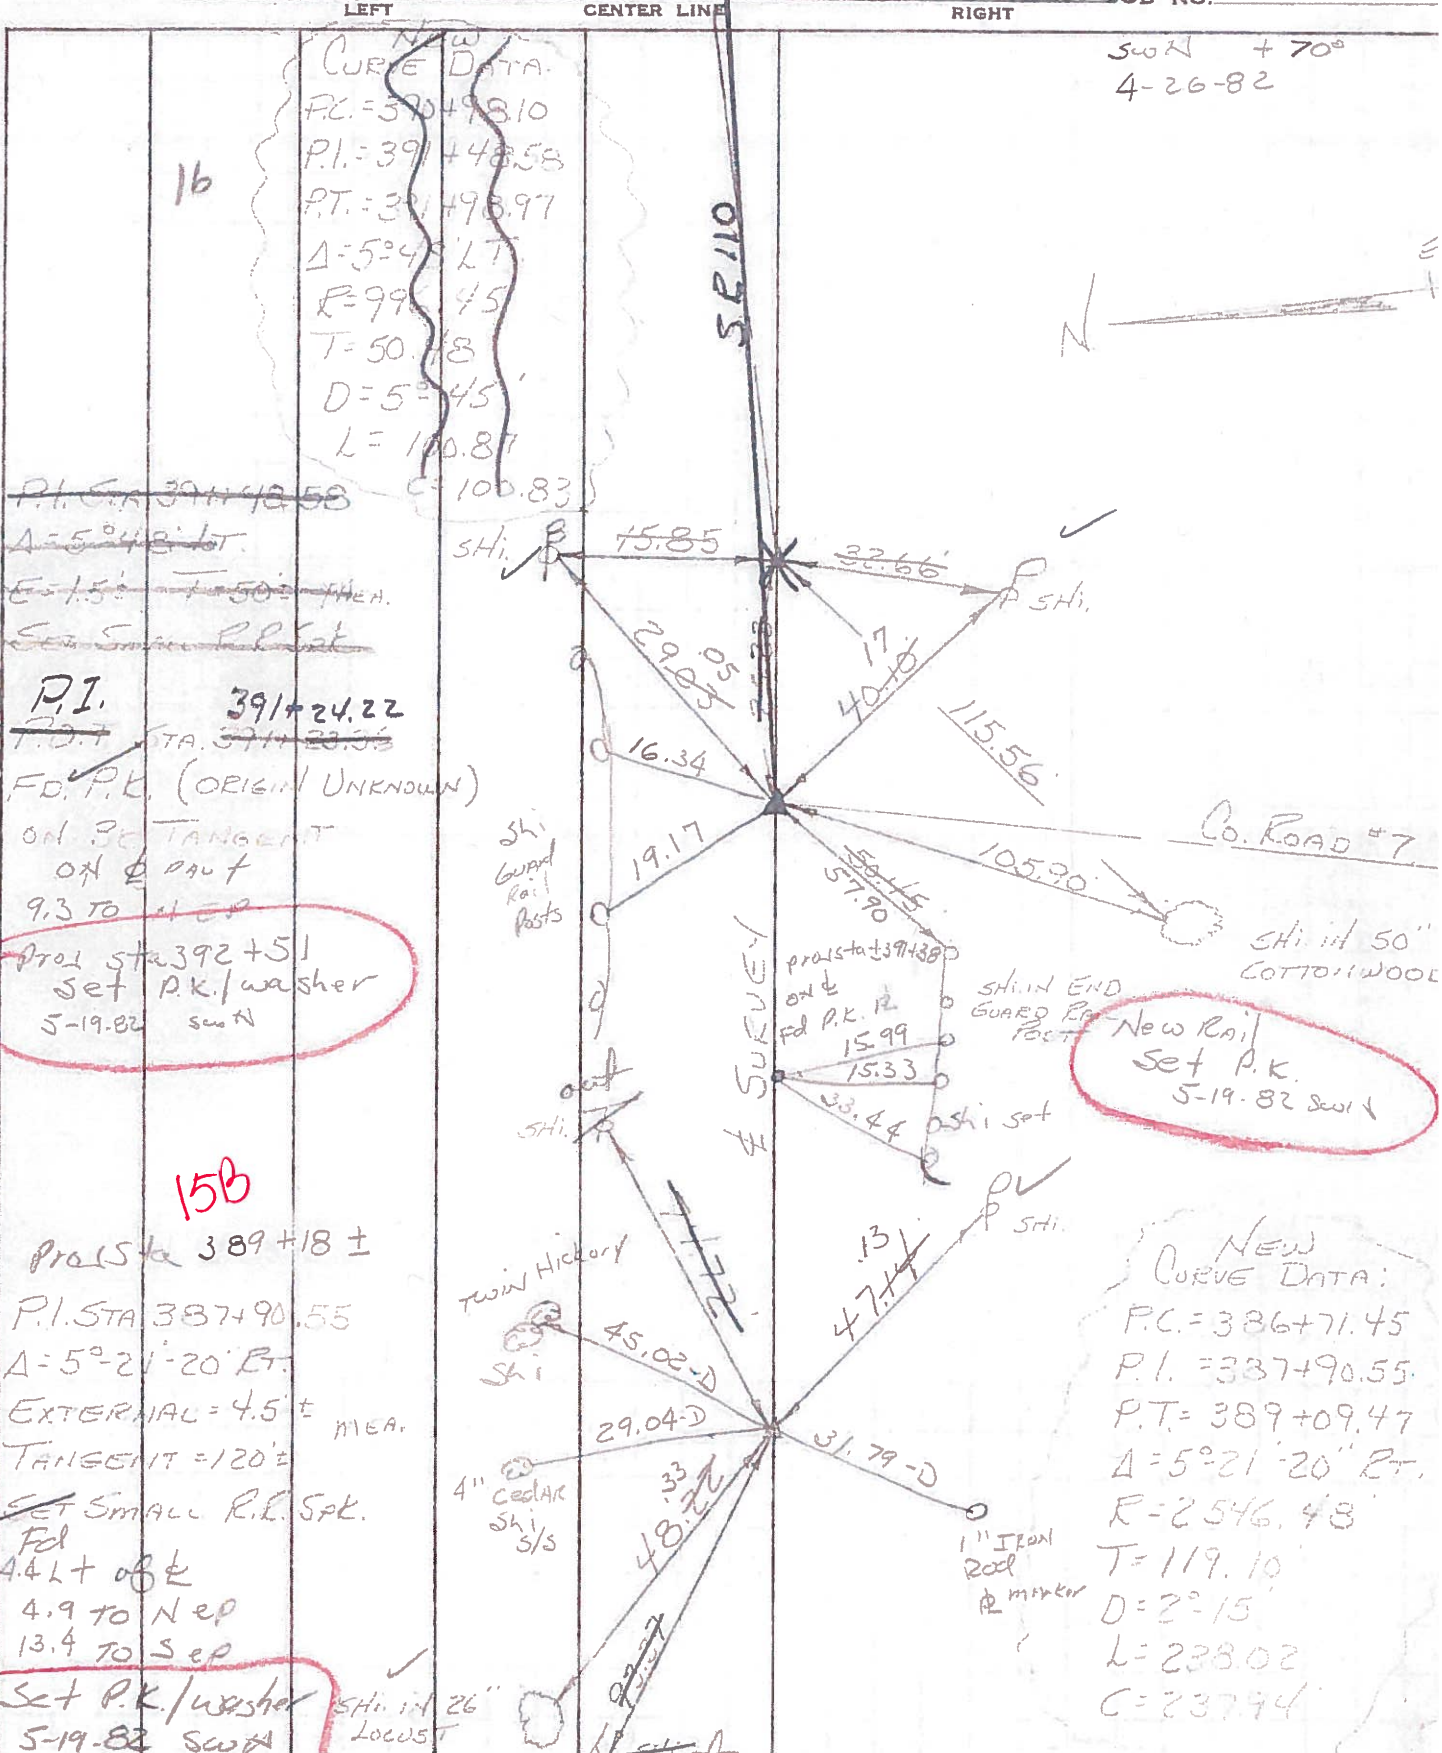

CURVE DATA:
 P.C. = 390+48.10
 P.I. = 391+48.58
 P.T. = 391+48.97
 $\Delta = 5^\circ 45' LT$
 $R = 99.45$
 $T = 50.78$
 $D = 5^\circ 45'$
 $L = 100.87$

~~P.I. STA. 391+48.58~~
 ~~$\Delta = 5^\circ 45' LT$~~
 ~~$E = 1.5'$ $T = 50'$ MEAS.~~
~~Set Small R.P. Set~~

P.I. 391+24.22
~~P.O.T. STA. 391+23.53~~
 F.D. P.K. (ORIGIN UNKNOWN)
 ON 30' TANGENT
 ON $\frac{1}{2}$ PAUL
 9.3 TO ~~11.5'~~
 Proj Sta 392+51
 Set P.K./washer
 5-19-82 SWN

15B

Proj Sta 389+18 ±
 P.I. STA 387+90.55
 $\Delta = 5^\circ 21' 20'' RT$
 EXTERNAL = 4.5' MEAS.
 TANGENT = 120'
 Set Small R.P. Spk.
 Fed
 4.4 L + off k
 4.9 TO NEP
 13.4 TO SEP
 Set P.K./washer
 5-19-82 SWN

NEW CURVE DATA:
 P.C. = 386+71.45
 P.I. = 387+90.55
 P.T. = 389+09.47
 $\Delta = 5^\circ 21' 20'' RT$
 $R = 2546.48$
 $T = 119.10$
 $D = 2^\circ 15'$
 $L = 238.02$
 $C = 237.94$