


O.D.O.T. DISTRICT 2 SURVEY OFFICE (USE ONLY)

PERSONNEL _____ REFERENCE NO. 16 A SHEET 17 OF 61
 NOTES NIESE DATE 3/25/24 ROUTE SR 110
 H.C. MILLER WEATHER CLOUDY COUNTY HENRY
 R.C. RHOADES TEMP. 45° TOWNSHIP DAMASCUS
 DWG BY RHOADES PID 114846 SECTION 7
 T 5 N R 8 E


TYPE MONUMENT MONBOX W/1" IPIN
 ON SURFACE - ~~BELOW~~ ON
 OFFSET ☐ PAVEMENT ON LT : RT
10.6' TO LT EDGE PAVEMENT
 STATION: 389+89.65

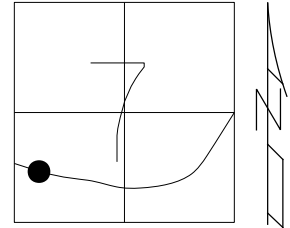

HORIZ.DATUM: NAD83 2011 GEOID: NAVD88 2018
 GRID: NORTHING: 635880.714 EASTING: 1557877.389

RECORD: T.S.
 STA: 396+87.80
 FD MONBOX
 MONREFA16
 09/01/15, JFO
 FD MONBOX
 W/1" IPIN
 REFA16
 12/21/21, DSA
 CKREFA16
 3/25/24, JAM


HEN LPD
 N: 492734.832
 E: 192338.635

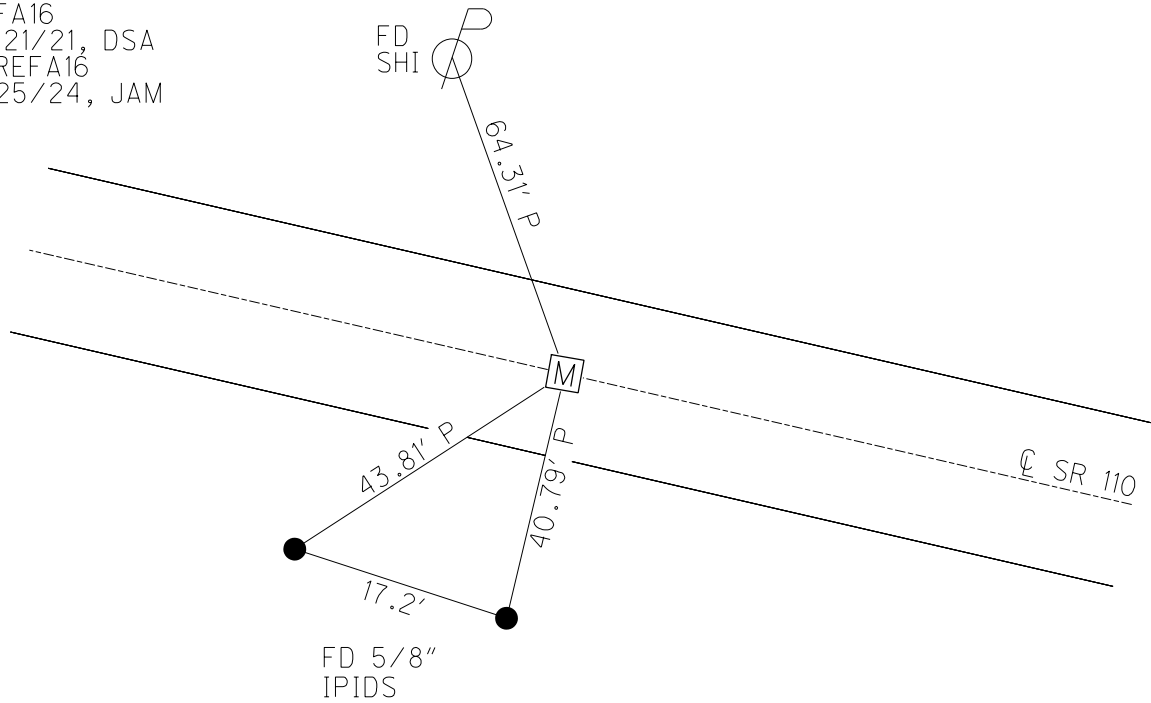

O.D.O.T. DISTRICT 2 SURVEY OFFICE (USE ONLY)


PERSONNEL	REFERENCE NO.	<u>16A</u>	SHEET	<u>18</u> OF <u>58</u>	
NOTES	<u>BARNHISEL</u>	DATE	<u>09/14/04</u>	ROUTE	<u>SR 110</u>
H.C.	<u>CANTERBURY</u>	WEATHER	<u>CLEAR</u>	COUNTY	<u>HENRY</u>
R.C.	<u>HOOKE</u>	TEMP.	<u>75°</u>	TOWNSHIP	<u>DAMASCUS</u>
				SECTION	<u>07</u>
				<u>T 5 N</u>	<u>R 8 E</u>

TYPE MONUMENT MON. BOX W/IRON PIN
 ON SURFACE - ~~BELOW~~ ON
~~LEFT~~ - Q PAV'T - ~~RIGHT~~ ON
10.6' TO LT EDGE PAVEMENT
 S.L.M. 398+11

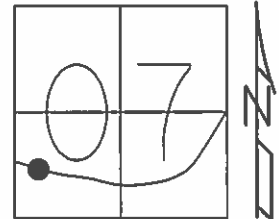

Grid: Northing: 635880.689 Easting: 1557877.339

RECORD: TS. PLAN
 STA: 396+87.80
 NOTE: THIS MON. BOX
 SET DURING CONST.
 IN 1988
 GPS, MONREFA16
 09/01/15, JFO
 FD MON BOX
 CANNOT OPEN
 08/03/16, JFO

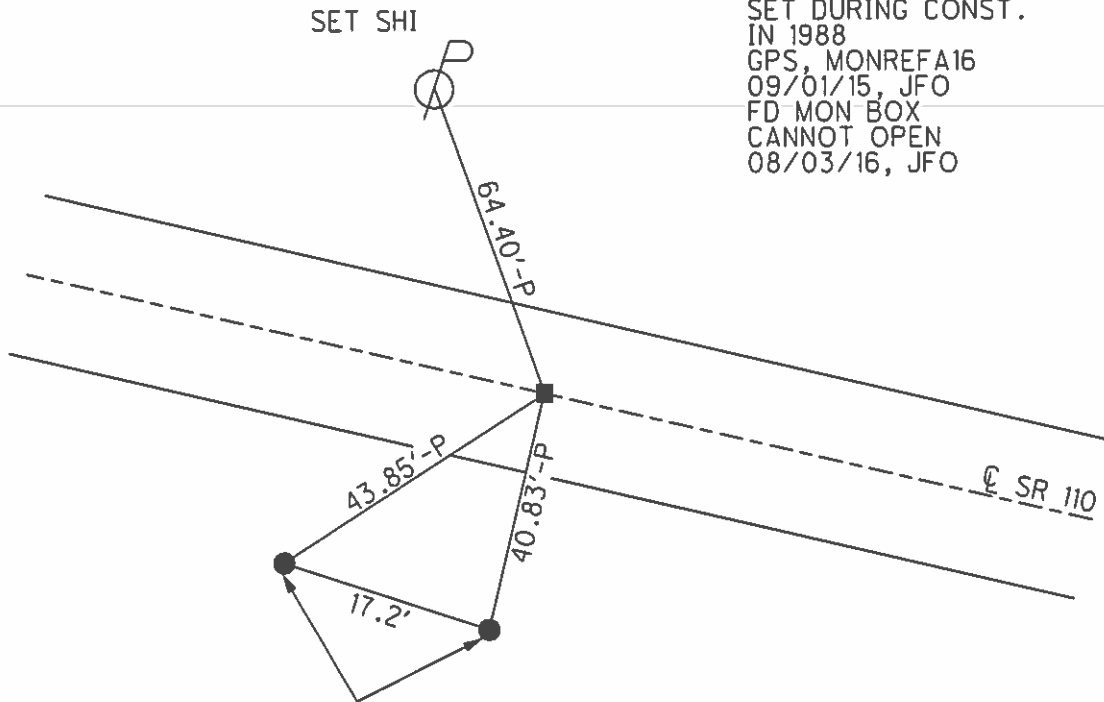

SET (5/8") CAPPED IRON ROD

O.D.O.T. DISTRICT 2 SURVEY OFFICE

PERSONNEL _____

REFERENCE NO. ¹⁹⁸⁸ 16A

SHEET 4 OF 37

NOTES BARNHISEL

DATE 09/14/04

ROUTE S.R. 110

H.C. CANTERBURY

WEATHER CLEAR

COUNTY HENRY

R.C. HOOKER

TEMP. +75°

TOWNSHIP DAMASCUS

SECTION 07

T 5 N R 8 E


TYPE MONUMENT MON BOW W/IRON PIN

ON SURFACE - ~~BELOW~~ YES


~~LEFT~~ - Q PAV'T - ~~RIGHT~~ YES

10.6' TO LT EDGE PAVEMENT

S.L.M. 398+11

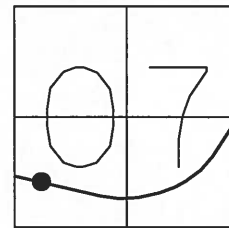

RECORD: TS.
PLAN STA: 396+87.80

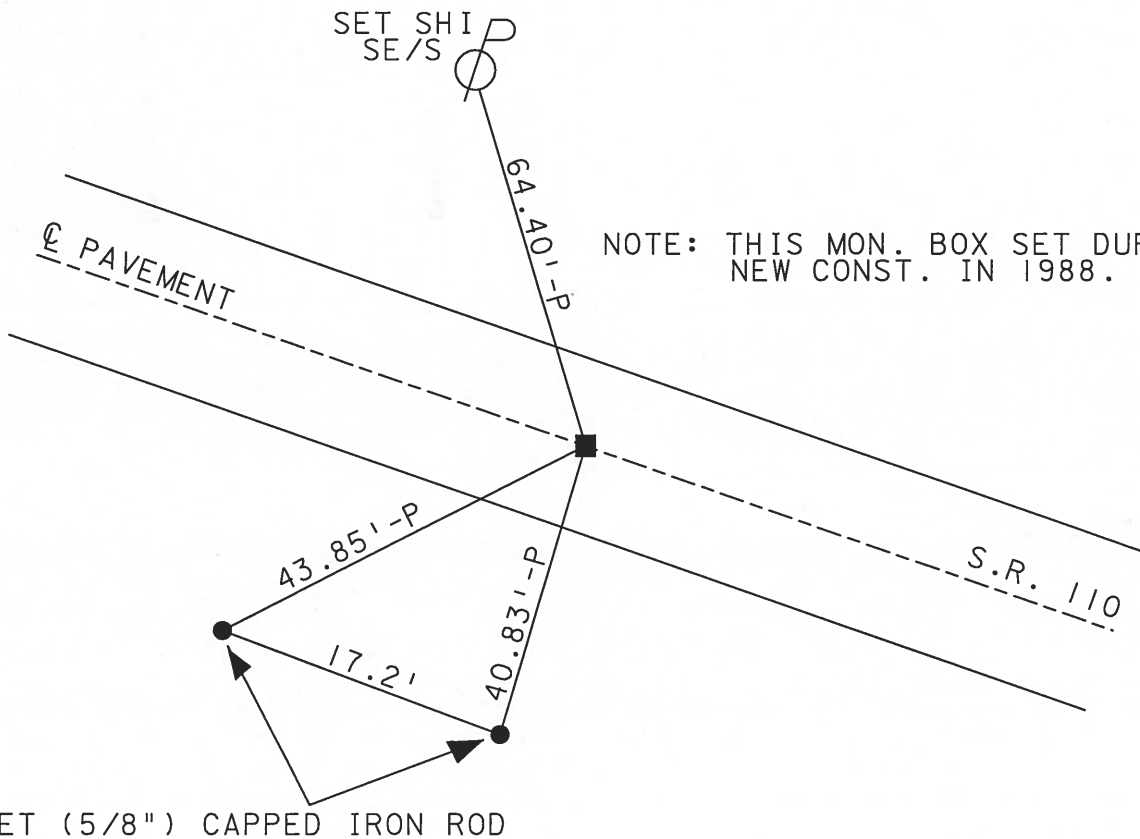

NOTE: THIS MON. BOX SET DURING NEW CONST. IN 1988.

SET (5/8") CAPPED IRON ROD

County HENRY S.R. 110

Date 4-26-82

Township DAMASCUS

Weather _____

Section 7

Temp. +70°


T5N, R8E

Personnel HOFFMAN

16A

LOEHRKE

HOUSEHOLDER

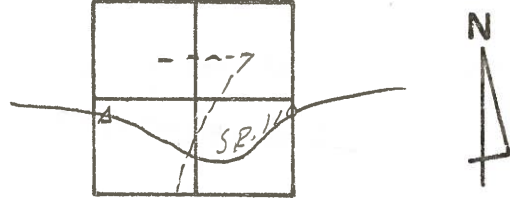


Proj. Sta. 399+96

Old Alignment

P.I. STA. 398+69.38
 $\Delta = 6^\circ - 33' \text{ Lt.}$
 P.C. = 397+79.50
 P.T. = 399+59.05

FD. SMALL R.R. SPK.
 30' RT. OF ϕ
 6.0' S.-E.P.
 11.9' N.-E.P.

SET P.K./WASHER
 5-20-82
 S.W.H.

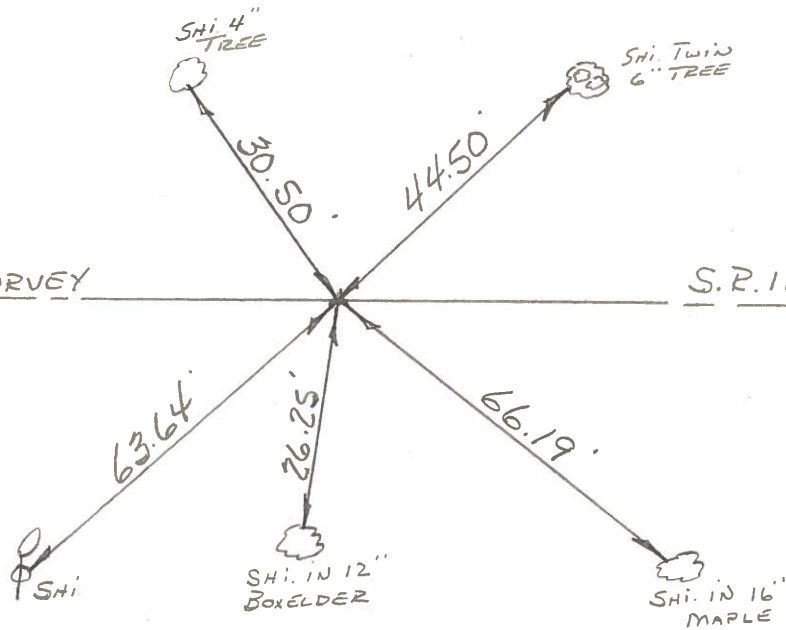


PERSONNEL TITLE PERSONNEL TITLE
BUENSIDE _____
SMITH _____
BOWERS _____
MEAD _____

COUNTY HENRY DATE 4-2-73

S. R. 110 WEATHER SHOWERS

SEC. _____ TEMP. +43°

DESCRIPTION ¢ SURVEY CONTROL TIES JOB NO. _____

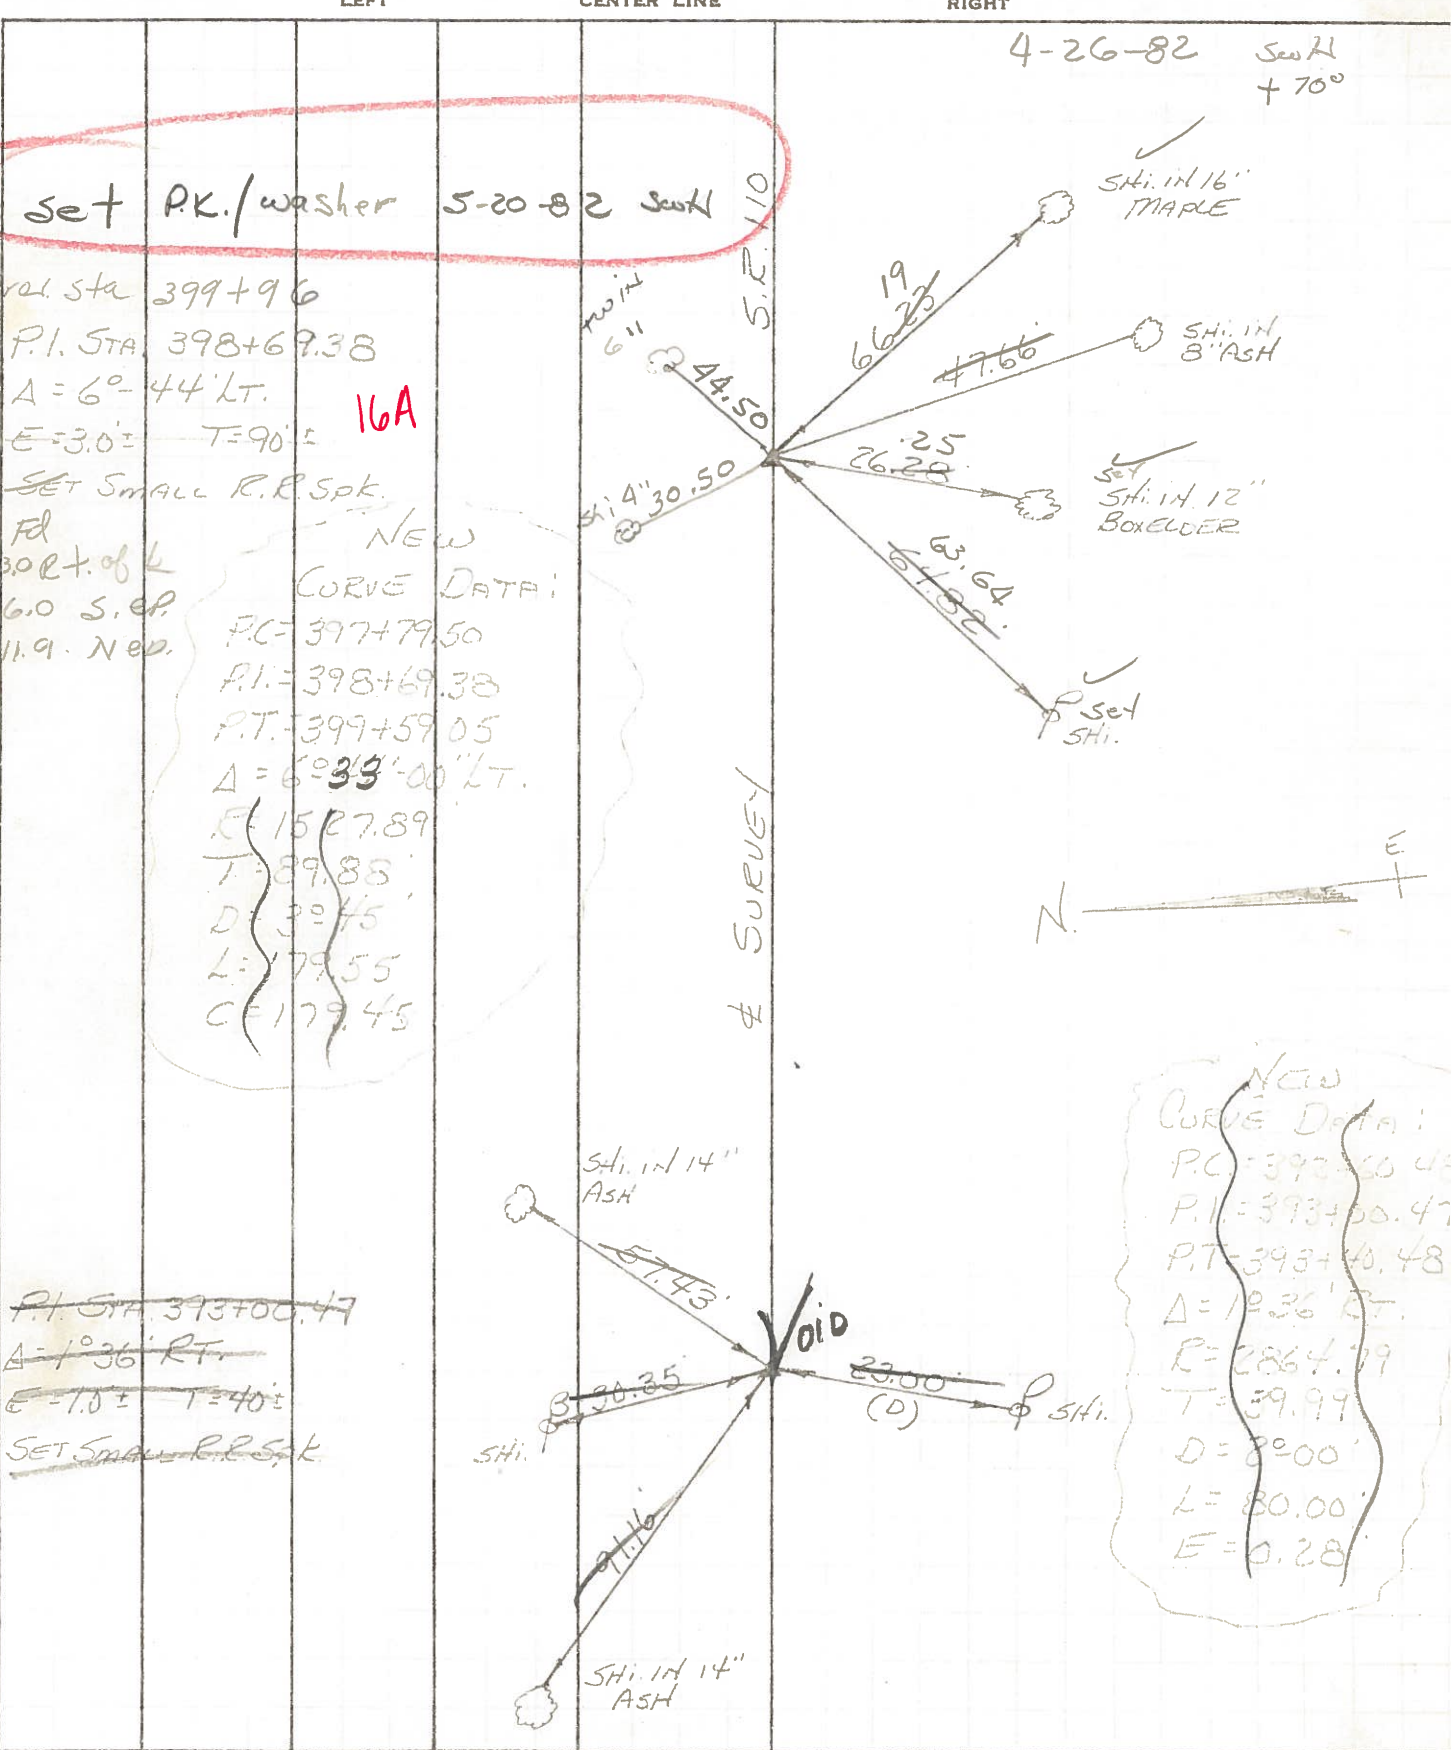

PERSONNEL	TITLE	PERSONNEL	TITLE
BURNSIDE			
SMITH			
BOWERS			
MEAD			

COUNTY HENRY DATE 4-2-73
 S. R. 110 WEATHER SHOWERS
 SEC. _____ TEMP. +43°

DESCRIPTION ¢ SURVEY CONTROL TIES JOB NO. _____

