


O.D.O.T. DISTRICT 2 SURVEY OFFICE (USE ONLY)

PERSONNEL _____ REFERENCE NO. 16 B SHEET 18 OF 61
 NOTES NIESE DATE 3/25/24 ROUTE SR 110
 H.C. MILLER WEATHER CLOUDY COUNTY HENRY
 R.C. RHOADES TEMP. 45° TOWNSHIP DAMASCUS
 SECTION 7
 DWG BY RHOADES PID 114846 T 5 N R 8 E


TYPE MONUMENT MONBOX W/1" IPIN
 ON SURFACE - ~~BELOW~~ ON
 OFFSET \odot PAVEMENT ON LT : RT
10.7' TO RT EDGE PAVEMENT
 STATION: 393+89.65

HORZ.DATUM: NAD83 2011 GEOID: NAVD88 2018
 GRID: NORTHING: 635693.094 EASTING: 1558228.808

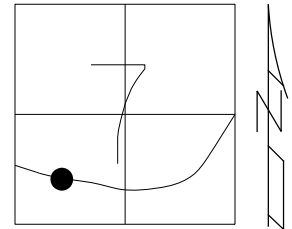

RECORD: S.C.
 FD MONBOX
 MONREFB16
 9/01/15, JFO
 FD MONBOX
 W/ 1" IPIN
 REFB16
 12/21/21, DSA
 CKREFB16
 3/25/24, JAM


HEN LPD
 N: 492553.680
 E: 192693.465

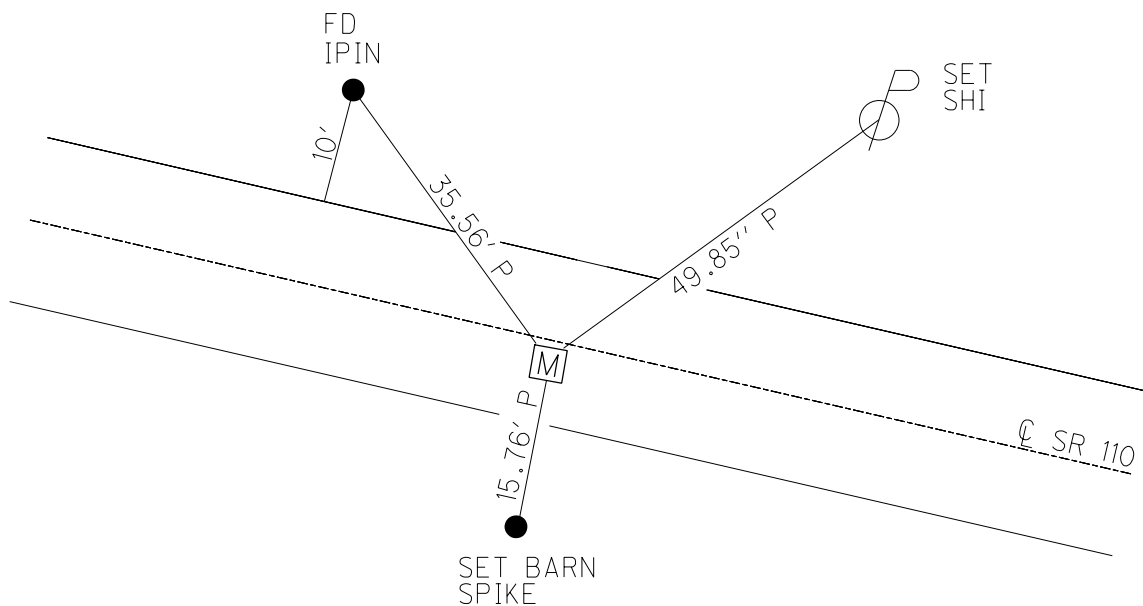


O.D.O.T. DISTRICT 2 SURVEY OFFICE (USE ONLY)

PERSONNEL	REFERENCE NO.	<u>16B</u>	SHEET	<u>19</u>	OF	<u>58</u>
NOTES	<u>BARNHISEL</u>	DATE	<u>09/14/04</u>	ROUTE	<u>SR 110</u>	
H.C.	<u>CANTERBURY</u>	WEATHER	<u>CLEAR</u>	COUNTY	<u>HENRY</u>	
R.C.	<u>HOOKER</u>	TEMP.	<u>75°</u>	TOWNSHIP	<u>DAMASCUS</u>	
				SECTION	<u>07</u>	
				T	<u>5</u>	N
				R	<u>8</u>	E

TYPE MONUMENT MON. BOX W/IRON PIN
 ON SURFACE - ~~BELOW~~ ON
~~LEFT - C PAV'T~~ - RIGHT 1.5'
10.7' TO RT EDGE PAVEMENT
 S.L.M. 402+11
 Grid: Northing: 635693.189 Easting: 1558228.804

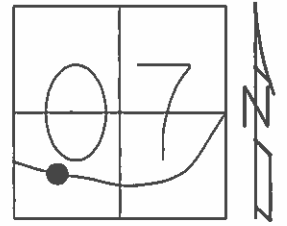

RECORD: CS. PLAN
 STA. 400+87.70
 NOTE: THIS MON. BOX
 SET DURING NEW CONST.
 IN 1988
 GPS, MONREFB16
 09/01/15, JFO
 FD MON BOX
 CANNOT OPEN
 08/03/16, JFO

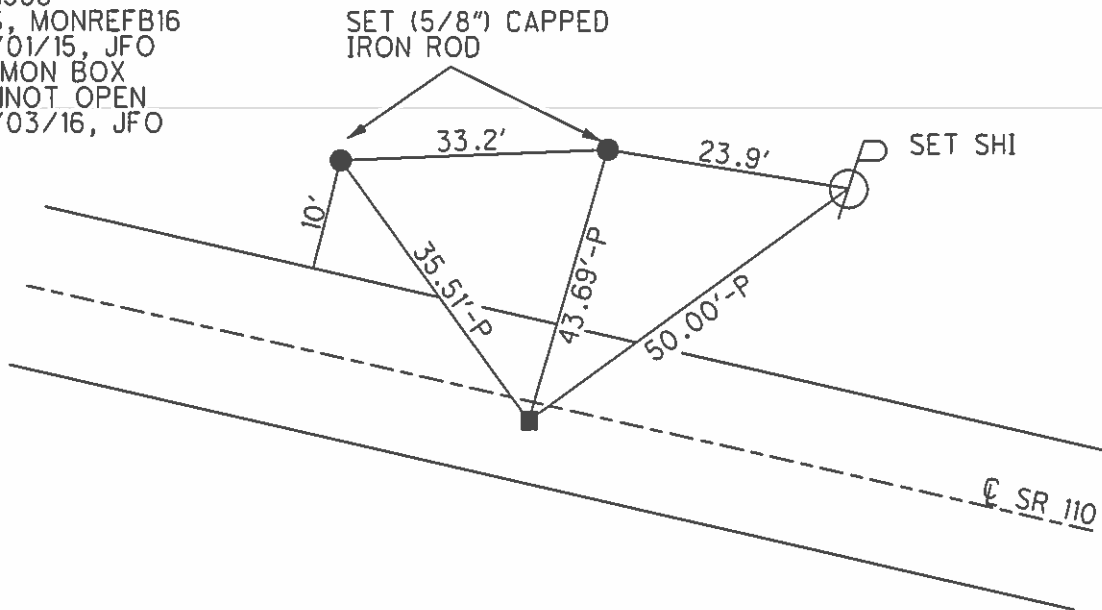

O.D.O.T. DISTRICT 2 SURVEY OFFICE

PERSONNEL

REFERENCE NO. 163¹⁹⁸⁸


SHEET 4.5 OF 37

NOTES BARNHISEL
 H.C. CANTERBURY
 R.C. HOOKER


DATE 09/14/04
 WEATHER CLEAR
 TEMP. +75°

ROUTE S.R. 110
 COUNTY HENRY
 TOWNSHIP DAMASCUS
 SECTION 07
T 5 N R 8 E

TYPE MONUMENT MON BOX W/IRON PIN
 ON SURFACE - ~~BELOW~~ YES
~~LEFT~~ - Q PAV'T - RIGHT 1.5'
10.7' TO RT EDGE PAVEMENT
 S.L.M. 402+11

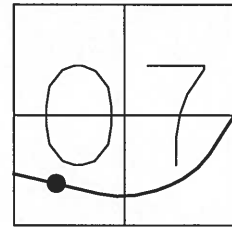

RECORD: CS.
 PLAN STA: 400+87.70

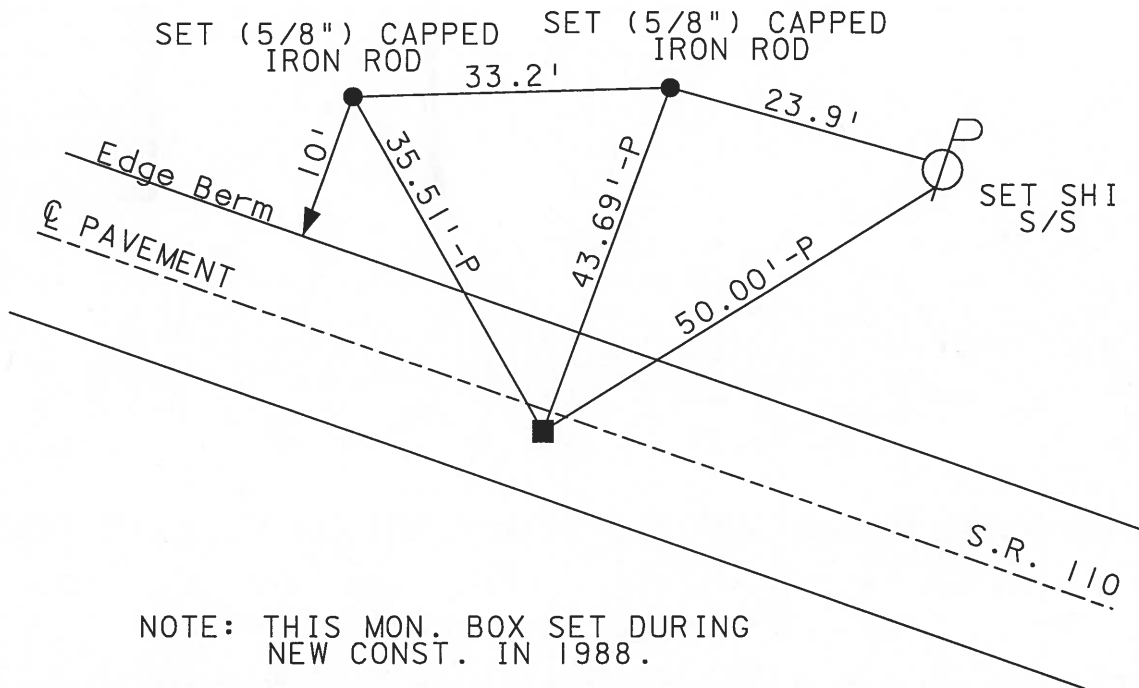

NOTE: THIS MON. BOX SET DURING
 NEW CONST. IN 1988.

County HENRY S.R. 110

Date 4-26-82

Township DAMASCUS

Weather _____

Section 7

Temp. +76°


T5N, R8E

Personnel HOFFMAN

LOEHRKE

HOUSEHOLDER

16B

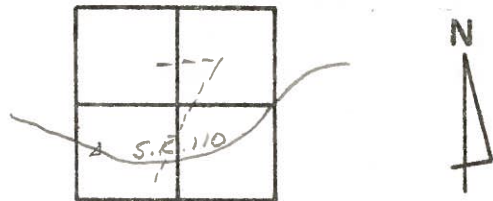

P.I. STA. 404+05.62

Proj. STA. 405+32

P.C. 403+36.02

Old ALIGNMENT

P.T. 404+75.10


$\Delta = 5^{\circ}54'40''$ RT.

R = 1348.14'

T = 69.60'

D = 4°15'

L = 139.08

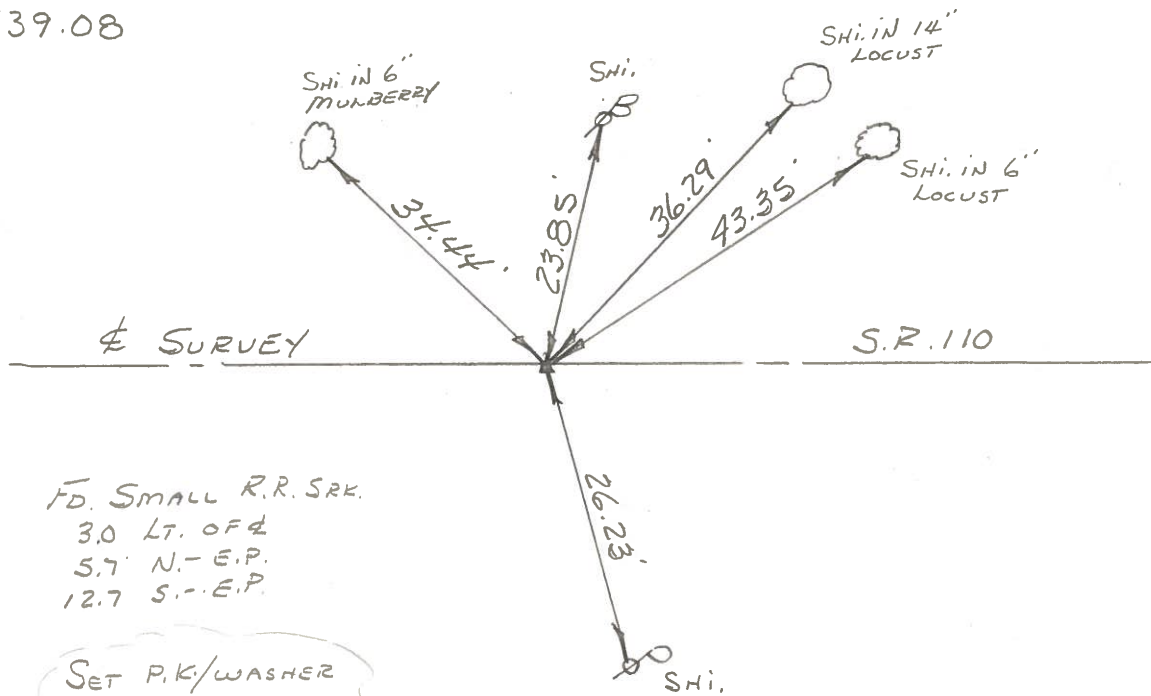


FD. SMALL R.R. SRK.
 3.0 LT. OF Δ
 5.7 N.-E.P.
 12.7 S.-E.P.

SET P.K./WASHER
 S-20-BL
 S.W.H.

PERSONNEL	TITLE	PERSONNEL	TITLE
BURNSIDE			
SMITH			
BOWERS			
MEAD			

COUNTY HENRY DATE 4-2-73
 S. R. 110 WEATHER CLOUDY
 SEC. _____ TEMP. +42°

DESCRIPTION § SURVEY CONTROL TIES

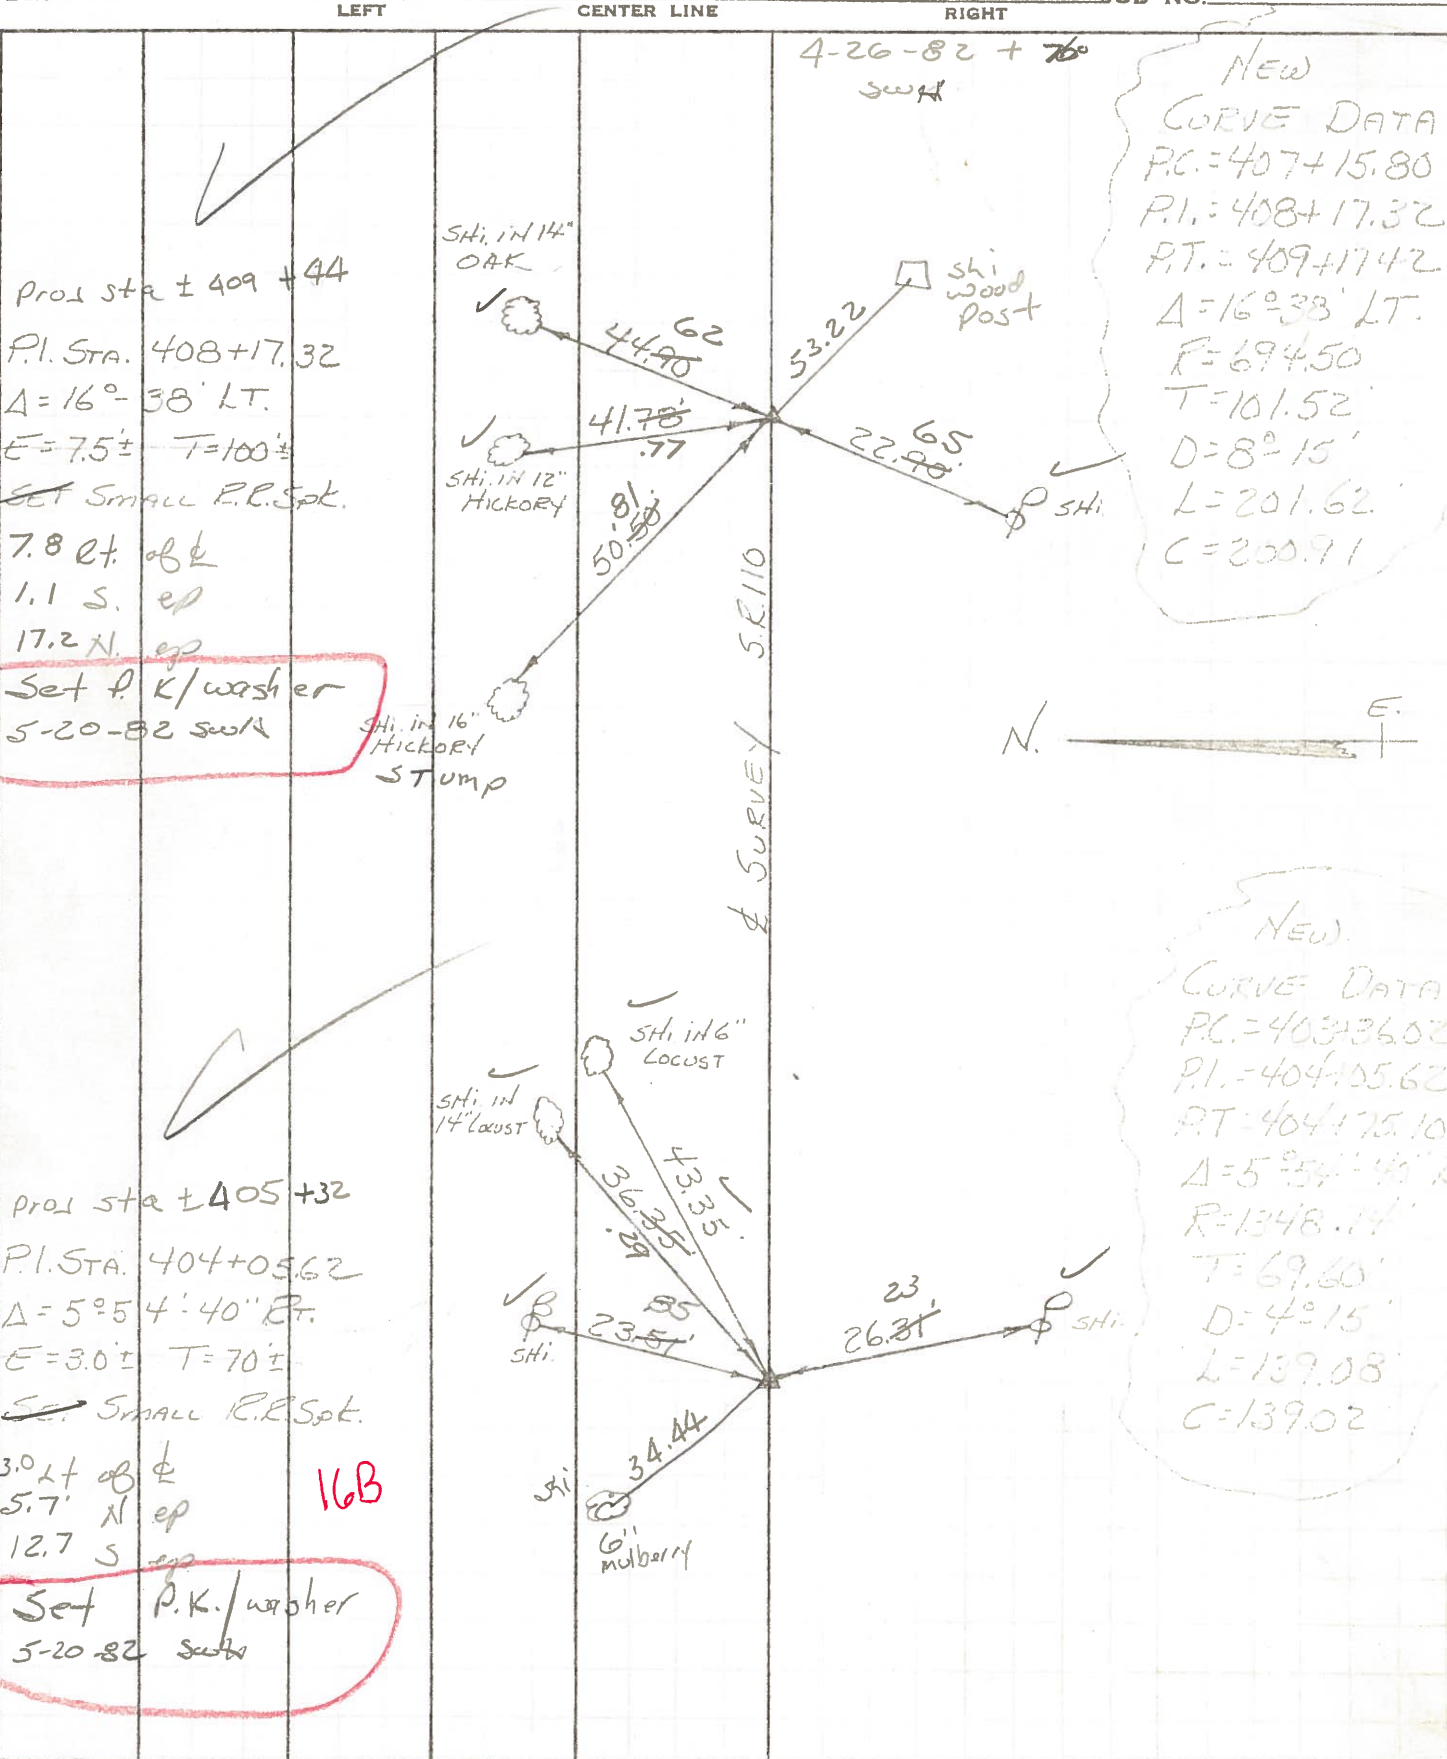

NEW
 CURVE DATA
 P.C. = 407+15.80
 P.I. = 408+17.32
 P.T. = 409+17.42
 Δ = 16° 38' LT.
 R = 694.50
 T = 101.52'
 D = 8° 15'
 L = 201.62'
 C = 200.91

NEW
 CURVE DATA
 P.C. = 403+36.02
 P.I. = 404+05.62
 P.T. = 404+17.10
 Δ = 5° 54' 40" RT.
 R = 1348.14'
 T = 69.60'
 D = 4° 15'
 L = 139.08'
 C = 139.02

Prod Sta ± 409 + 44
 P.I. Sta. 408+17.32
 Δ = 16° 38' LT.
 E = 7.5' ± T = 100' ±
 SET Small P.C. Spk.
 7.8 ct. oak
 1.1 S. ep
 17.2 N. ep
 Set P.K./washer
 5-20-82 Swk


Prod Sta ± 405 + 32
 P.I. Sta. 404+05.62
 Δ = 5° 54' 40" RT.
 E = 3.0' ± T = 70' ±
 SET Small P.C. Spk.
 3.0 ct oak
 5.7 N ep
 12.7 S ep
 Set P.K./washer
 5-20-82 Swk

16B

PERSONNEL TITLE PERSONNEL TITLE
BURNSIDE _____
SMITH _____
BOWERS _____
MEAD _____

COUNTY HENRY DATE 4-2-73
 S. R. 110 WEATHER CLOUDY
 SEC. _____ TEMP. +42°

DESCRIPTION ± SURVEY CONTROL TIES JOB NO. _____

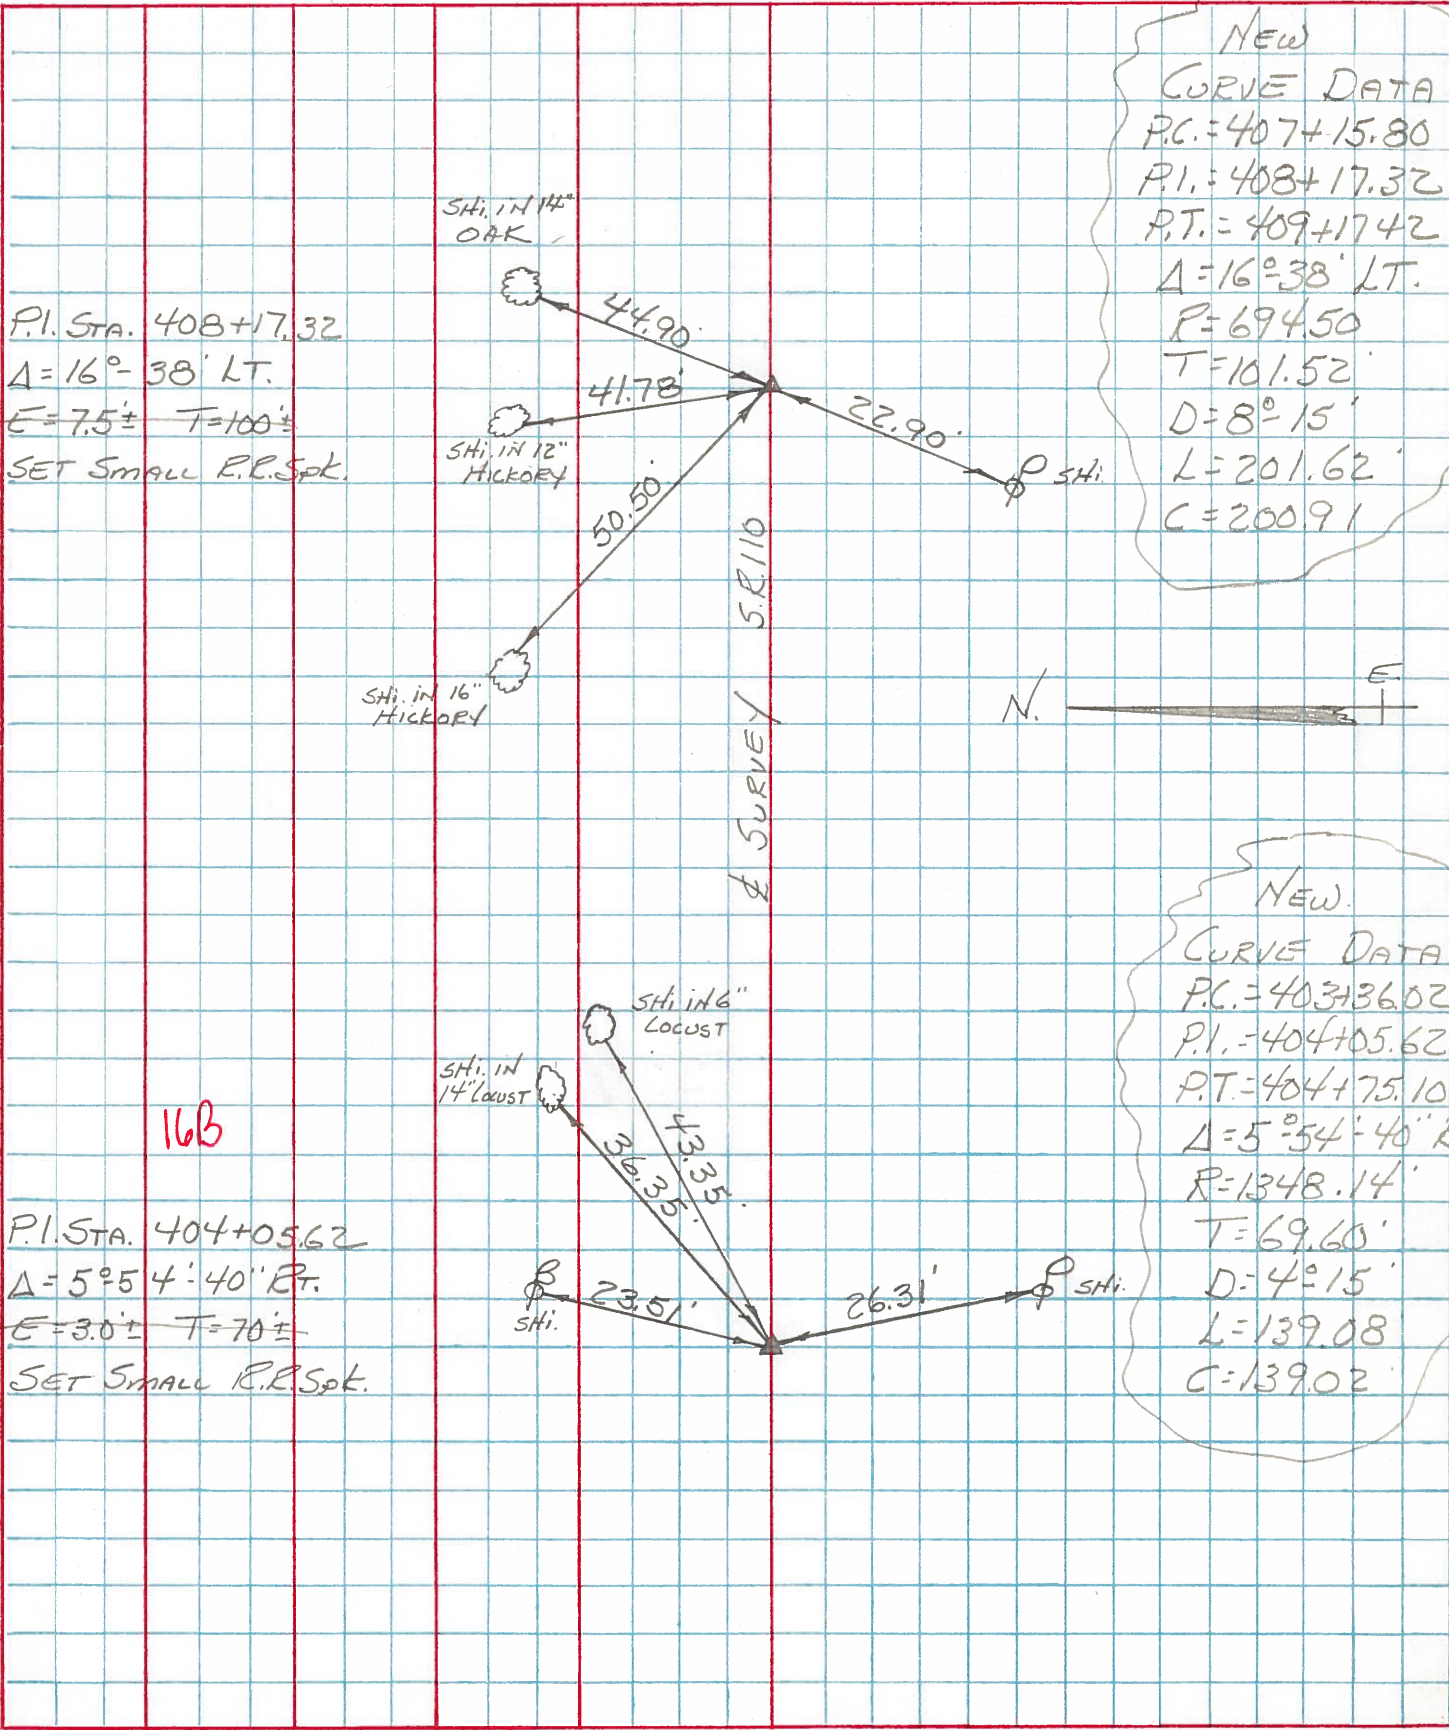

P.I. STA. 408+17.32
 $\Delta = 16^\circ - 38' \text{ LT.}$
 $E = 7.5 \pm$ $T = 100 \pm$
 SET SMALL R.R. Spt.

16B
 P.I. STA. 404+05.62
 $\Delta = 5^\circ 54' 40'' \text{ RT.}$
 $E = 3.0 \pm$ $T = 70 \pm$
 SET SMALL R.R. Spt.

NEW
 CURVE DATA
 P.C. = 407+15.80
 P.I. = 408+17.32
 P.T. = 409+17.42
 $\Delta = 16^\circ - 38' \text{ LT.}$
 $R = 694.50$
 $T = 101.52$
 $D = 8^\circ - 15'$
 $L = 201.62$
 $C = 200.91$

NEW.
 CURVE DATA
 P.C. = 403+36.02
 P.I. = 404+05.62
 P.T. = 404+17.510
 $\Delta = 5^\circ 54' 40'' \text{ RT.}$
 $R = 1348.14'$
 $T = 69.60'$
 $D = 4^\circ 15'$
 $L = 139.08$
 $C = 139.02$