

O.D.O.T. DISTRICT 2 SURVEY OFFICE (USE ONLY)

PERSONNEL

REFERENCE NO. 16 D

SHEET 20 OF 61

NOTES NIESE DATE 3/25/24

H.C. MILLER WEATHER CLOUDY

R.C. RHOADES TEMP. 45°

ROUTE SR 110

COUNTY HENRY

TOWNSHIP DAMASCUS

SECTION 7

DWG BY RHOADES PID 114846

T 5 N R 8 E

TYPE MONUMENT MONBOX W/1" IPIN

ON SURFACE - ~~BELOW~~ ON

OFFSET ☉ PAVEMENT ON LT : RT

11.1' TO RT EDGE PAVEMENT


STATION: 399+95.62

HORZ.DATUM: NAD83 2011

GEOID: NAVD88 2018


GRID: NORTHING: 635603.822

EASTING: 1558825.427

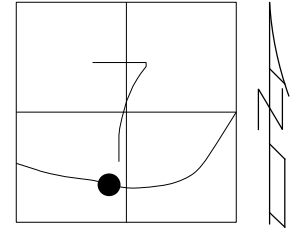

RECORD: S.T.  
 FD MONBOX  
 MONREFD16  
 9/01/15, JFO  
 FD MONBOX  
 REFD16  
 12/21/21, DSA  
 CKREFD16  
 3/25/24, JAM


HEN LPD  
 N: 492475.366  
 E: 193291.664

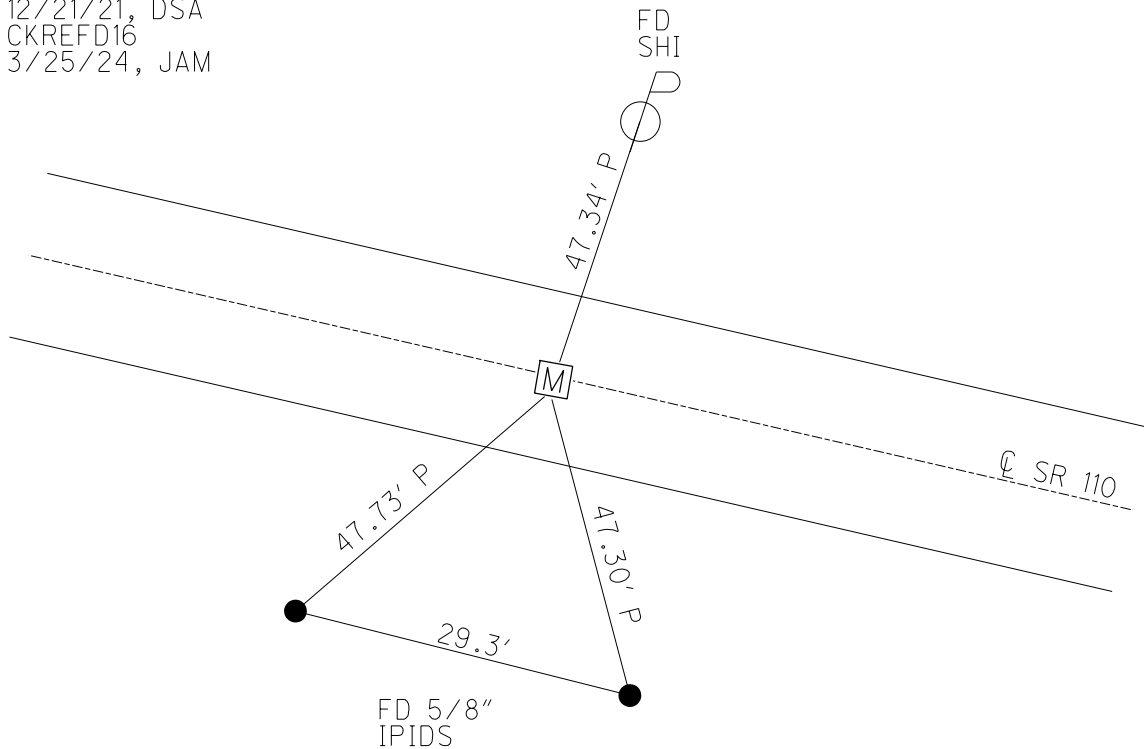


O.D.O.T. DISTRICT 2 SURVEY OFFICE (USE ONLY)

PERSONNEL \_\_\_\_\_ REFERENCE NO. 16D SHEET 21 OF 58  
 NOTES BARNHISEL DATE 09/15/04 ROUTE SR 110  
 H.C. CANTERBURY WEATHER CLEAR COUNTY HENRY  
 R.C. HOOKER TEMP. 80° TOWNSHIP DAMASCUS  
 \_\_\_\_\_ SECTION 07  
 \_\_\_\_\_ T 5 N R 8 E

TYPE MONUMENT MON. BOX W/IRON PIN  
 ON SURFACE - ~~BELOW~~ \_\_\_\_\_ ON \_\_\_\_\_  
~~LEFT~~ - CL PAV'T - ~~RIGHT~~ \_\_\_\_\_ ON \_\_\_\_\_  
11.1' TO RT EDGE PAVEMENT  
 S.L.M. \_\_\_\_\_ 408+17  
 Grid: Northing: 635603.832 Easting: 1558825.400

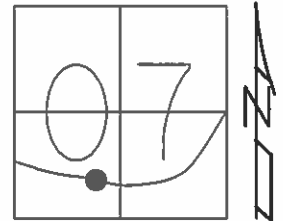

RECORD: ST.  
 PLAN STA: 406+93.62 BK  
 PLAN STA: 406+96.31 AH  
 NOTE: THIS MON. BOX SET  
 DURING NEW CONST. IN 1988  
 GPS, MONREFD16  
 09/01/15, JFO  
 FD MON BOX  
 CANNOT OPEN  
 08/03/16, JFO

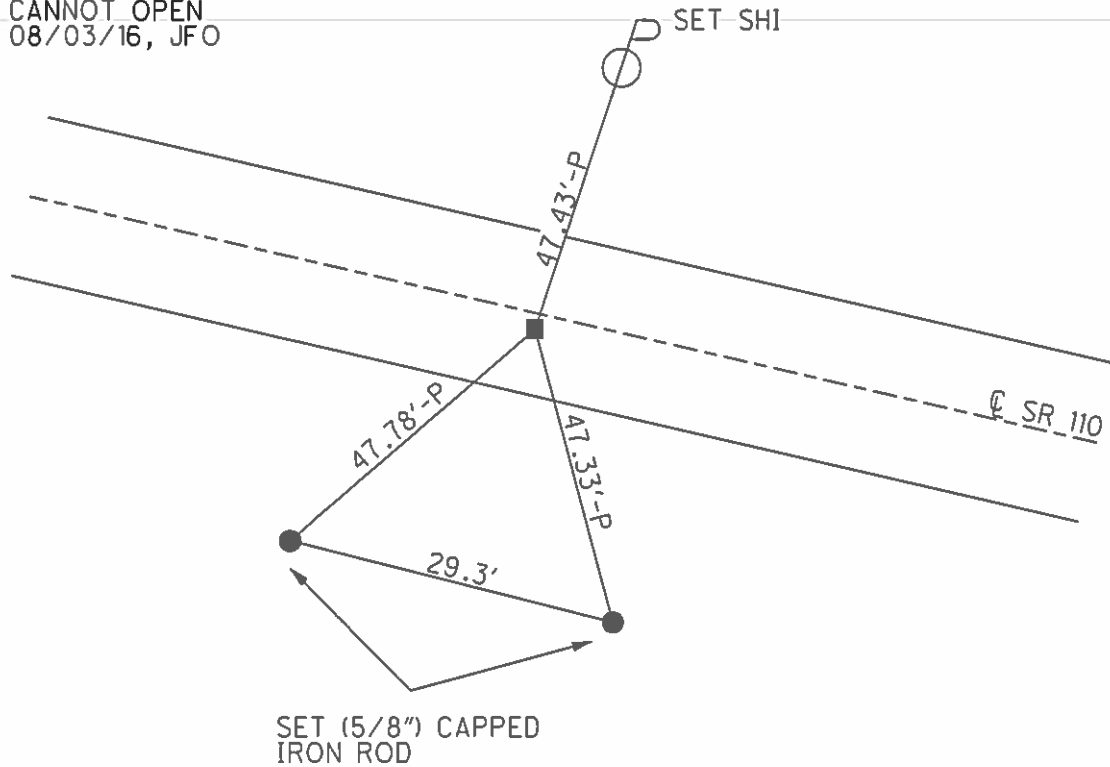

O.D.O.T. DISTRICT 2 SURVEY OFFICE

PERSONNEL

REFERENCE NO. 16<sup>1988</sup>D

SHEET 6 OF 37


NOTES BARNHISEL  
 H.C. CANTERBURY  
 R.C. HOOKER

DATE 09/15/04  
 WEATHER CLEAR  
 TEMP. +80°

ROUTE S.R. 110  
 COUNTY HENRY  
 TOWNSHIP DAMASCUS  
 SECTION 07

T 5 N R 8 E

TYPE MONUMENT MON BOX W/IRON PIN  
 ON SURFACE - ~~BELOW~~ YES  
~~LEFT~~ - Q PAV'T - ~~RIGHT~~ YES  
11.1' TO RT. EDGE PAVEMENT  
 S.L.M. 408+17

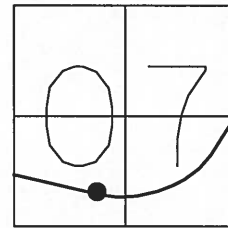

RECORD: ST.  
 PLAN STA: 406+93.62 BK  
 PLAN STA: 406+96.31 AH

NOTE: THIS MON. BOX SET DURING  
 NEW CONST. IN 1988.

