

OD.O.T. DISTRICT 2 SURVEY OFFICE

SHEET 7 OF

County HENRY S.R. 110

Date 4-26-82

Township DAMASCUS

Weather

Section 7

Temp. +76°


T5N, R8E

Personnel HOFFMAN

LOEHRKE

HOUSEHOLDER

T66

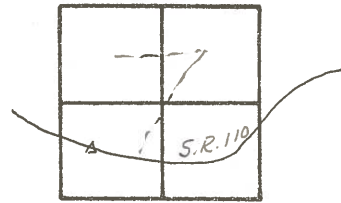


CURVE DATA:

P.I. 408+17.32
P.C. 407+15.80
P.T. 409+17.42
Δ = 16°-38 LT.
R. = 694.50
T = 101.52
D = 8°-15'
L = 201.62

Proj. Sta. 409+44

Old ALIGNMENT

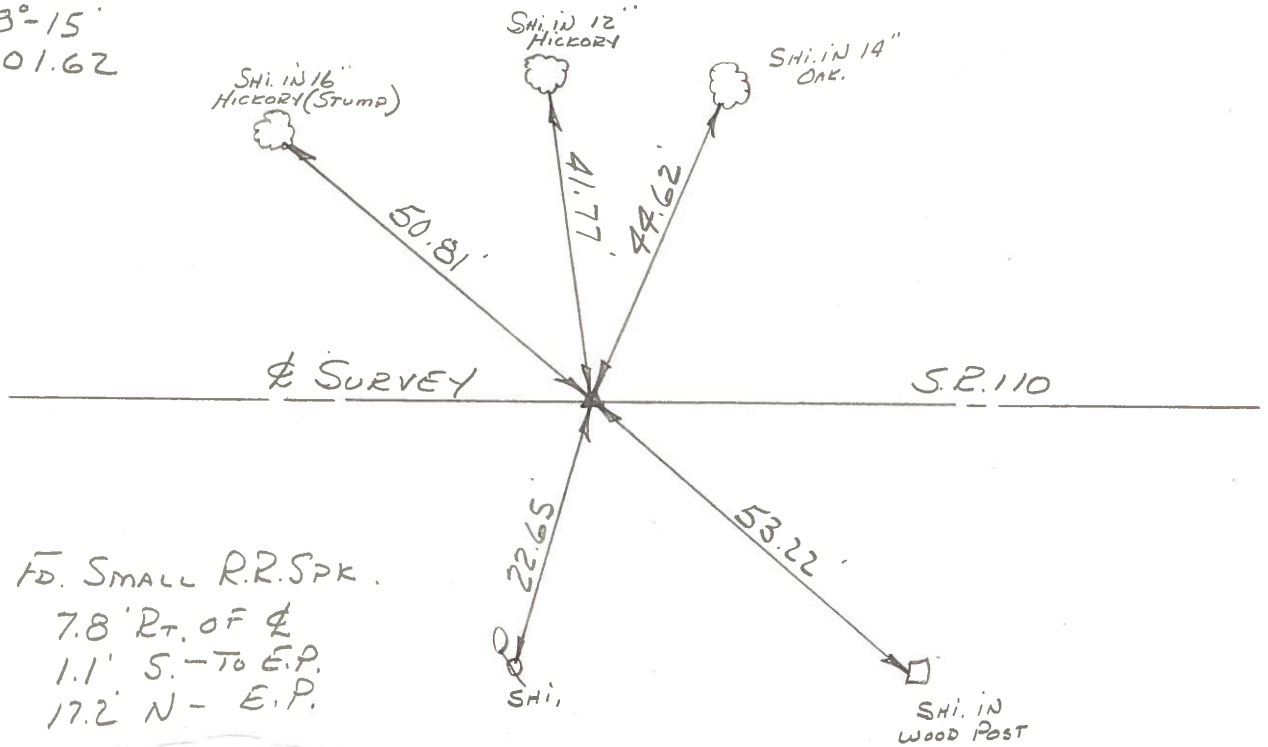

FD. SMALL R.R. SPK.
7.8' RT. OF ♯
1.1' S. - TO E.P.
17.2' N - E.P.

SET P.K./WASHER
S-20-BL
S.W.H.