

County HENRY S.R. 110

Date 4-26-82

Township DAMASCUS

Weather _____

Section 7

Temp. +76°

T5N, R8E

Personnel HOFFMAN

LOEHRKE

HOUSEHOLDER



Proj. Sta. 414+29

CURVE DATA:

P.I. STA. 413+01.61

P.C. = 412+01.70

P.T. = 413+98.79

$\Delta = 23^\circ 09' 30''$ Lt.

R = 487.62


T = 99.91'

D = $11^\circ 45'$

L = 197.09


E = 10.13

OLD ALIGNMENT

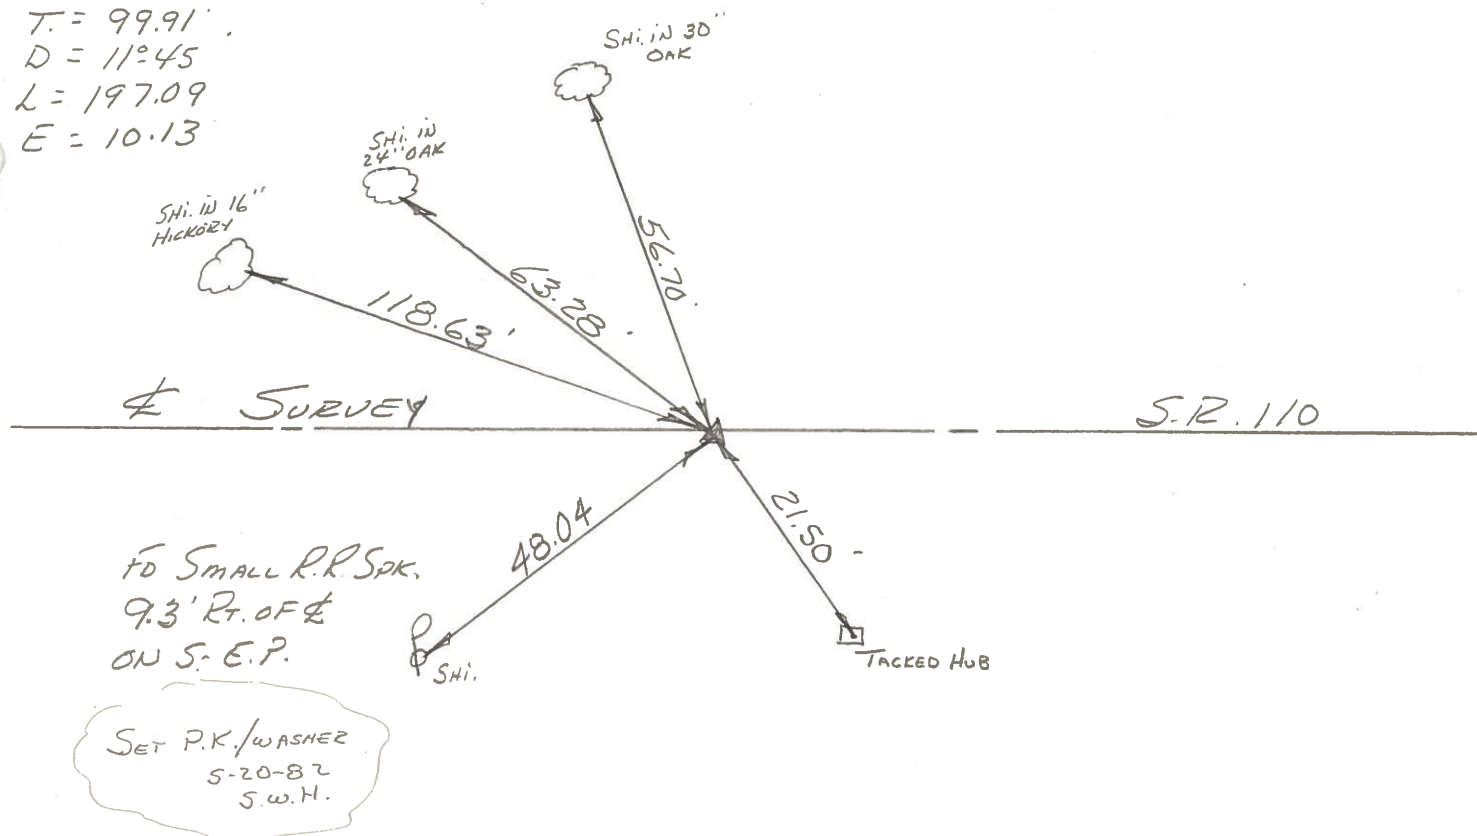

PERSONNEL TITLE PERSONNEL TITLE COUNTY HENRY DATE 4-2-73
BURNSIDE _____
SMITH _____ S. R. 110 WEATHER CLOUDY
BOWERS _____
MEAD _____ SEC. _____ TEMP. +43°

DESCRIPTION § SURVEY CONTROL TIES JOB NO. _____
 LEFT CENTER LINE RIGHT

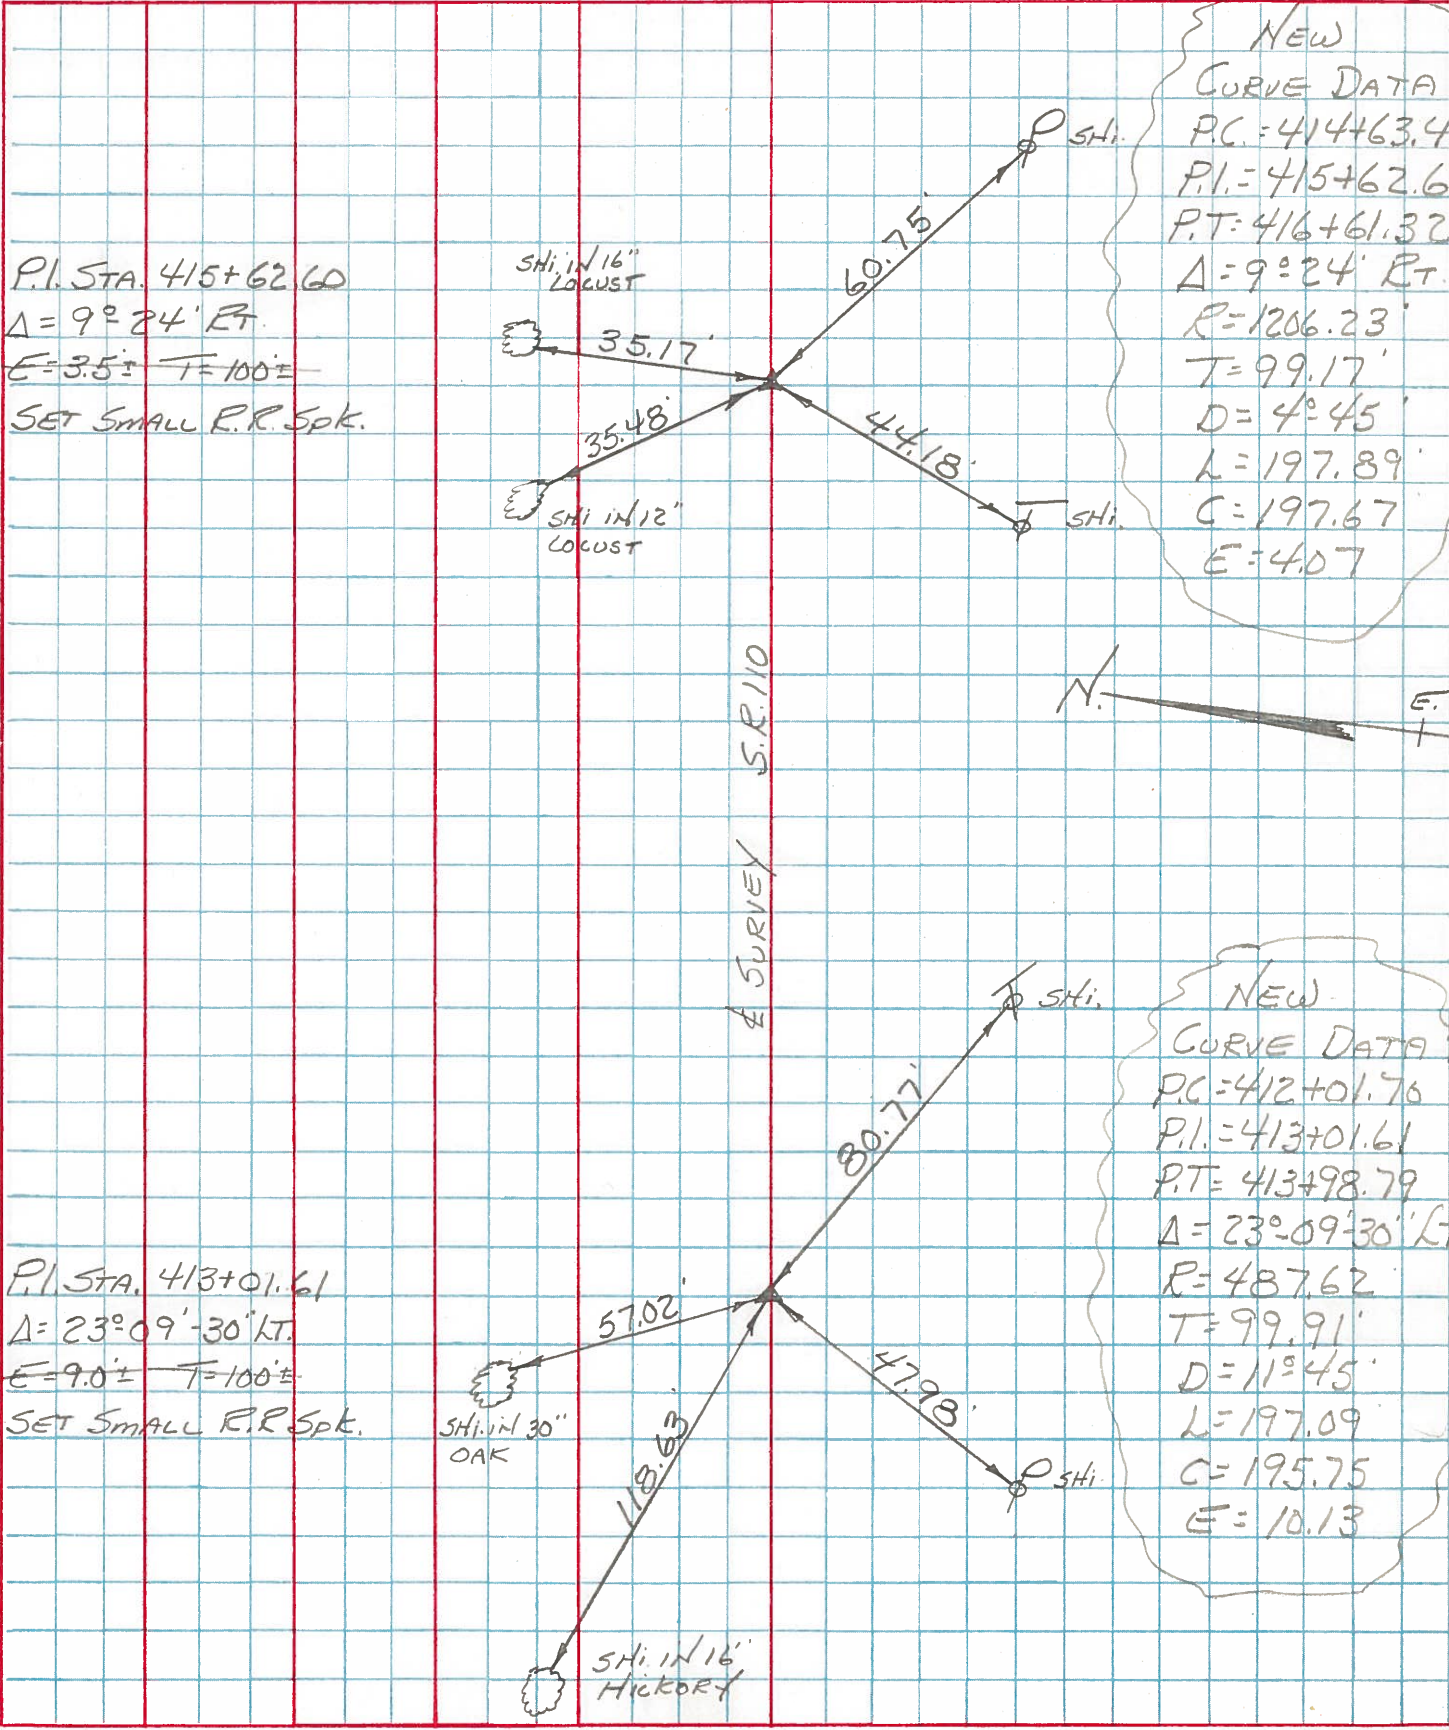

NEW
 CURVE DATA
 P.C. = 414+63.4
 P.I. = 415+62.6
 P.T. = 416+61.32
 Δ = 9°24' RT.
 R = 1206.23'
 T = 99.17'
 D = 4°45'
 L = 197.89'
 C = 197.67
 E = 40.7

NEW
 CURVE DATA
 P.C. = 412+01.76
 P.I. = 413+01.61
 P.T. = 413+98.79
 Δ = 23°09'-30' LT
 R = 487.62'
 T = 99.91'
 D = 11°45'
 L = 197.09'
 C = 195.75
 E = 10.13

