

County HENRY S.R. 110

Date 4-26-82

Township DAMASCUS

Weather                     

Section 7

Temp. +76°

T5N, R8E

Personnel HOFFMAN

LOEHRKE

HOUSEHOLDER



CURVE DATA:

Proj. Sta. 416+90

OLD ALIGNMENT

P.I. Sta. = 415+62.60

P.C. = 414+63.43

P.T. = 416+61.32

$\Delta = 9^{\circ}24' RT.$


$R = 1206.23$

$T = 99.17$

$D = 4^{\circ}45'$

$L = 197.89'$

$E = 4.07'$

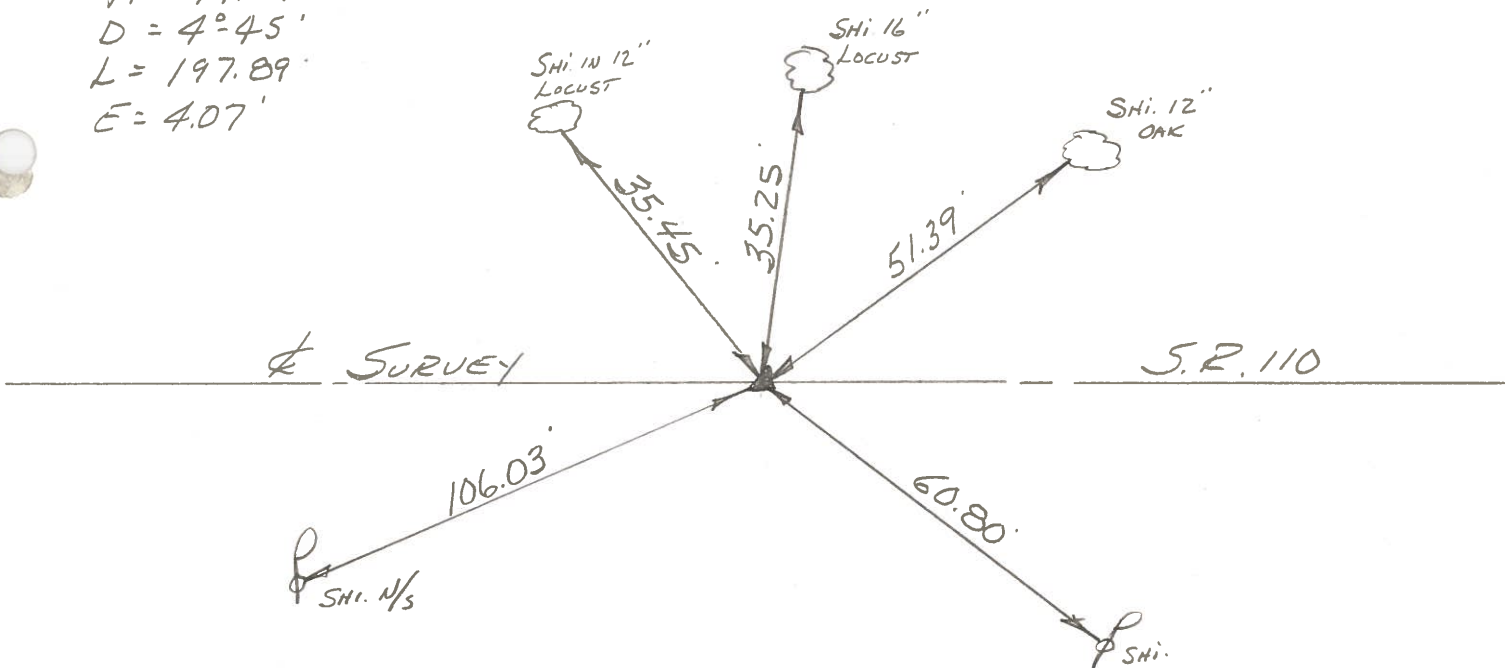

FD. SMALL R.R. SPK.

3.8' LT. of  $\Delta$


4.8' N. of E.P.

13.1' S. of E.P.


SET P.K./WASHER  
5-20-82  
S.W.H.

PERSONNEL TITLE PERSONNEL TITLE COUNTY HENRY DATE 4-2-73  
 SMITH \_\_\_\_\_ S. R. 110 WEATHER CLOUDY  
 BOWERS \_\_\_\_\_ SEC. \_\_\_\_\_ TEMP. +43°  
 MEAD \_\_\_\_\_

DESCRIPTION § SURVEY CONTROL TIES JOB NO. \_\_\_\_\_  
 LEFT CENTER LINE RIGHT

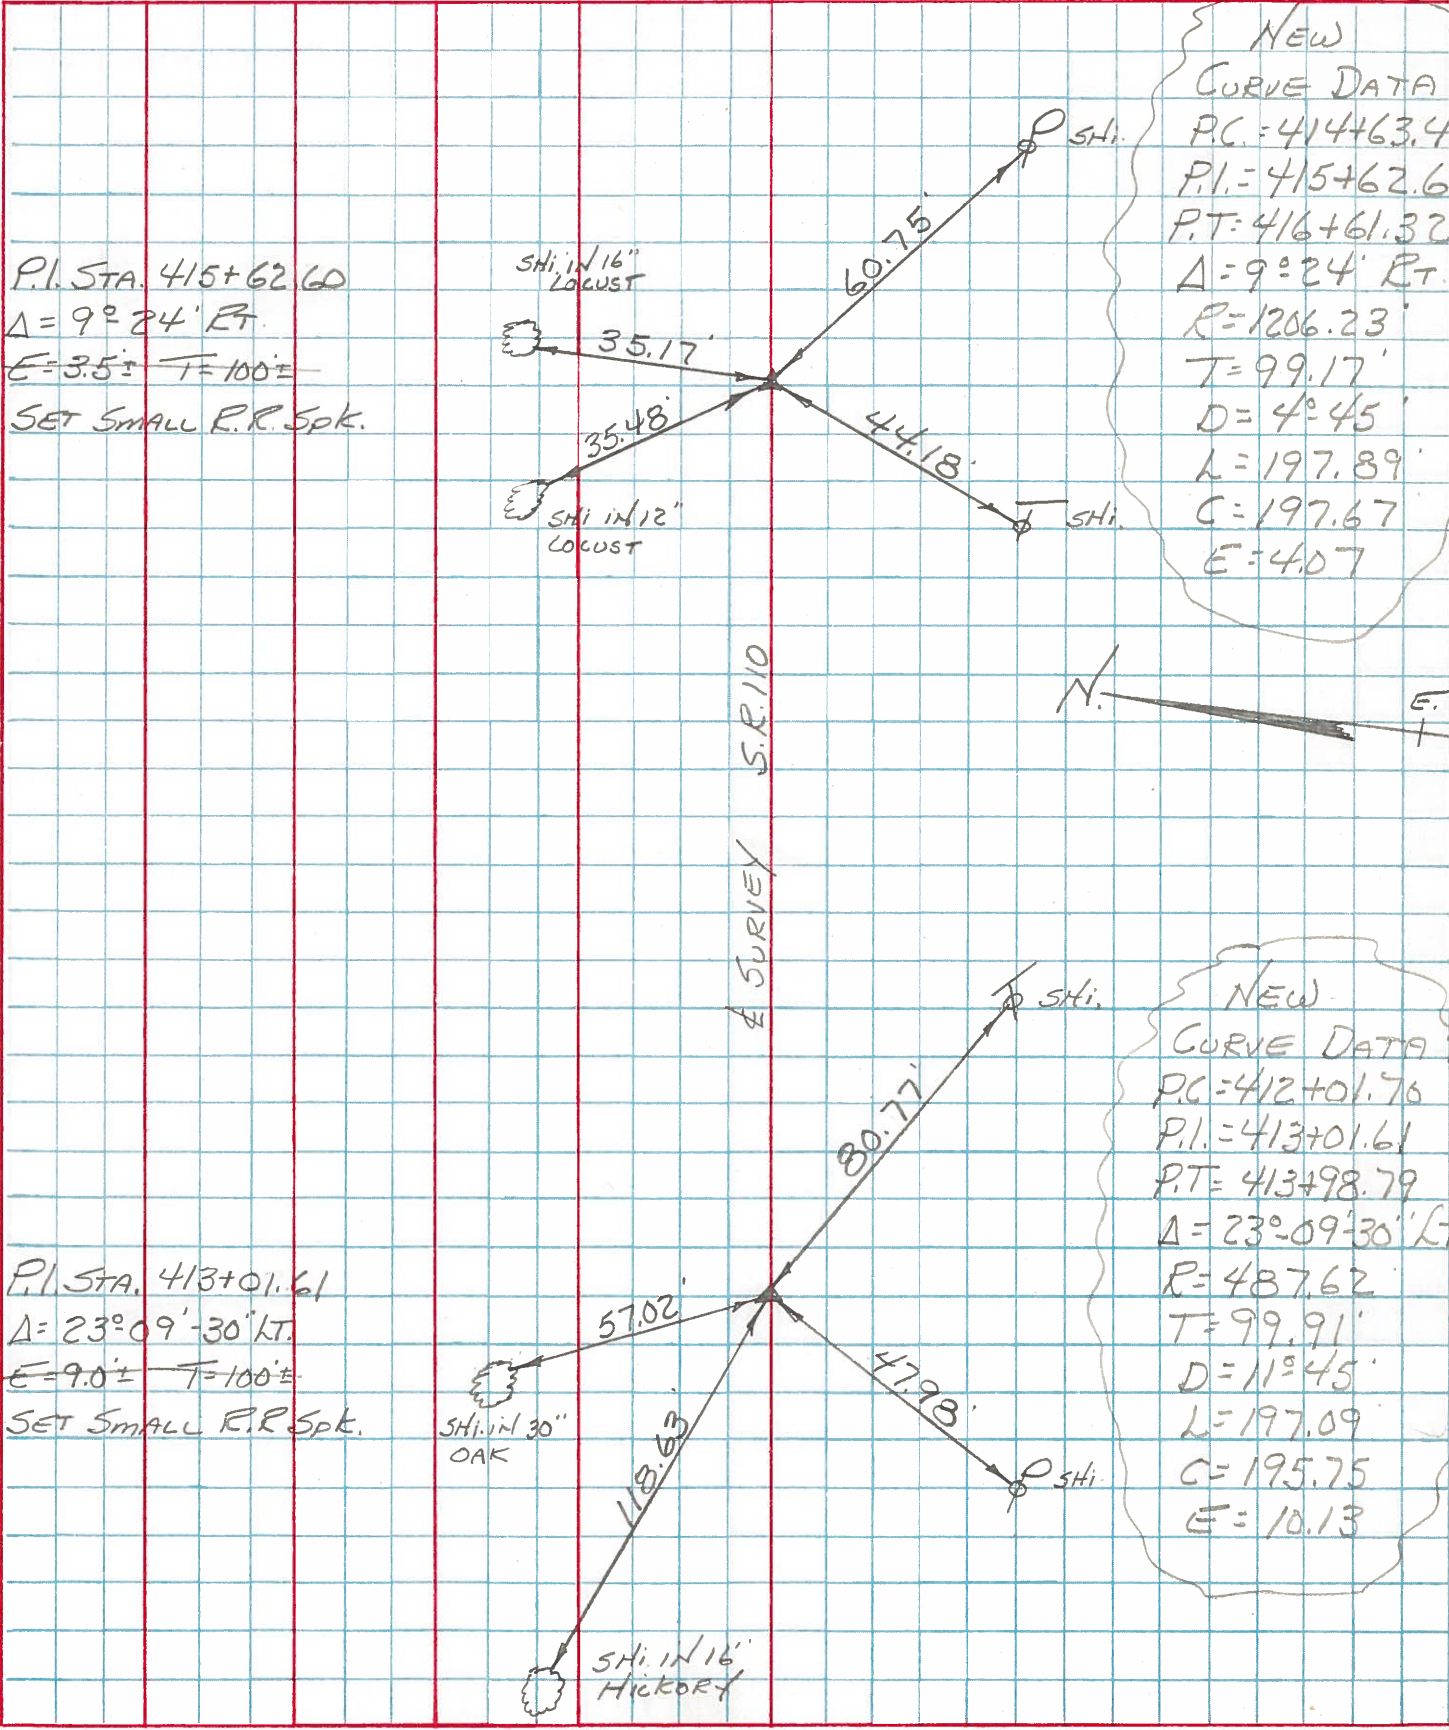

NEW  
 CURVE DATA  
 P.C. = 414+63.4  
 P.I. = 415+62.6  
 P.T. = 416+61.32  
 Δ = 9°24' RT.  
 R = 1206.23'  
 T = 99.17'  
 D = 4°45'  
 L = 197.89'  
 C = 197.67  
 E = 4.07

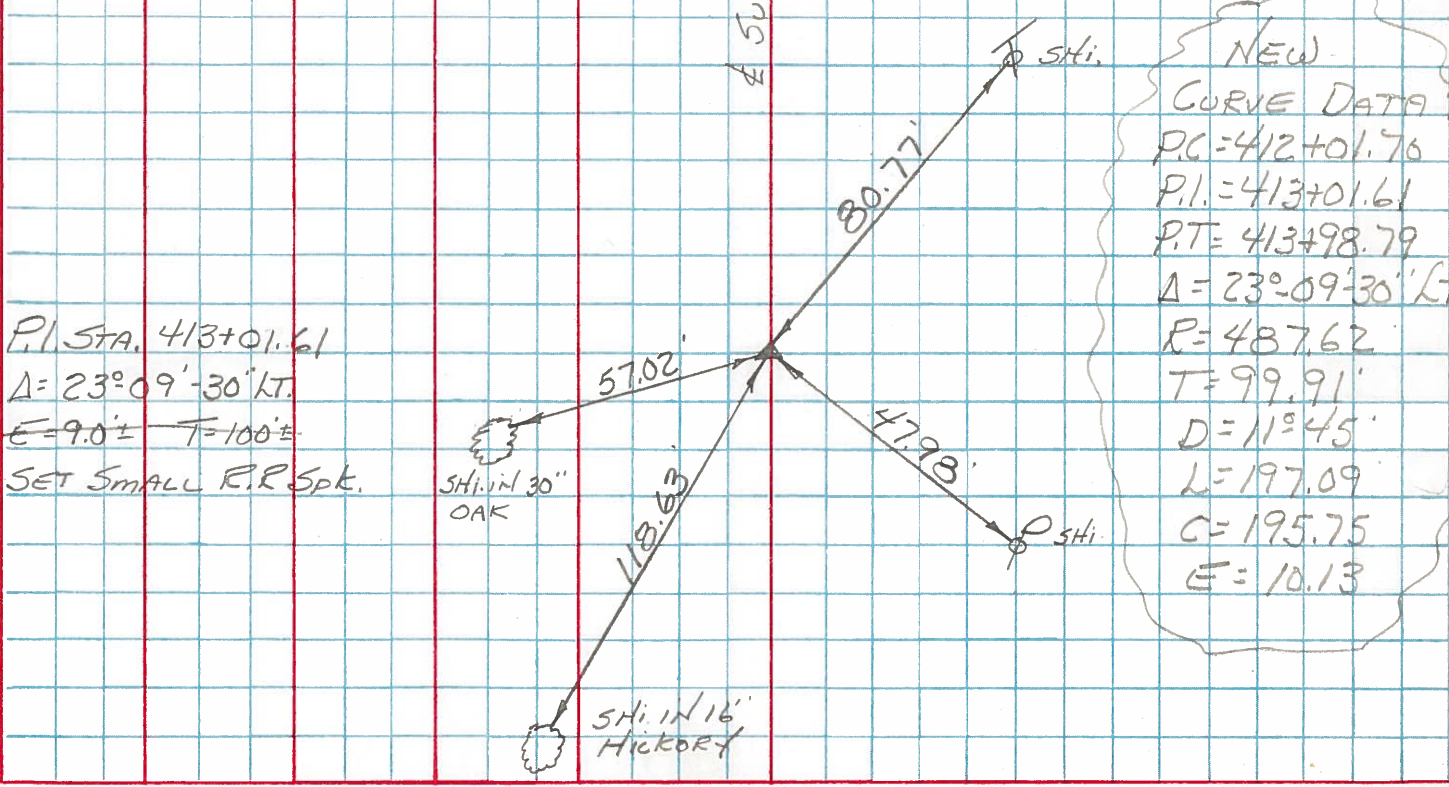

NEW  
 CURVE DATA  
 P.C. = 412+01.76  
 P.I. = 413+01.61  
 P.T. = 413+98.79  
 Δ = 23°09'30" LT  
 R = 487.62'  
 T = 99.91'  
 D = 11°45'  
 L = 197.09'  
 C = 195.75  
 E = 10.13