

County HENRY S.R. 110

Date 4-26-82

Township DAMASCUS

Weather

Section 7

Temp. +76°

T5N, R8E

Personnel HOFFMAN

LOEHRKE

HOUSEHOLDER



CURVE DATA:

Proj. Sta. 420+72

P.I. Sta. 419+43.93

P.C. = 418+53.93

P.T. = 420+33.93

$\Delta = 3^{\circ}09' LT.$


R. = 3274.05

T. 90.00

D = 1°45'

L = 180.00

OLD ALIGNMENT

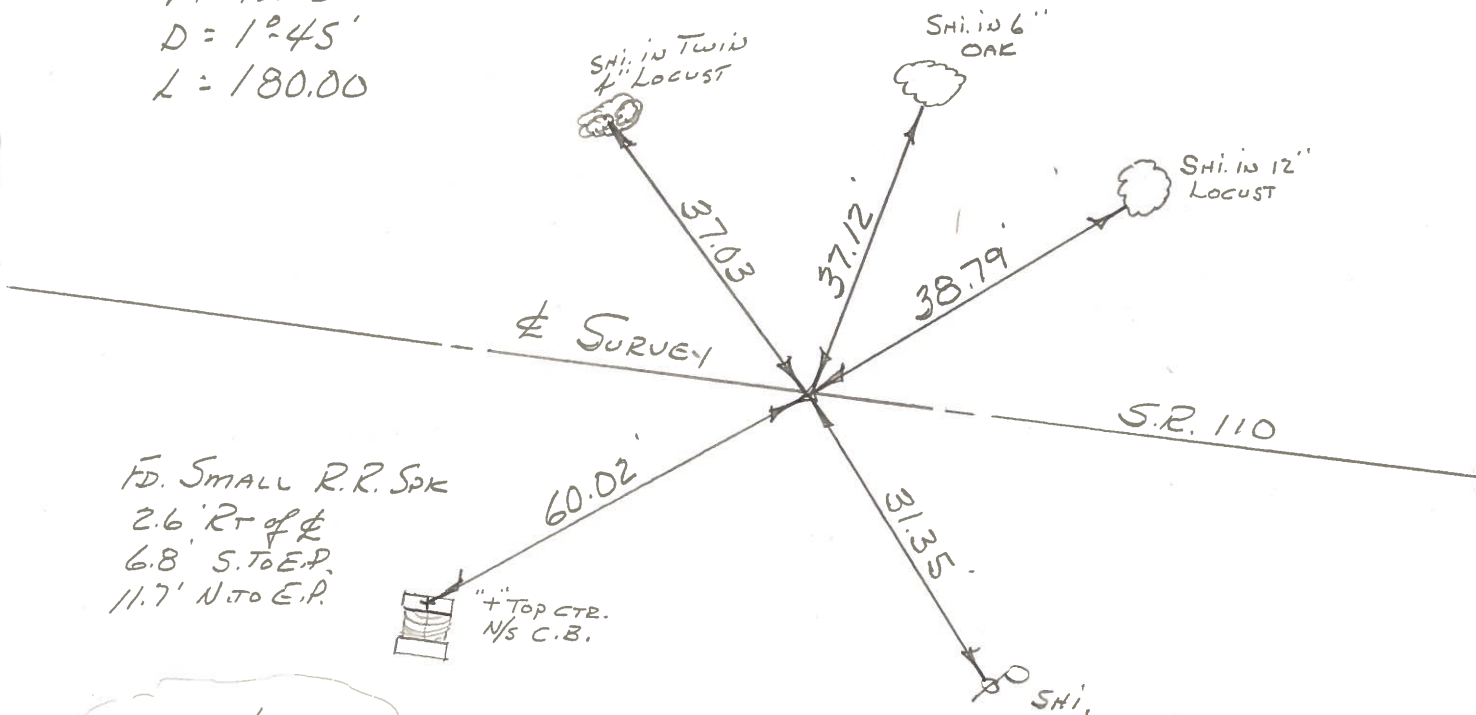

FD. SMALL R.R. SPK

2.6' RT of ϕ

6.8' S. TO E.P.


11.7' N. TO E.P.



SET P.K./WASHER
5-20-82
S.W.H.

PERSONNEL	TITLE	PERSONNEL	TITLE	COUNTY	<u>HENRY</u>	DATE	<u>4-2-73</u>
<u>BURNSIDE</u>				S. R.	<u>110</u>	WEATHER	<u>CLOUDY</u>
<u>SMITH</u>				SEC.		TEMP.	<u>+45°</u>
<u>BOWERS</u>							
<u>MEAD</u>							

DESCRIPTION ± SURVEY CONTROL TIES JOB NO. _____

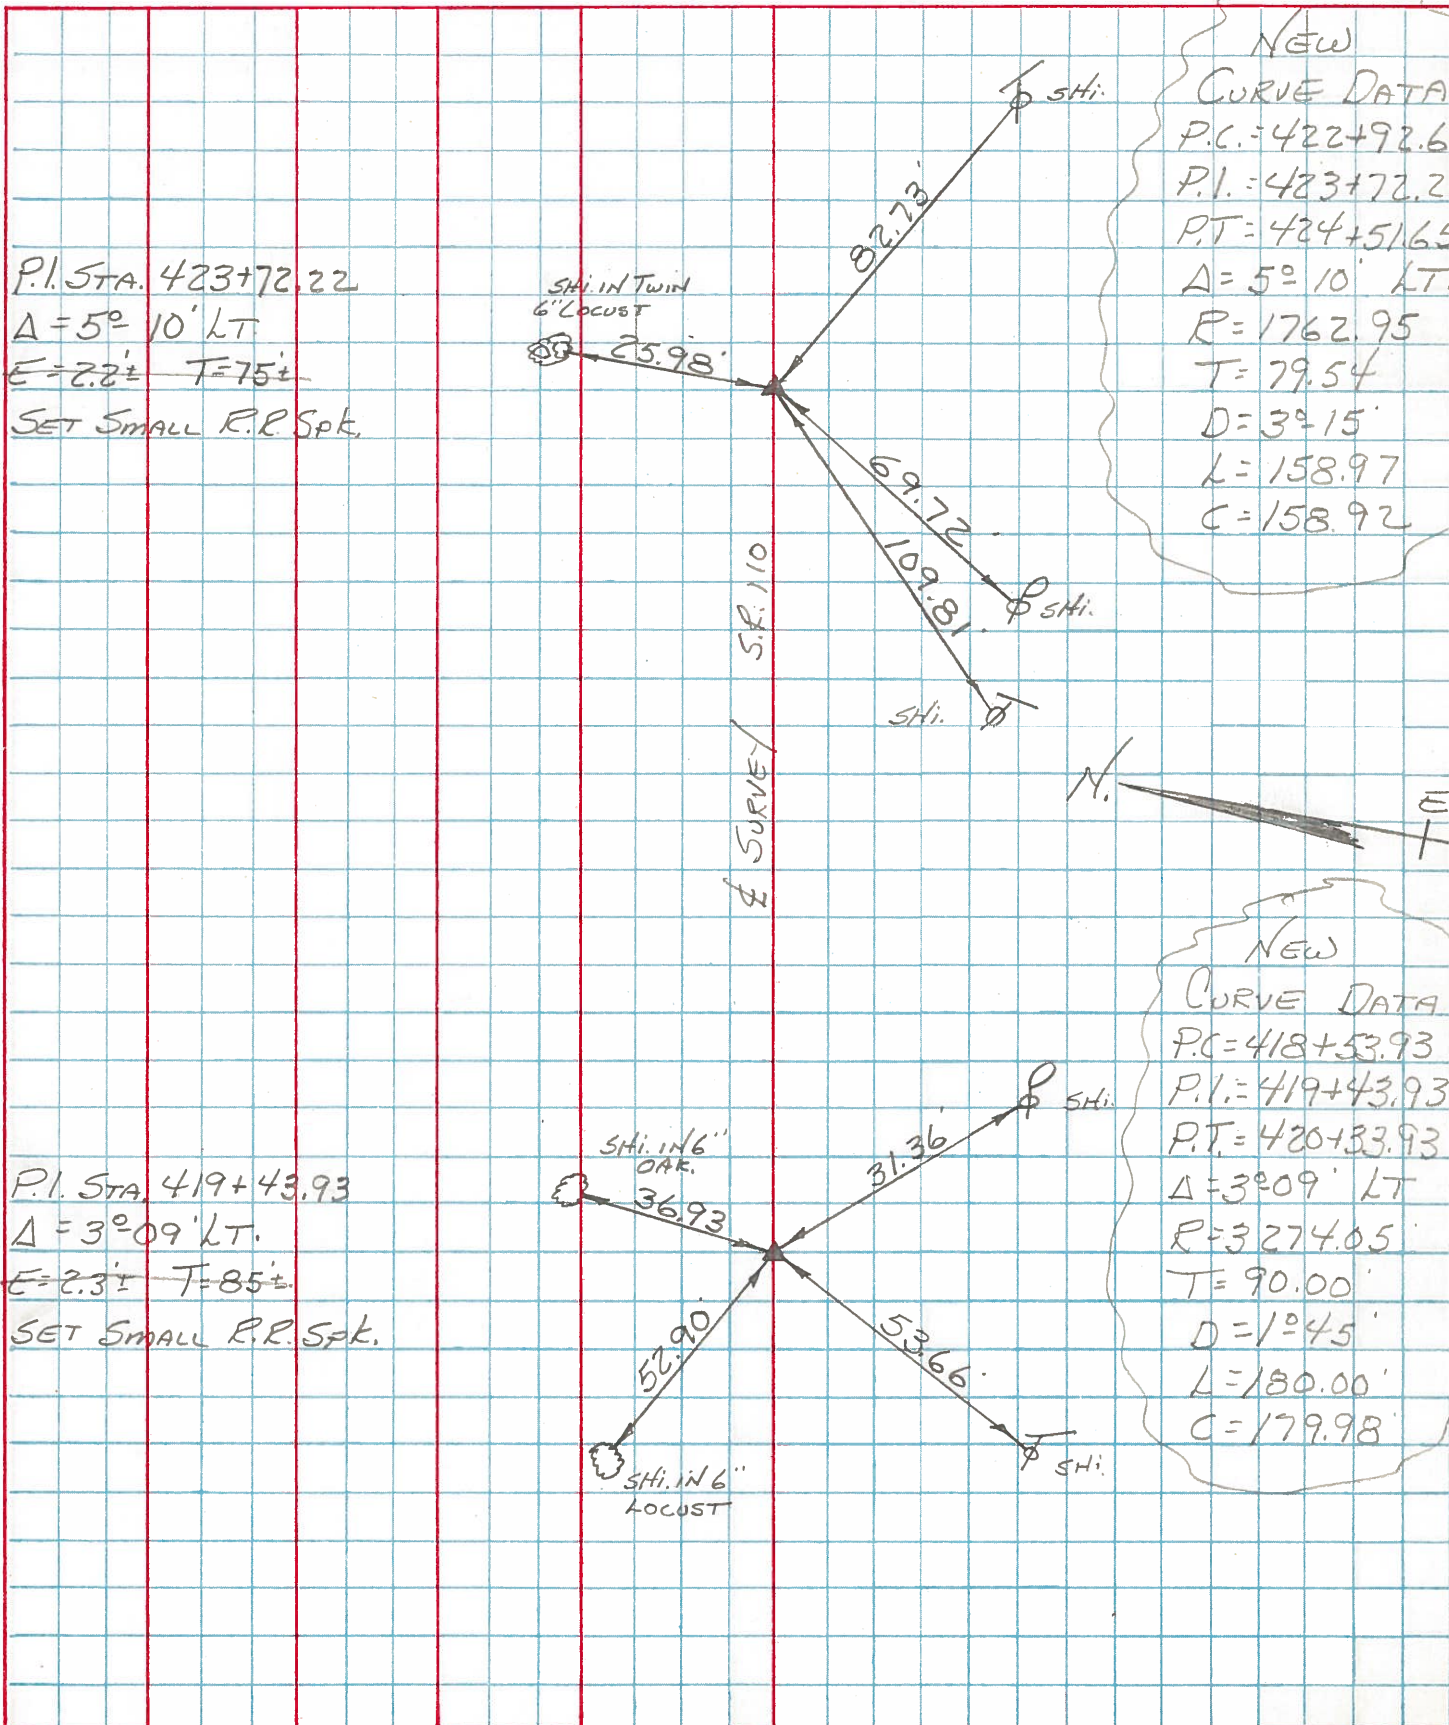

NEW
CURVE DATA
P.C.=422+92.6
P.I.=423+72.2
P.T.=424+51.6
Δ=5°10' LT
R=1762.95
T=79.54
D=3°15'
L=158.97
C=158.92

NEW
CURVE DATA
P.C.=418+53.93
P.I.=419+43.93
P.T.=420+33.93
Δ=3°09' LT
R=3274.05
T=90.00
D=1°45'
L=180.00
C=179.98

